


31.5.07

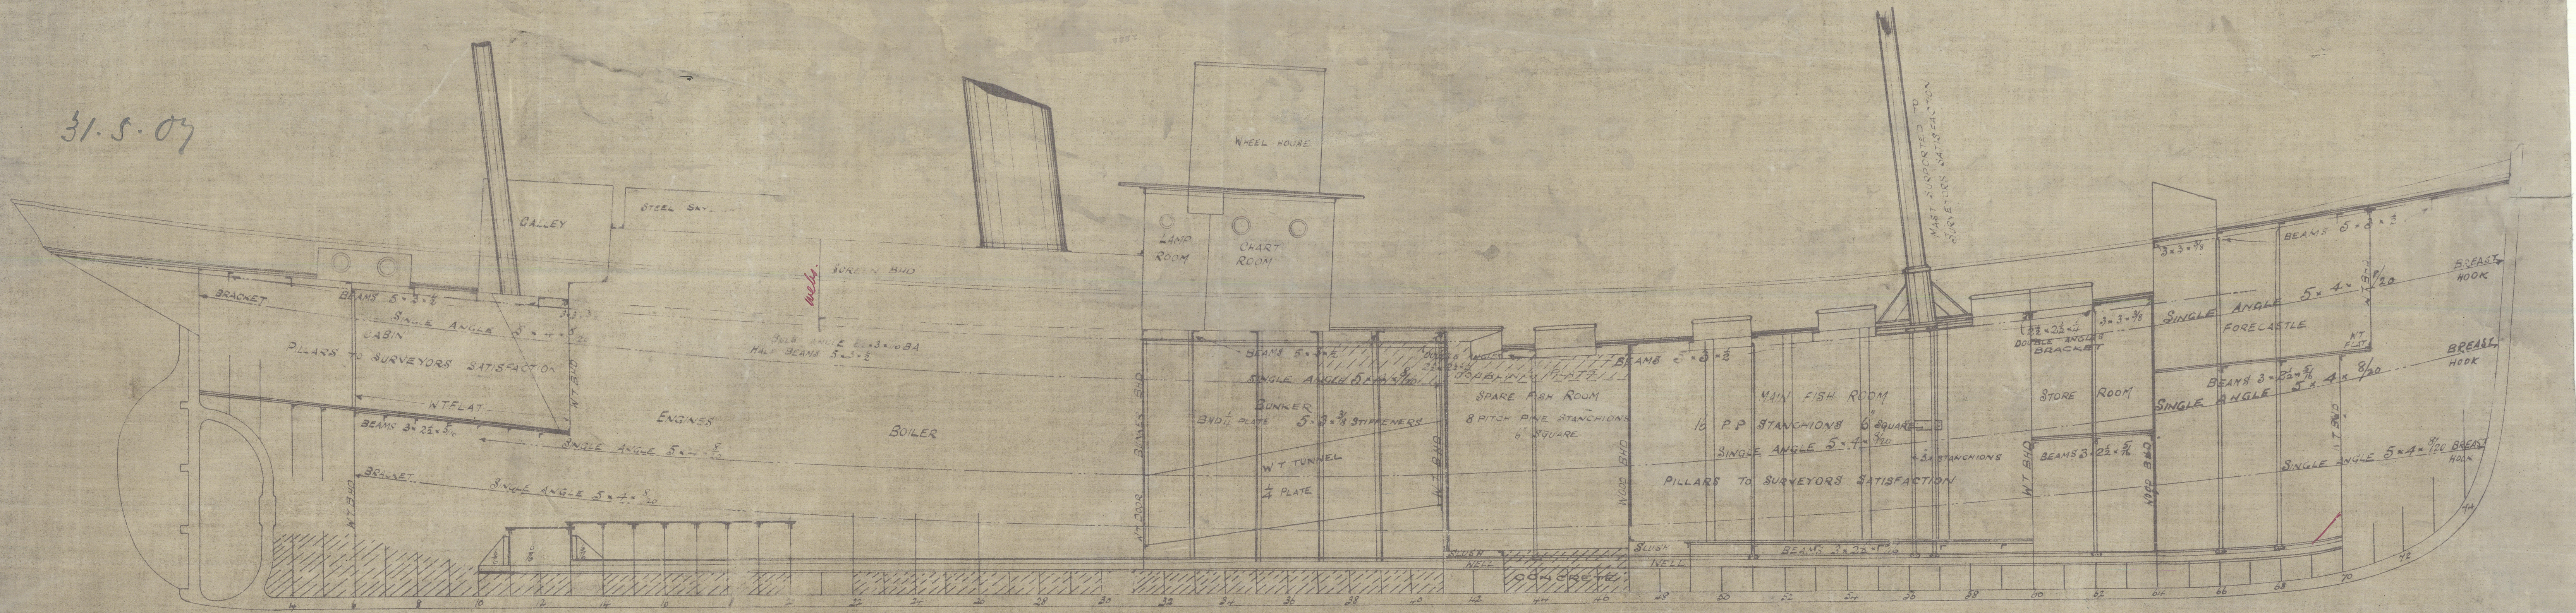


BEAM ARRANGEMENT

PILLARS TO SURVEYORS SATISFACTION
SCALE 1/4" = ONE FOOT

No 155

MESSRS COOK WELTON & GEMMELL
SHIPBUILDERS
BEVERLEY
DATE SUBMITTED MAY 29th 07
DATE APPROVED

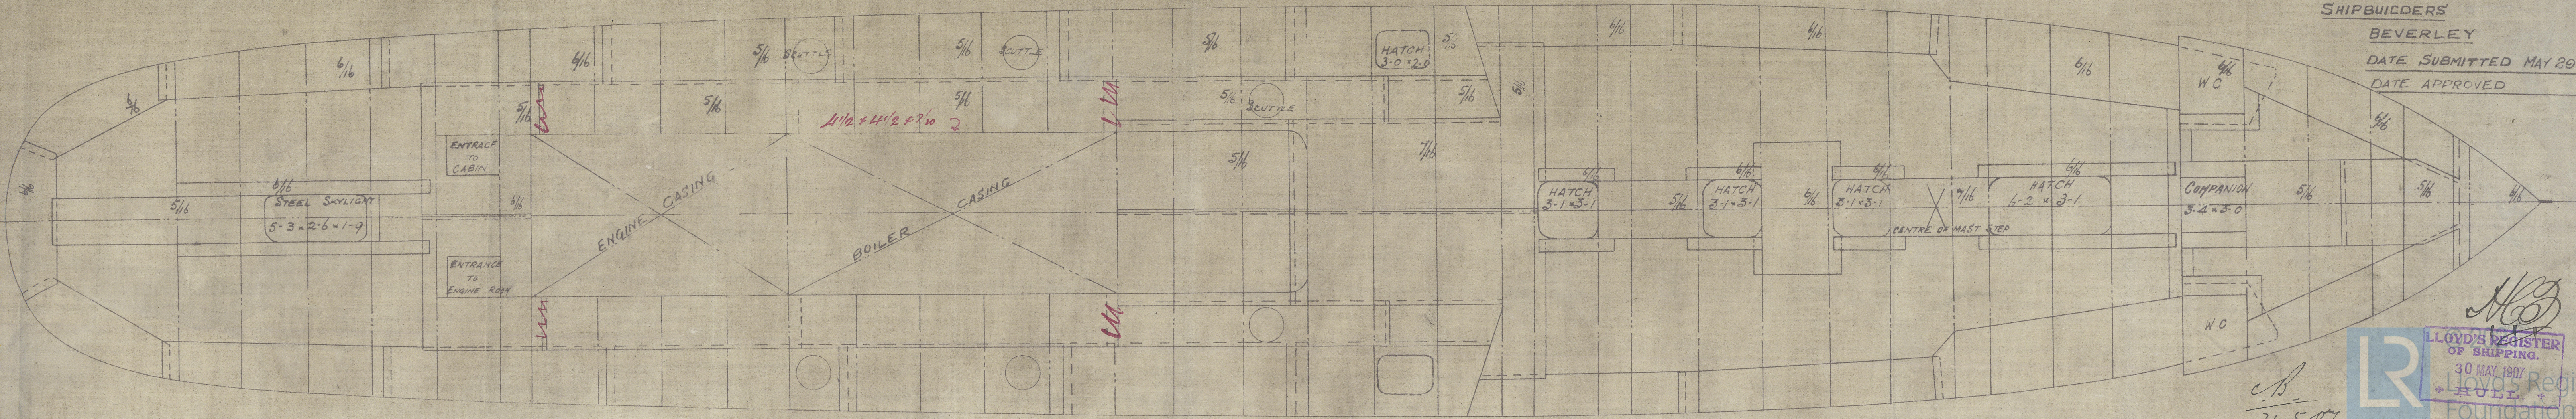


LLOYD'S REGISTER
OF SHIPPING
30 MAY 1907
FULL
Foundation

- Profile -

Cook Wilton & Gimmell ⁴⁴
Beverly

- Spec No 155 -

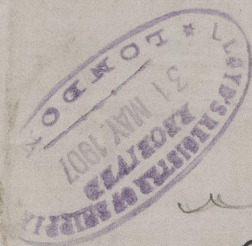

Goran

Spec Semuramis

Hull Report No 19565



© 2021

Lloyd's Register
Foundation

010067-010078-0020