






— S/S "BESSA." —

Midship Section  
of vessel as built

Union Iron Works Co's  
No 139.

S. Fr. Rpt. No. 2475.

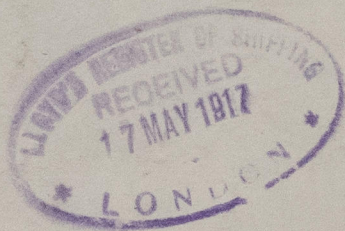

W/ <sup>a</sup> Missyn <sup>u</sup> Mann

010067-010078-0229



© 2021

Lloyd's Register  
Foundation