
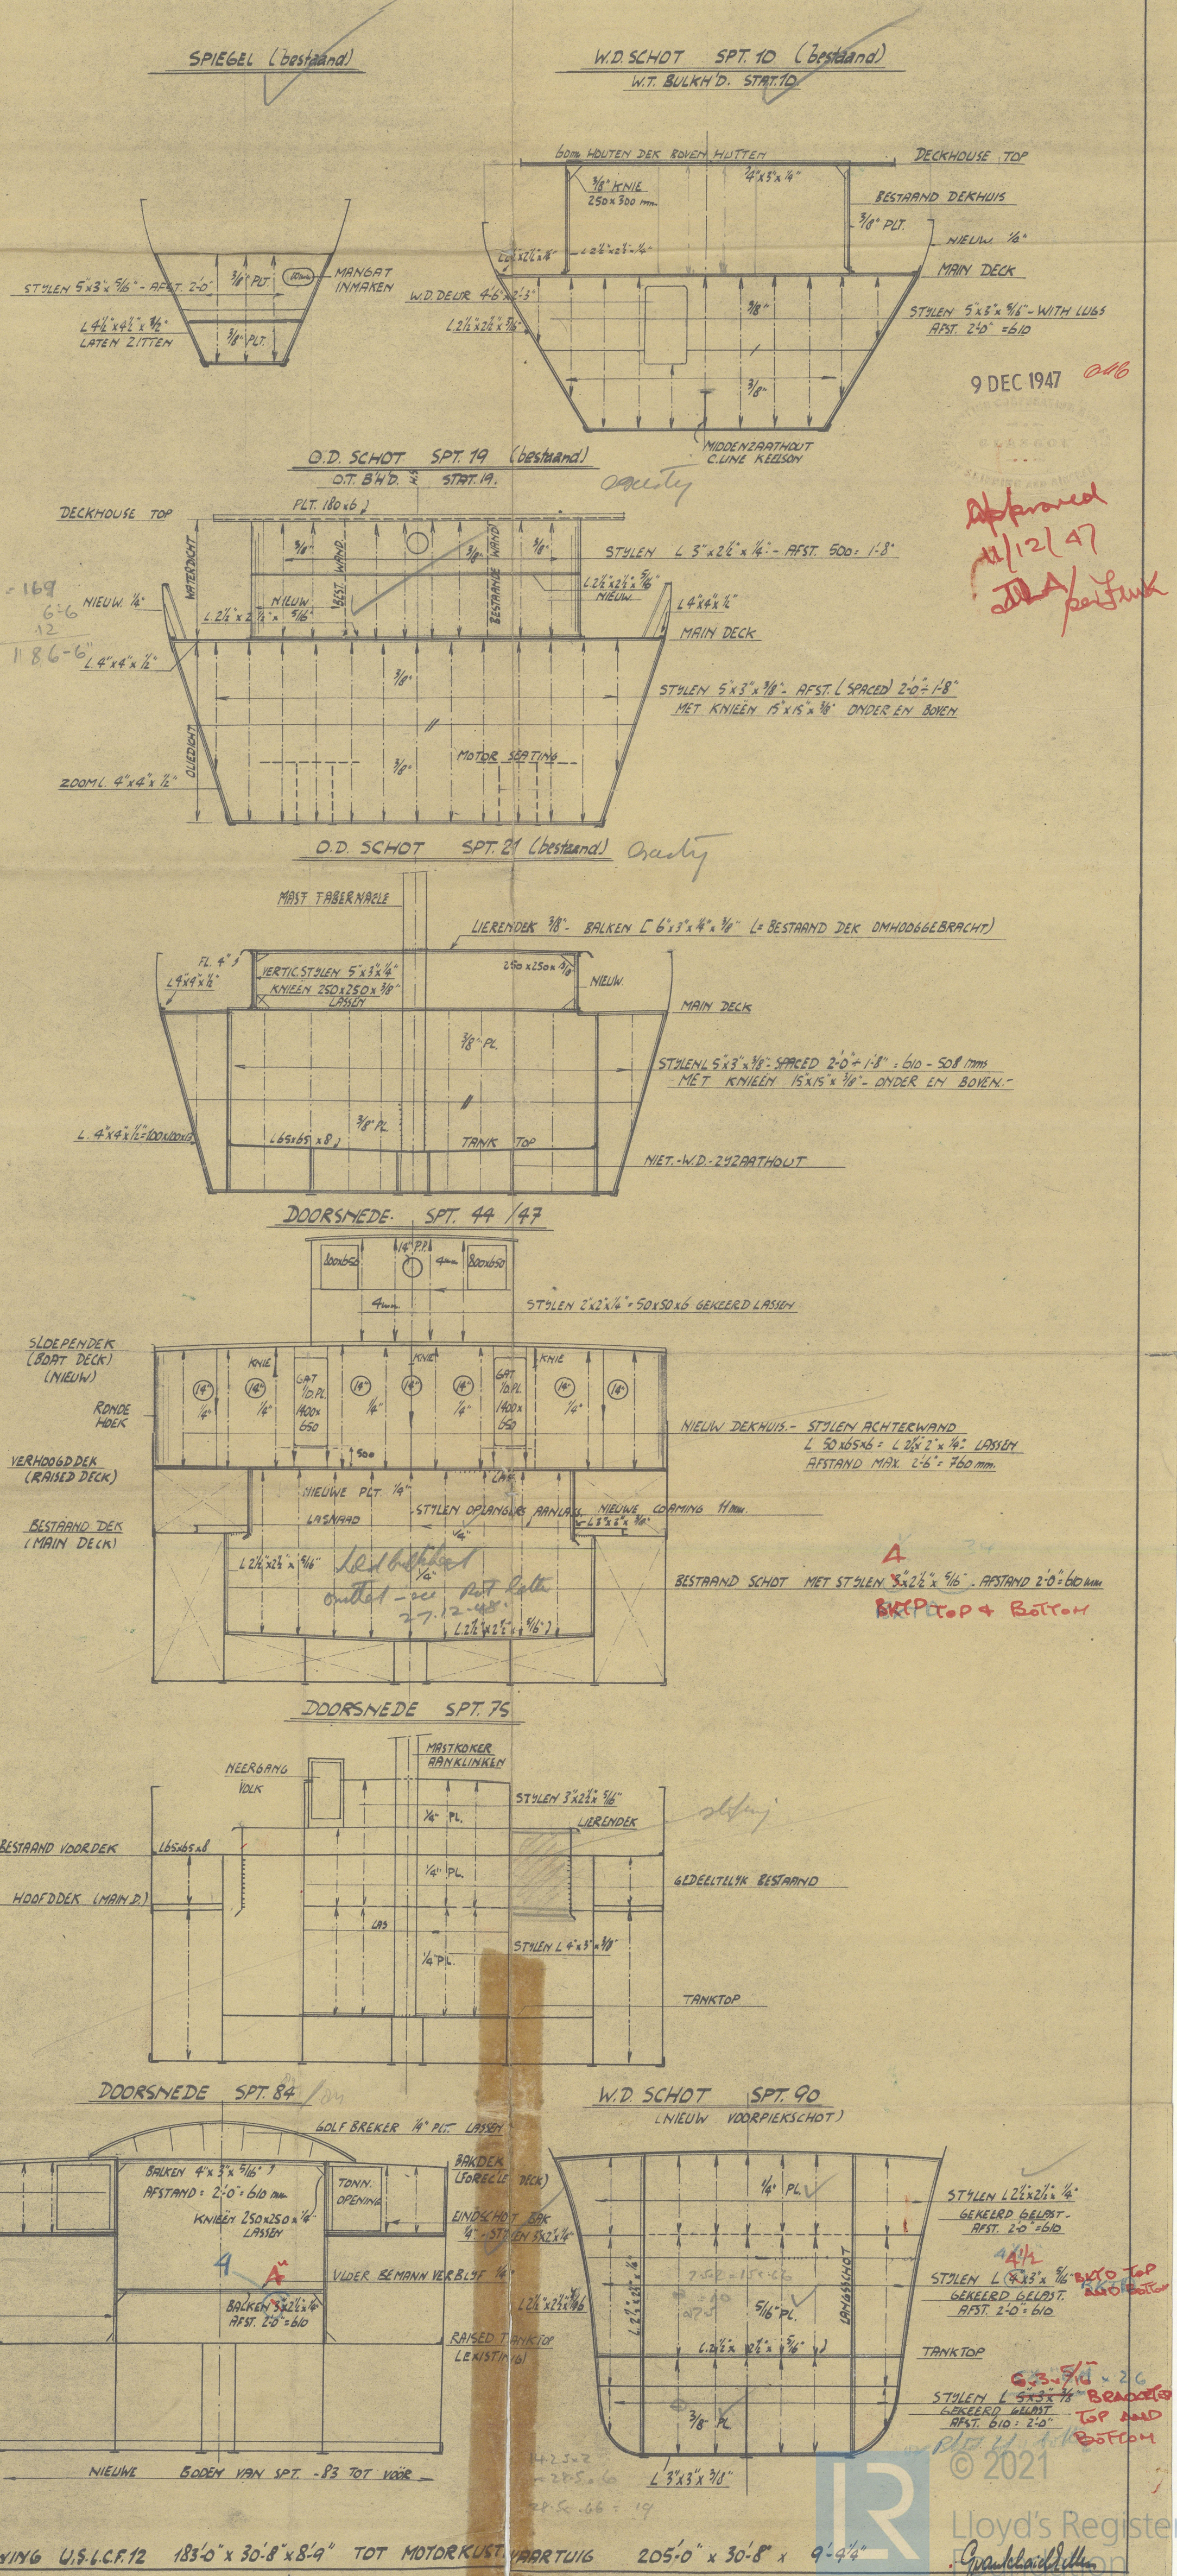


VERBOUWING LANDINGSVAARTUIG L.C.F. TOT MOTOR KUSTVAARTUIG
IJZERTEKENING - CLASSIF. PLAN
SCHAAL 1:75

Ing. G. van Schaik Zillen
Graf Adriaanstraat 26
SLIKKERVEER
Tel. 421 K. 1590

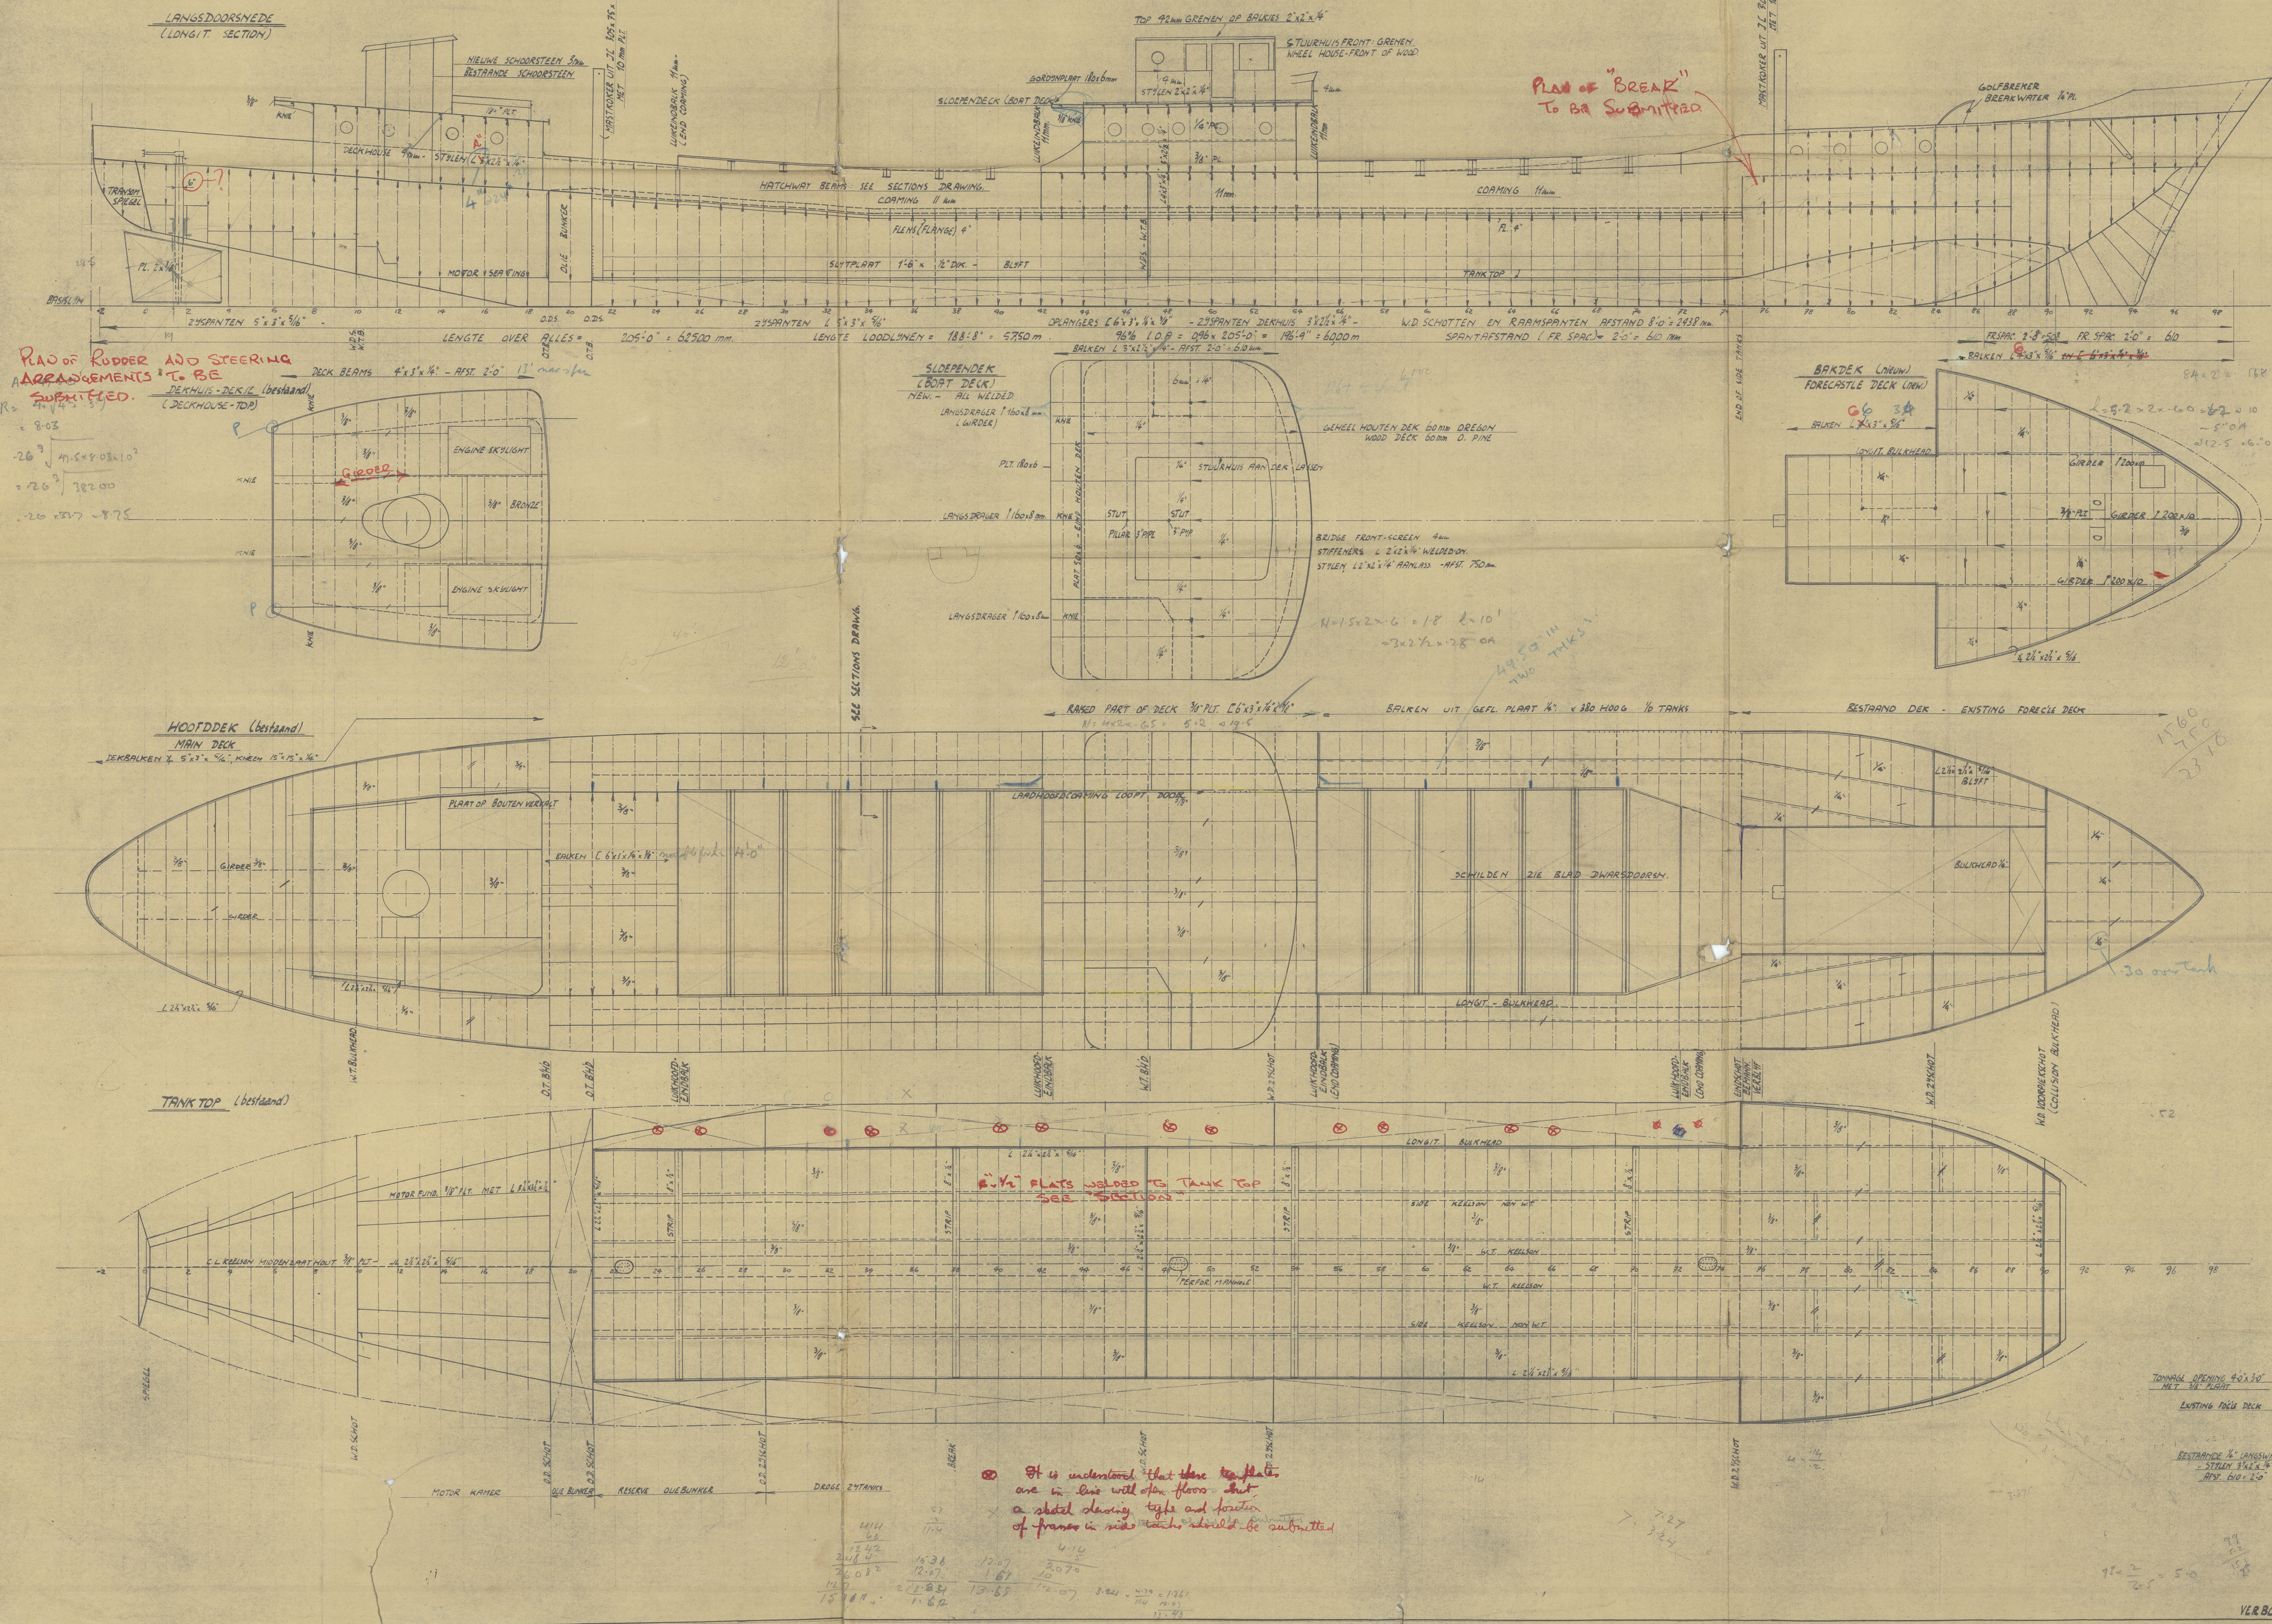

9 DEC 1947
Approved
11/12/47
J.A. / J.A.

2

Reconstruction Plan

U.S.N.

L.C.F. (12) ["]now Orca["] ★

"ORCA"

11.12.47.

RECORDS DEPT.,
LONDON

3

Reconstruction Plan
L.C.F. (12) Conversion

Rotterdam

9 - DEC 1947.

Boag