

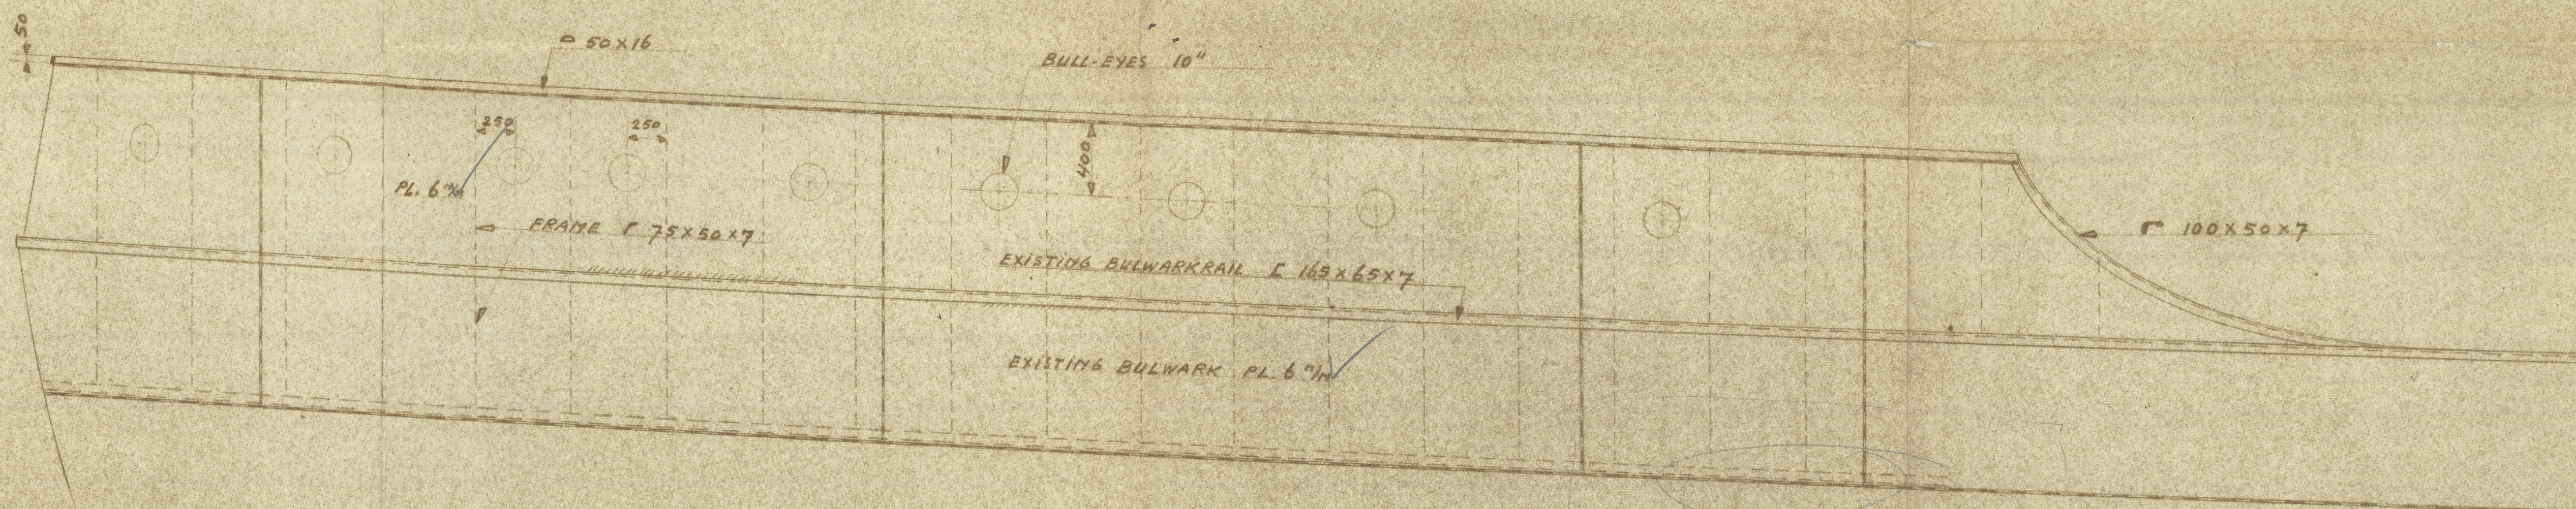
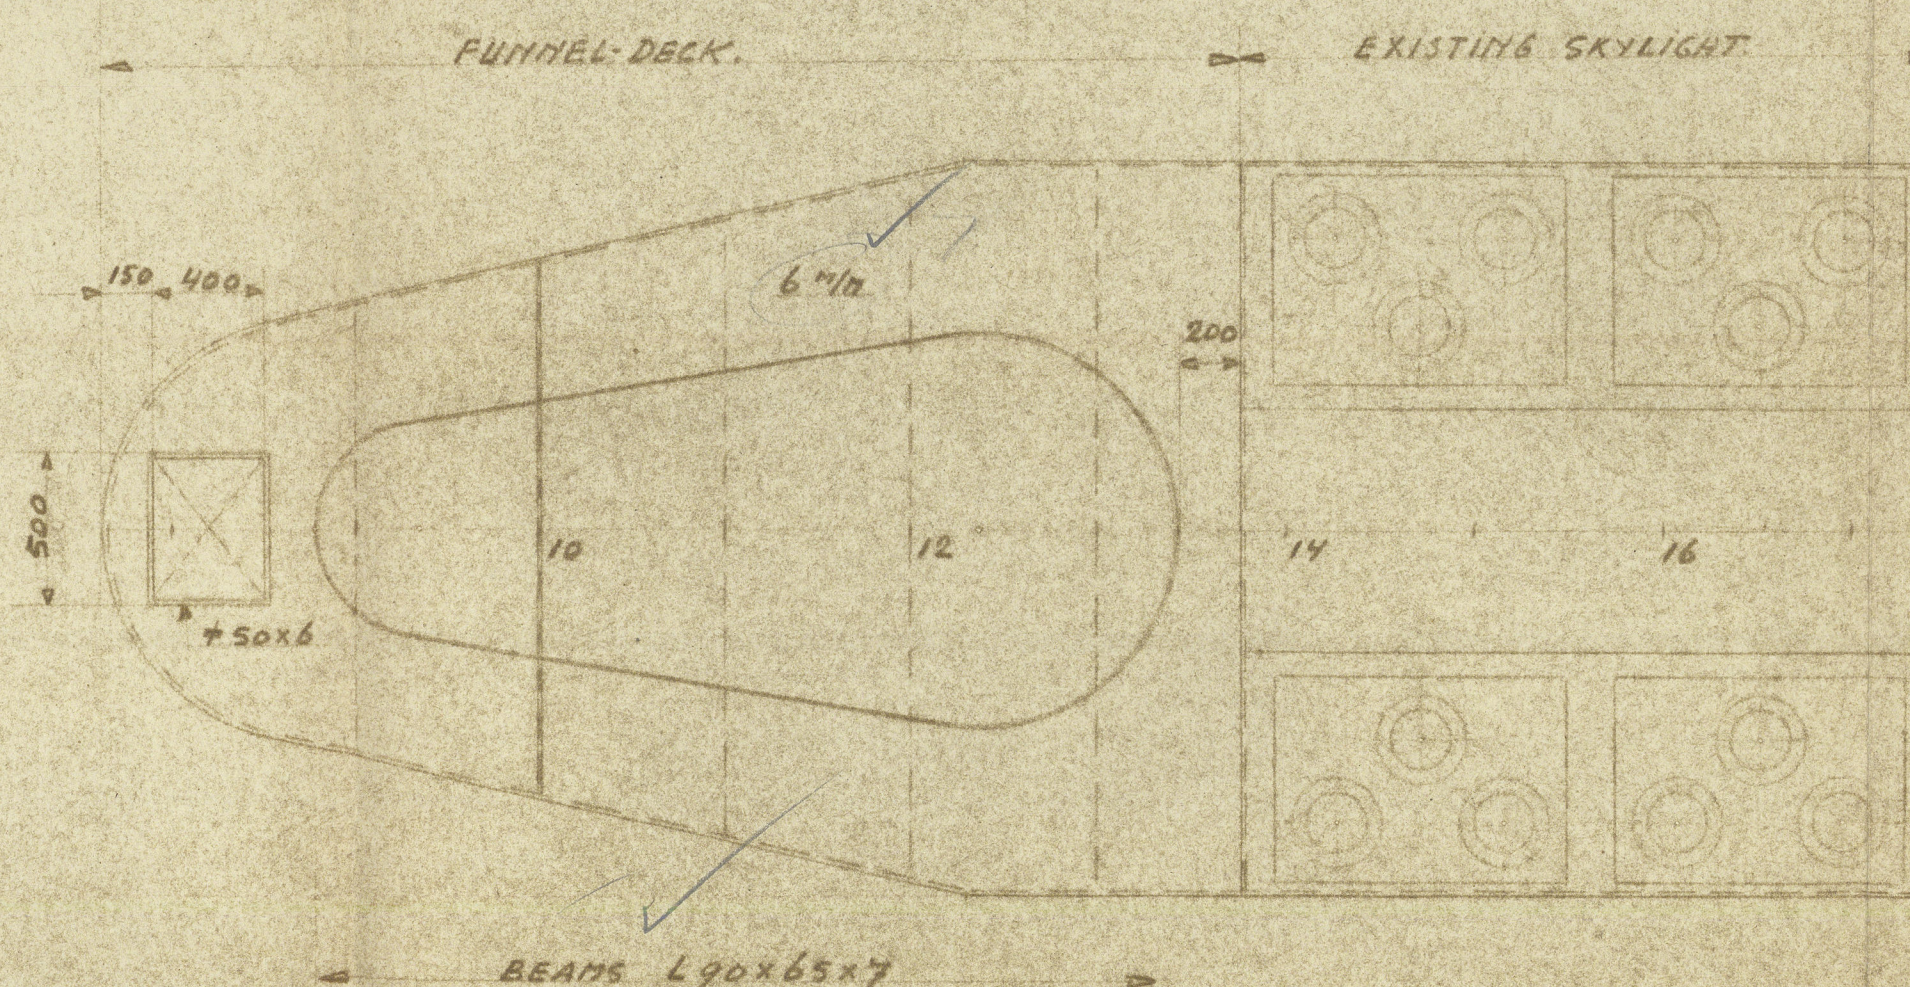
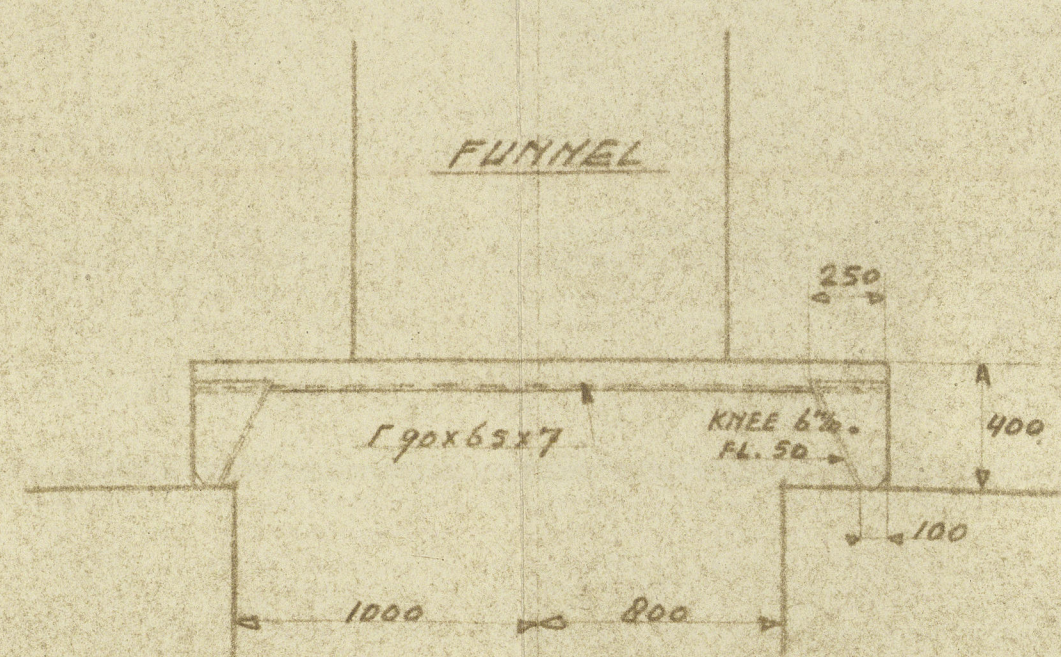


SECTION FR 12

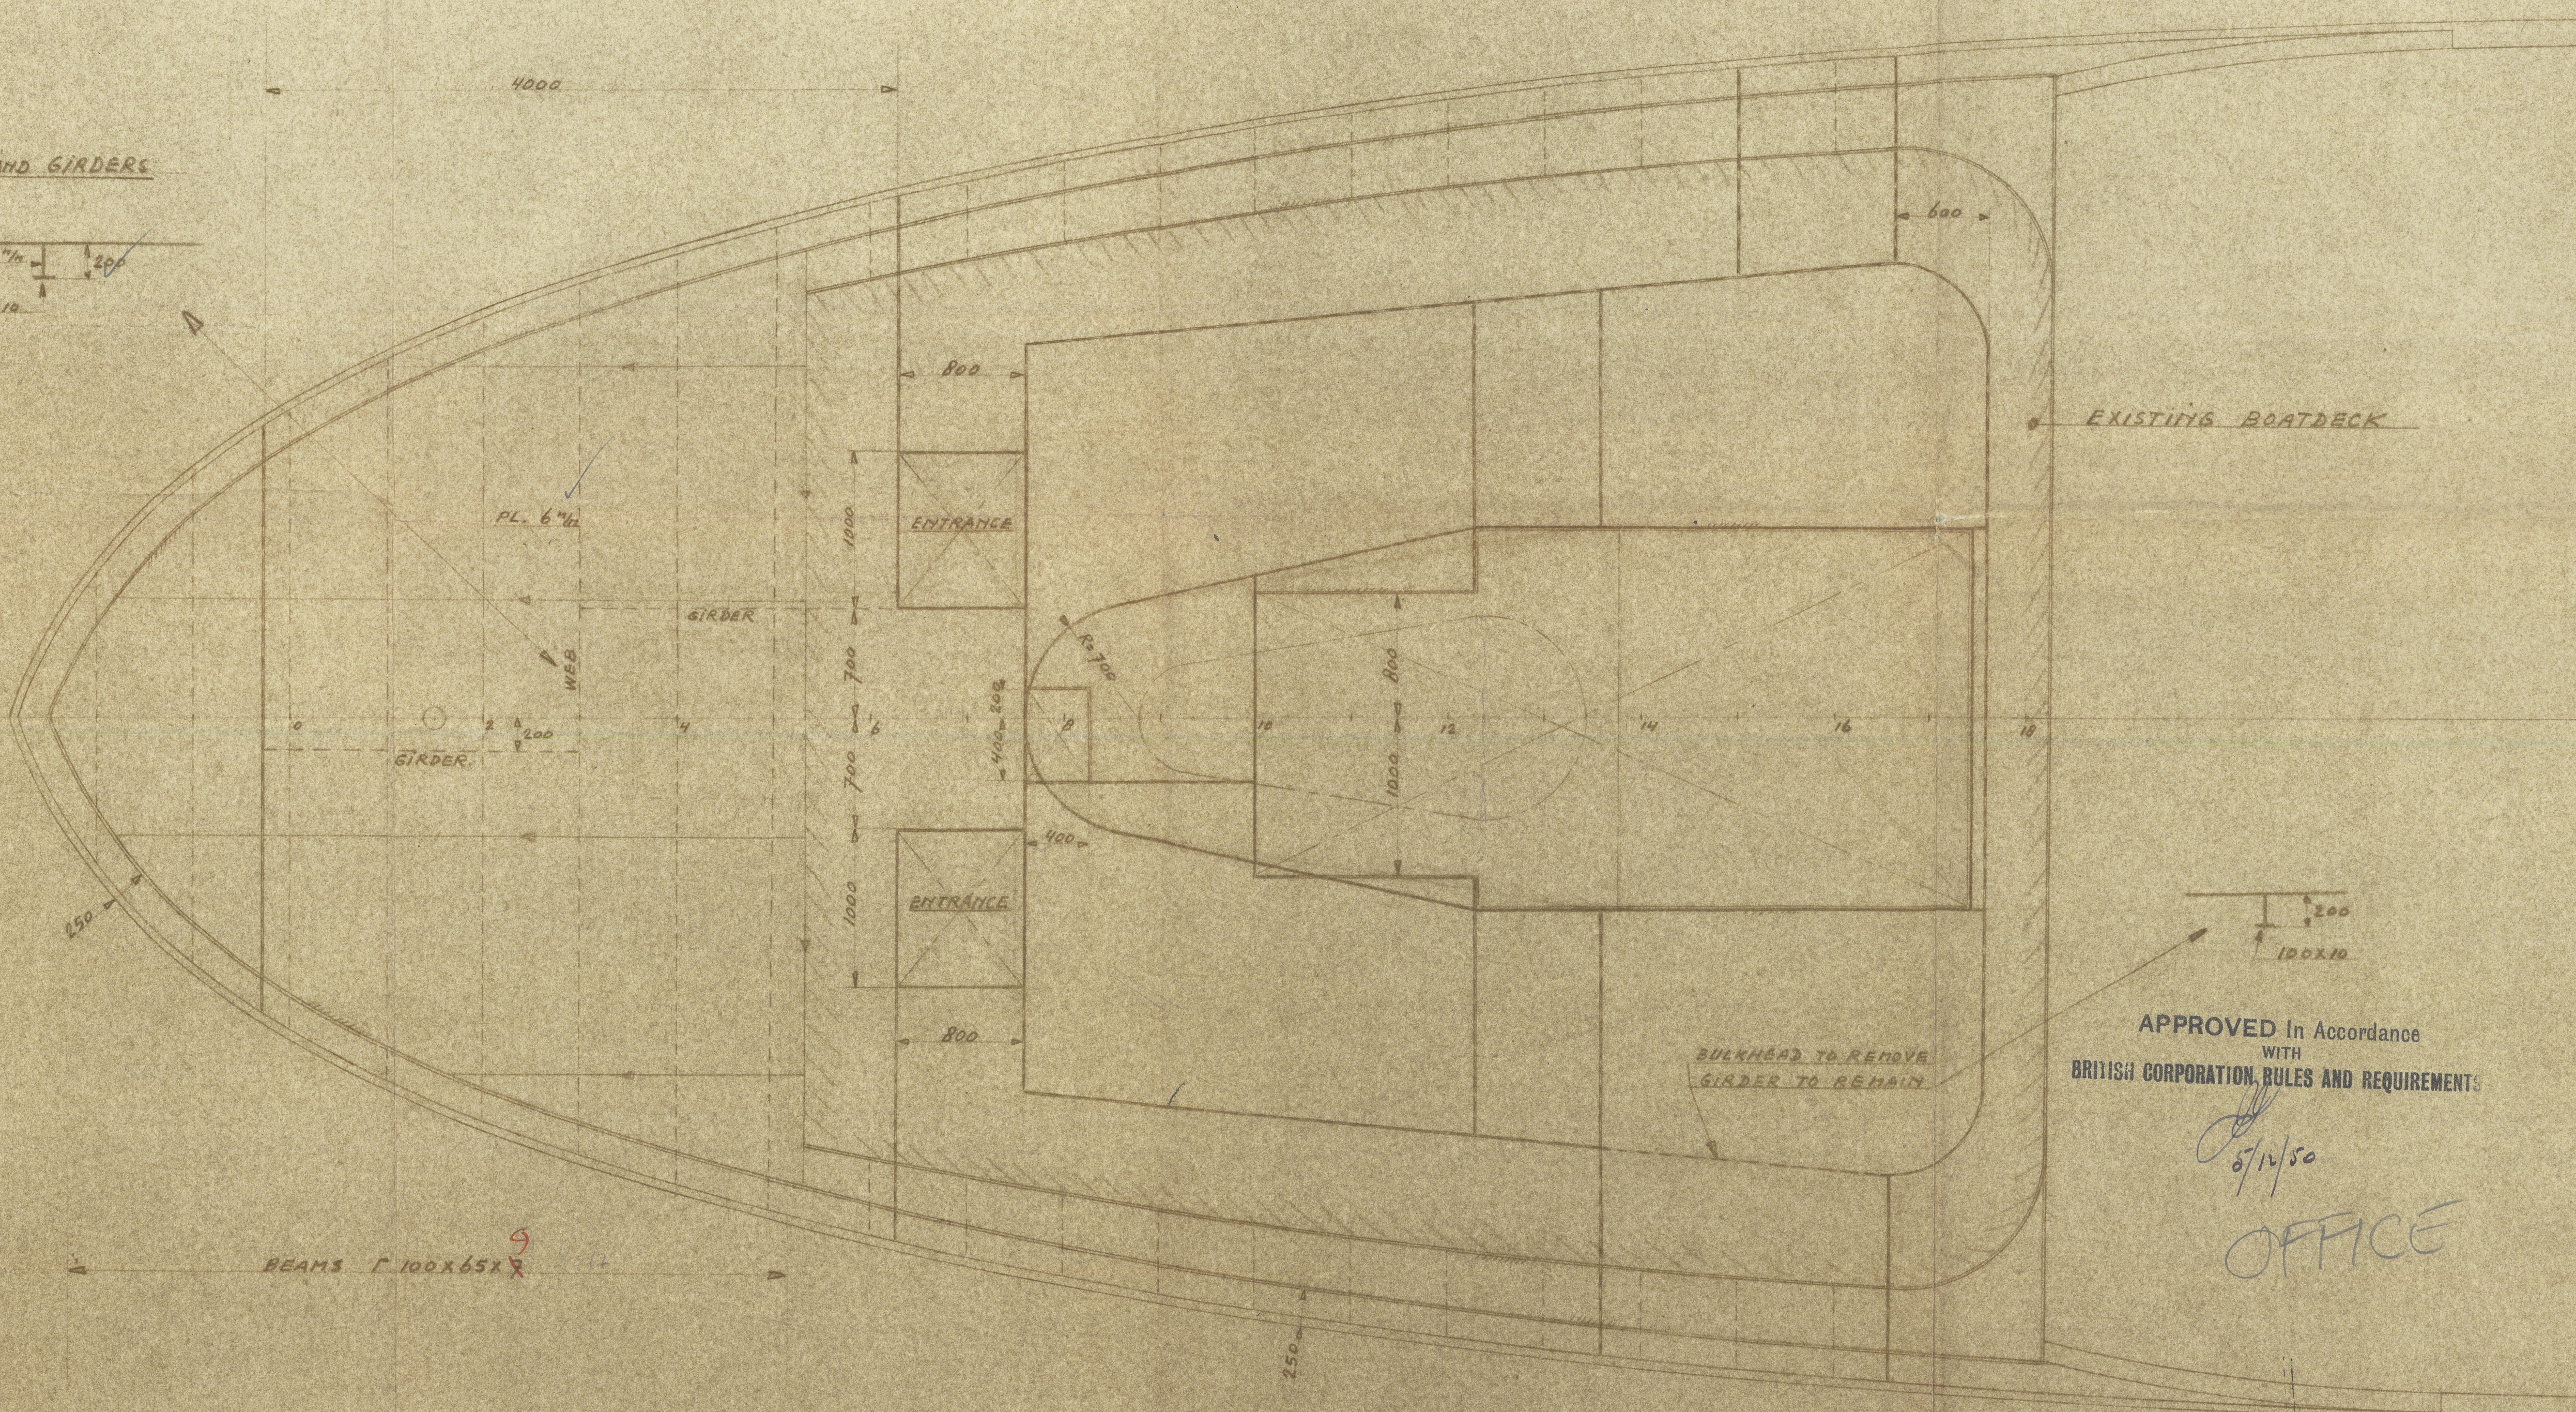

WEB AND GIRDERS

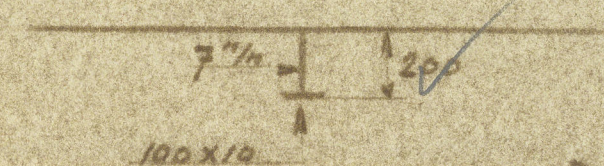

APPROVED In Accordance
WITH
BRITISH CORPORATION RULES AND REQUIREMENTS

6/14/50

OFFICE

M.V. "ORCA"	ORDER NO.	SCALE 1:25
EXTENSION BOATDECK AND POOP-SIDE	DRAW. NO.	100 X 10
	DE. 11.11.50	
	ZALTBOMME	

"
Nigeria."

Extension board deck + poop-side.

Port rept No. 33531.



© 2021

Lloyd's Register
Foundation

010067-010078-0270