



P.

48

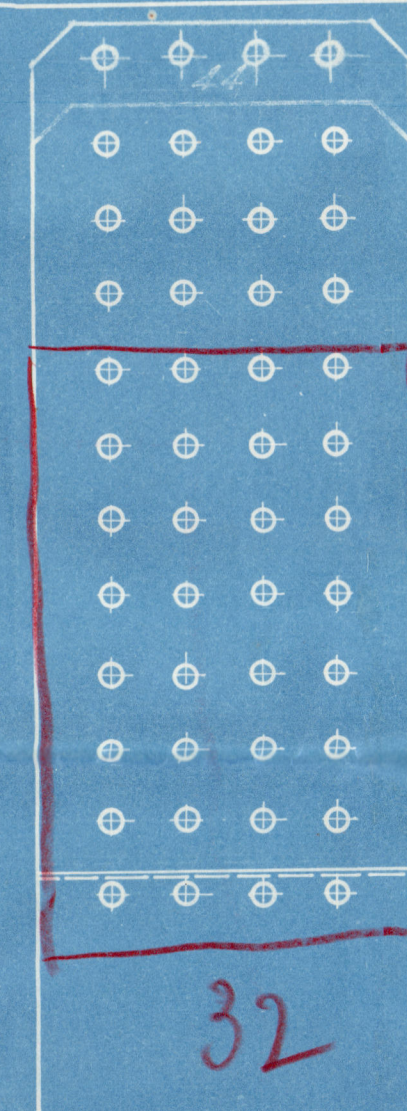


32

91

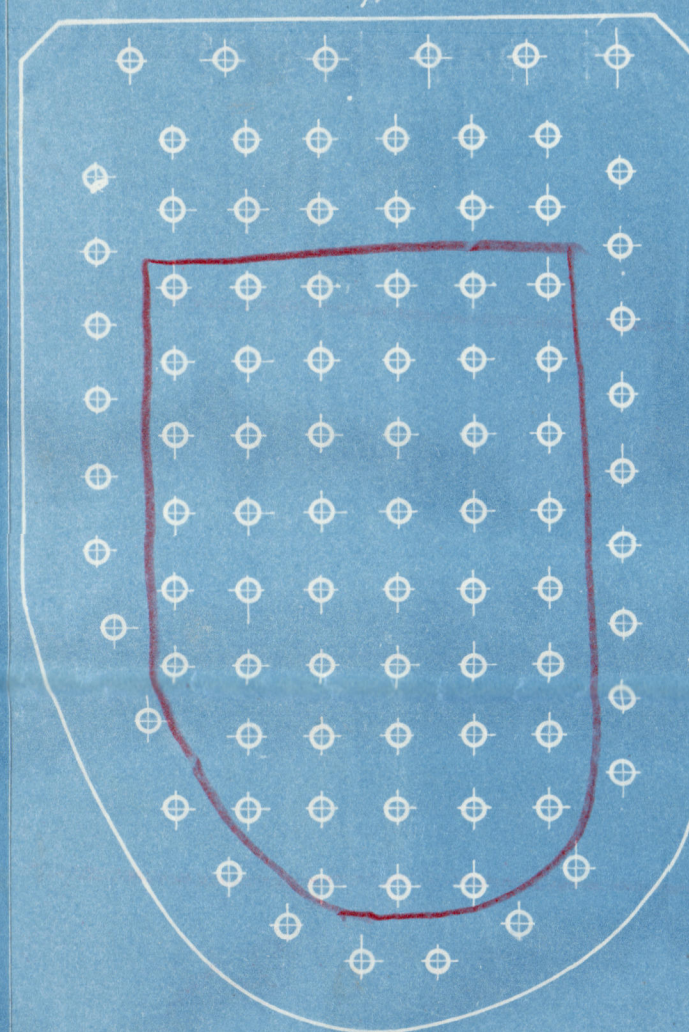


49

44

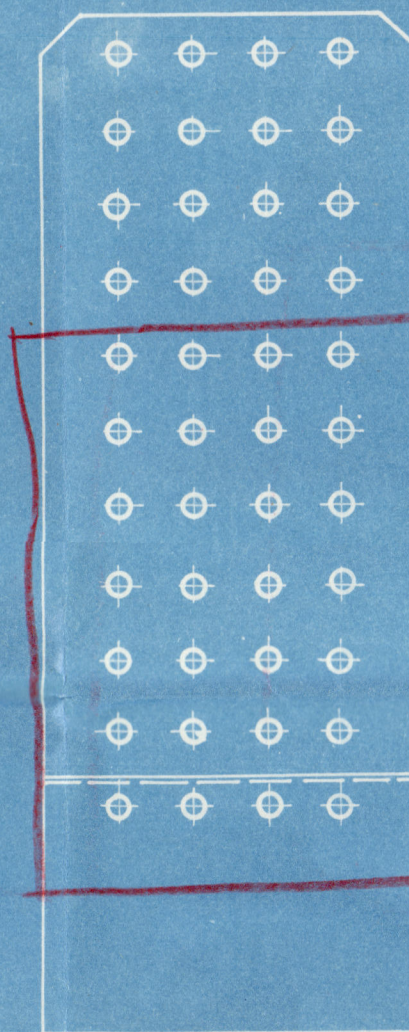


28

44

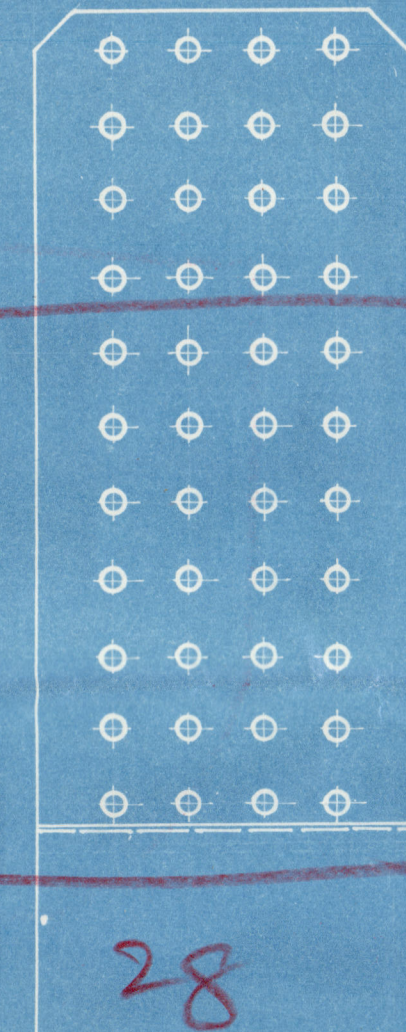


87

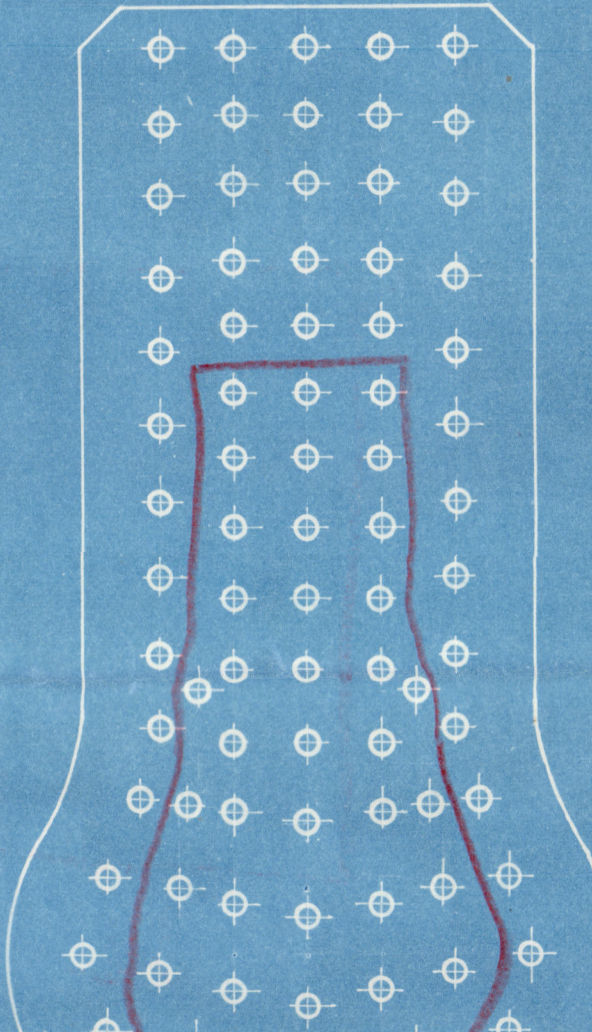


39

44

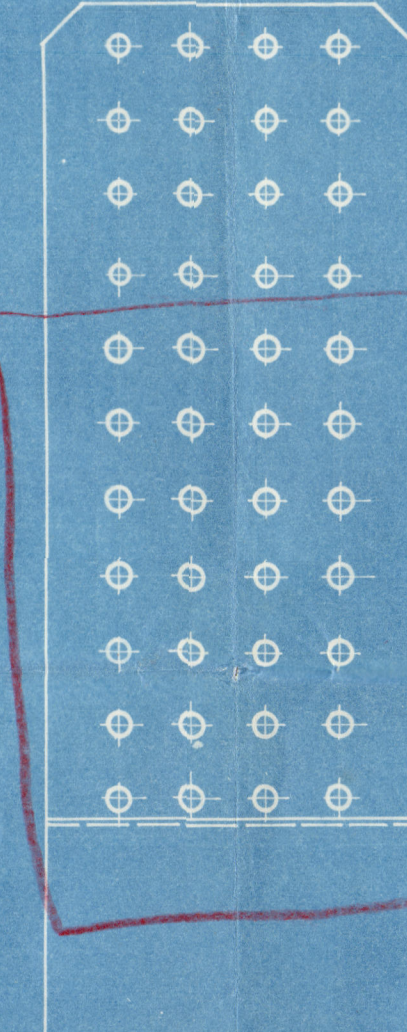


28

44

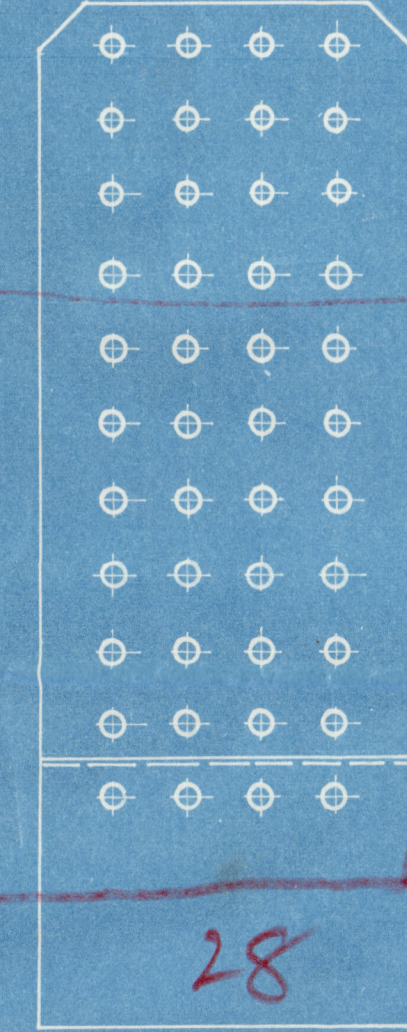


91

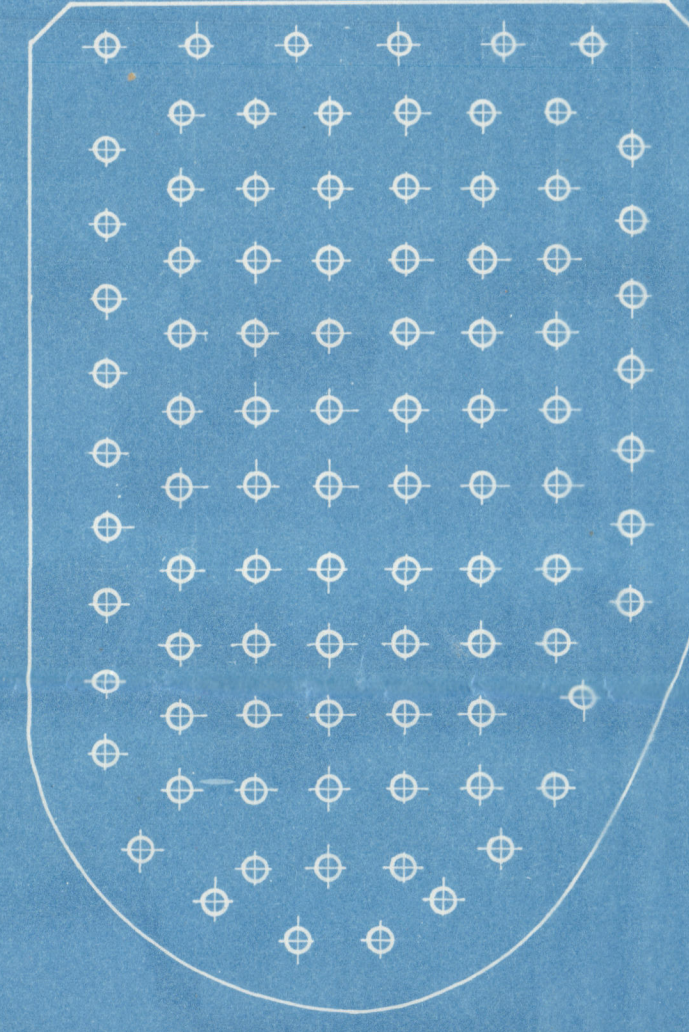

49

48

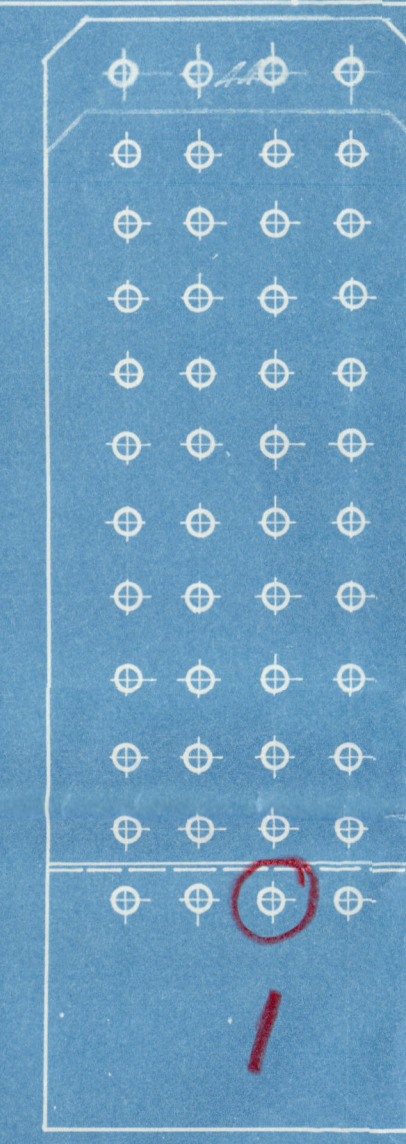


1

SCREW STAYS PLAN.


S.

48

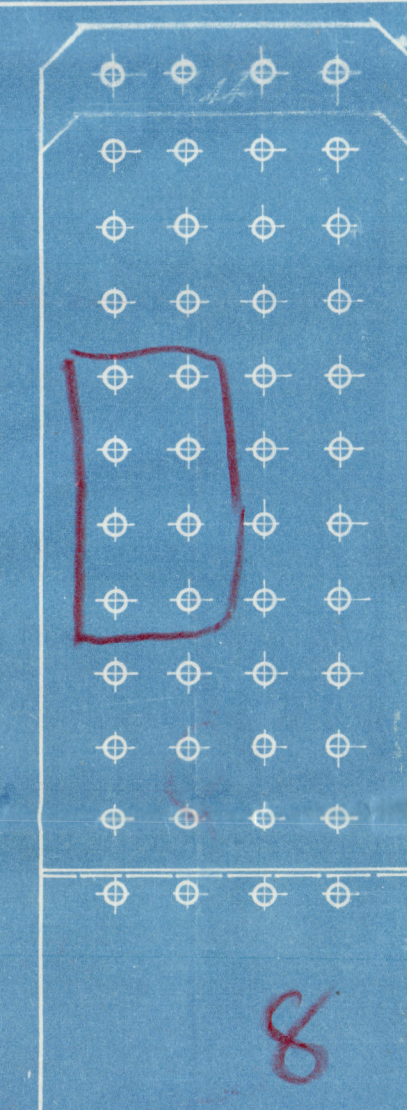


8

91

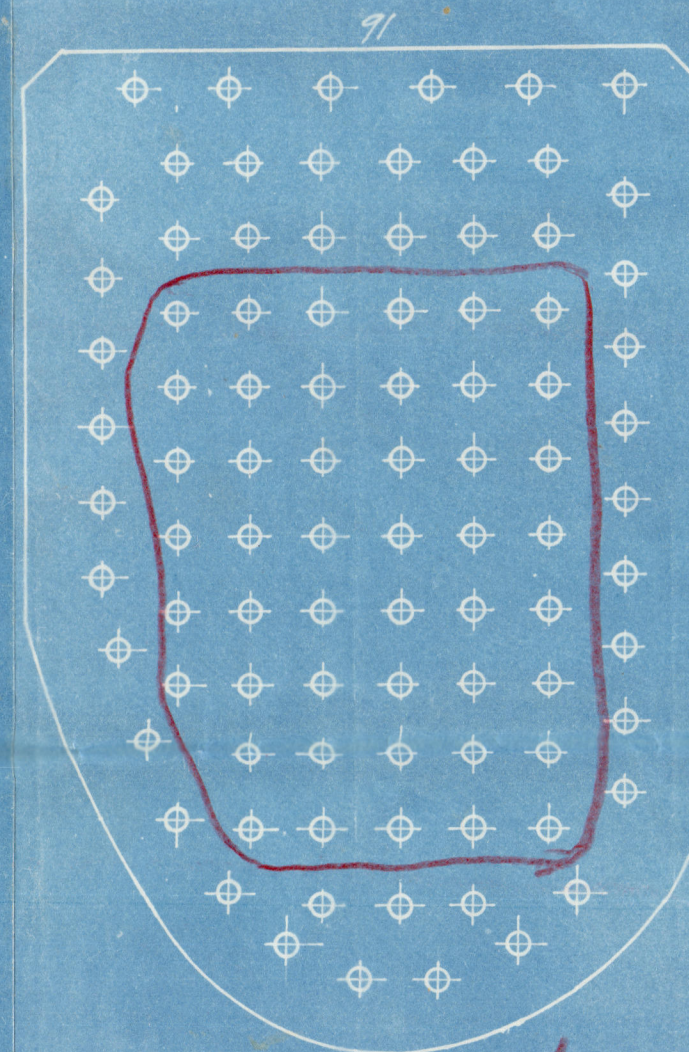


46

44

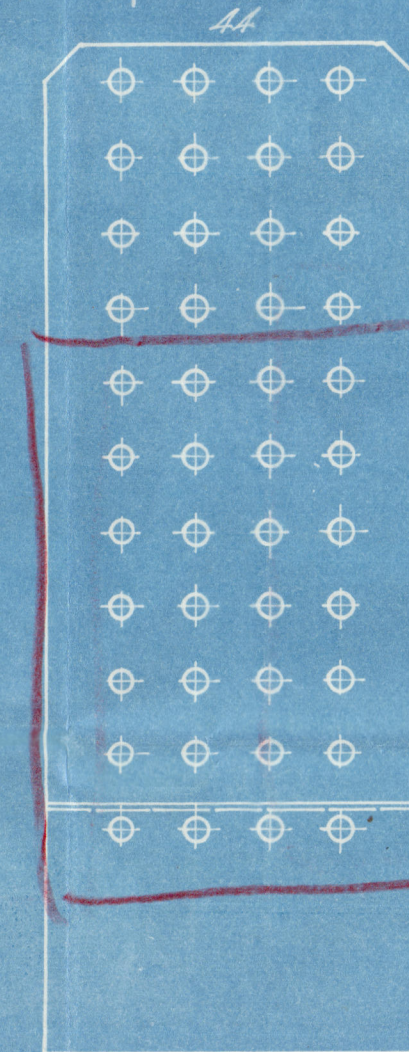


28

44

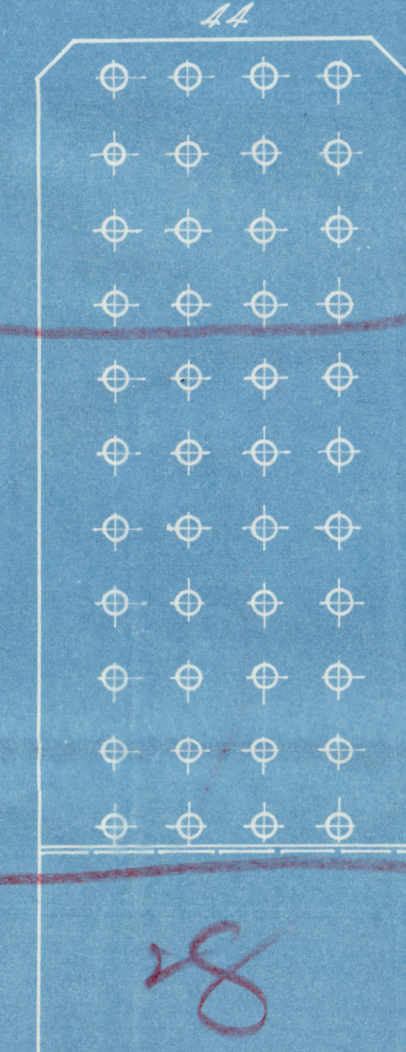


87

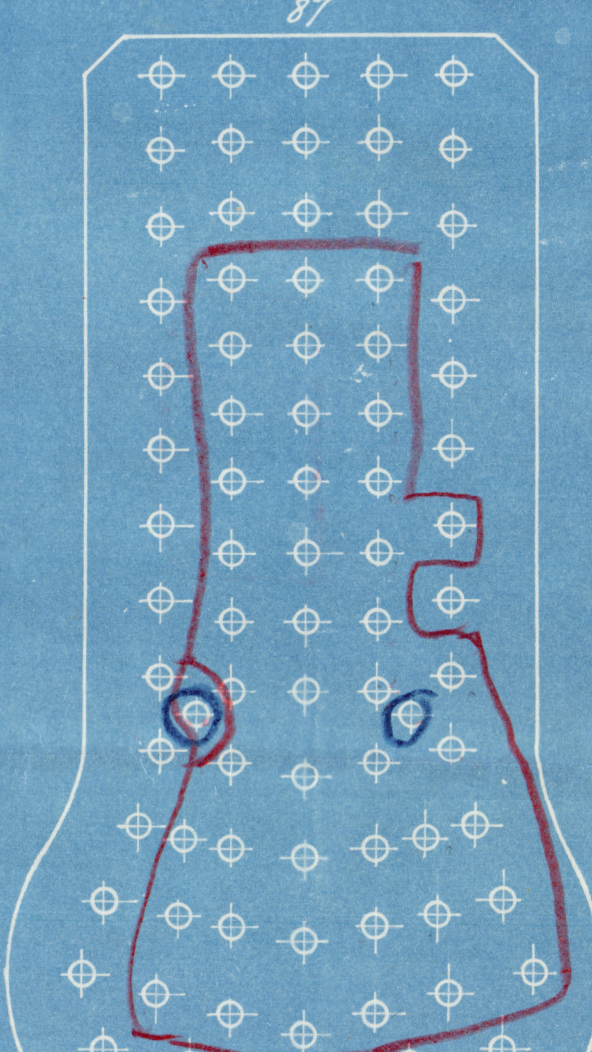


45

44

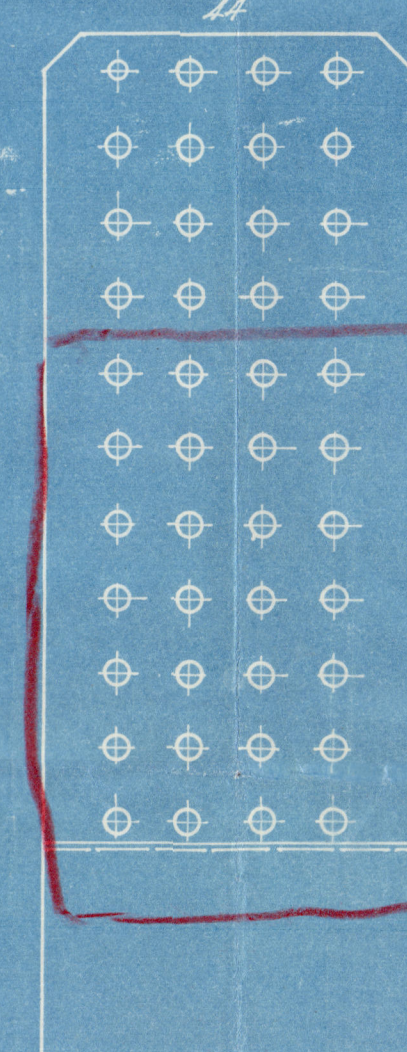


28


44

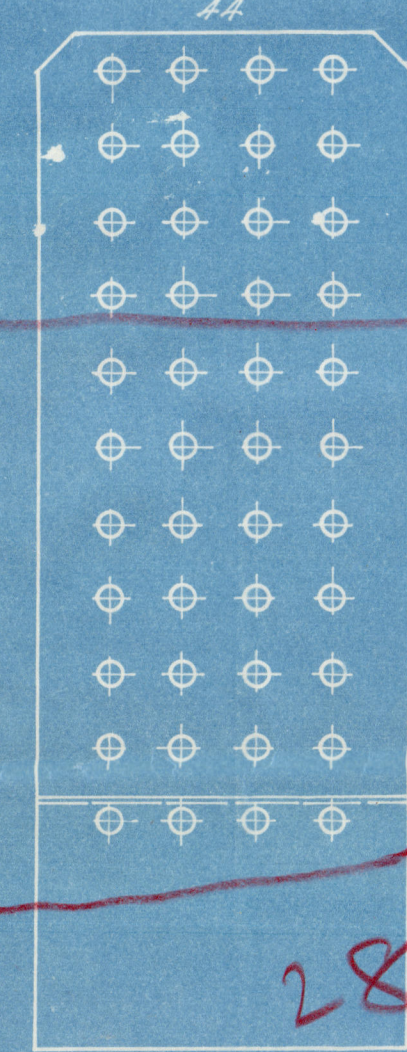

91

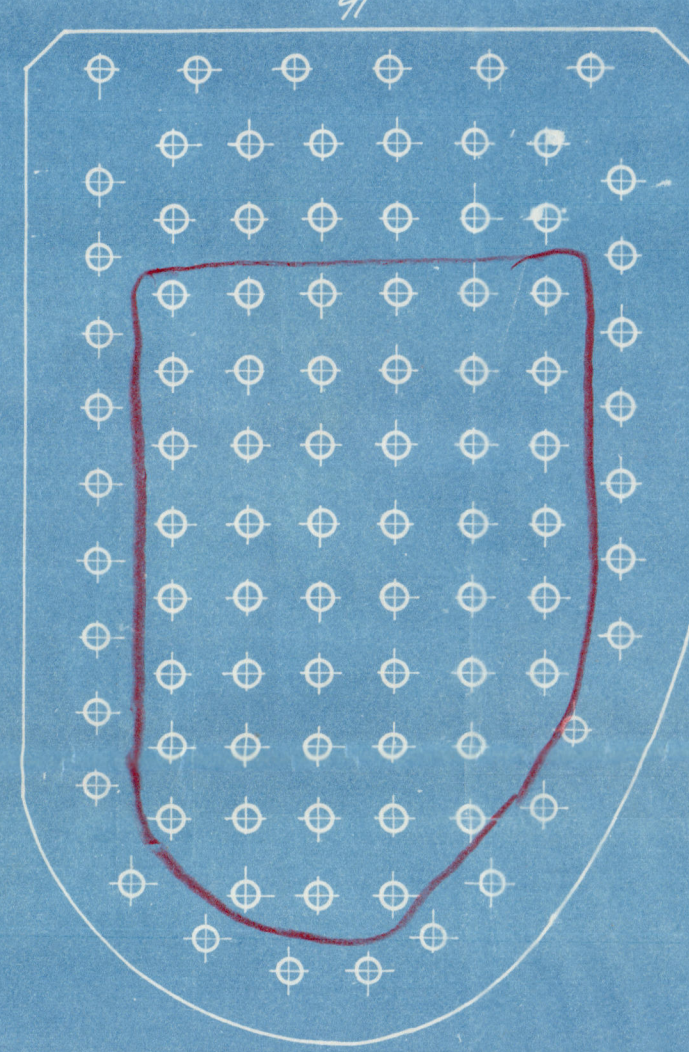


28

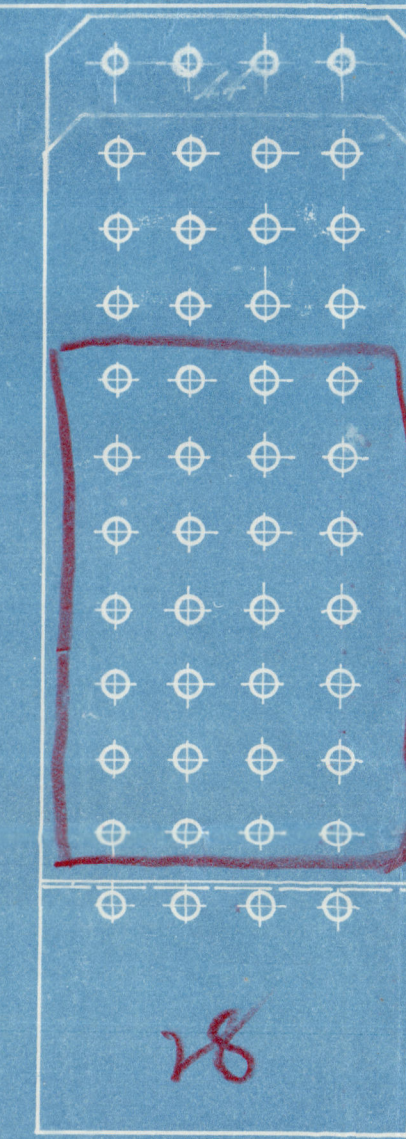

SCREW STAYS PLAN.


120

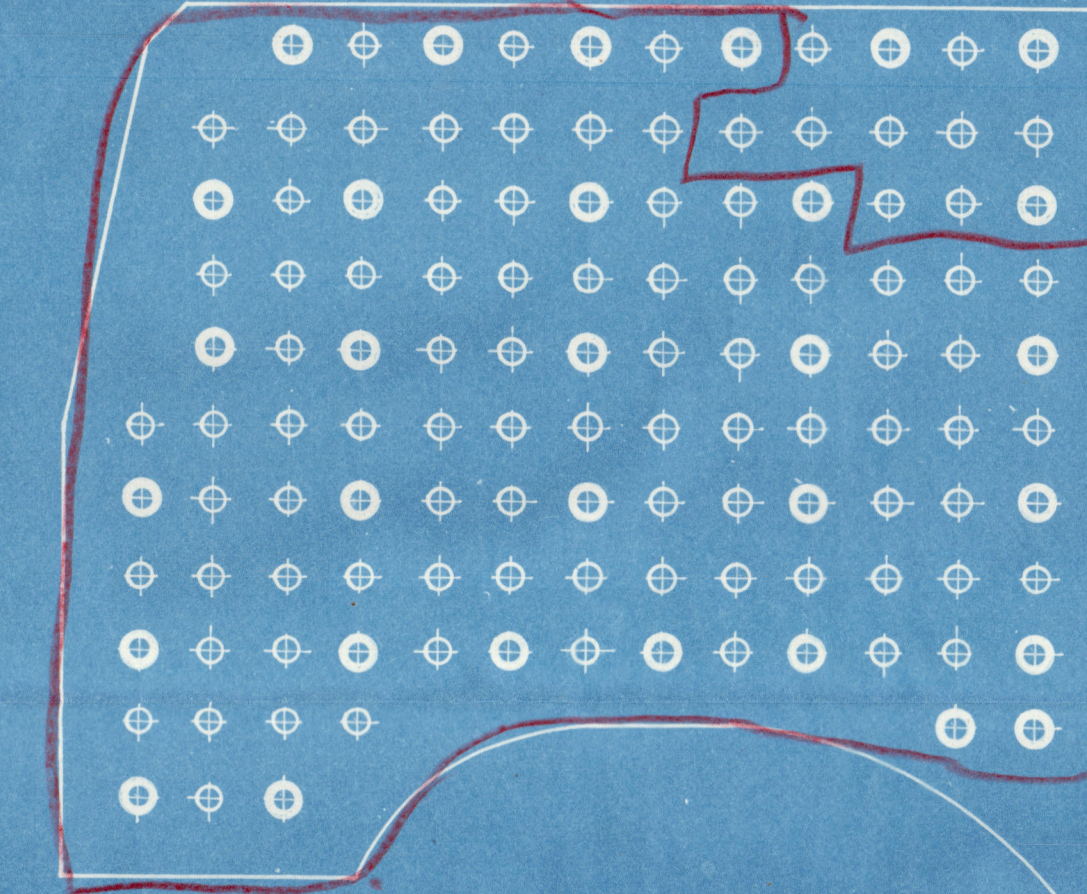


80 ordinary tubes changed

○ = 89 Ordinary Tubes.
● = 31 Stay Tubes.

120

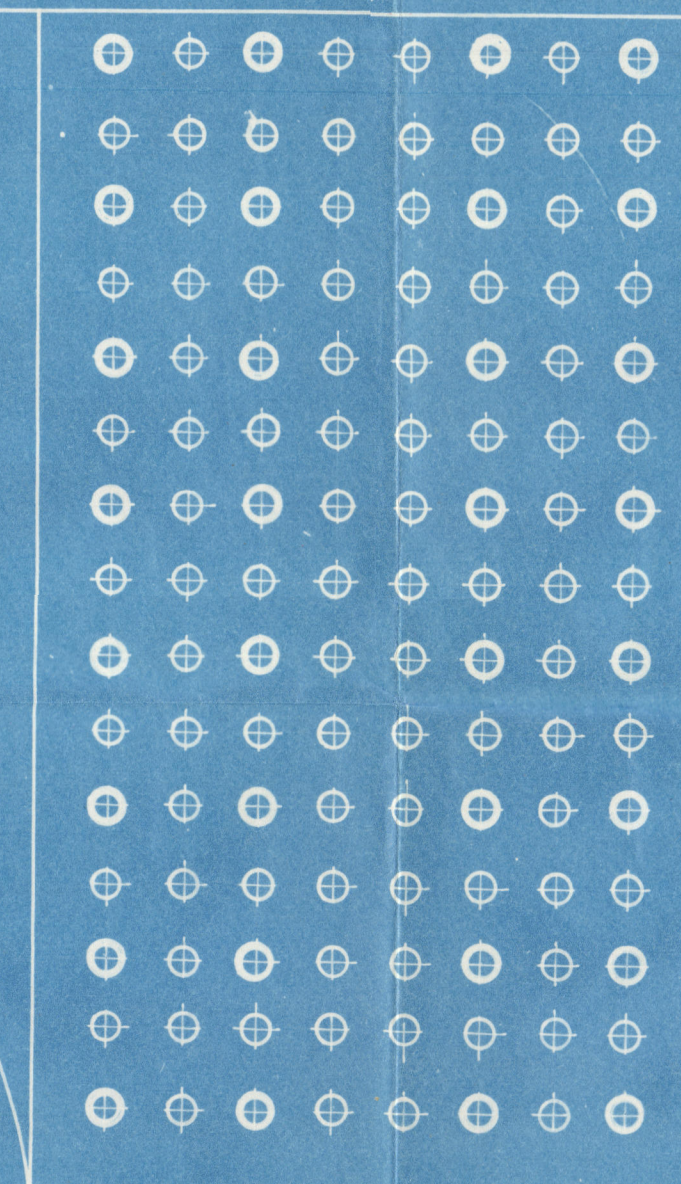○ = 88 Ordinary Tubes.
● = 32 Stay Tubes.

120

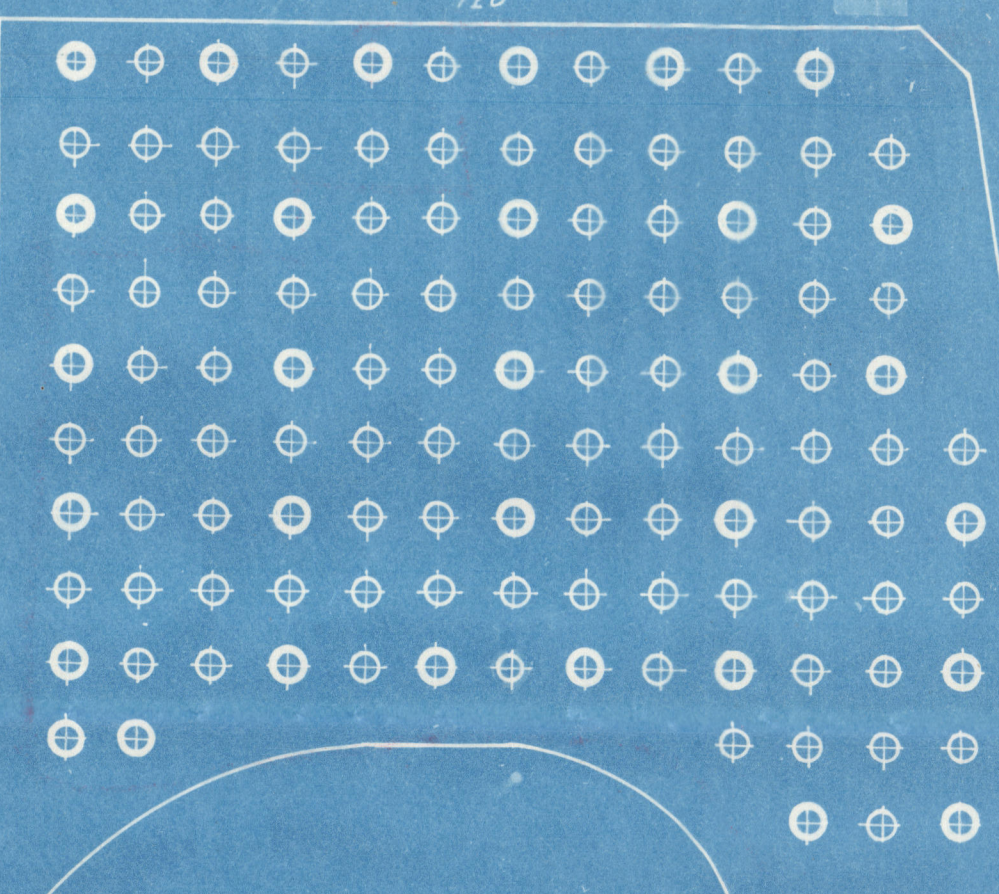○ = 89 Ordinary Tubes.
● = 31 Stay Tubes.


ORDINARY TUBES & STAY TUBES PLAN.

○ = 88 Ordinary Tubes.
● = 32 Stay Tubes.

P.


S.

48

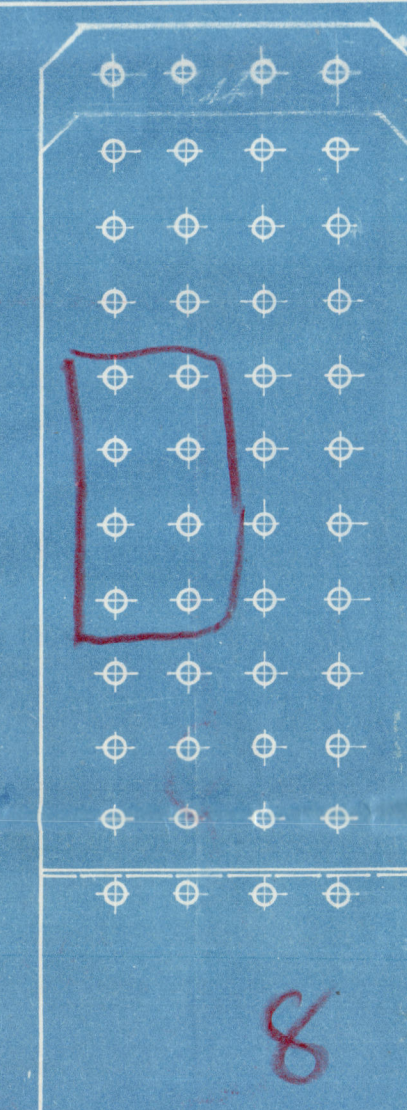


8

91

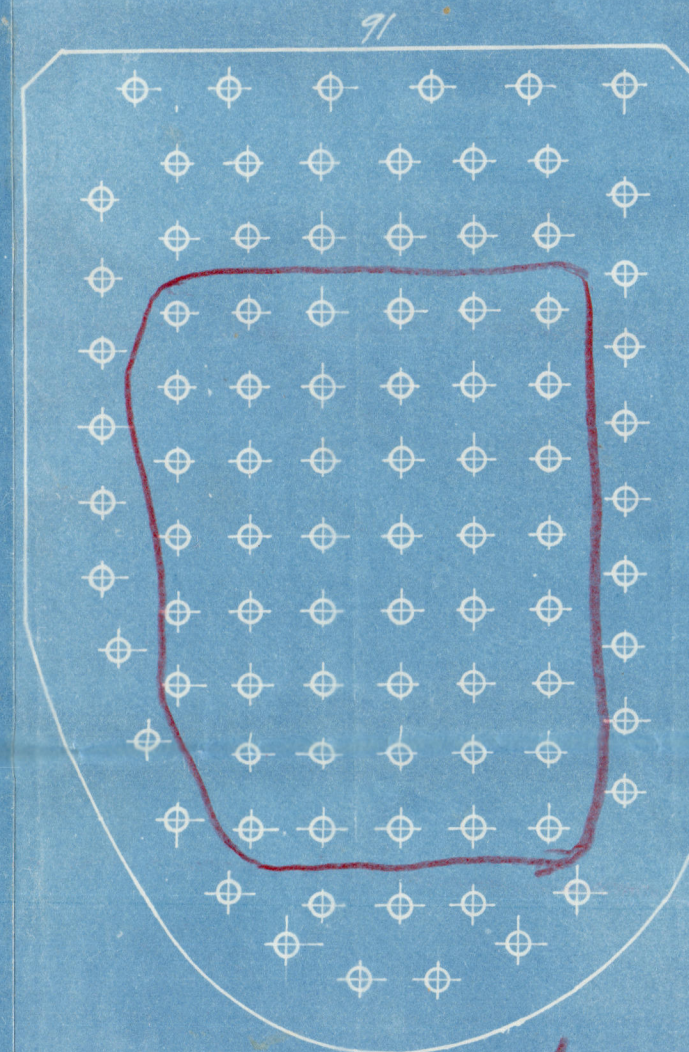


46

44

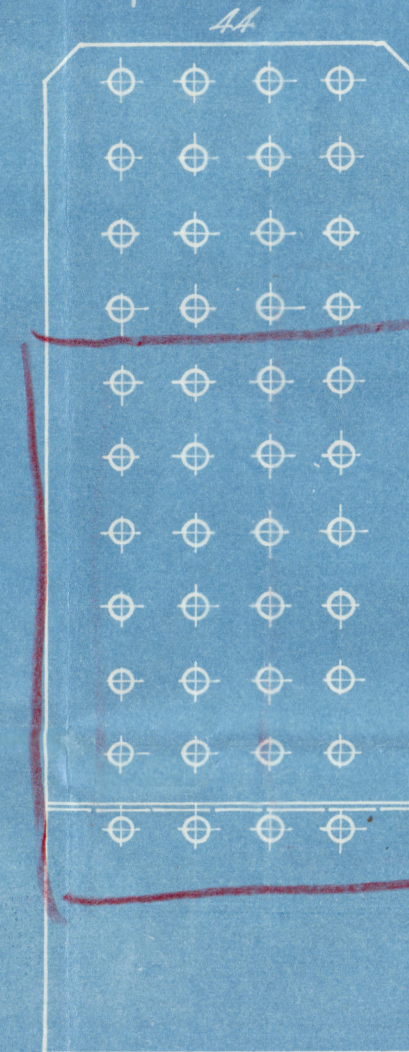


28

44

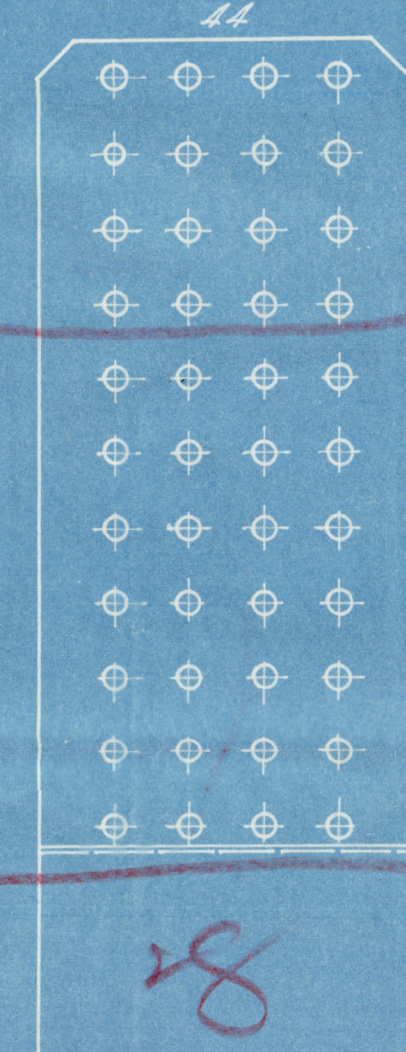


87

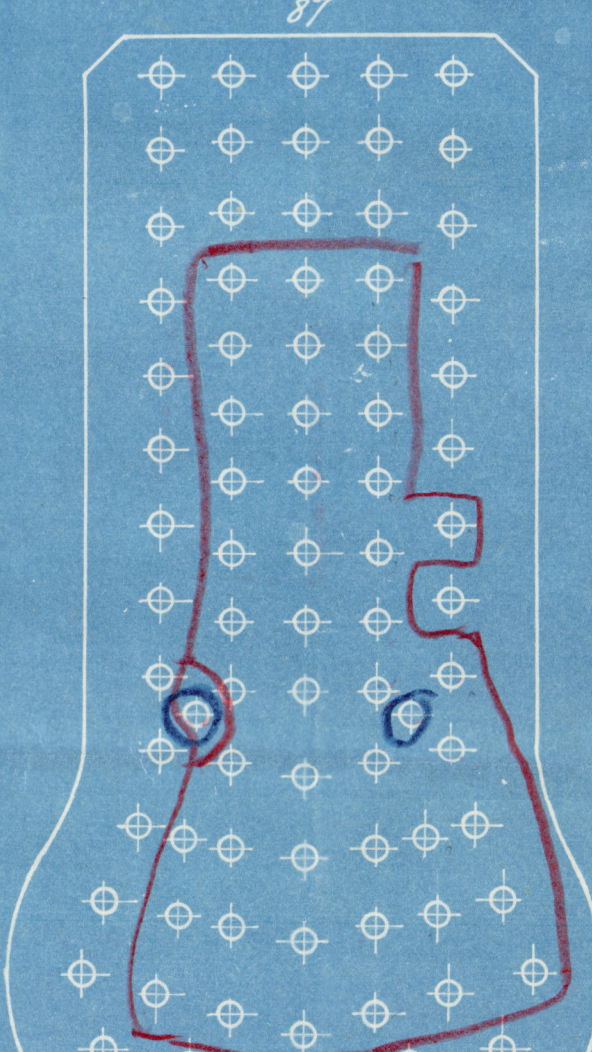


45

44

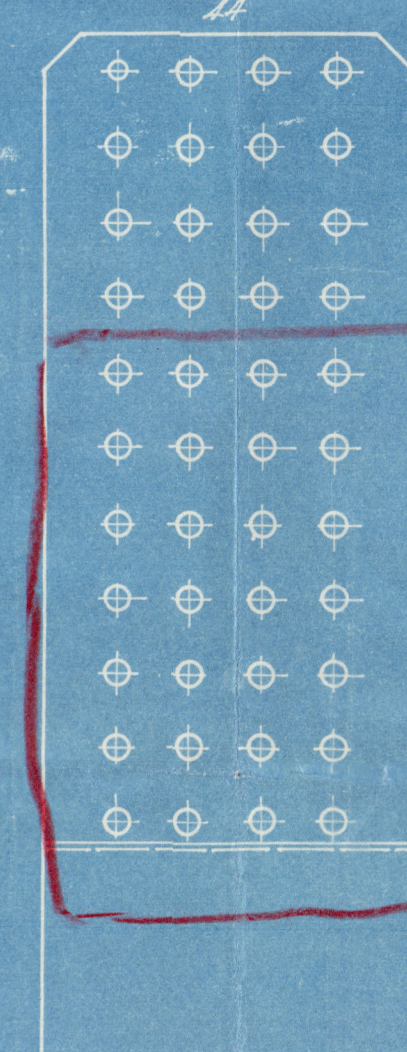


28


44

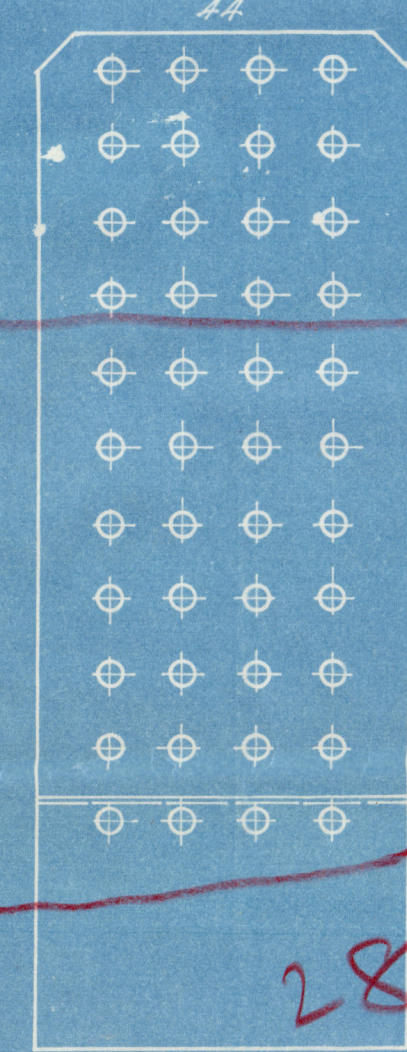

91

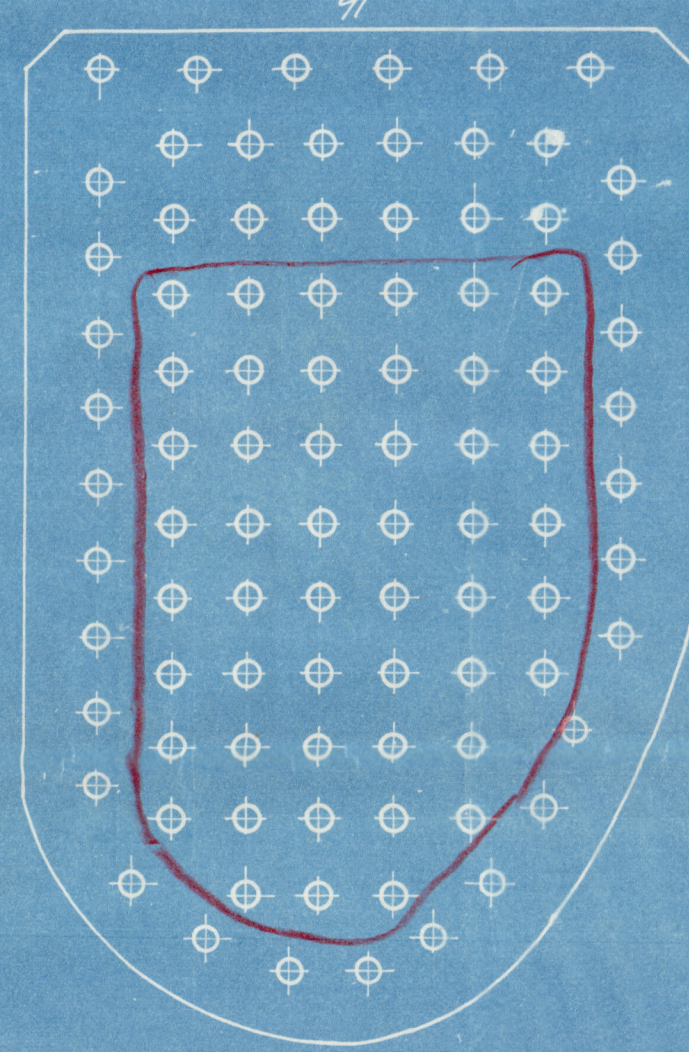


28

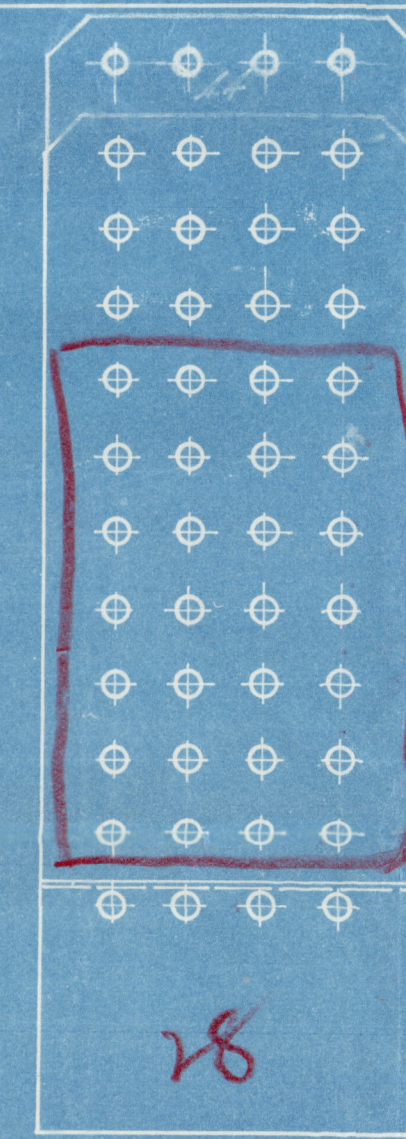

SCREW STAYS PLAN.


120

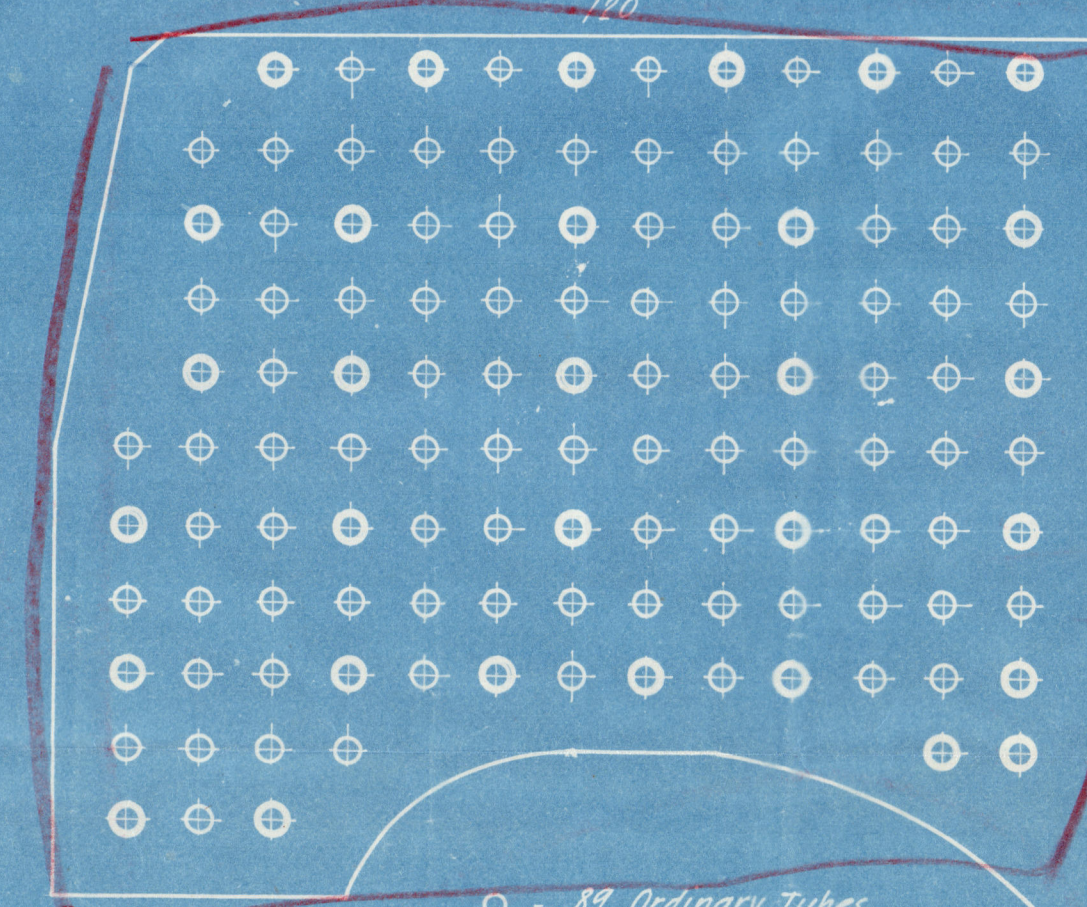


89 ordinary tubes changed

○ = 89 Ordinary Tubes.
● = 31 Stay Tubes.

120

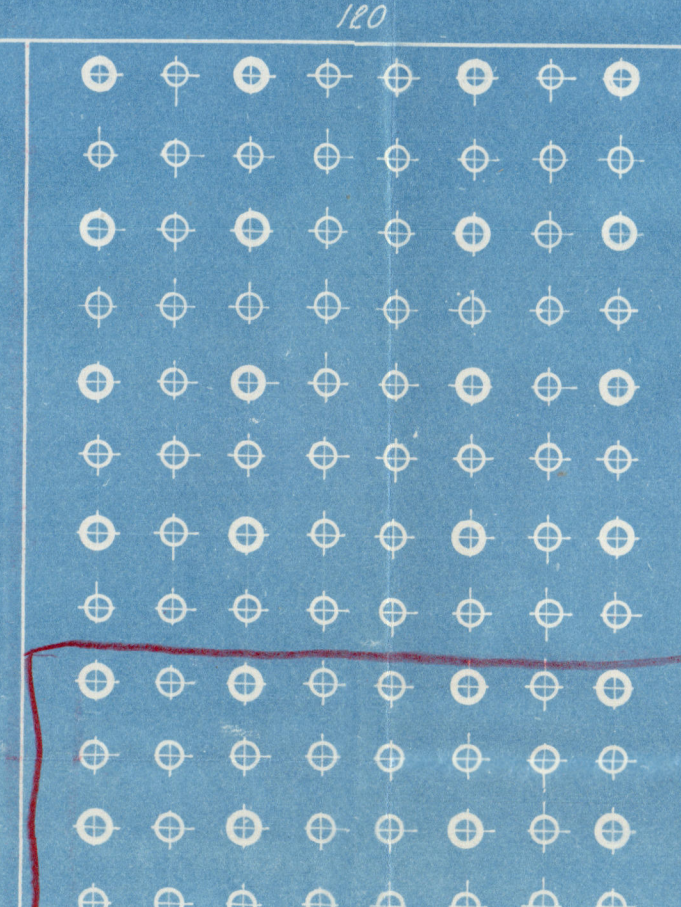○ = 88 Ordinary Tubes.
● = 32 Stay Tubes.

120

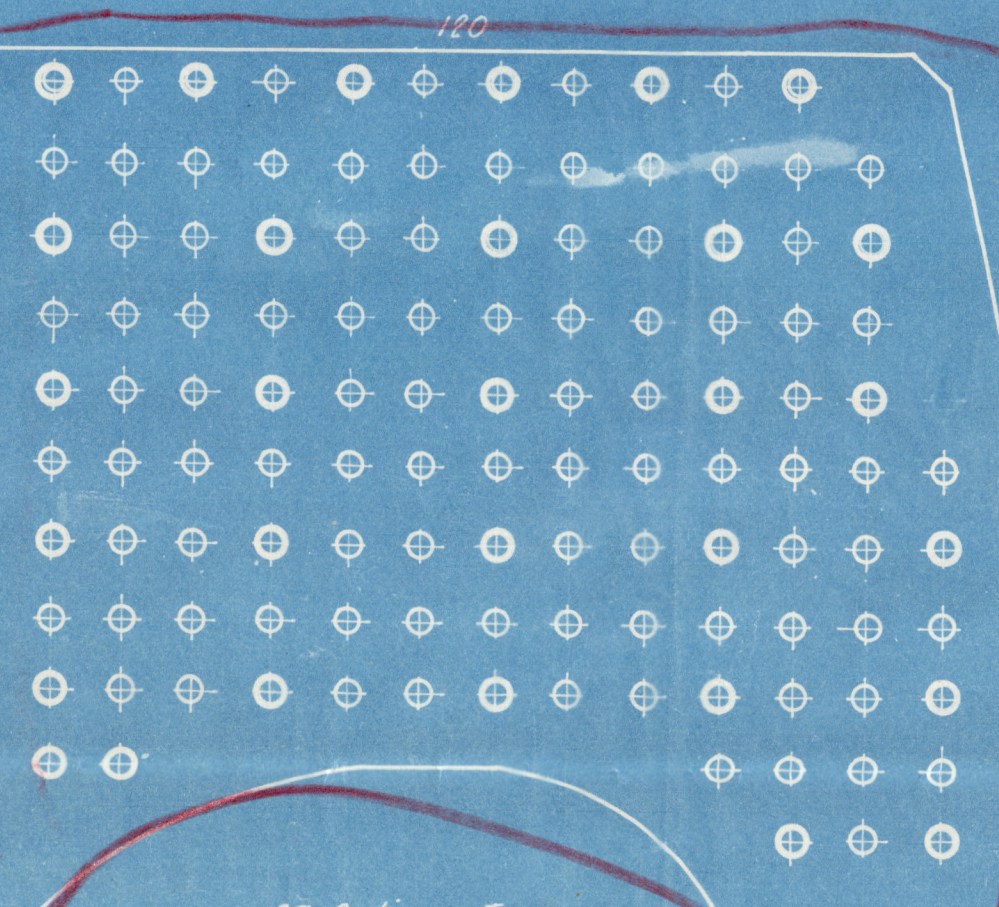○ = 89 Ordinary Tubes.
● = 31 Stay Tubes.

ORDINARY TUBES & STAY TUBES PLAN.

○ = 88 Ordinary Tubes.
● = 32 Stay Tubes.

S.

S.S. NANGSUANGNAWA.

SCREW STAYS PLAN, ORDINARY TUBES -
AND STAY TUBES PLAN.
NOT TO SCALE.

89 ordinary tubes changed

Lloyd's Register
Foundation

010039-010045-0269

S/S "NANG SUANG NAWA"

RPT. NO. Bgk. 1410.



© 2021

Lloyd's Register
Foundation

010089-010095-0269