

# T.S.S. HAKONE MARU.

## STERN FRAME & SHAFT BRACKET.


SCALE  $\frac{1}{2}$  INCH TO ONE FOOT.

MATERIAL: DUCTILE CAST STEEL.

WEIGHTS:-  
STERN FRAME 5.3 TONS.  
SHAFT BRACKET 12.8 TONS.

### DETAILS.

SCALE:-  $\frac{1}{2}$  TO ONE FOOT

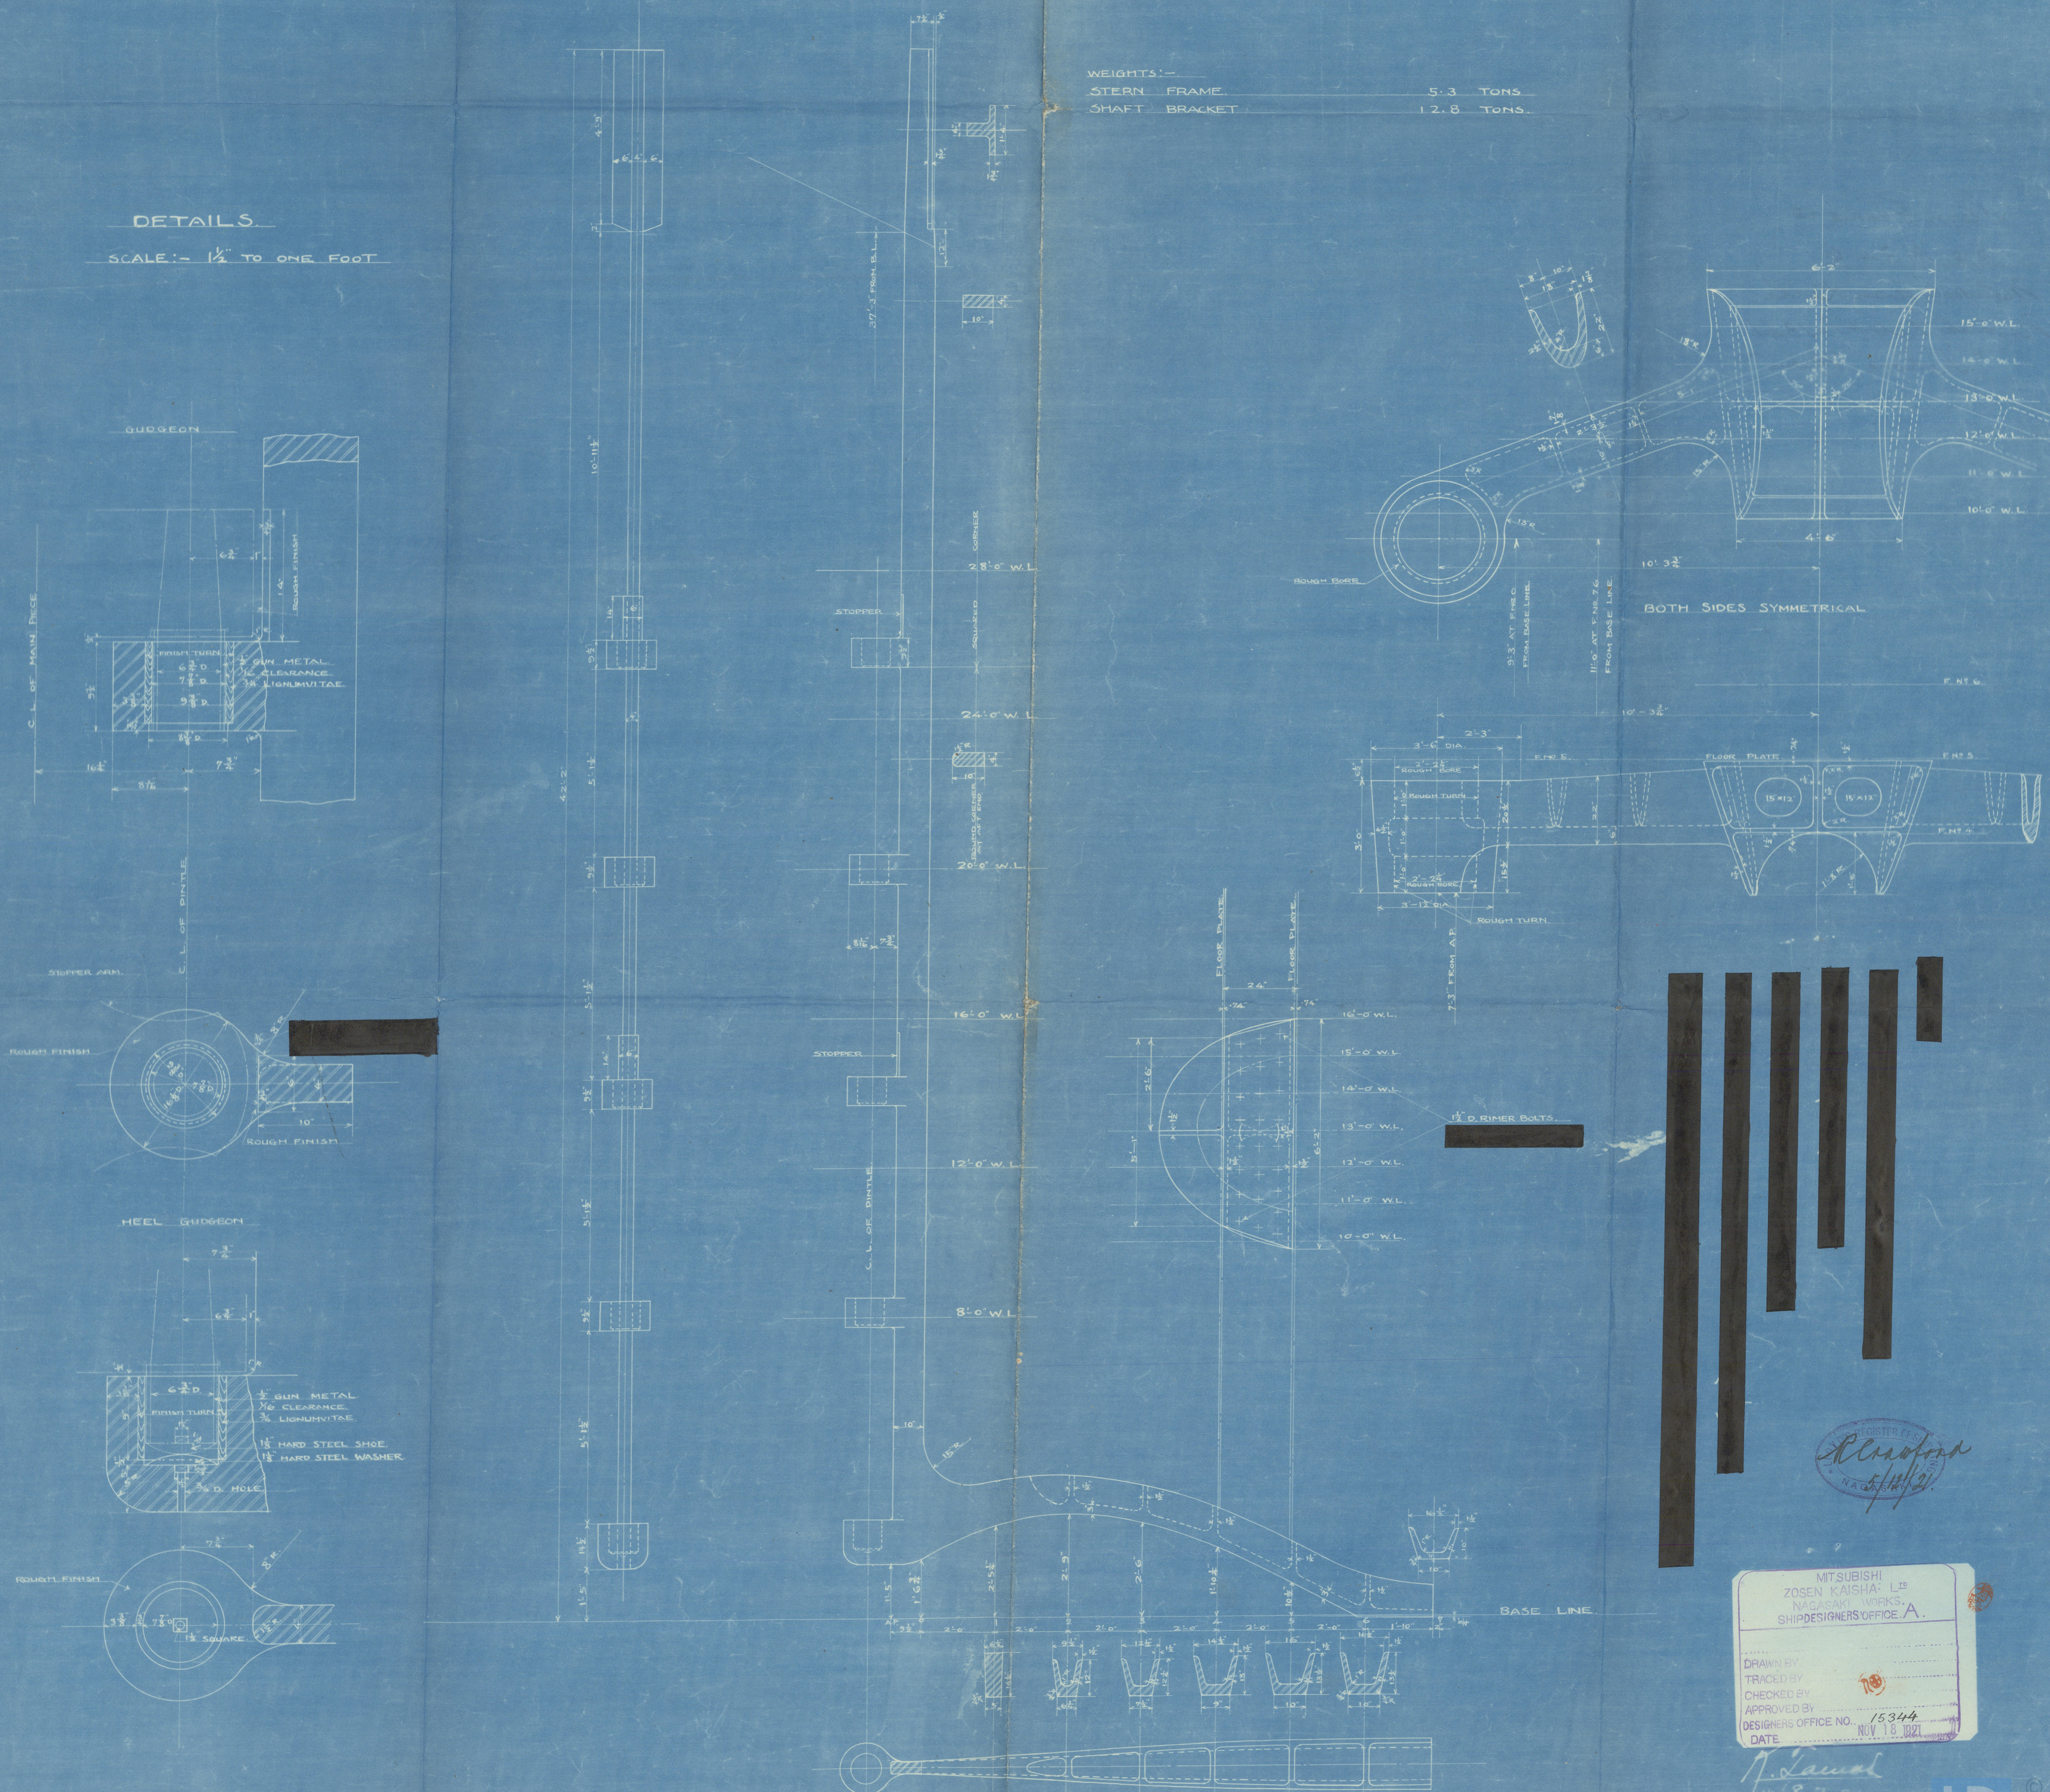

*Handwritten signature: J. Samuel*

MITSUBISHI  
ZOSEN KAISHA LTD.  
NAGASAKI WORKS  
SHIP DESIGNERS' OFFICE A.

DRAWN BY  
TRACED BY  
CHECKED BY  
APPROVED BY  
DESIGNER'S OFFICE NO. 15344  
DATE NOV. 18, 1921

Stern Frame re

S. S. No. 346.

Mitsubishi Zosen Kaisha.

Nagasaki, Report No. 1341.

"Akoni Maru"



© 2021

Lloyd's Register  
Foundation

010127-010136-0163