

23.4.07.

N^{OS} 537-538.

MIDSHIP SECTION.

DIMENSIONS 135'0" B.P. x 23'0" EX. x 13'0" M^{LD}

STEEL TO CLASS 100 A.I. FOR FISHING PURPOSES.

SCALE $\frac{1}{2}$ " = 1 FOOT.



NUMERALS.

DEPTH = 13.5
 $\frac{1}{2}$ BREADTH = 11.43
 $\frac{1}{2}$ GIRTH = 21.25
 $46.18 = 1^{ST} N^o$
 $133.80 = LENGTH.$
 369440
 13854
 13854
 4618
 $6178.8840 = 2^{ND} N^o$


$$\frac{L}{B} = 5.85$$

$$\frac{L}{D} = 9.91$$


EQUIPMENT.

ONE ANCHOR 6 CWTs. EX. STOCK.
 " " 5 1/2 " " "
 " " 3 " " "

120 FATHOMS 1/8" CABLE.
 60 " 6" HAWSER.
 60 " 5" WARP.

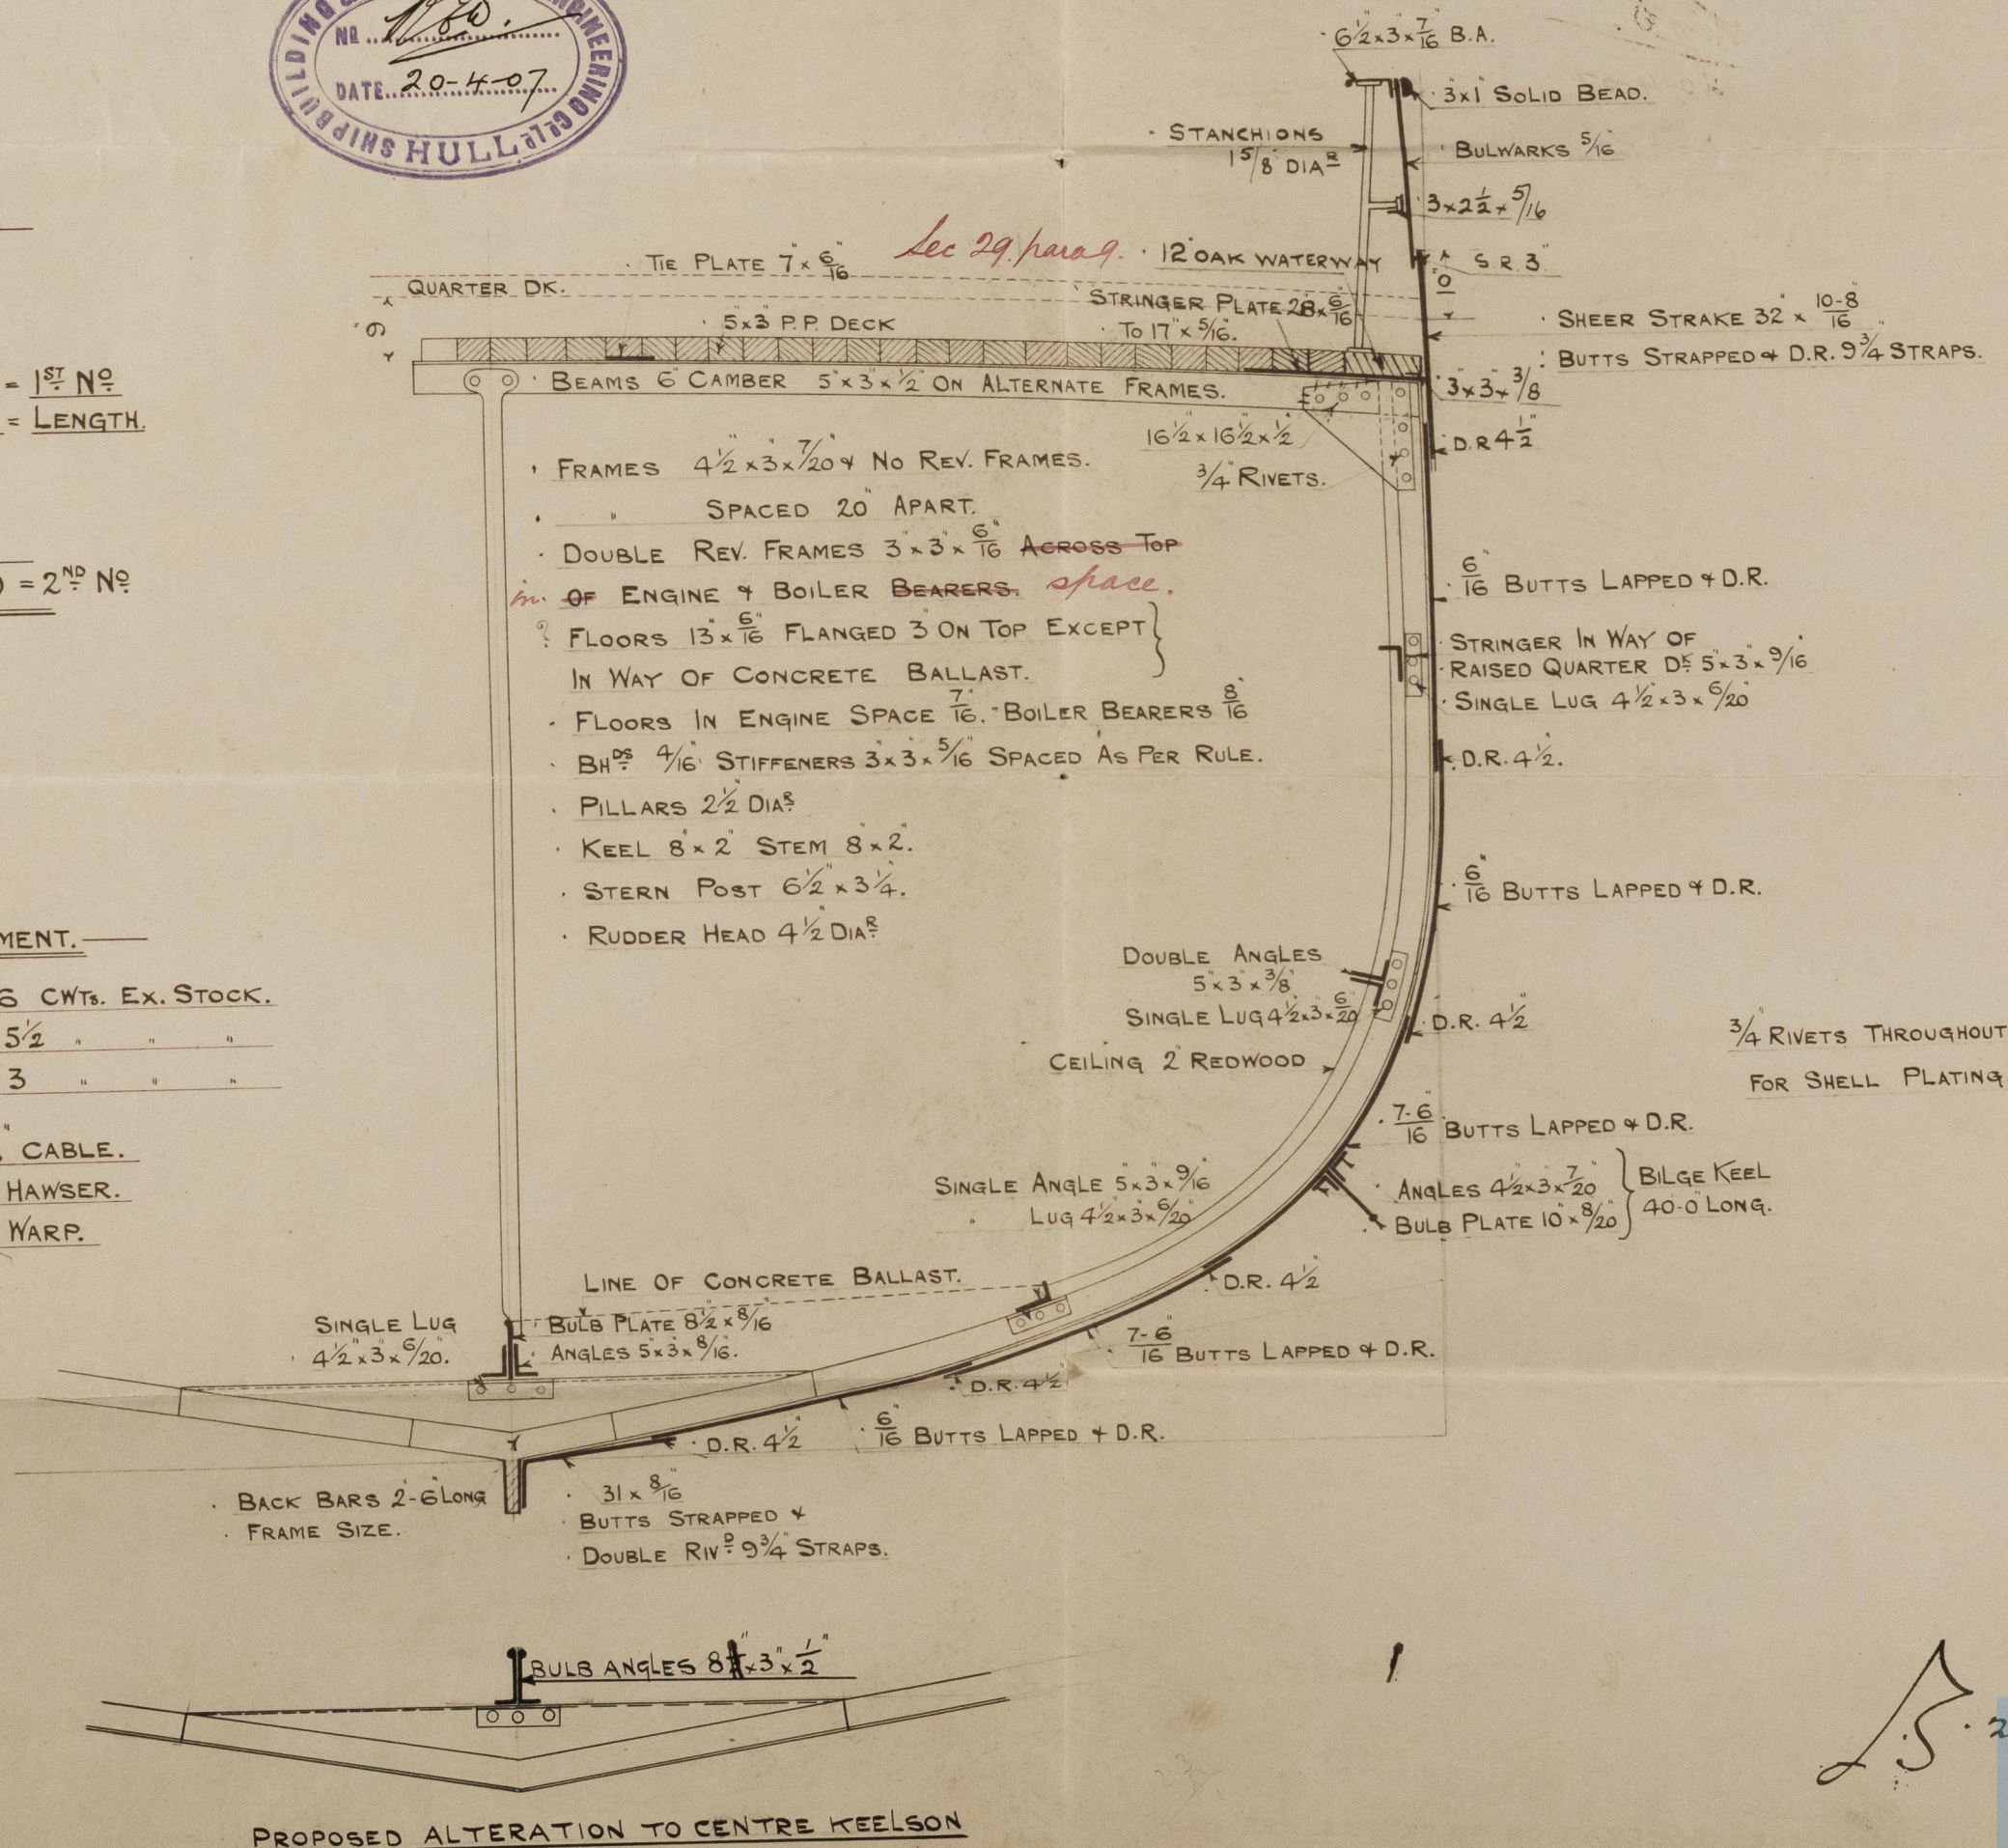

PROPOSED ALTERATION TO CENTRE KEELSON

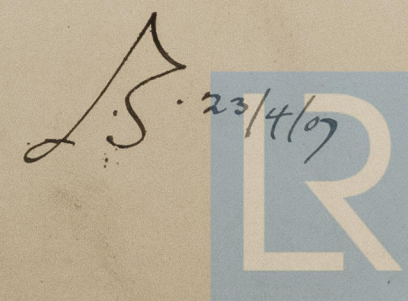

© 2020

Lloyd's Register Foundation

010137-010149-0111


Earle's S. & C.

No 537 + 538.

Midship Section.



s/s Lark Hull Report No:
" Maryjorie " " "

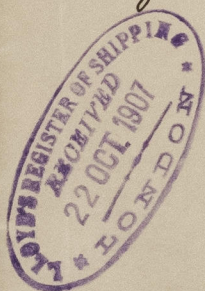

© 2020

Lloyd's Register
Foundation