
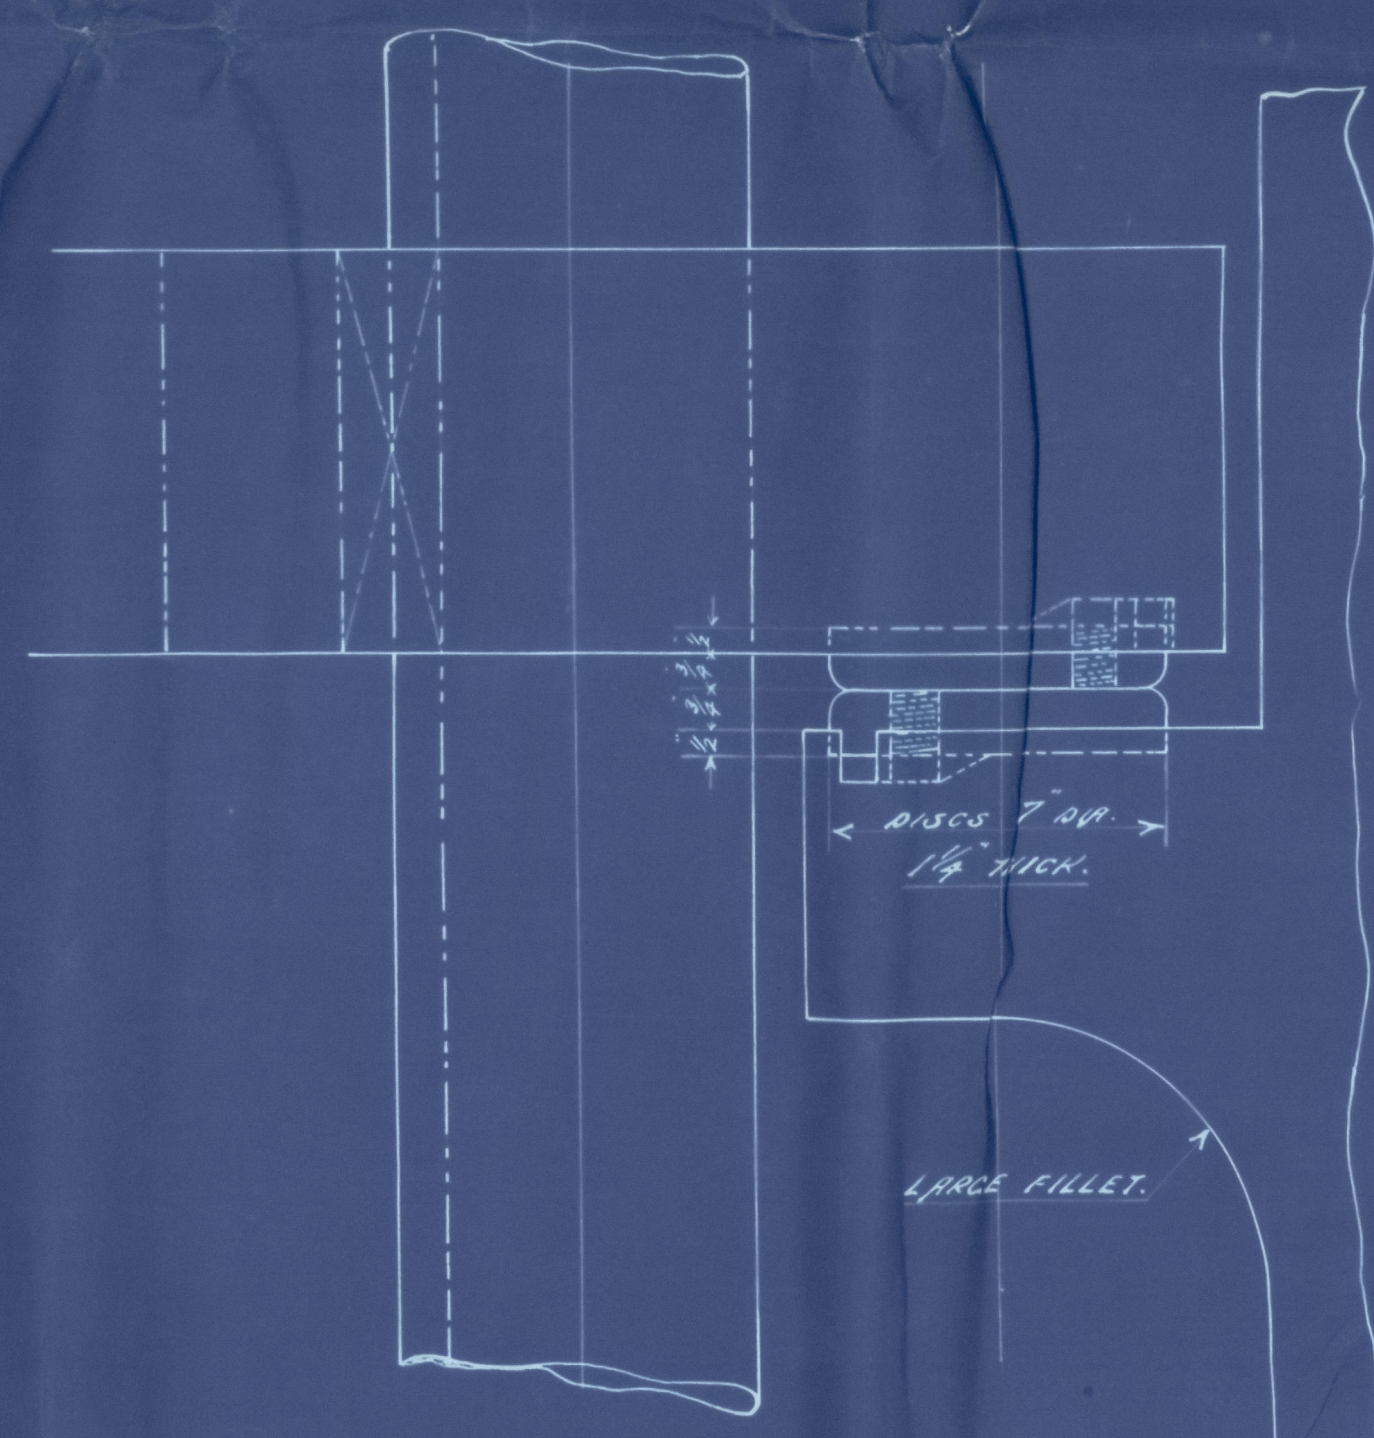
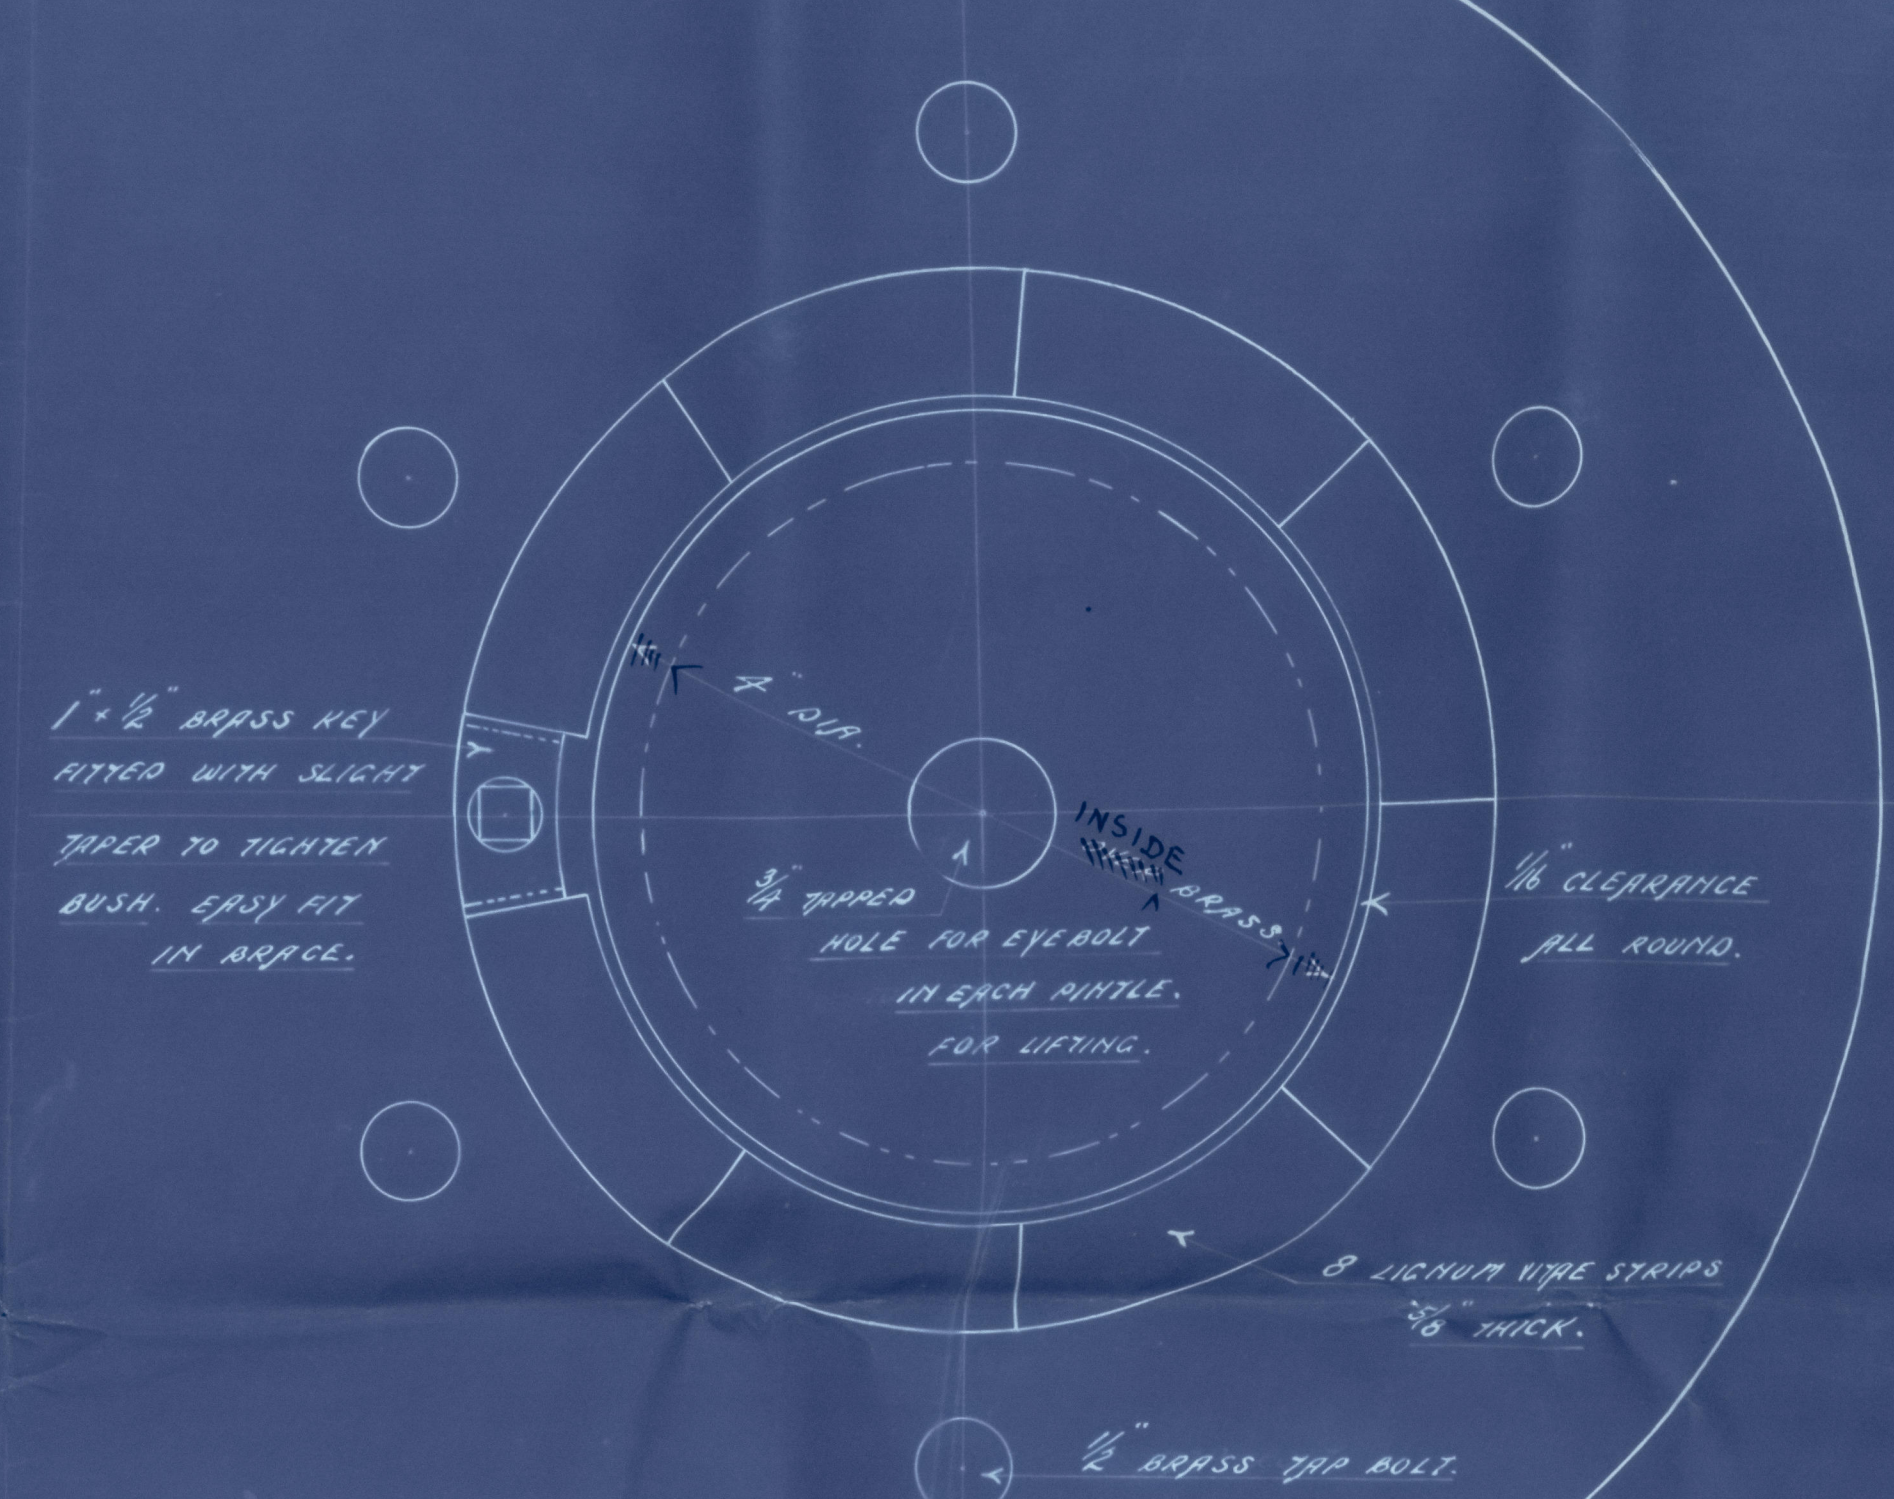



RUDDER, S.S.N. 276

SCALE 1/2" = 1 FOOT.


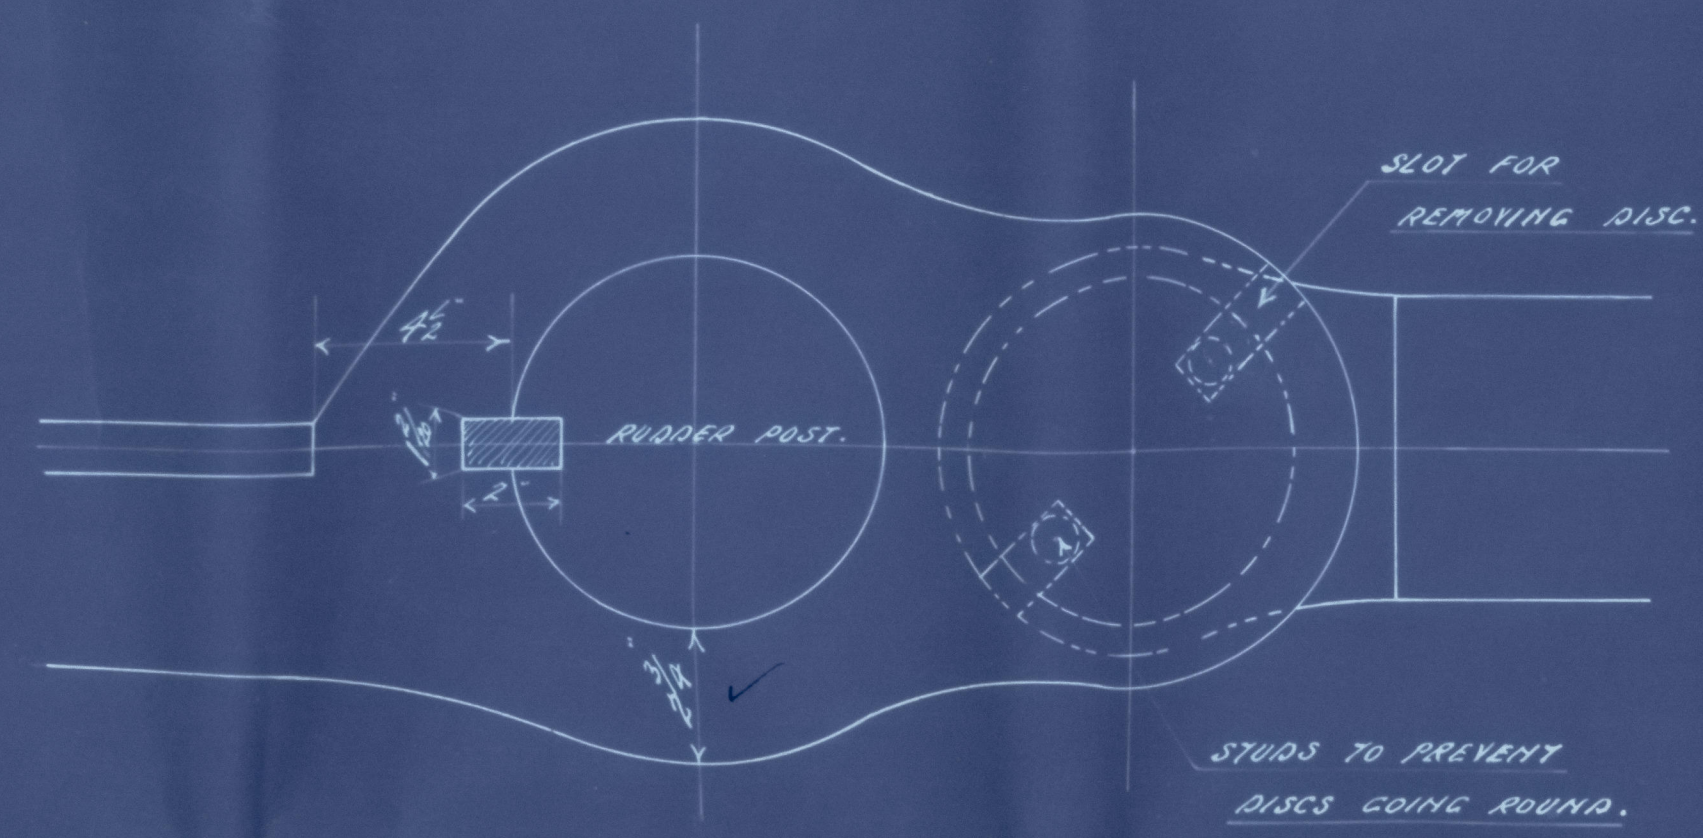


DETAIL OF STEEL BEARING DISCS
 SCALE 3/4" = 1 FOOT.
 ON GUDGEON MARKED 'A'

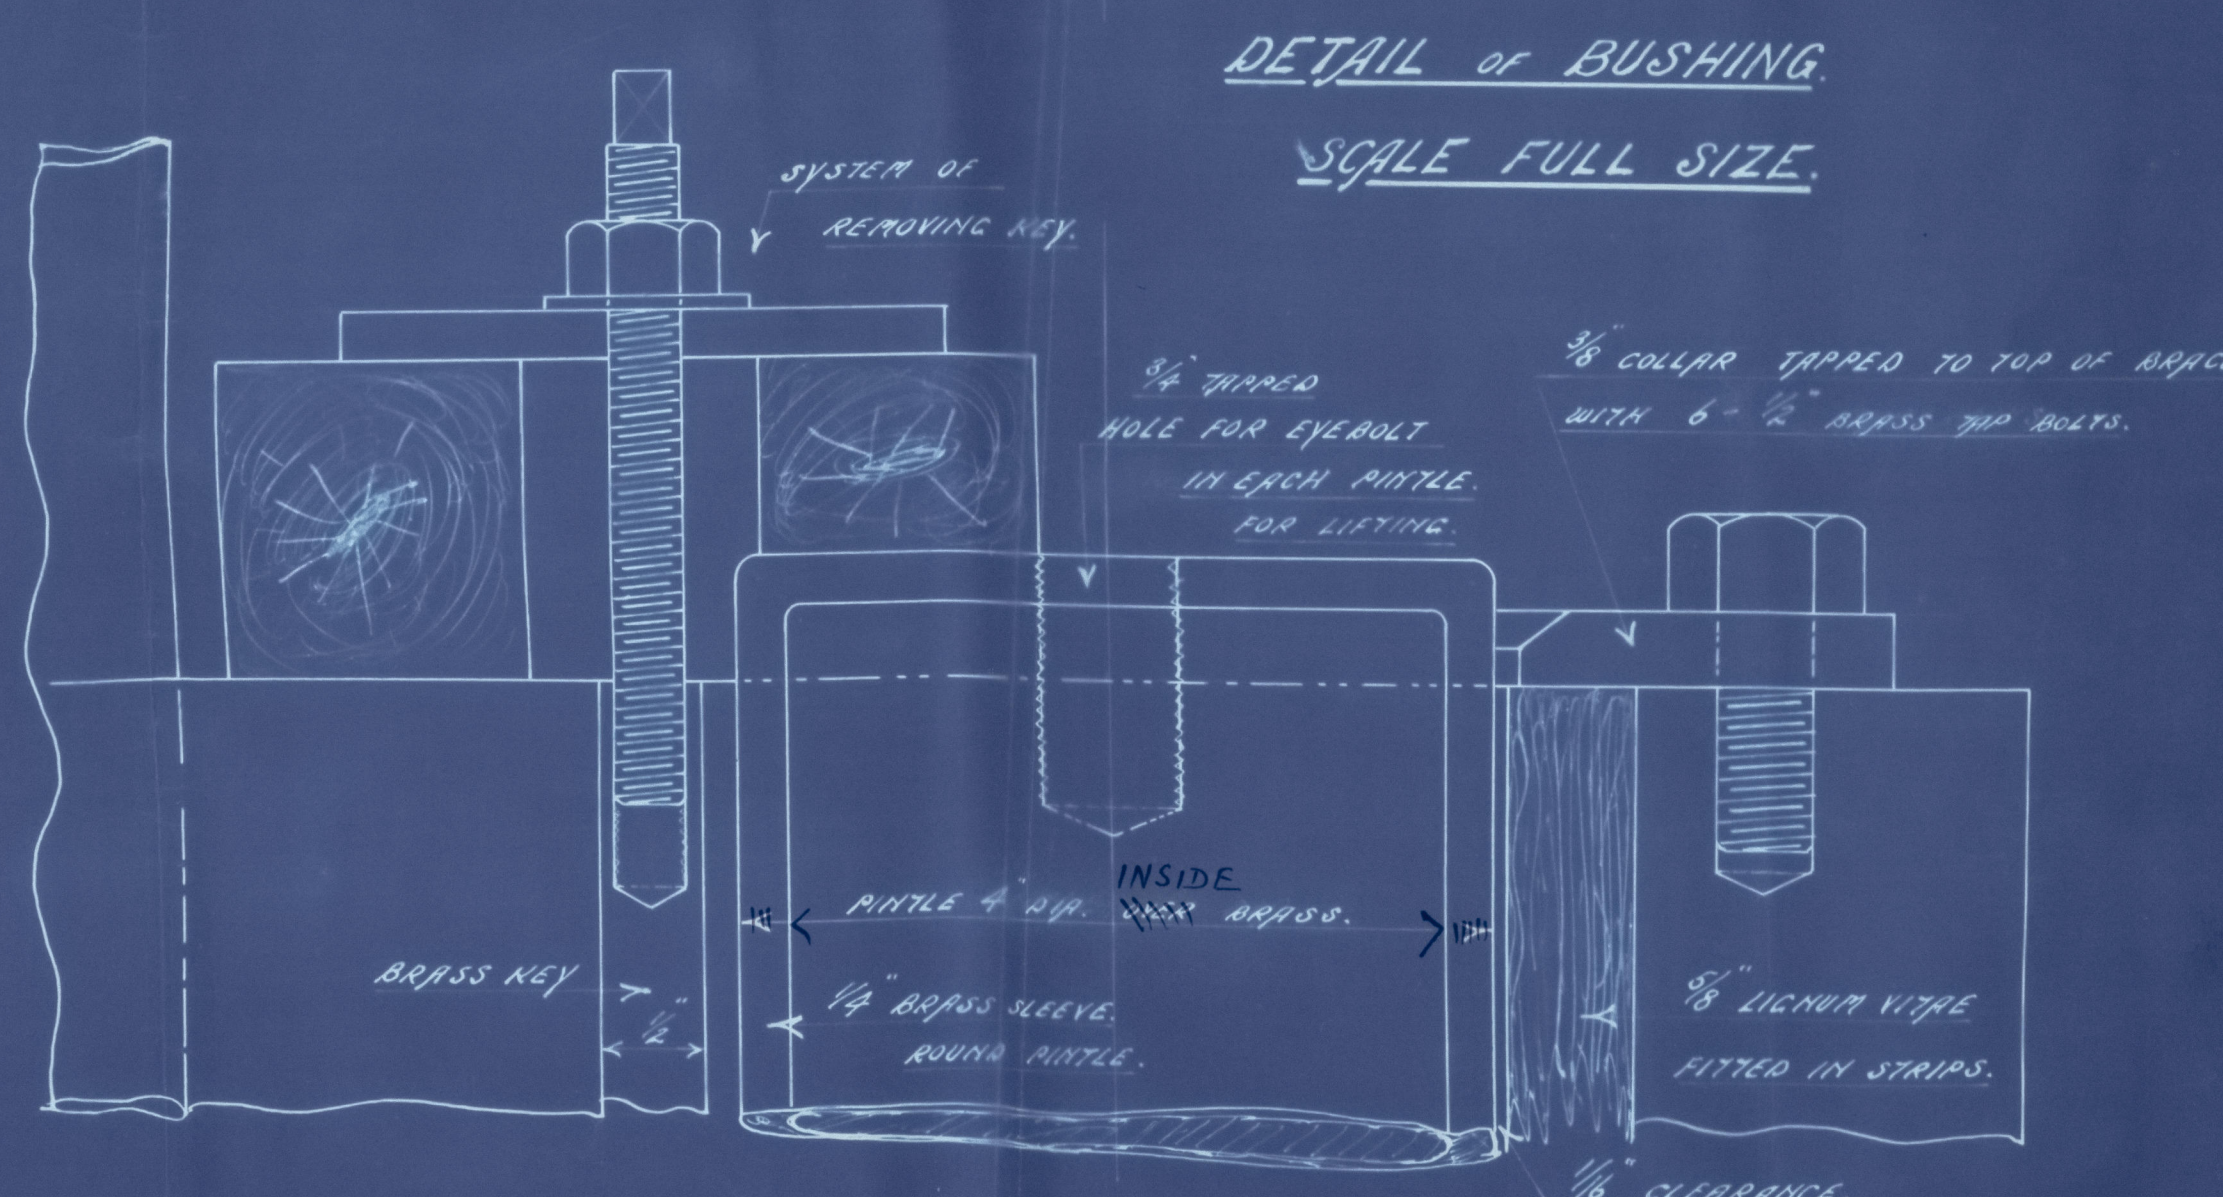


DETAIL OF BUSHING
 SCALE FULL SIZE.





PLAN OF COUPLING.
 SCALE 1/2" = 1 FOOT.

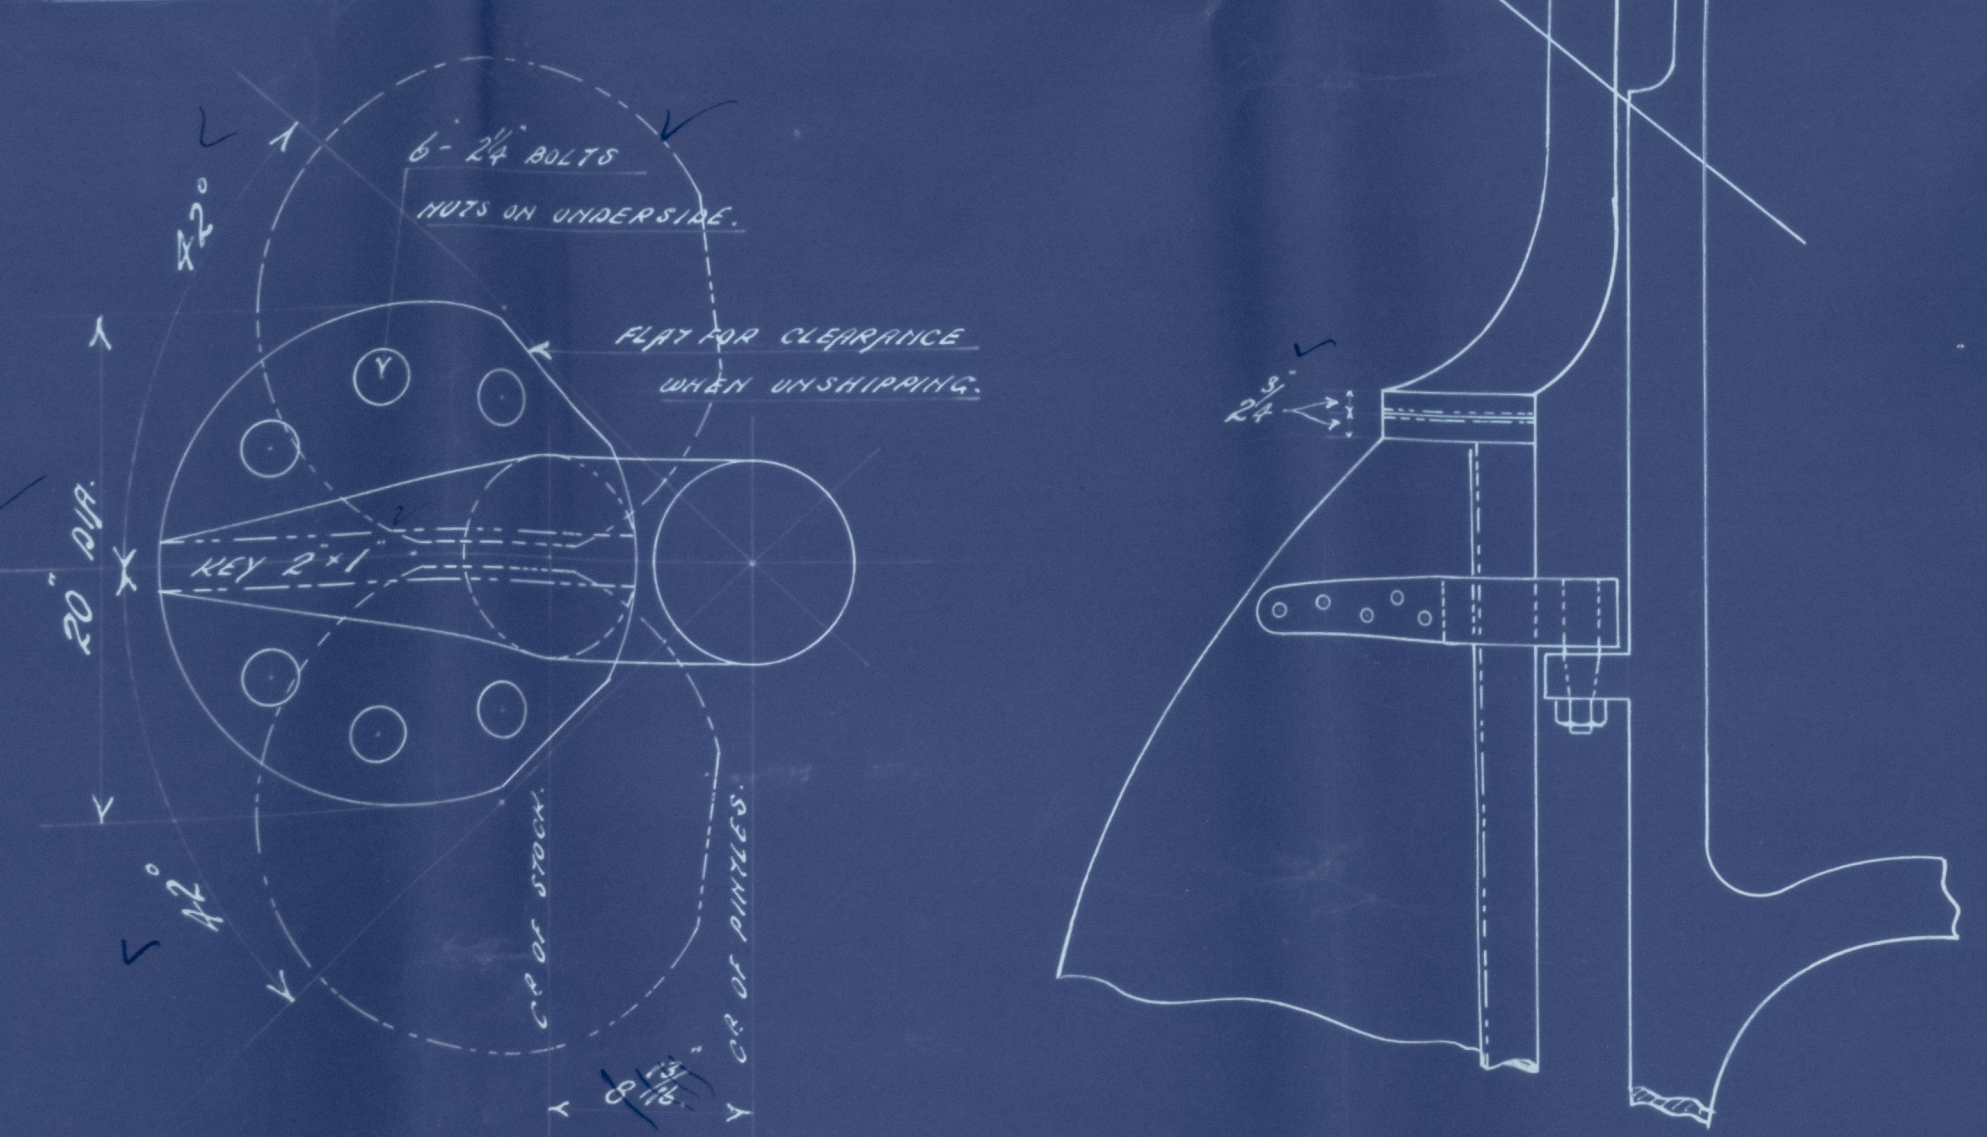





ALTERNATIVE ARRANGEMENT OF COUPLING.

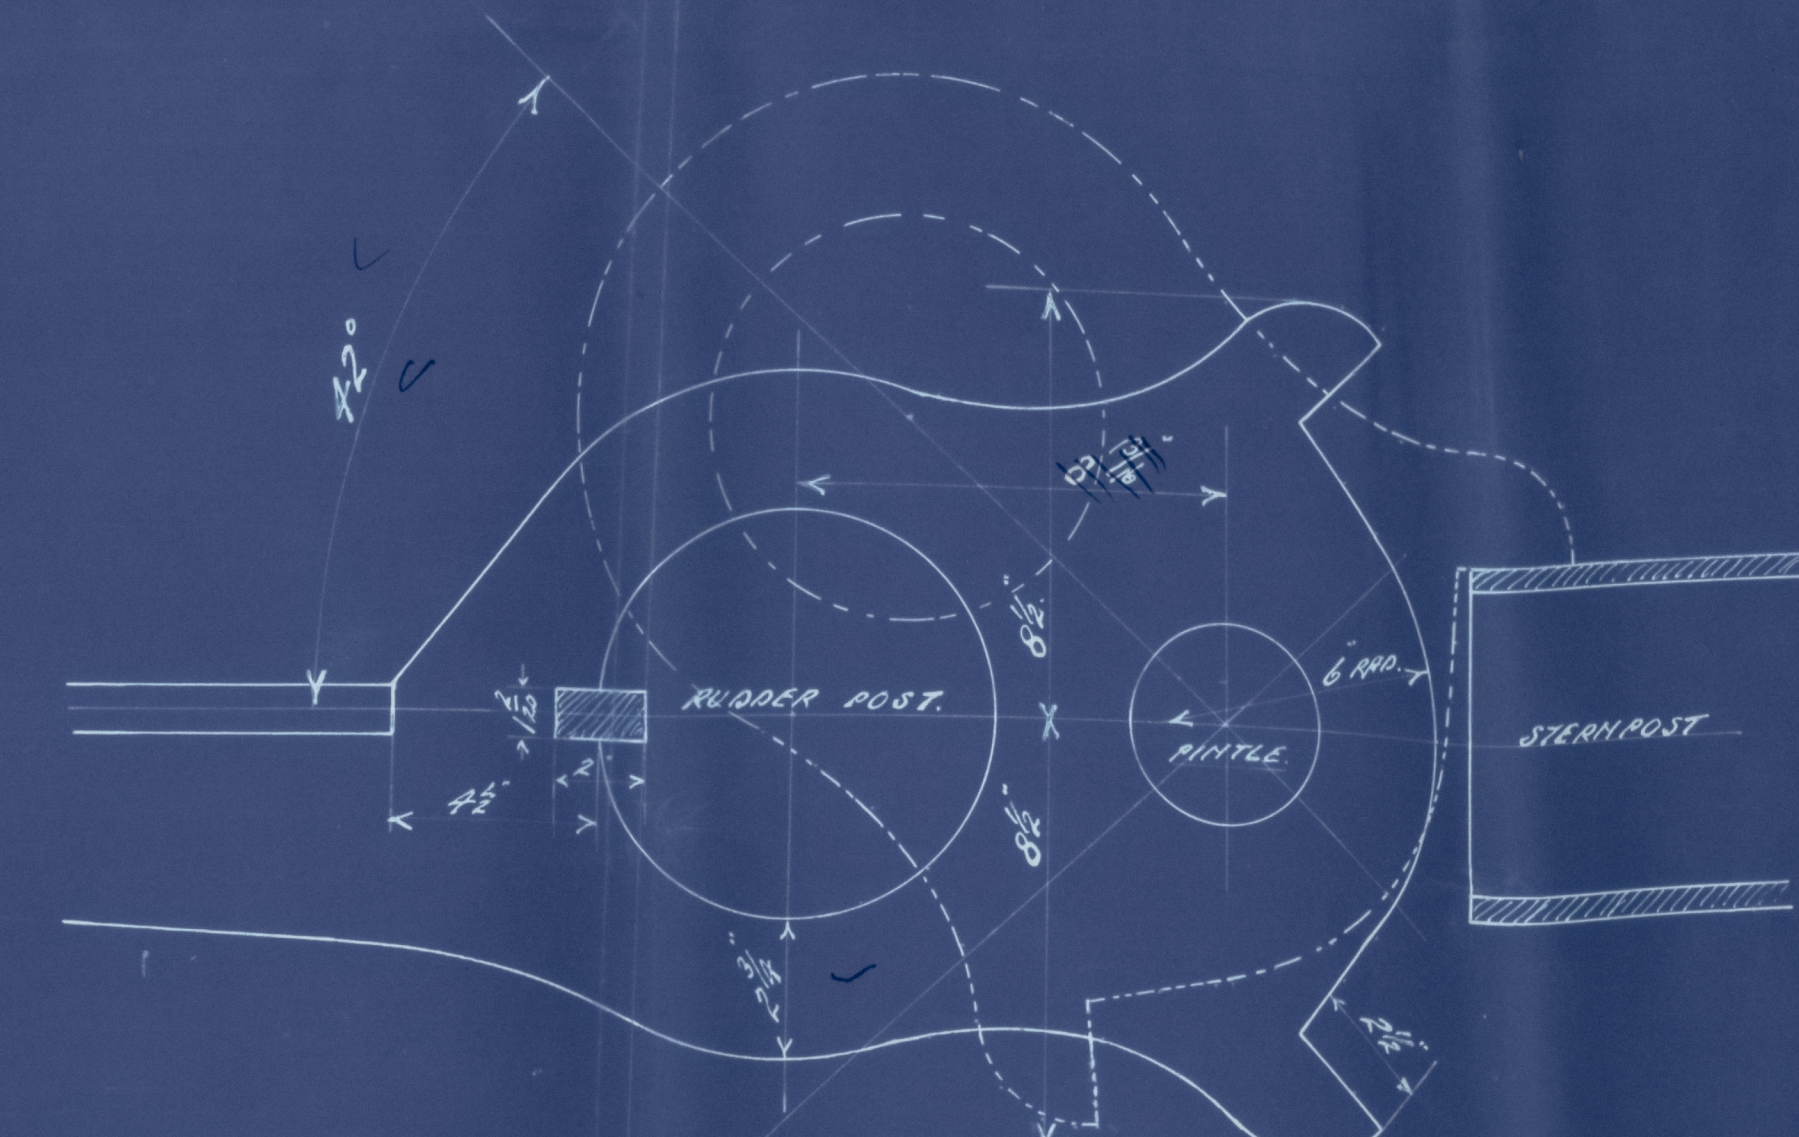

DETAIL OF STOPPER ON TOP ARM.
 SCALE 3/4" = 1 FOOT.

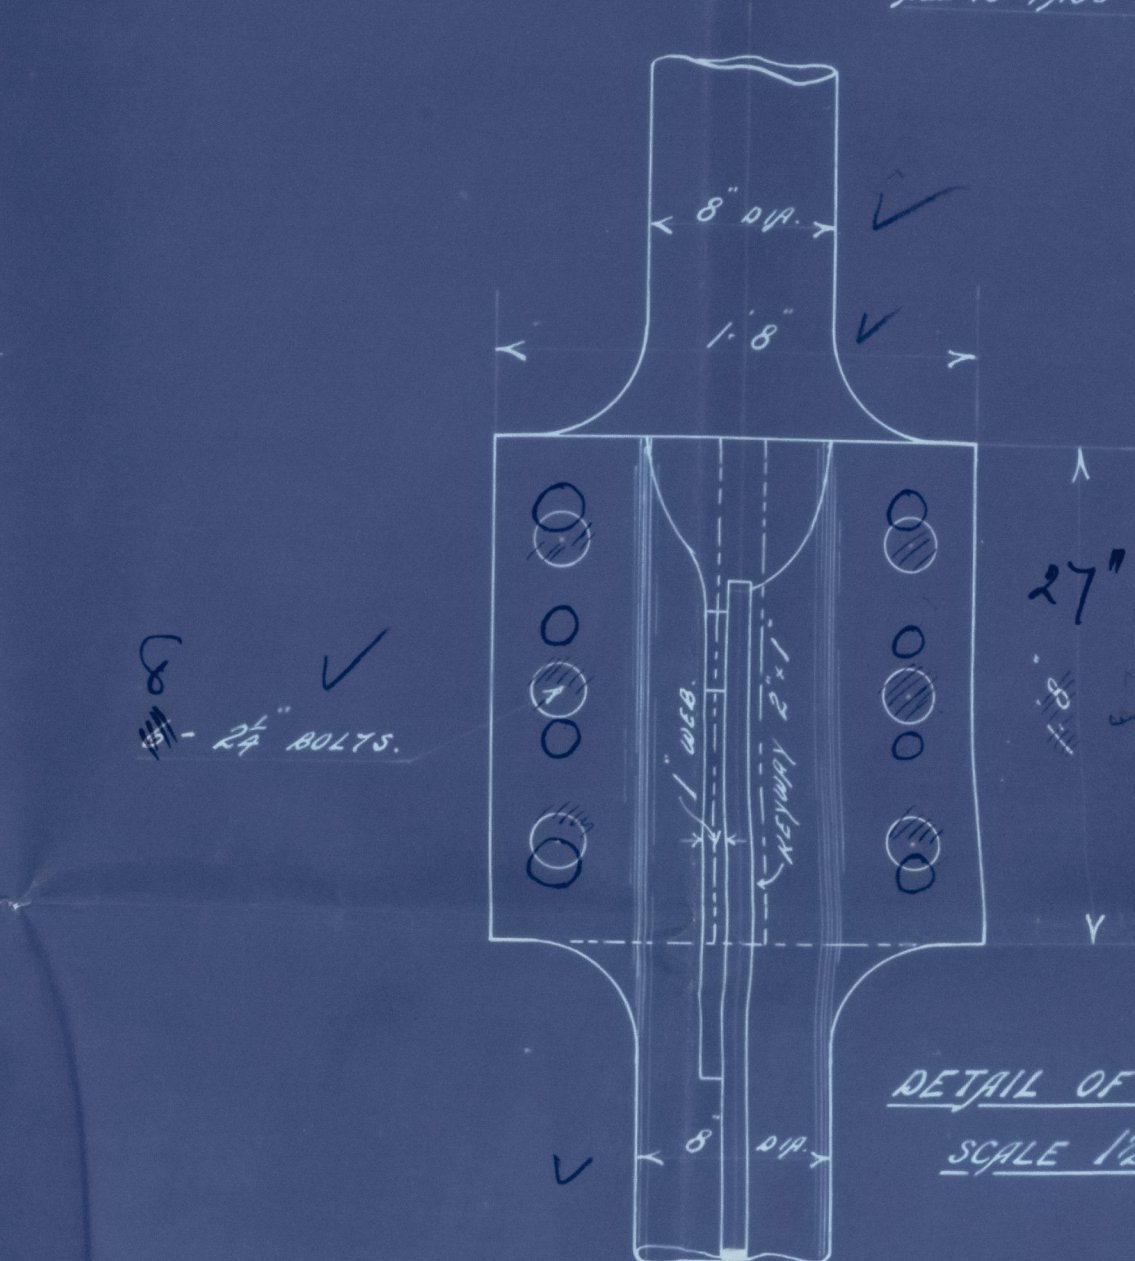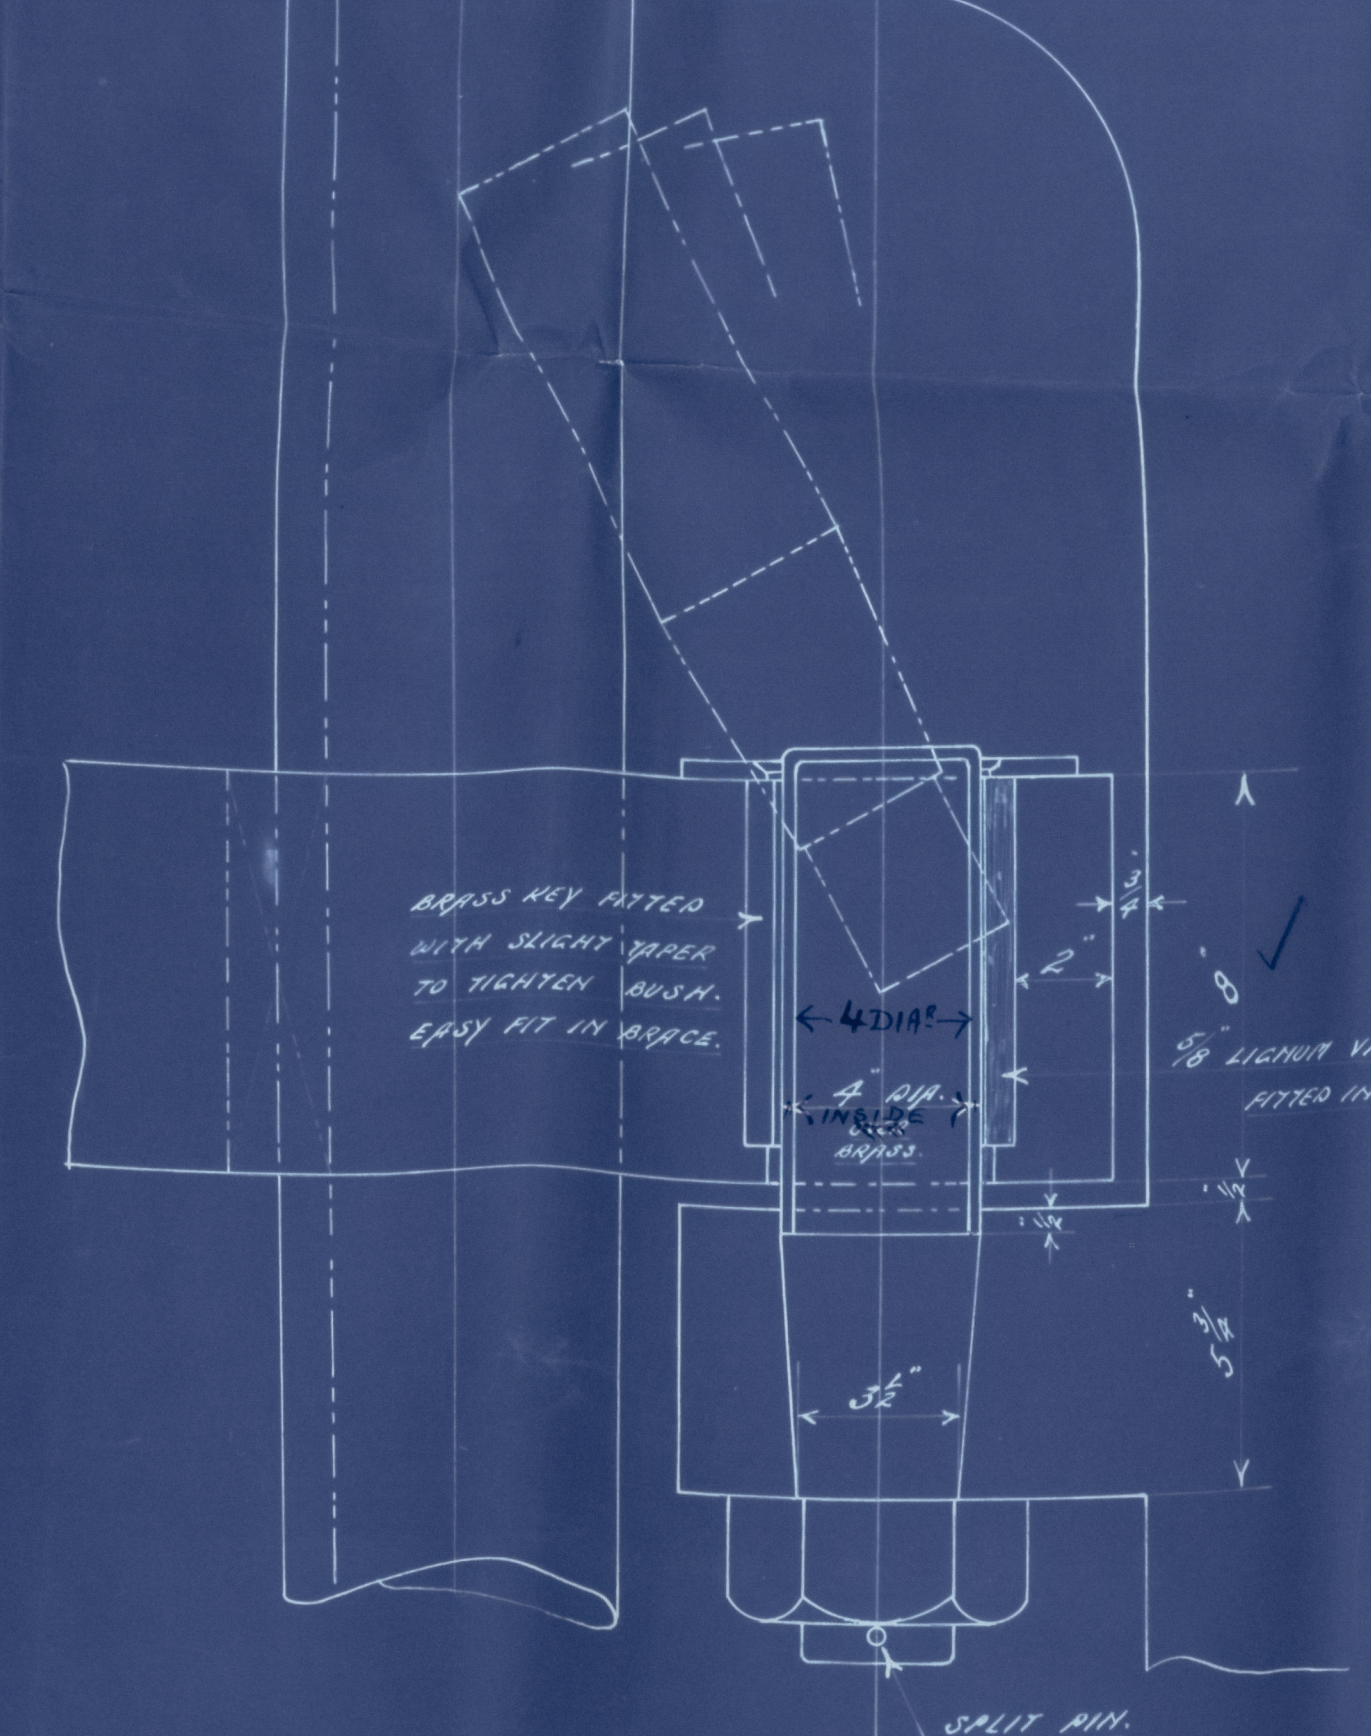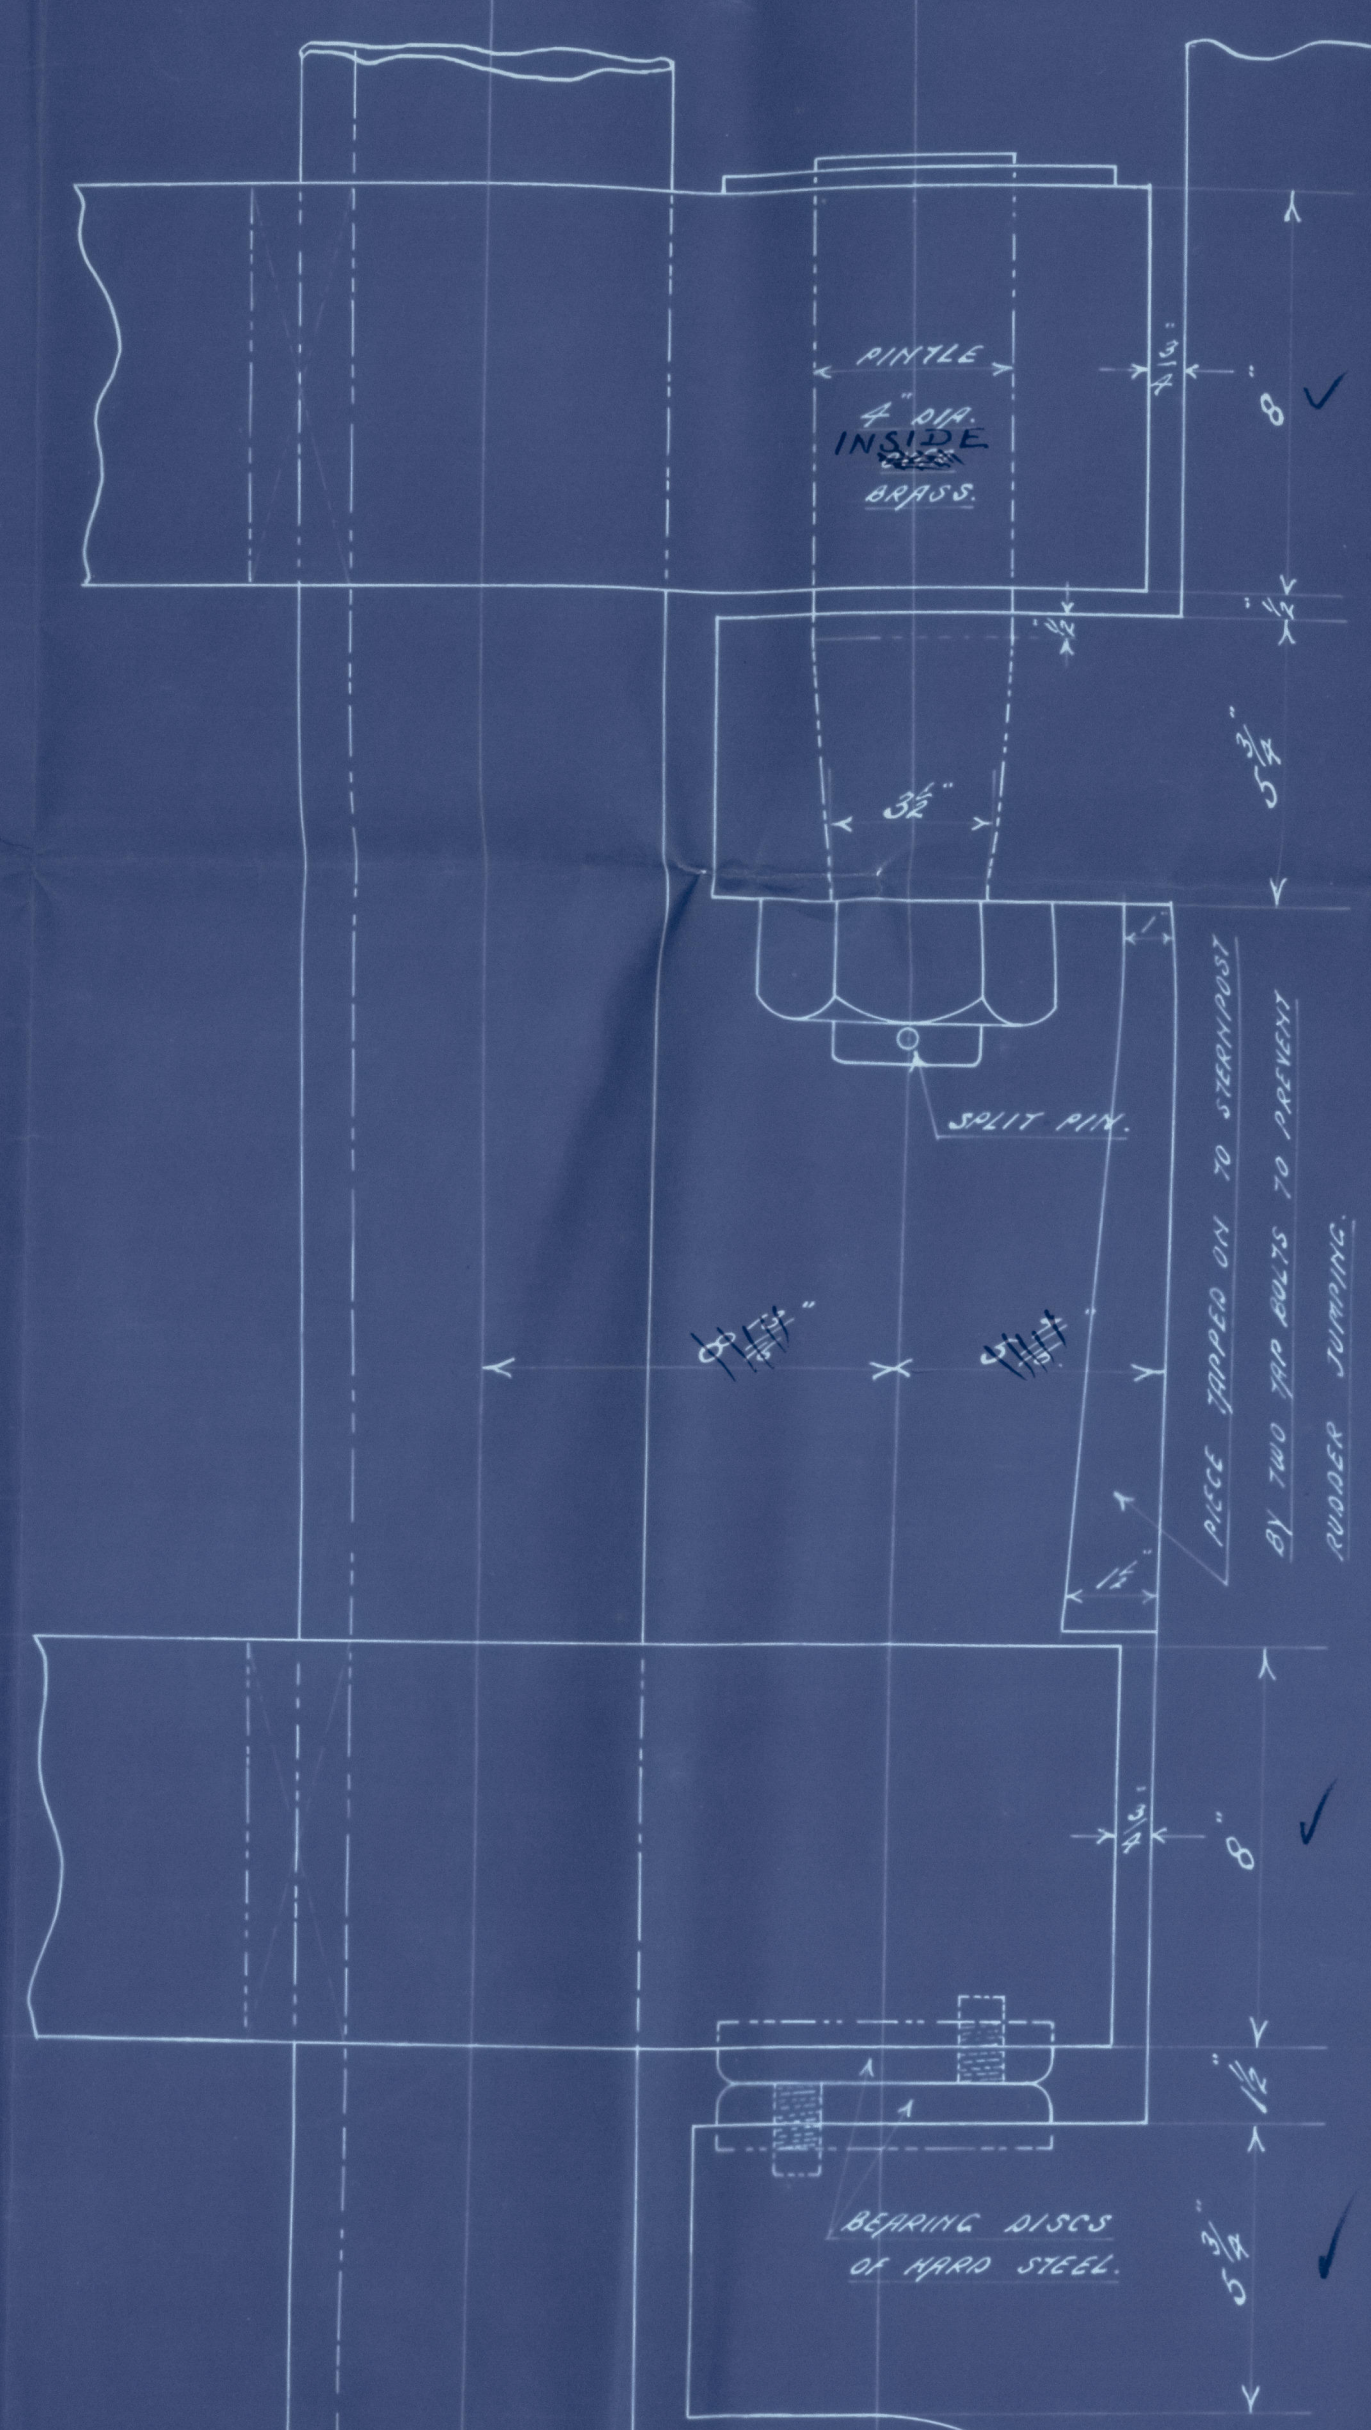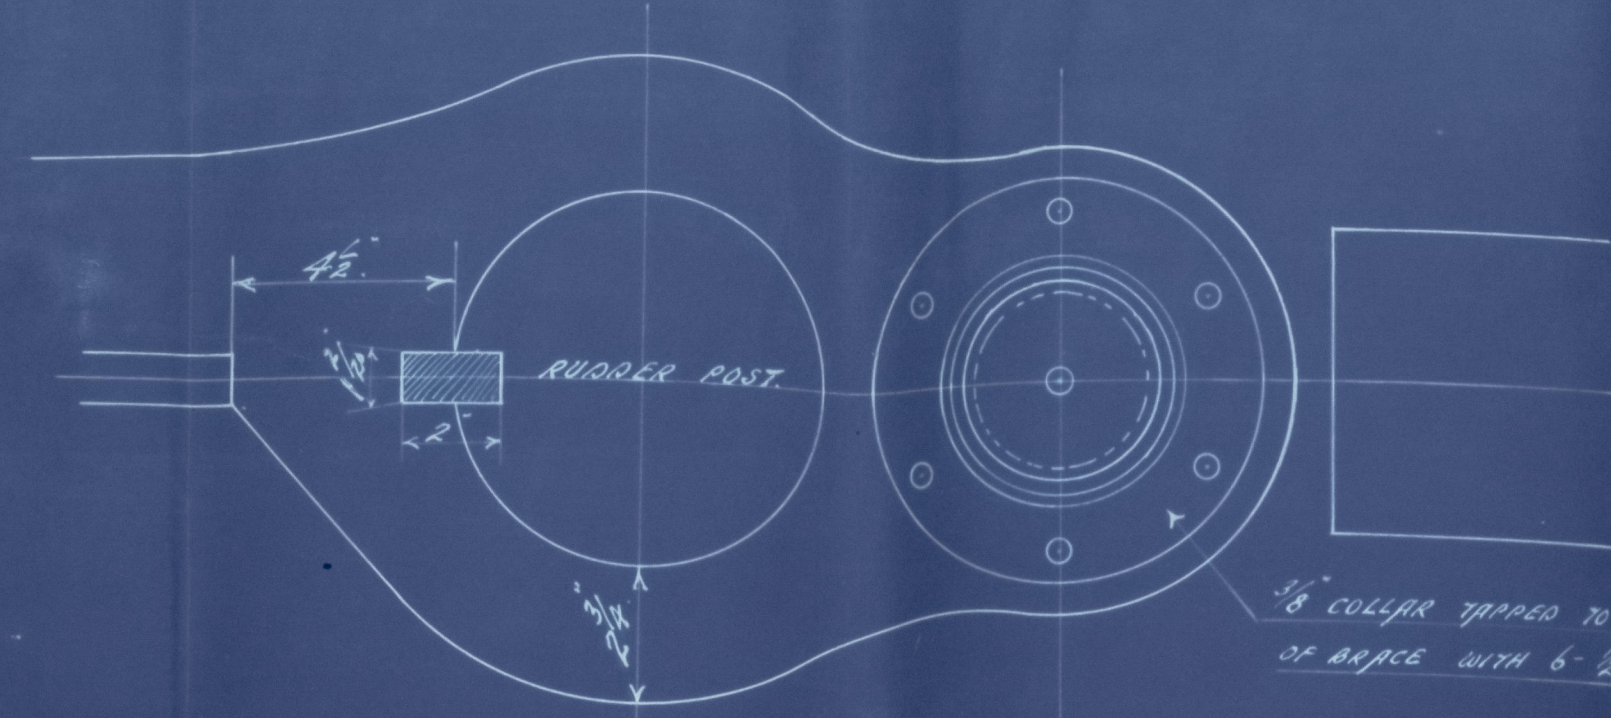

DETAIL OF COUPLING
 SCALE 1/2" = 1 FOOT.

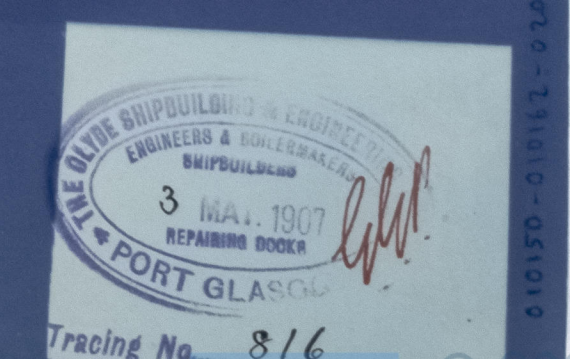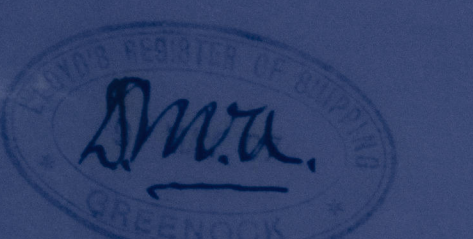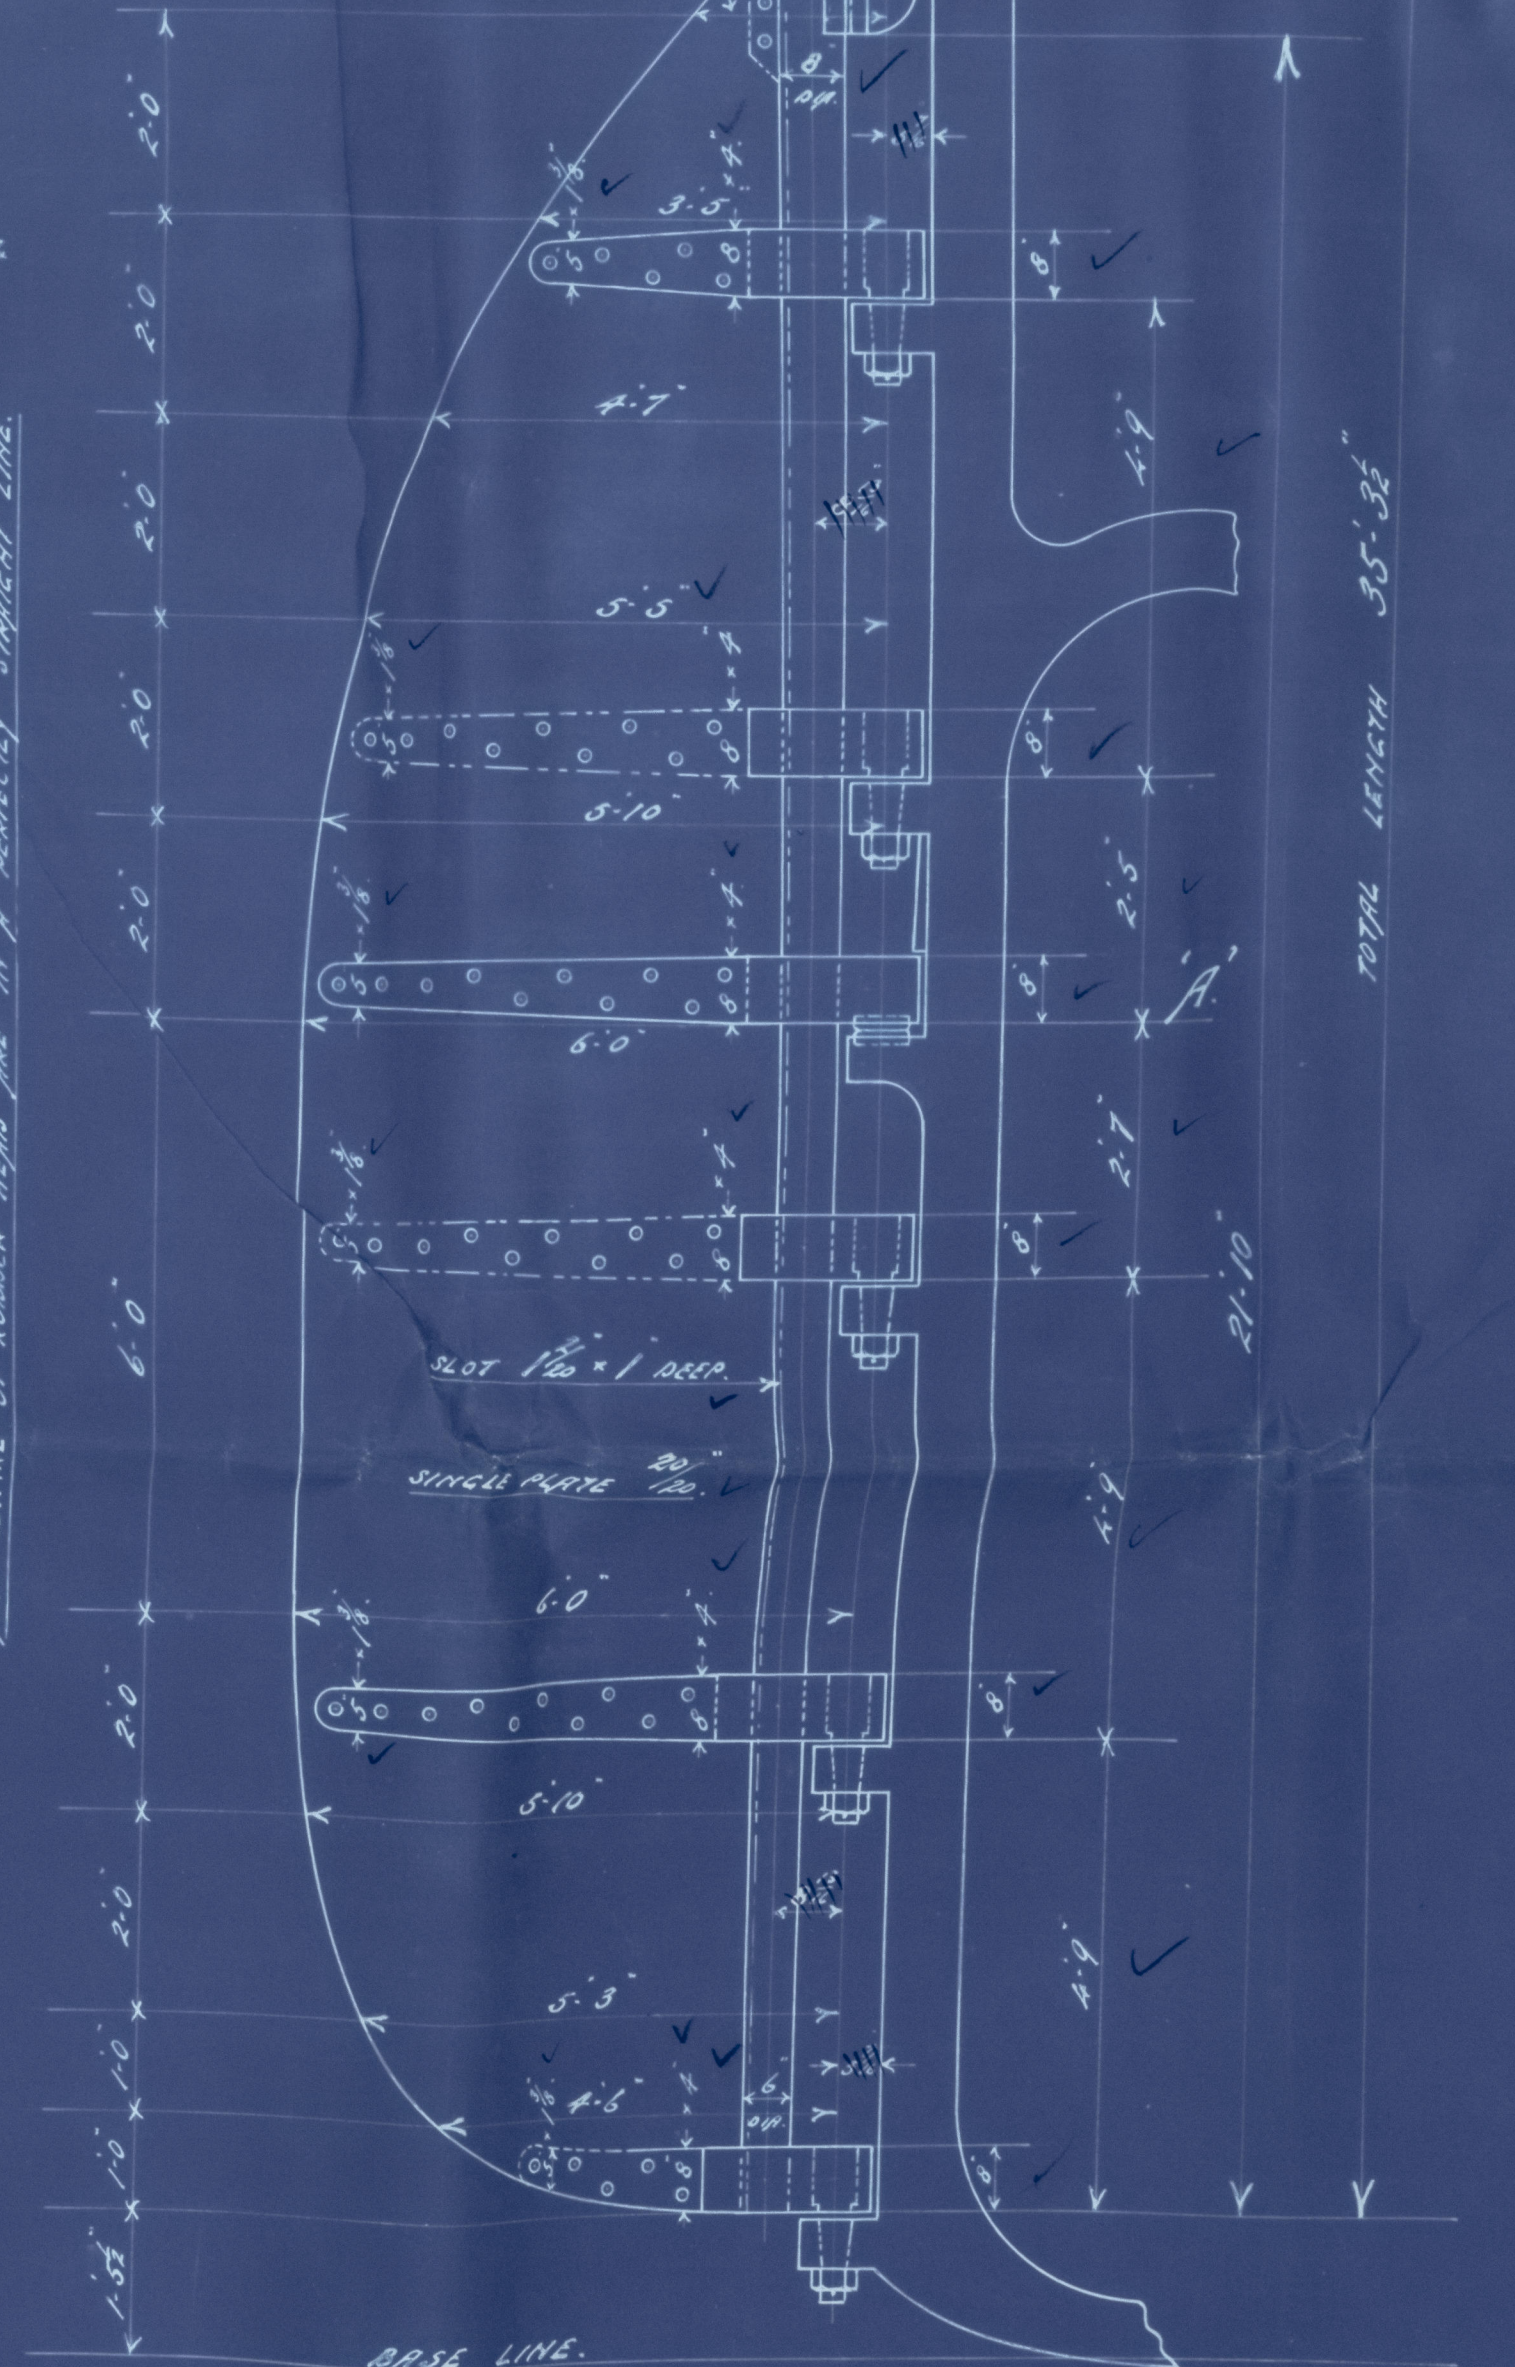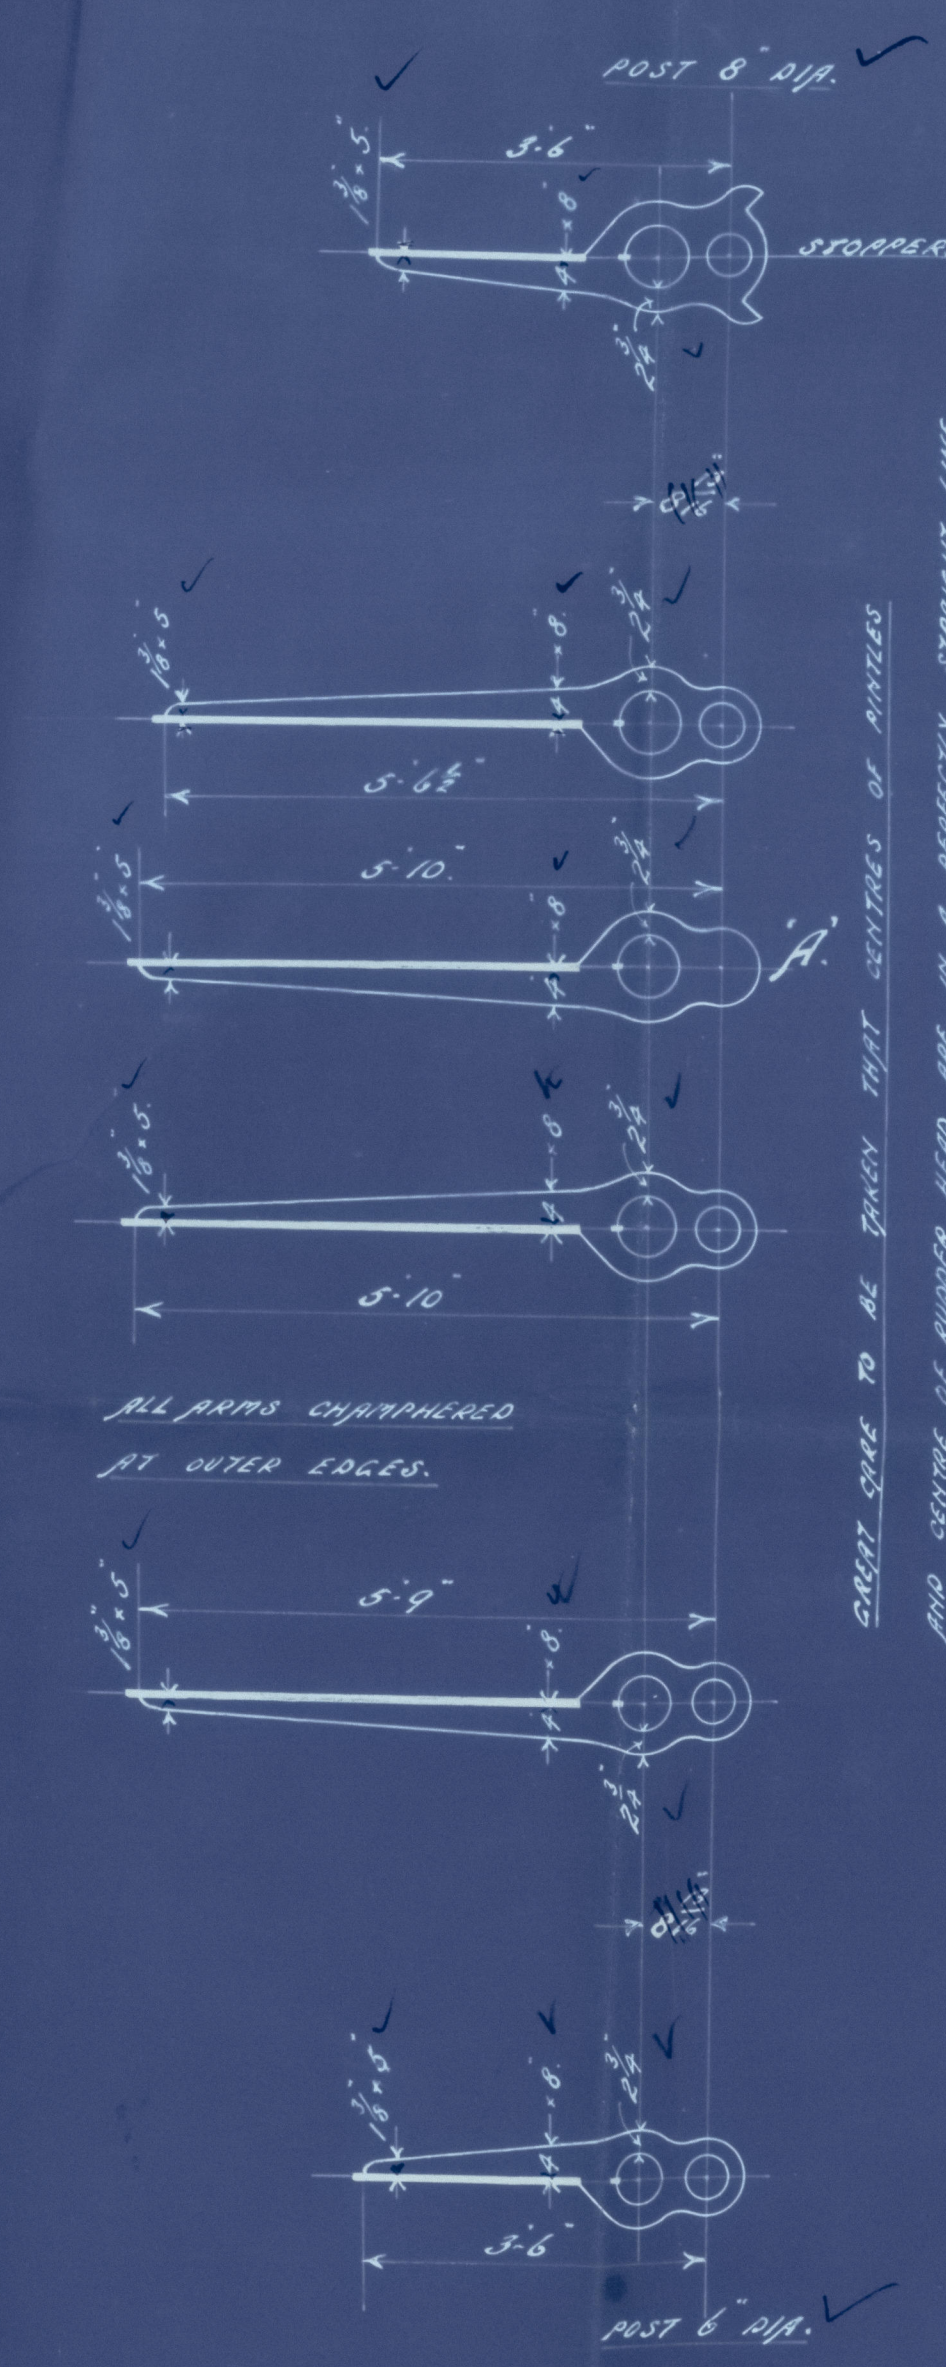


Tracing No. 816

Rudder Plan
Clyde SB Eng Co.
No 246

S. H. Hooyong
Greenock rpt No 15251

for "Patt Dar"

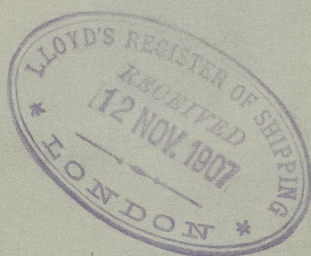

010150-010162-0205



Lloyd's Register
Foundation