



1-2% flexible staaldraad (6x12) lang 137,25 m

[illegible]

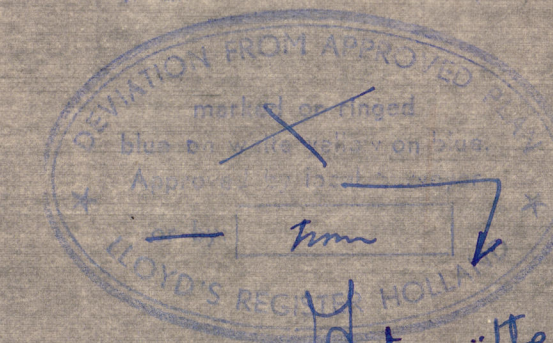

Bido ★  
Midship Section

RECORDS DEPT  
LONDON

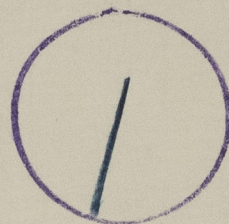

© 2021

Lloyd's Register  
Foundation

010150-010162-0301