

MIDSHIP SECTION

STEEL SCREW TRAWLER

N^o 512

DIM^{NS} 117'-6" x 21'-6" x 12'-6" M^{LD}

SCALE $\frac{1}{2}$ " = 1 FOOT

TO CLASS 100.A.1. AT LLOYD'S FOR FISHING PURPOSES

PLAN No. 541
FOR ENCLOSURE TO
Messrs Lloyd's Surveyors
Hull
COCHRANE & SONS
SHIPBUILDERS, SELEBY
DATE 24/7/11 R.H.

NUMERALS

B + D = 34
L x (B + D) = 3995


PROPORTIONS

$\frac{L}{D}$ = 9.4
 $\frac{L}{B}$ = 5.46

EQUIPMENT

✓ 1ST BOWER ANCHOR 5 $\frac{1}{2}$ CWTs EX STOCK
✓ 2ND BOWER " 4 $\frac{1}{2}$ " " "
✓ KEDGE ANCHOR 2 $\frac{1}{2}$ " " "
✓ 90 FATHS 1" CABLE
✓ 60 " 6" HAWSER
✓ 60 " 4 $\frac{1}{2}$ WARR

RIVETING
BUTTS OF SHELL PLATING STRAPPED & DOUBLE RIV
LANDINGS DOUBLE RIV. BULWARKS SINGLE RIV
BUTTS OF STRINGER & TIE PLATES OVERLAPPED
& DOUBLE RIV

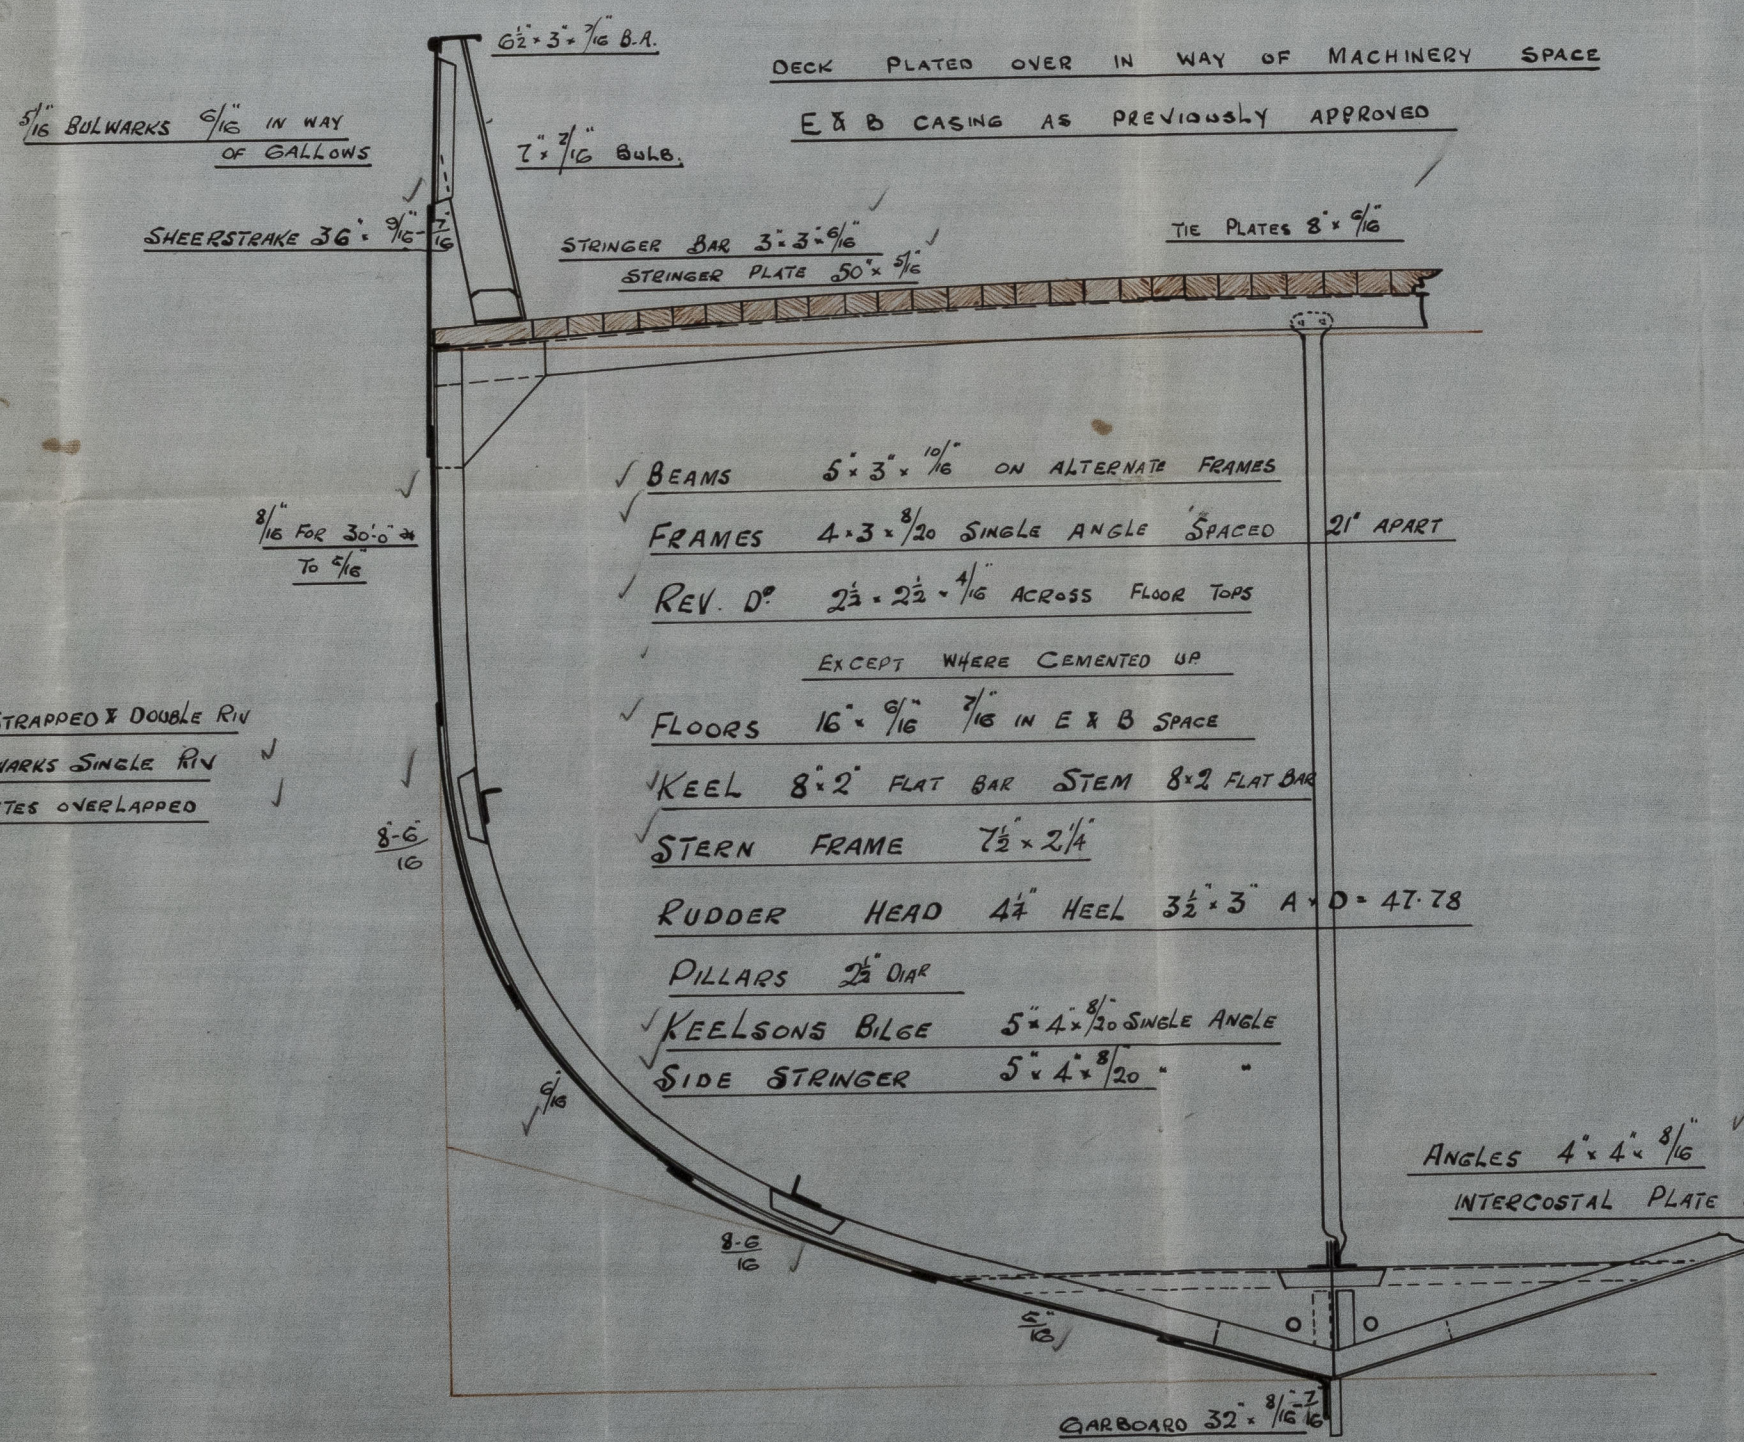

C.B.
26.7.11.



Midship Section

RIVETING

Bohrane's

512.

Sp. Mary Admiral
Hull No. 24634.

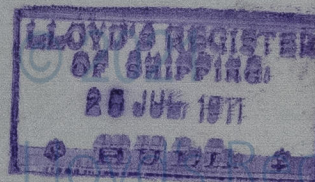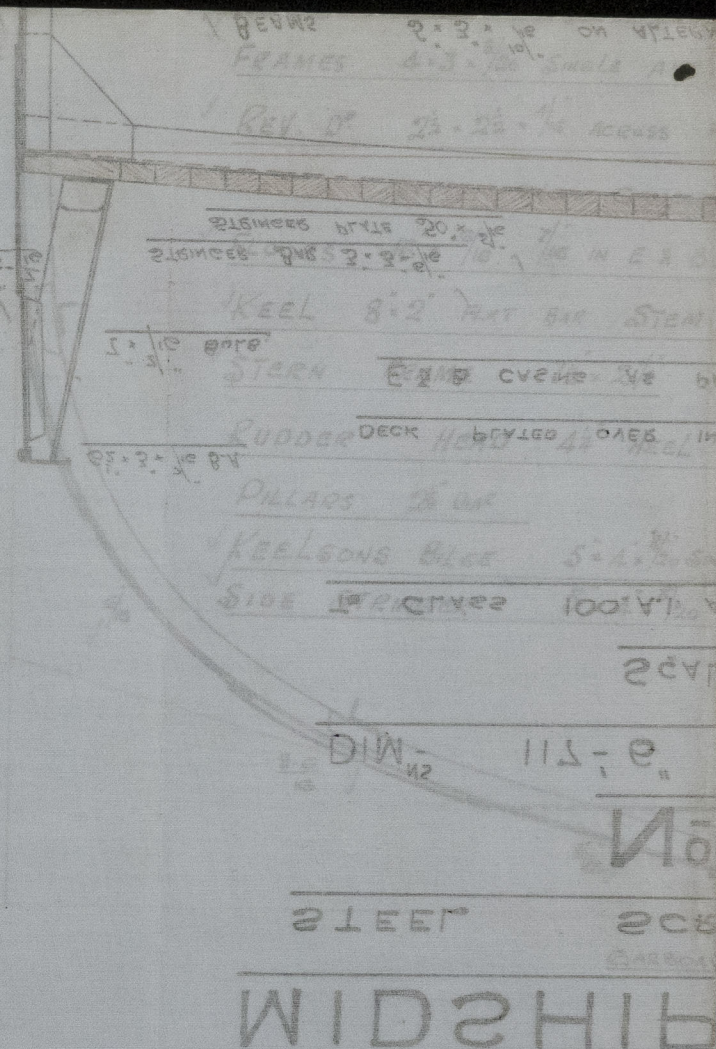

Lloyd's Register
Foundation