


DECK PLANS
S.S. N° 553
Scale 1/1600



STRINGER 69" x 20" FOR 1/2 LENGTH TO 44" x 20" AT ENDS.
STRINGER AS APPROVED. 57" x 20" FOR 1/2 LENGTH TO 44" x 20" AT ENDS.

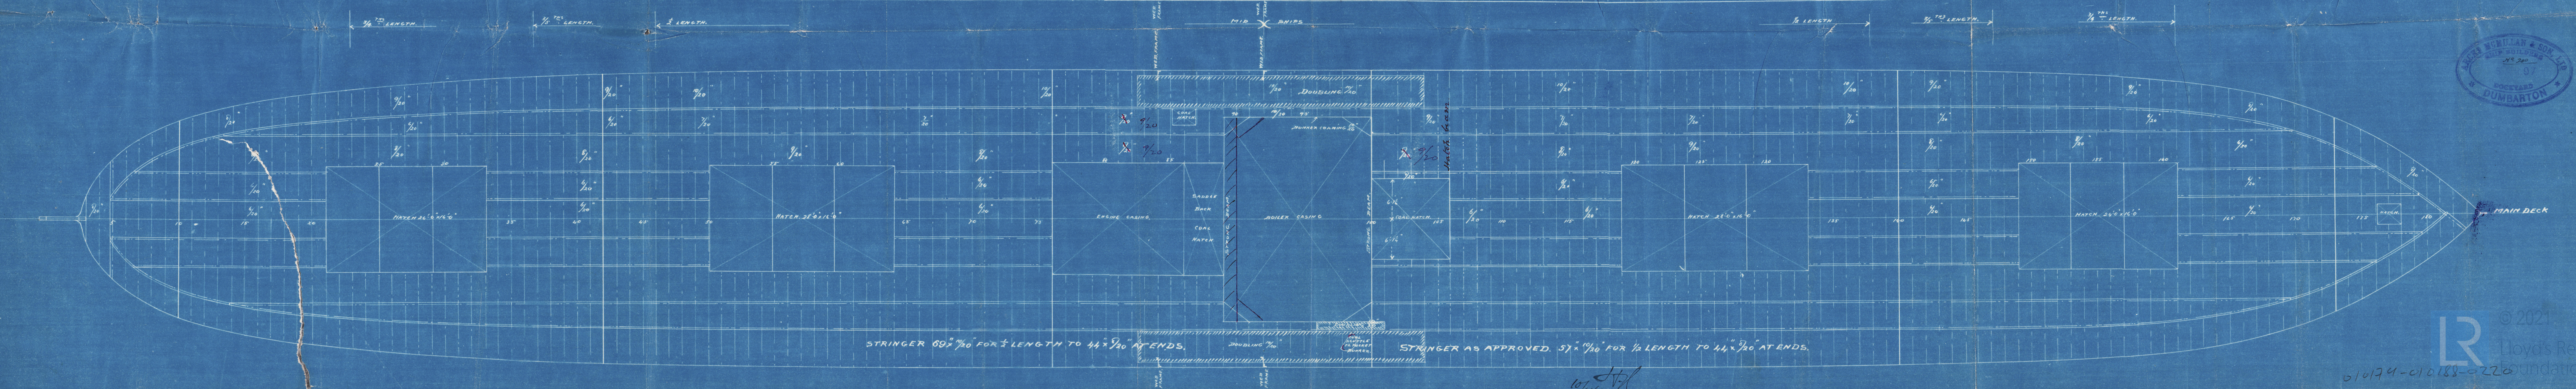

McMillan's
353

370 x 44 x


Deck plan

S.S. "Montclair"

GLASGOW. No 15974.

Wm "Ramon Alonso R" ✱

RECORDS DEPT.,
LONDON

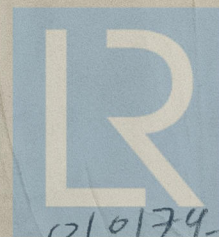

© 2021

Lloyd's Register
Foundation

010179-010188-0220