
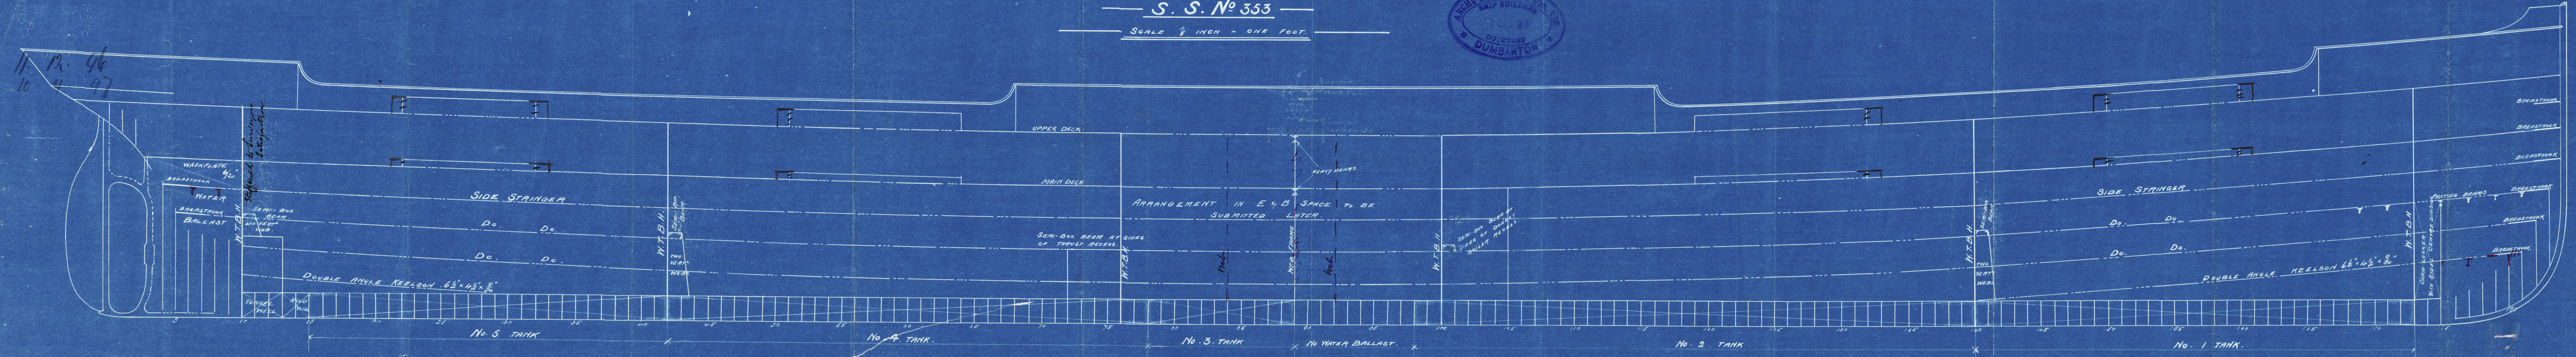


REGISTERED  
SHIP

11. 12. 96  
10. 4. 97

S. S. No 353

SCALE 1/8 INCH = ONE FOOT.

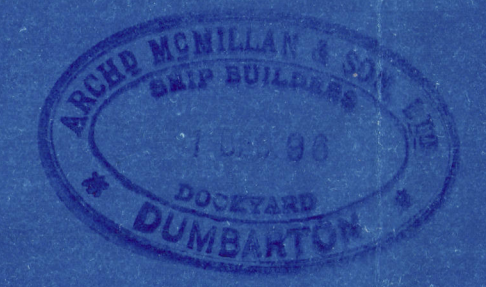

PROFILE


NOTE: ALL SCANTLINGS AS ON MIDSHIP SECTION.

11/12/96



Lloyd's Register  
010179-010188-0222



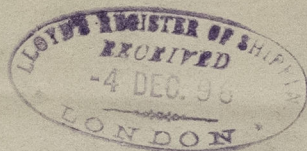

*McMillans 353*



*Profile*

*S.S. 'Montclair'*

GLASGOW. No 15974.

*Y<sup>n</sup> "Ramon Alonso R" ★*

G.B.



RECORDS DEPT.,  
LONDON



LR  
© 2021  
Lloyd's Register  
010174-010188-0222  
Foundation