


— VAPOR RAMON ALONSO R —


— DISCO DE CARGA —

— ESCALA 1:10 —

11 OCT 1943

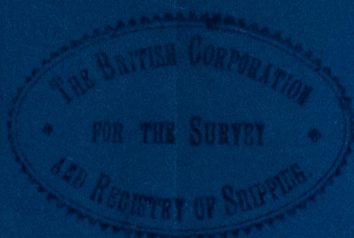

C¹A SUPERIOR.

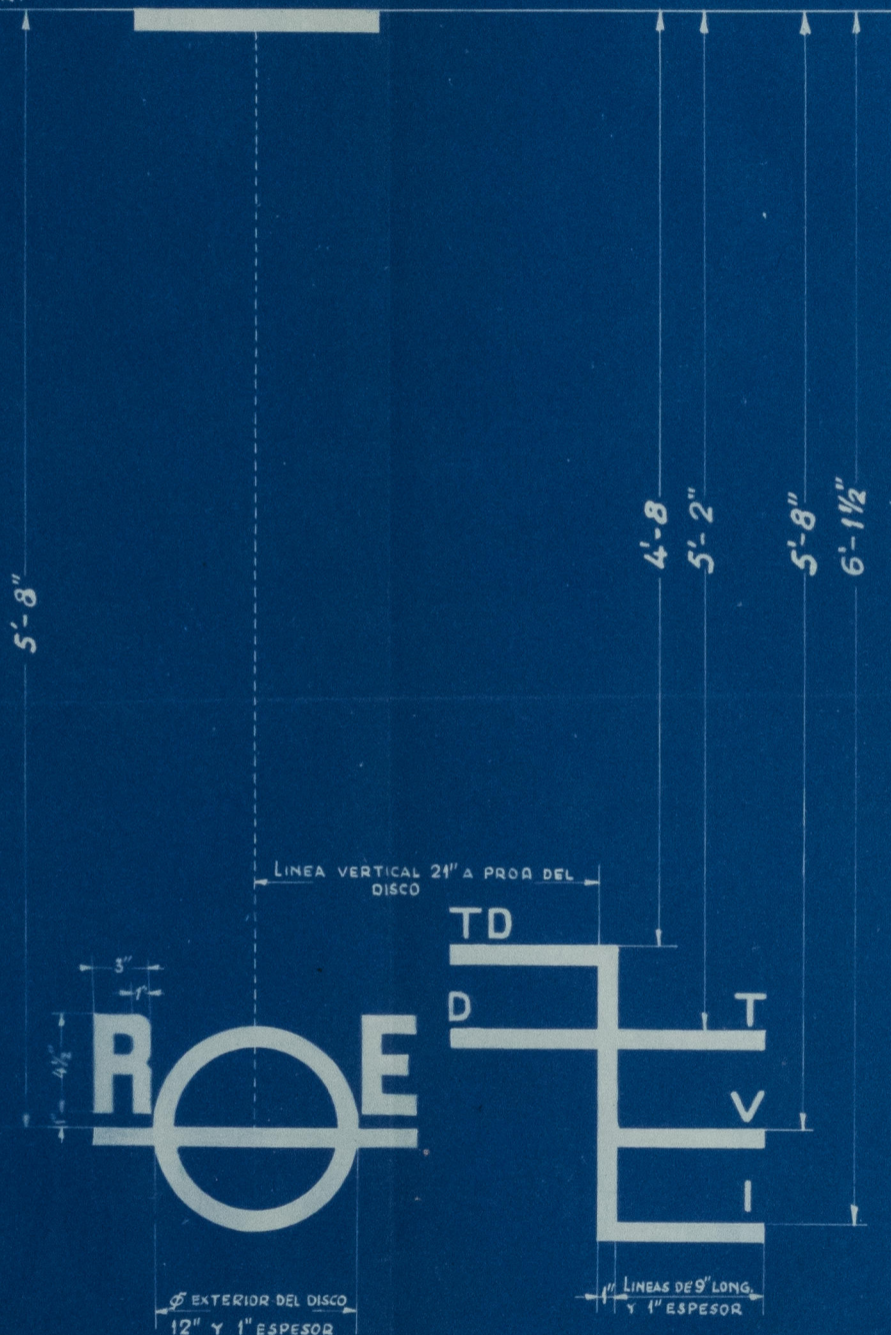

TD LINEA DE CARGA MAXIMA PARA AGUA DULCE EN LOS TROPICOS

D " " " " " " DULCE

T " " " " " " LOS TROPICOS

V " " " " " " VERANO

I " " " " " " INVIERNO

Eusebio Bilbao 5 Sept 1943

Inspector
de
The British Corporation
Eusebio Bilbao

010179-016188-0223

Freeboard Marked

8/5 RAMON ALONSA R.

11 OCT 1943

010179-010188-0223



RECORDS DEPT.
LONDON

Alonso. 11.10.43.

8/5 RAMON ALONSA R. ★

Freeboard Signific



© 2021

Lloyd's Register
Foundation