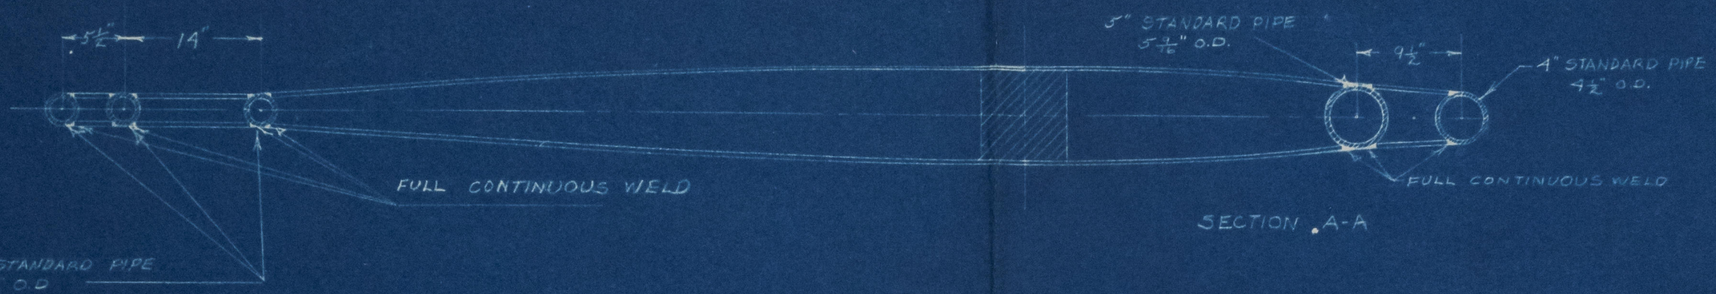


SECTION A-A

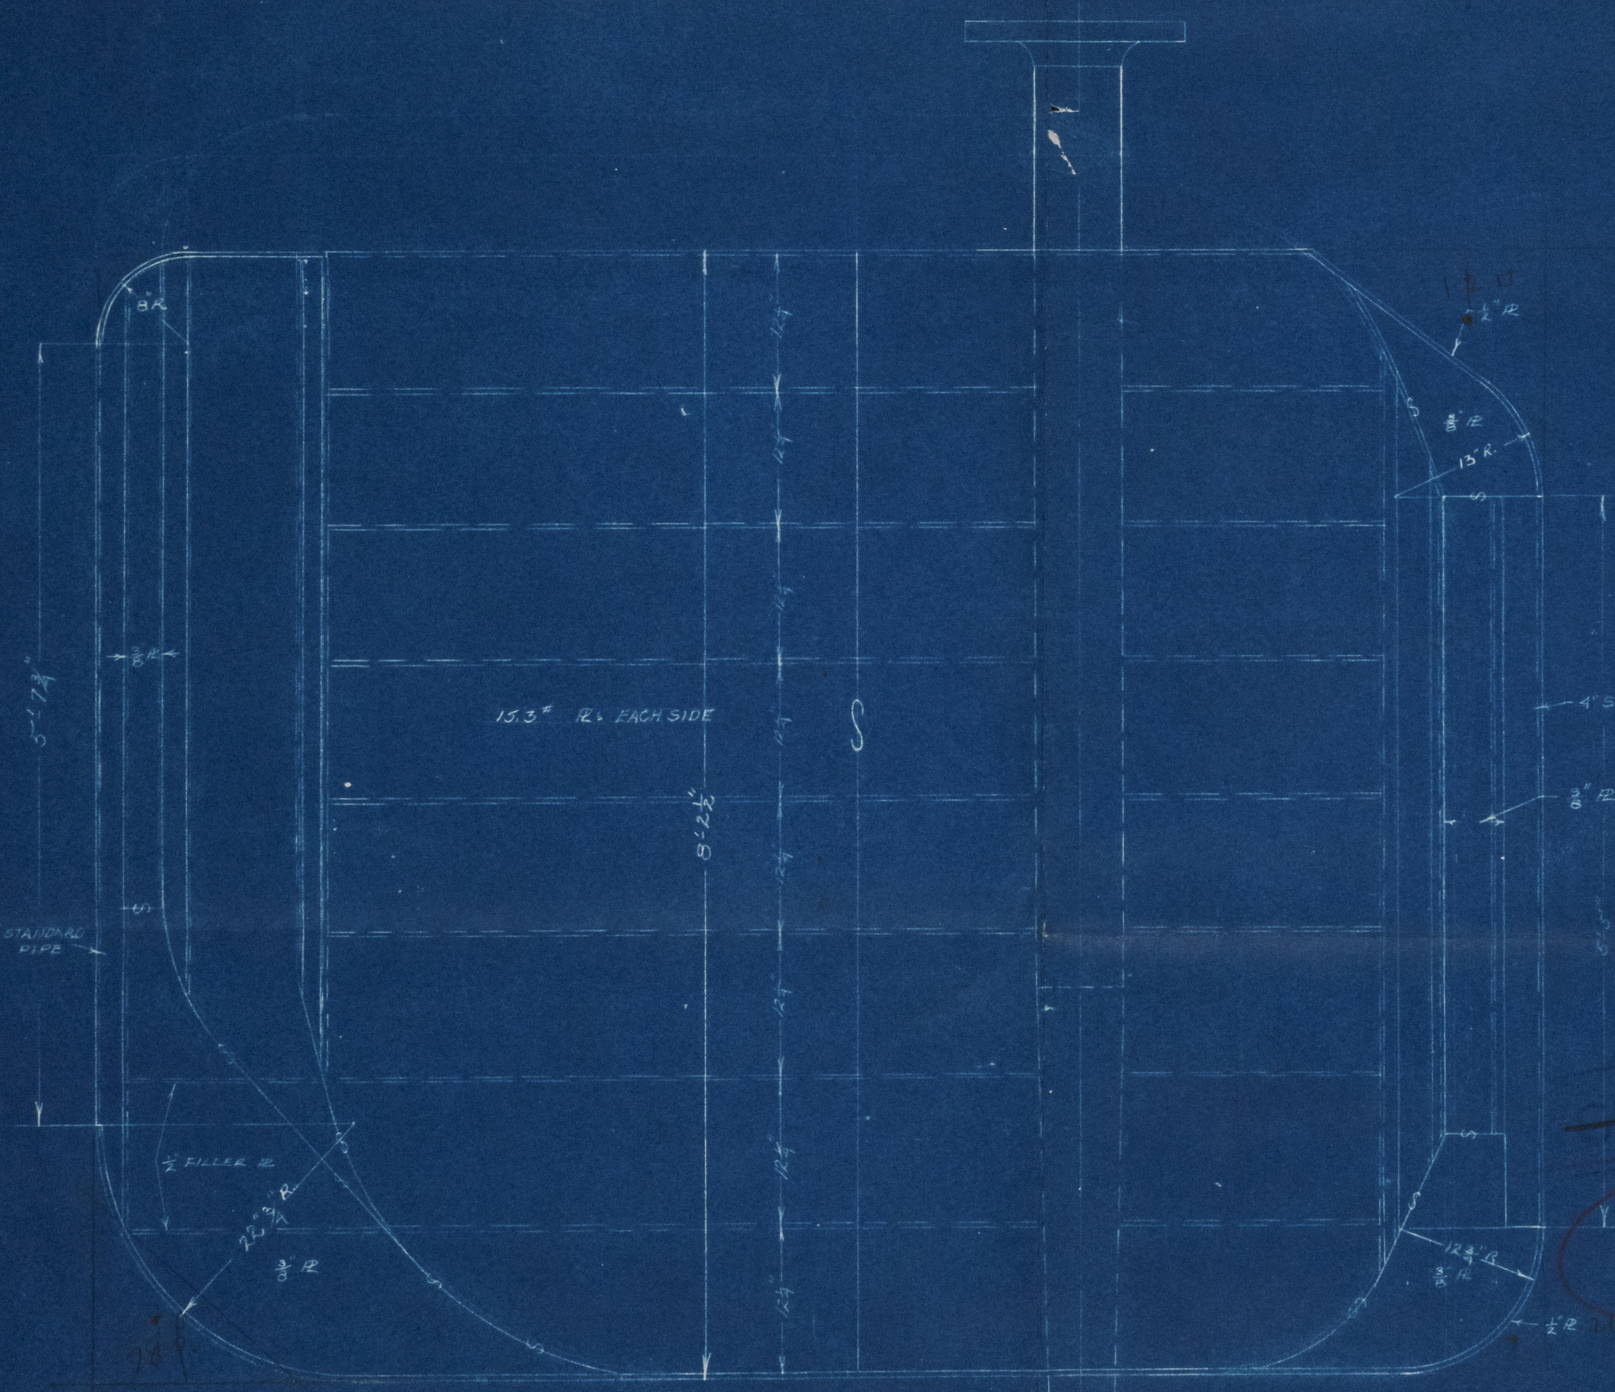


APPROVED
NOV 25 1938
"Nicketiner"
M.S. "DOLOMITE 4"
Nyk 38976

| DOLOMITE MARINE CORP. - ROCHESTER, N. Y. | |
|---|---|
| REVISED RUDDER PLAN | |
| Drwg. # D4 - 69 | Date 11/21/38 |
| Drawn by E.L.N | Revised |
| Scale 1"-1'-0" | Revised |

REVISED RUDDER PLAN 12-10

The electric welding must be done with an approved process and the requirements of the SPECIFICATIONS FOR THE APPLICATION OF ELECTRIC ARC WELDING FOR SHIP CONSTRUCTION must be carried out.