

HULL NO 633

MIDSHIP SECTION

STEEL LIGHTER.

DIMS 95'-0" B.P. x 21'-0" x 10'-6"


SCALE $\frac{1}{4}$ " = 1 FOOT.

Class + 100 A- Barge for being towed

$$L \times D = 997.5$$

$$L \times (B + D) = 2992.5$$

$$L/D = 9.09$$

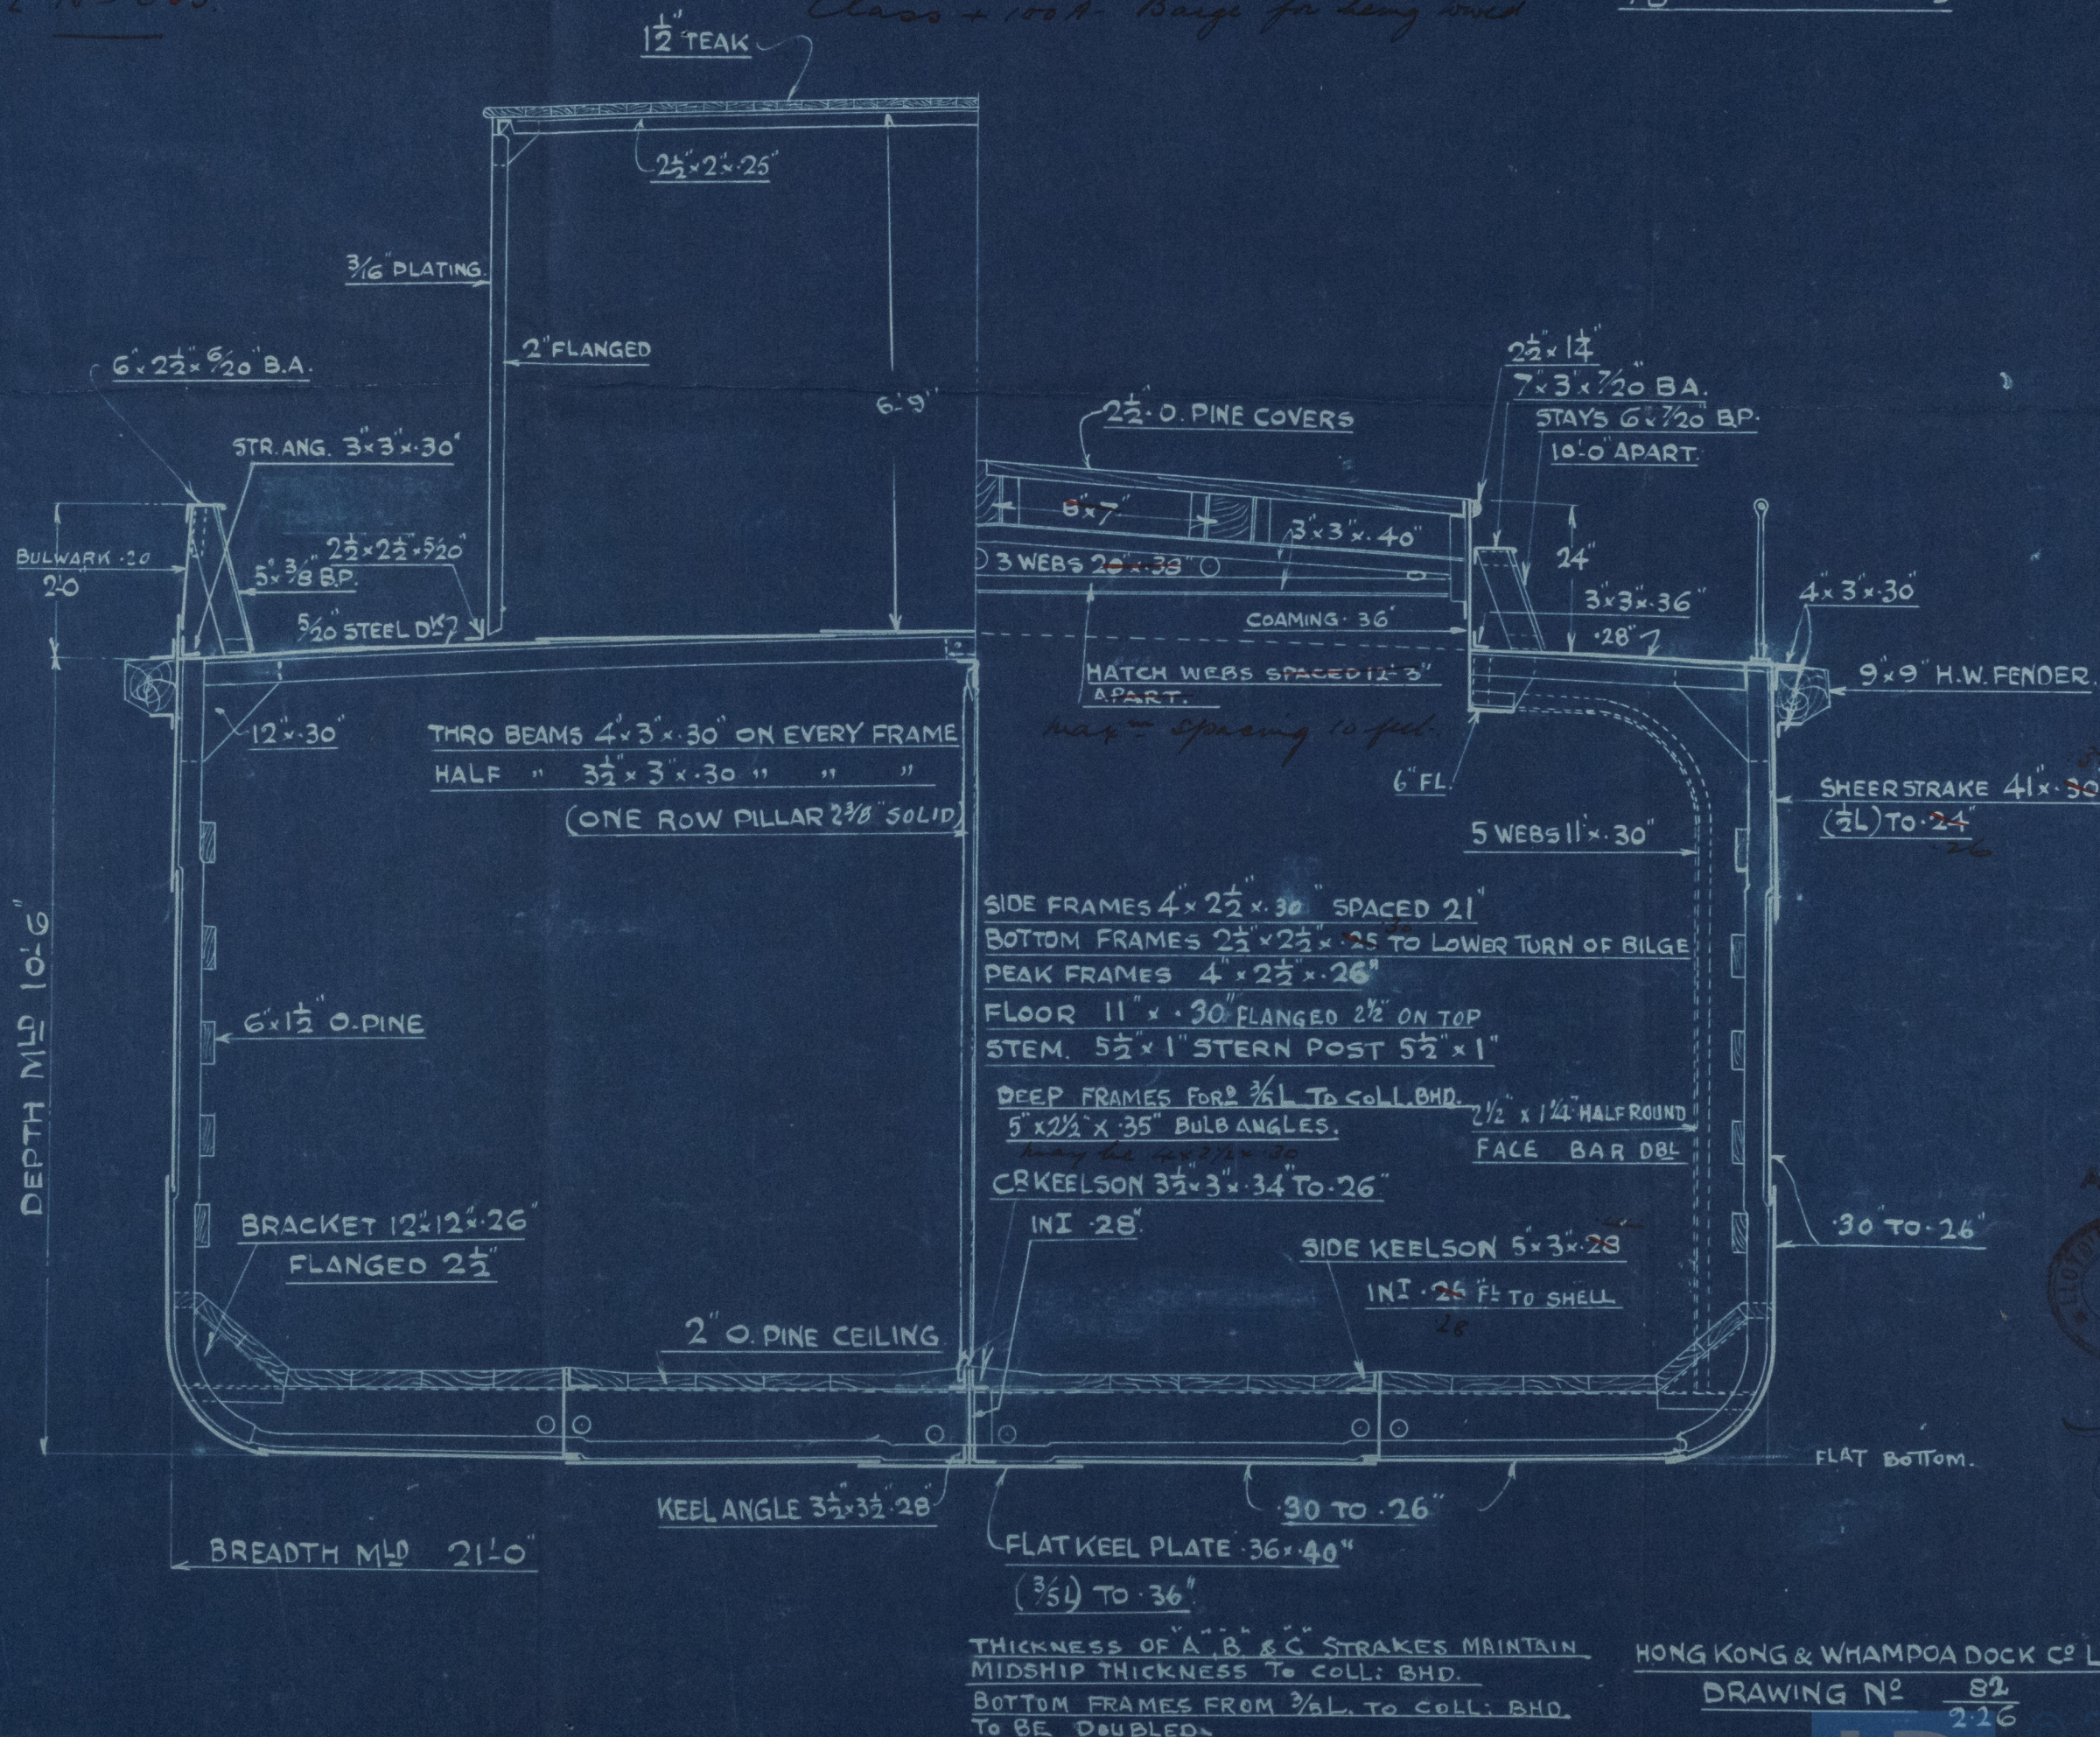

APPROVED



Strengthening forward may be dispensed with



Lloyd's Register Foundation

010208-010218-0065

GEN. BOX NO 940.

M.S. Barge. M.L. 3.

E. E. 9



© 2021

Lloyd's Register
Foundation