

SHIP No 633  
STEM, STERN POST & RUDDER

STEEL TOWING LIGHTER *hull propelled*


DIMS 95'-0" B.P. x 21'-0" x 10'-6" MLD

SCALE 1" & 3" = 1'00T.

MATERIAL :- FORGED STEEL

A = FULL AREA OF RUDDER = 36.3  
D = C. G. ABAFT PINTLE = 2.75  
A x D = 99

*Note:- About 20% under requirements of Tables for  
Considered maximum allowance for  
Tow Barge.*

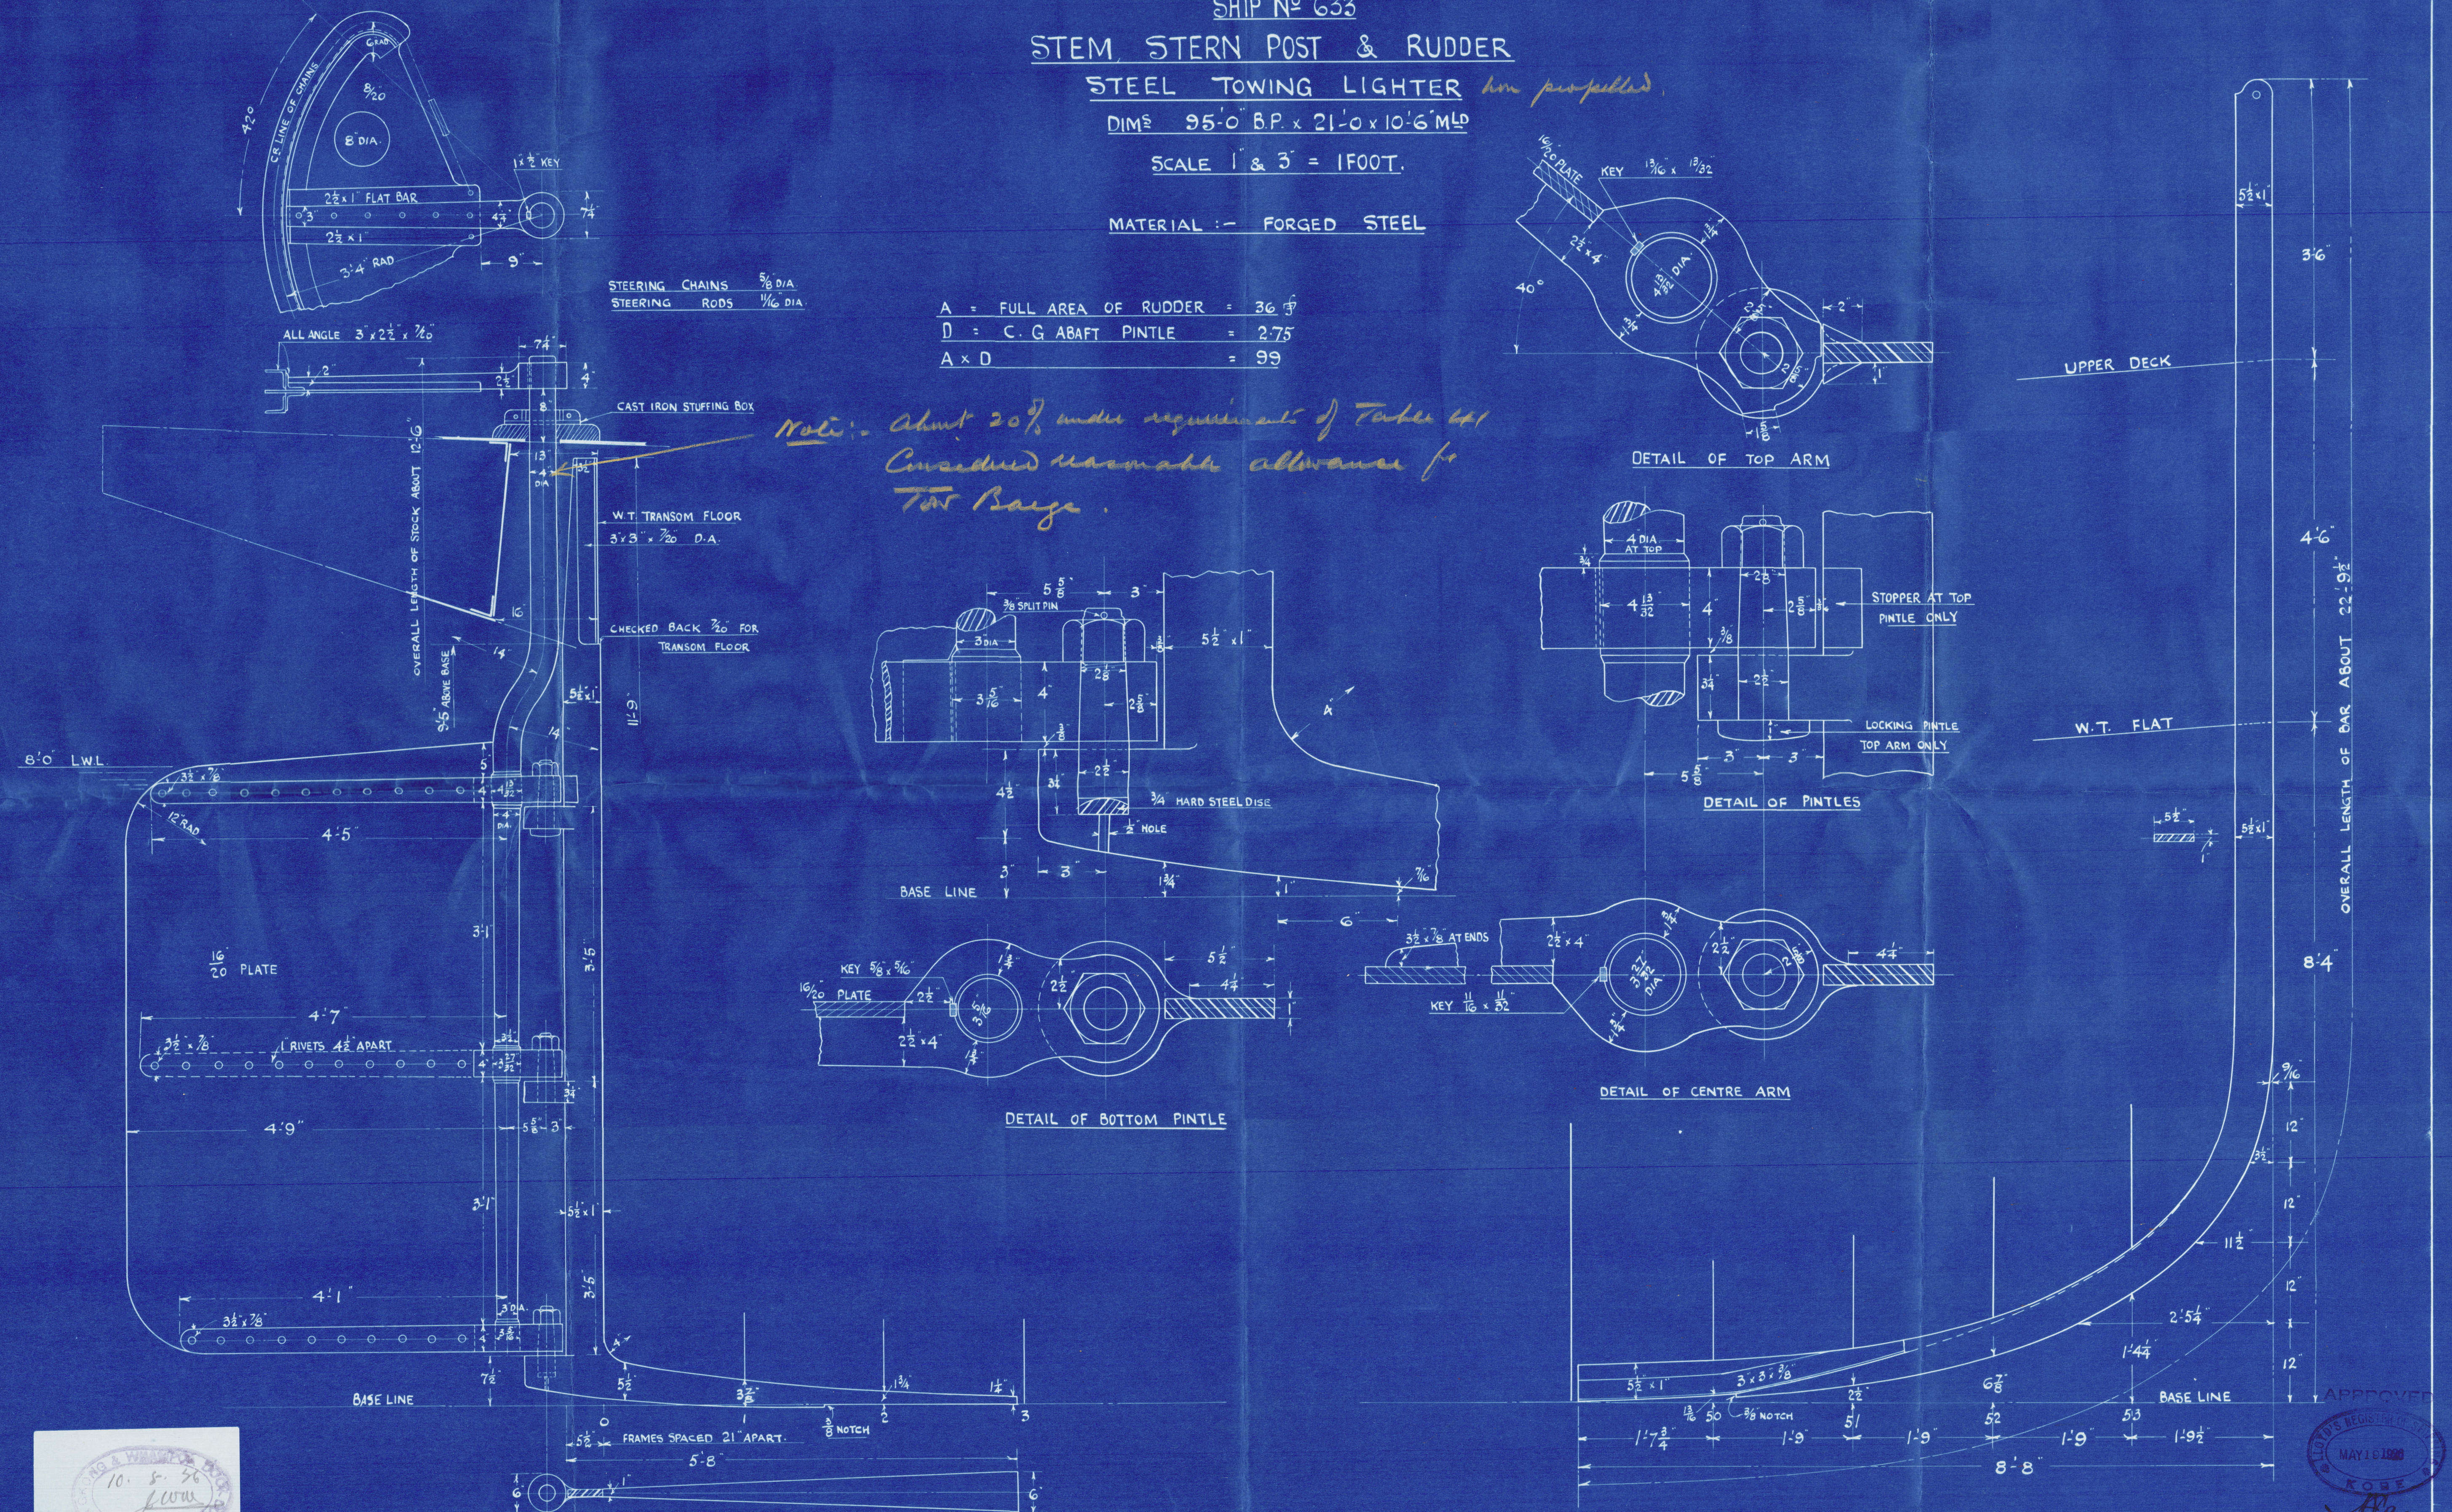



London. 633

Stem, Sternframm & Rudder

Barge M.L. 3.

GEN. BOX NO 940



© 2021

Lloyd's Register  
Foundation

010208-010218-0066