
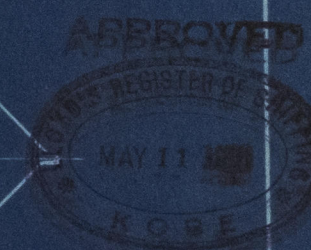


# STEEL LIGHTER PROFILE & DECK

LENGTH B.P. 95'-0"  
BREADTH MLD 21'-0"  
DEPTH MLD 10'-6"

SCALE  $\frac{1}{4}$ " = 1 FOOT.

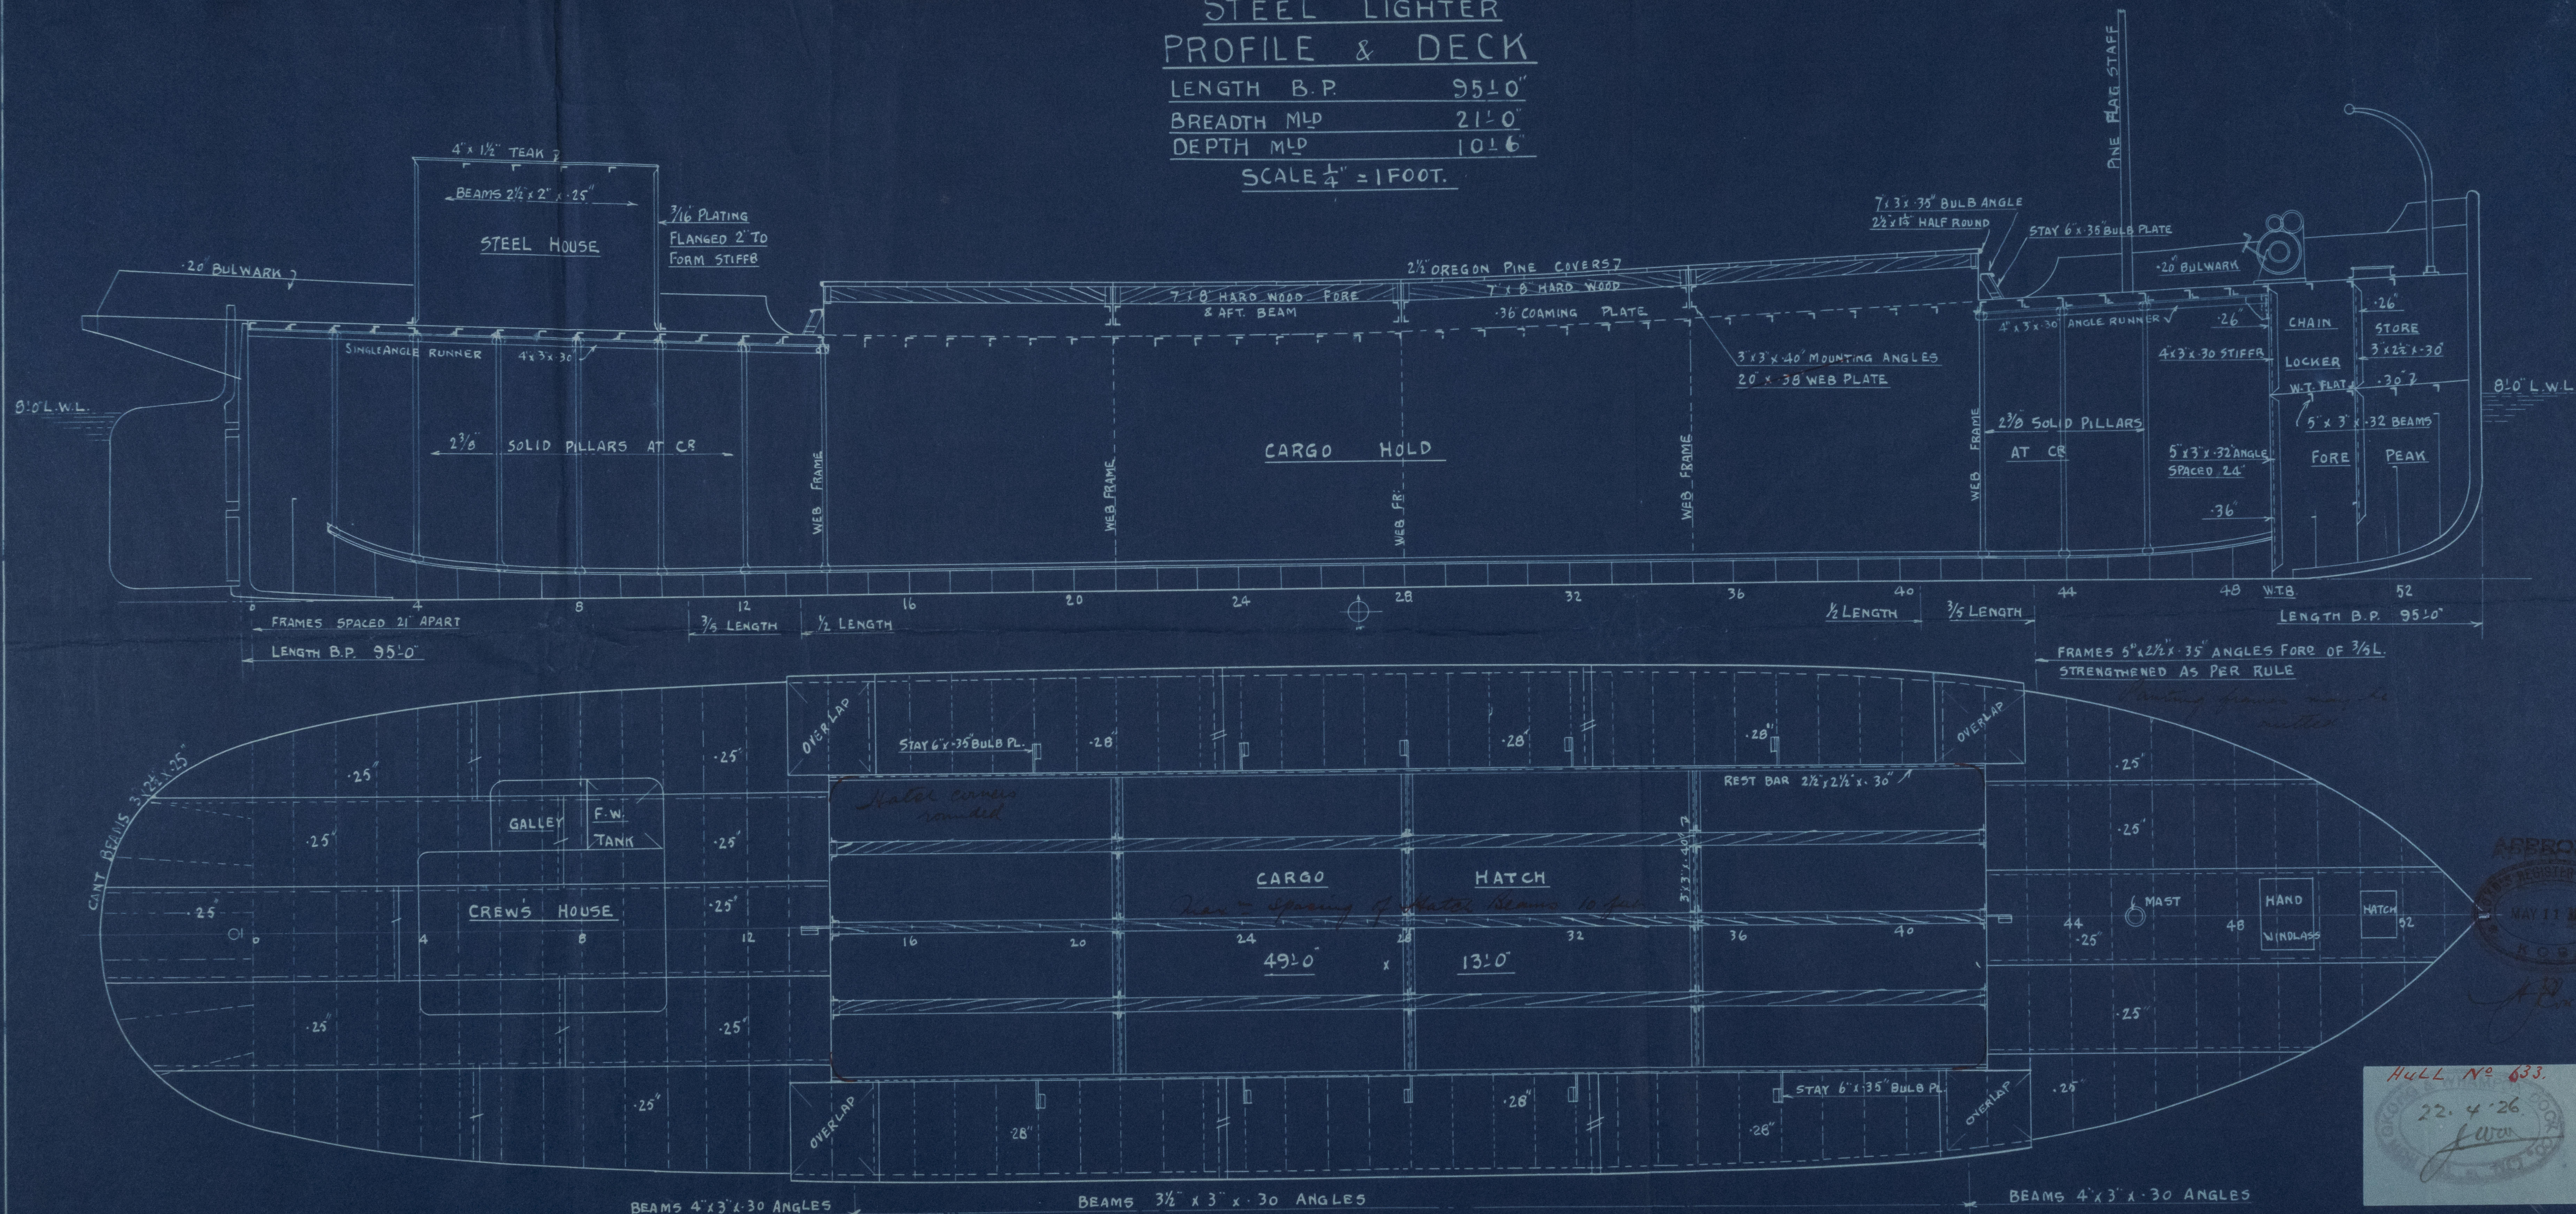

HULL No. 633.  
22. 4. 26.  
J. W. J.

H. K. & WHAMPOA DOCK CO. LTD.  
DRAWING NO. 201  
2-26.


Lloyd's Register  
Foundation



~~GEN. BOX 112~~ 940

---

1890

 

Lloyd's Register  
Foundation