


12 OCT 1945

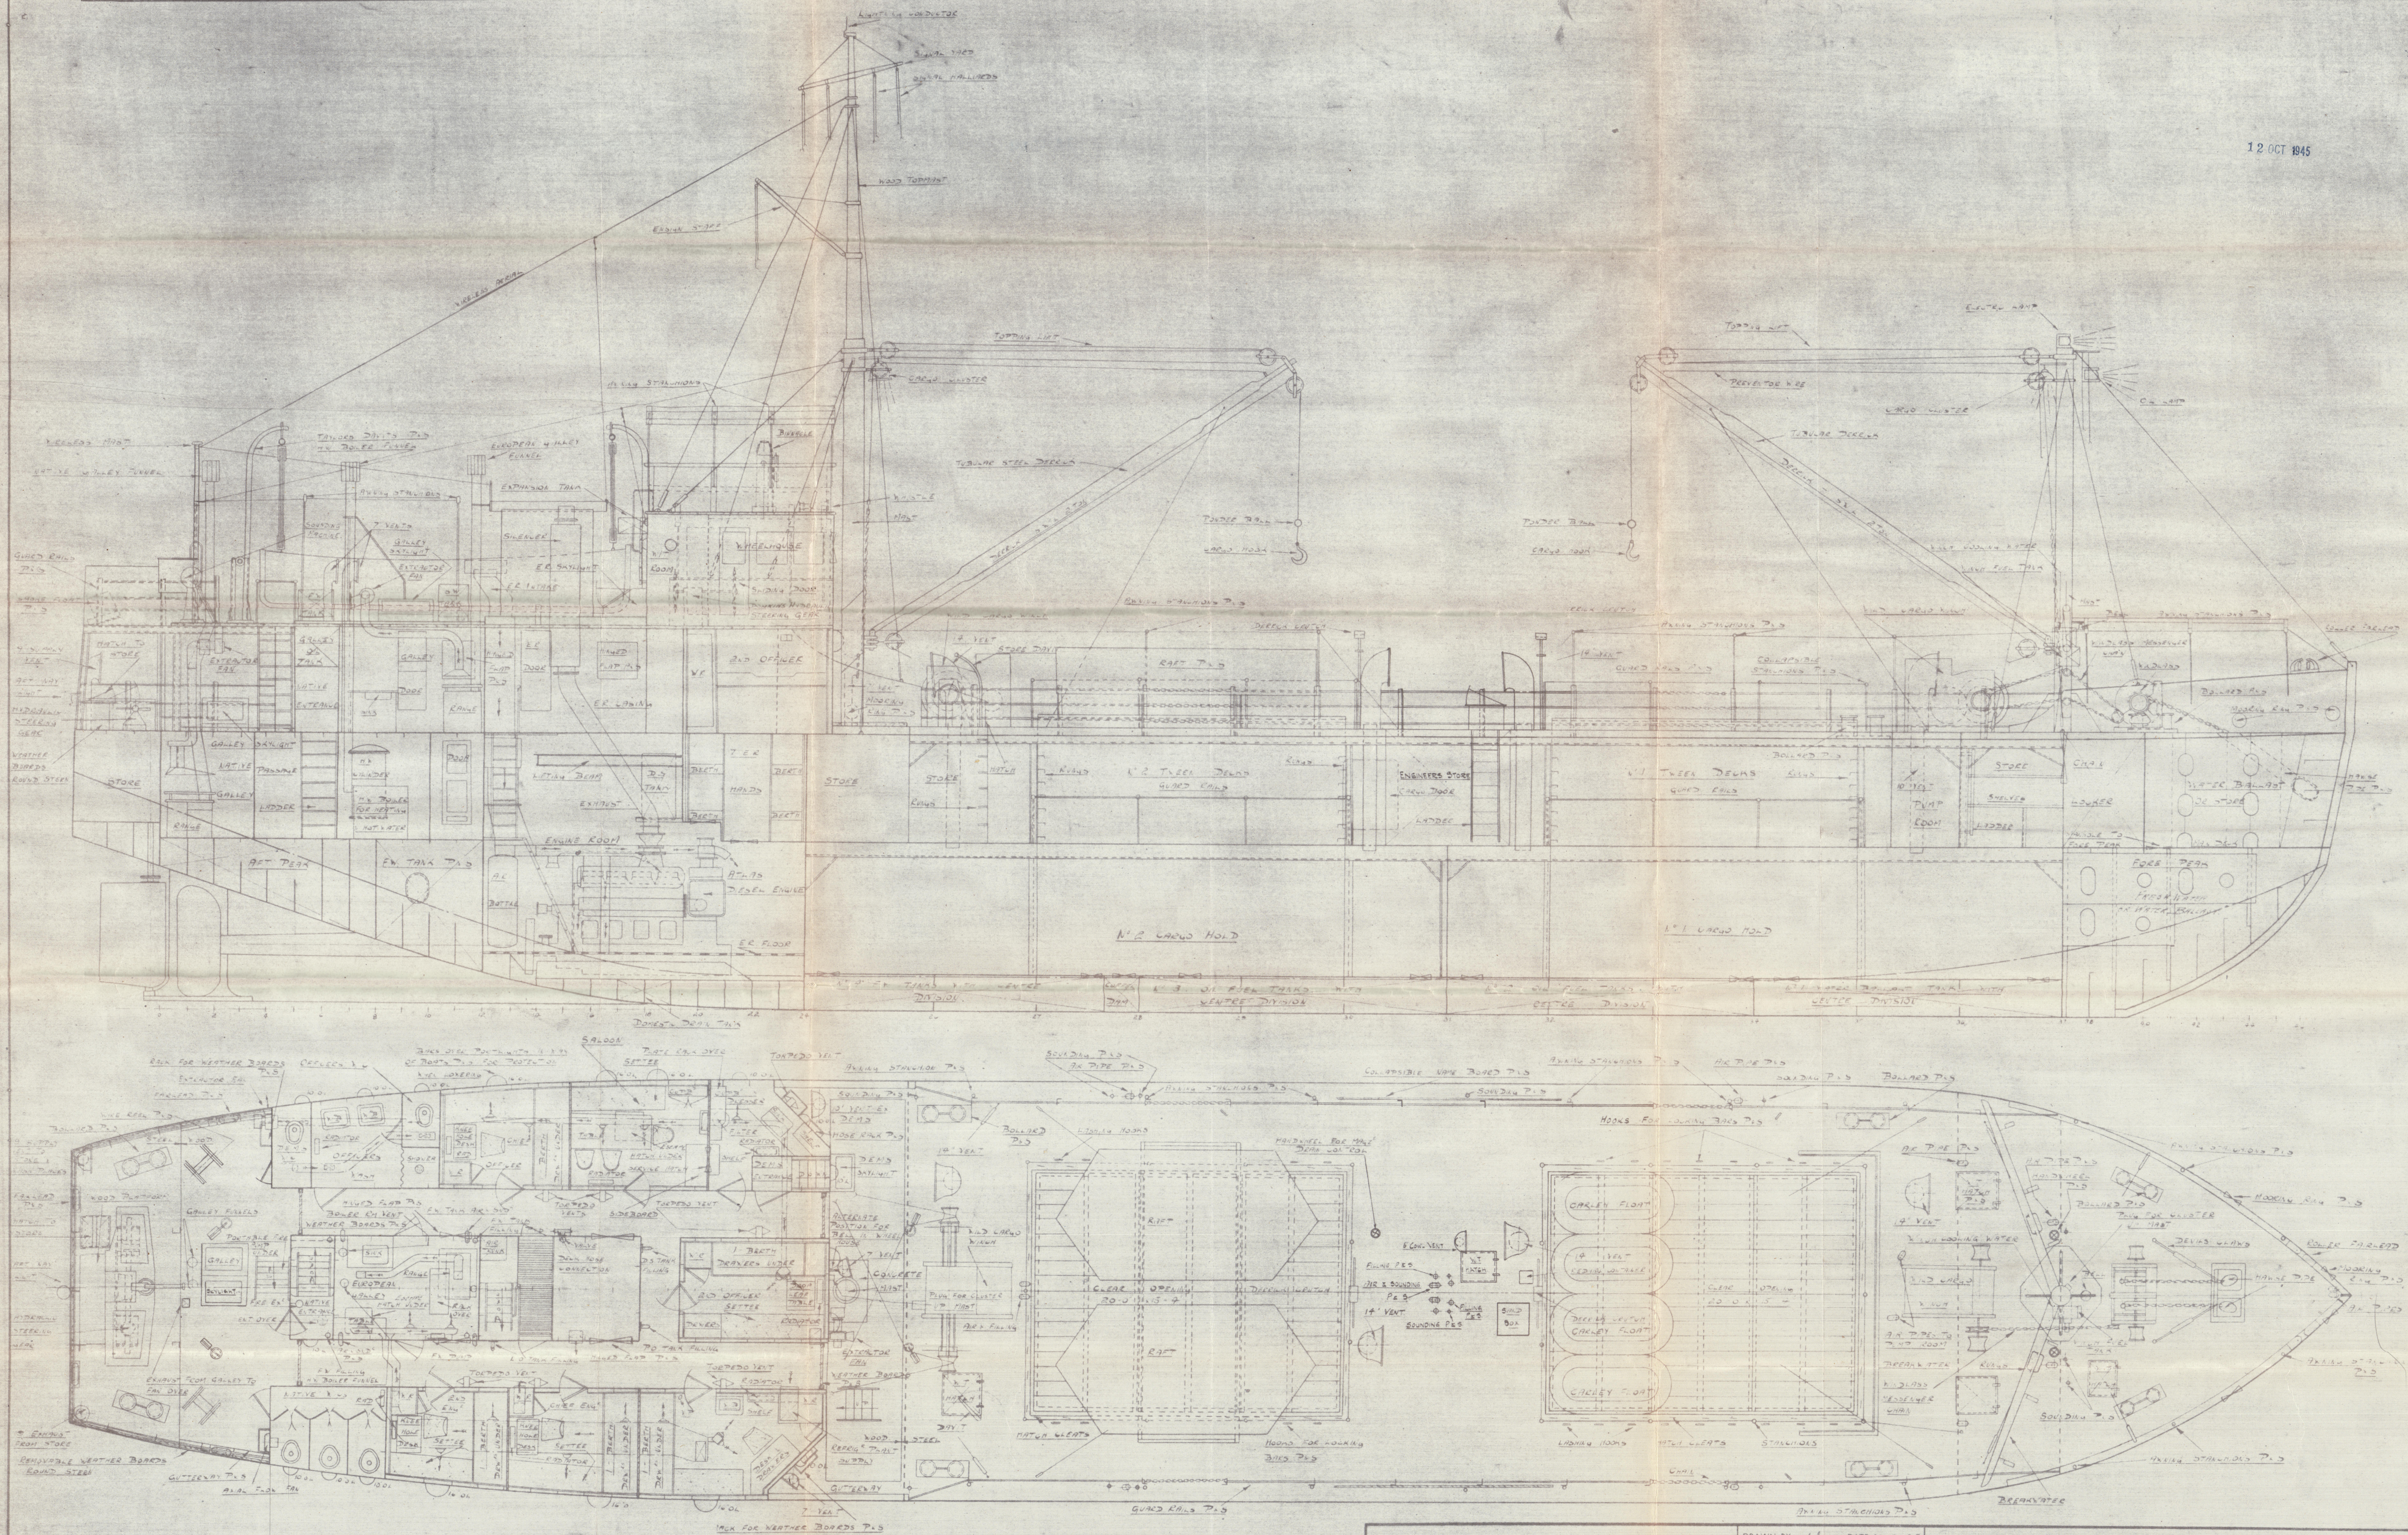

"EMPIRE SEALION"
A/M S. 1119

DIMENSIONS.
LENGTH O.A. 145'-1"
LENGTH B.P. 141'-0"
BREADTH MLD. 27'-0"
DEPTH MLD. 11'-0"

RICHARD DUNSTON LTD.
SHIPBUILDERS,
THORNE, YORKSHIRE

DRAWN BY	61	DATE	3-5-25
TRACED BY	62	DATE	3-7-25
CHECKED BY		DATE	
REVISIONS			
No.	DATE	PARTICULARS	

This Drawing and the Information it contains are the Property of RICHARD DUNSTON LTD. It is not to be Traced, Copied or Published without their Written Consent, nor is the Information thereon to be misused in any way.

RD No. S.473 DRG. No. 4500/298/1

FILE: GENERAL ARRANGEMENT (AS FITTED)

SCALE: 1" TO ONE FOOT

010209-010219-0150

1

General Argt. (SHEET 1)
R. Dunston 473.

12 OCT 1945

General Argt. - Peck.

R. Dunston Ltd.

No. 5472.

Rebuilt.

EMPIRE SEALION NOW SERUDOM.

"Empire Sealion"

Sealion
473 (1)

