



10.11.21.

PROFILE & DECK PLAN S.S. MARI ex J.S. CLAYRECK


SCALE 1/8" = 1 FOOT

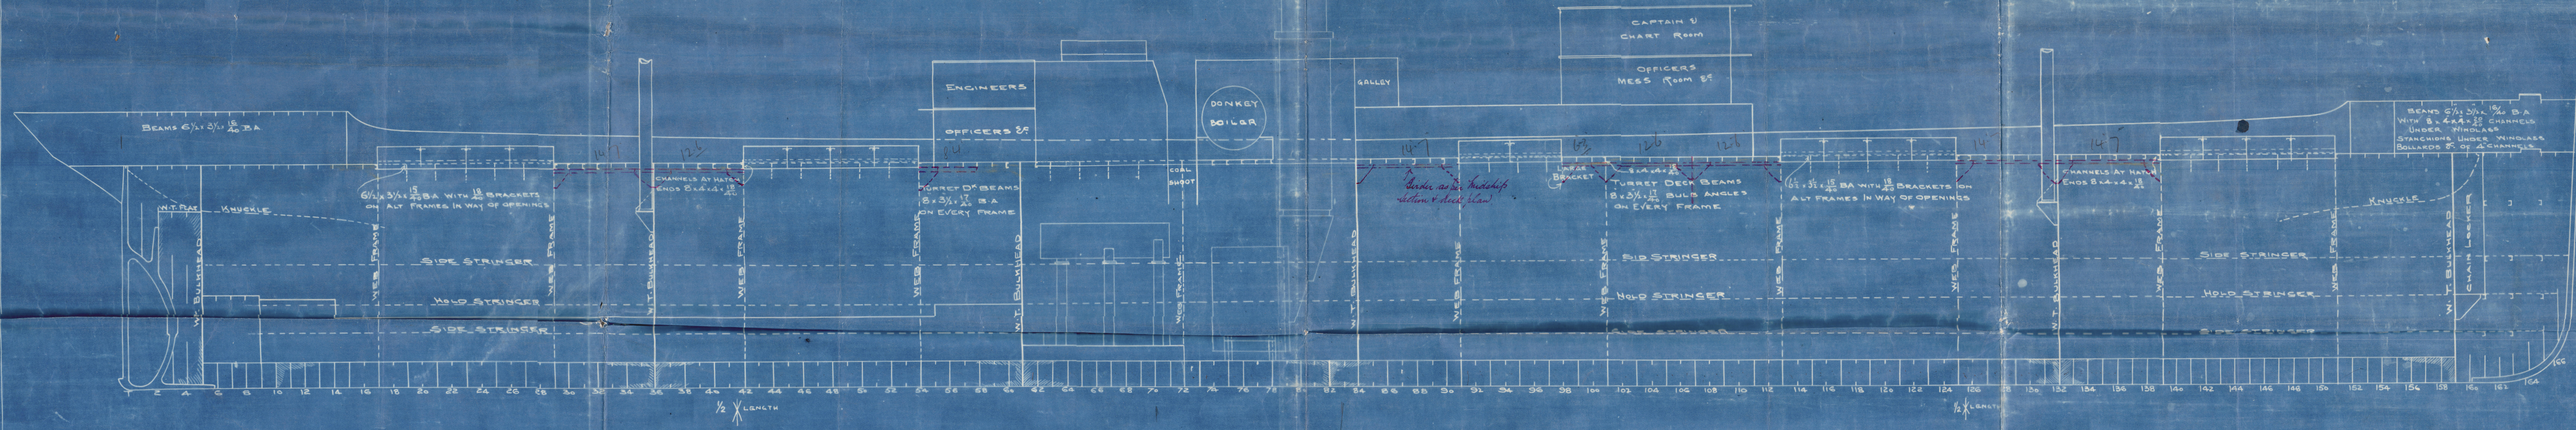

PLAN VIEW OF TURRET & HARBOUR DECKS

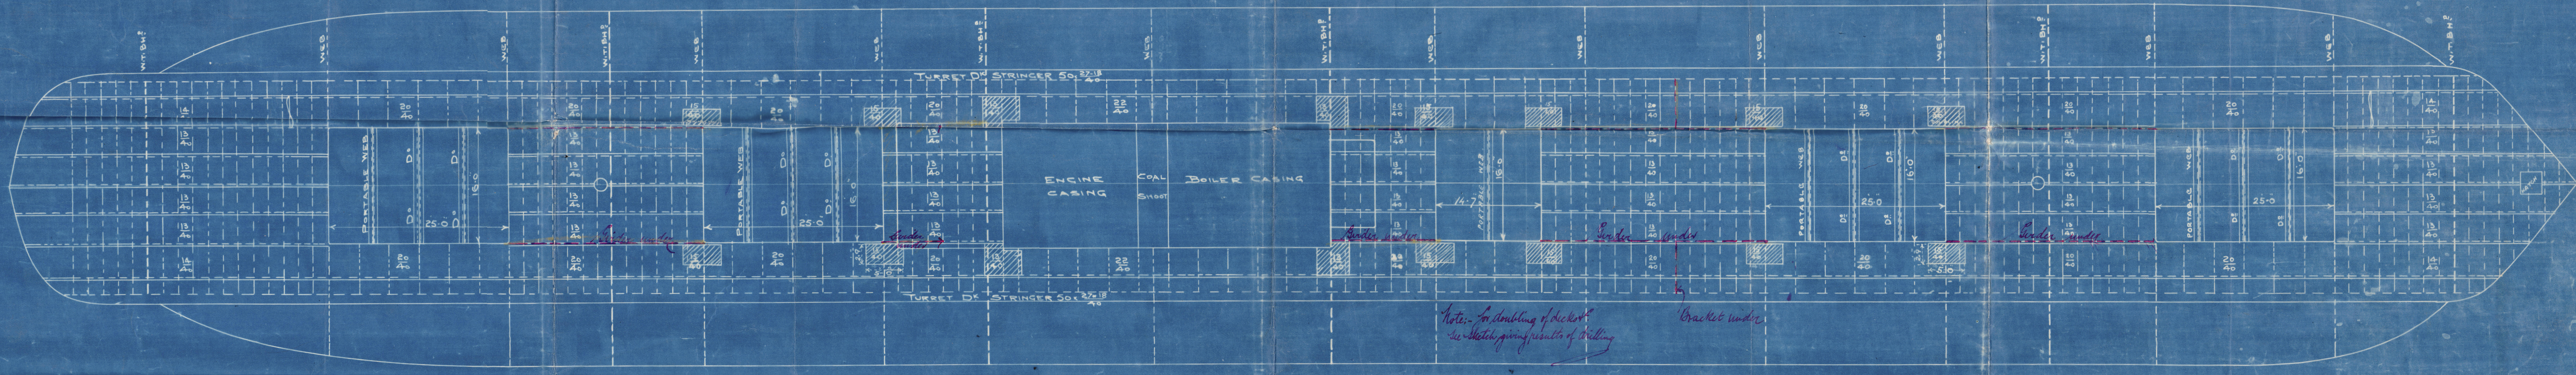

PLAN VIEW OF HOLD STRINGER

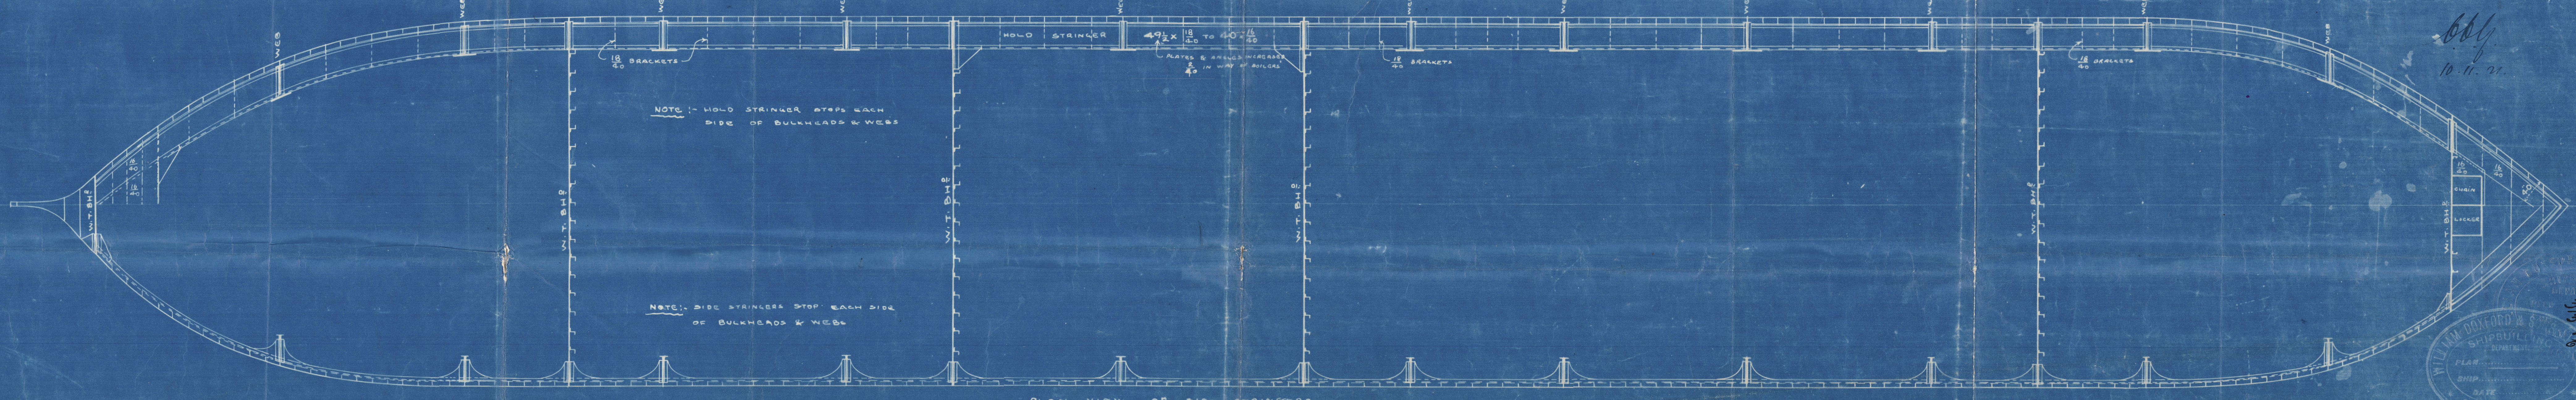

PLAN VIEW OF SIDE STRINGERS

10.11.21.



Mari

Profile & Deck Plan

No. 304

C. D. Mari

"S/S. "Mari"

Profile & Deck Plan

010219 - 010228 - 0070

S/S Mari

Dec. 6 1882

© 2012



Lloyd's Register
Foundation