

PROFILE & DECK PLANS ^S/110433: 2-3-4


— DIMENSIONS AS PER RULE —

LENGTH _____ 369.4

BREADTH _____ 50.79

DEPTH _____ 27.70

— CLASS 100.A.1* —

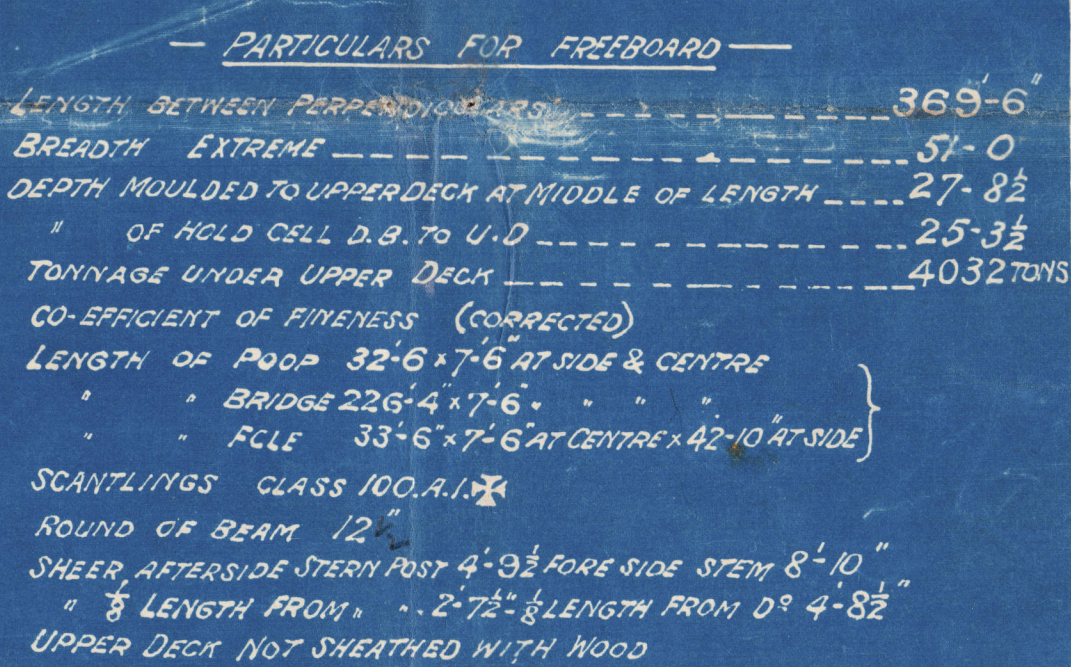

JOHN READHEAD & SONS LTD
SHIPBUILDERS. &c
SOUTH SHIELDS.

Messrs J Readhead & Co

No. 433

SS "TREVIDER" now

NEWCASTLE-ON-TYNE

REPORT No. 64228


Picotte



Profile & decks as built

~~"Rosina Topie"~~

Lika

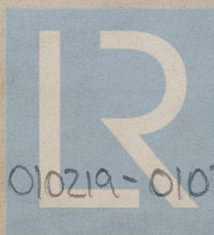

© 2021

010219-010228-0225

Lloyd's Register
Foundation