

TI & T2.

SHIPS NOS. 365-372

MIDSHIP SECTION.

SCALE: 3/4" = ONE FOOT. DRG. NO. 15.

DIMENSIONS: 141'-0" B.P. x 27'-0" MLD. x 11'-0" MLD.

CLASS: B.S. * (BULK OIL CARRIER, SPECIAL SERVICE).

DRAUGHT 10'-0".




EQUIPMENT. C 16.

2 BONES ANCHORS (STOCKLESS) ~ 9 CWT.
1 STREAM ANCHOR (EX. STOCK) ~ 3 CWT.
165 FATHOMS 1" STUD LINK GABLE.
45 FATHOMS STREAM WIRE 2 1/2" CIRC. 6/12 CONSTR.
75 FATHOMS TOW LINE 2 1/2" CIRC. 6/12 CONSTR.
90 FATHOMS CHAINER 1 @ 5/2" CIRC. HEMP.

29 NOV 1943

Approved
3.12.43
C.D.

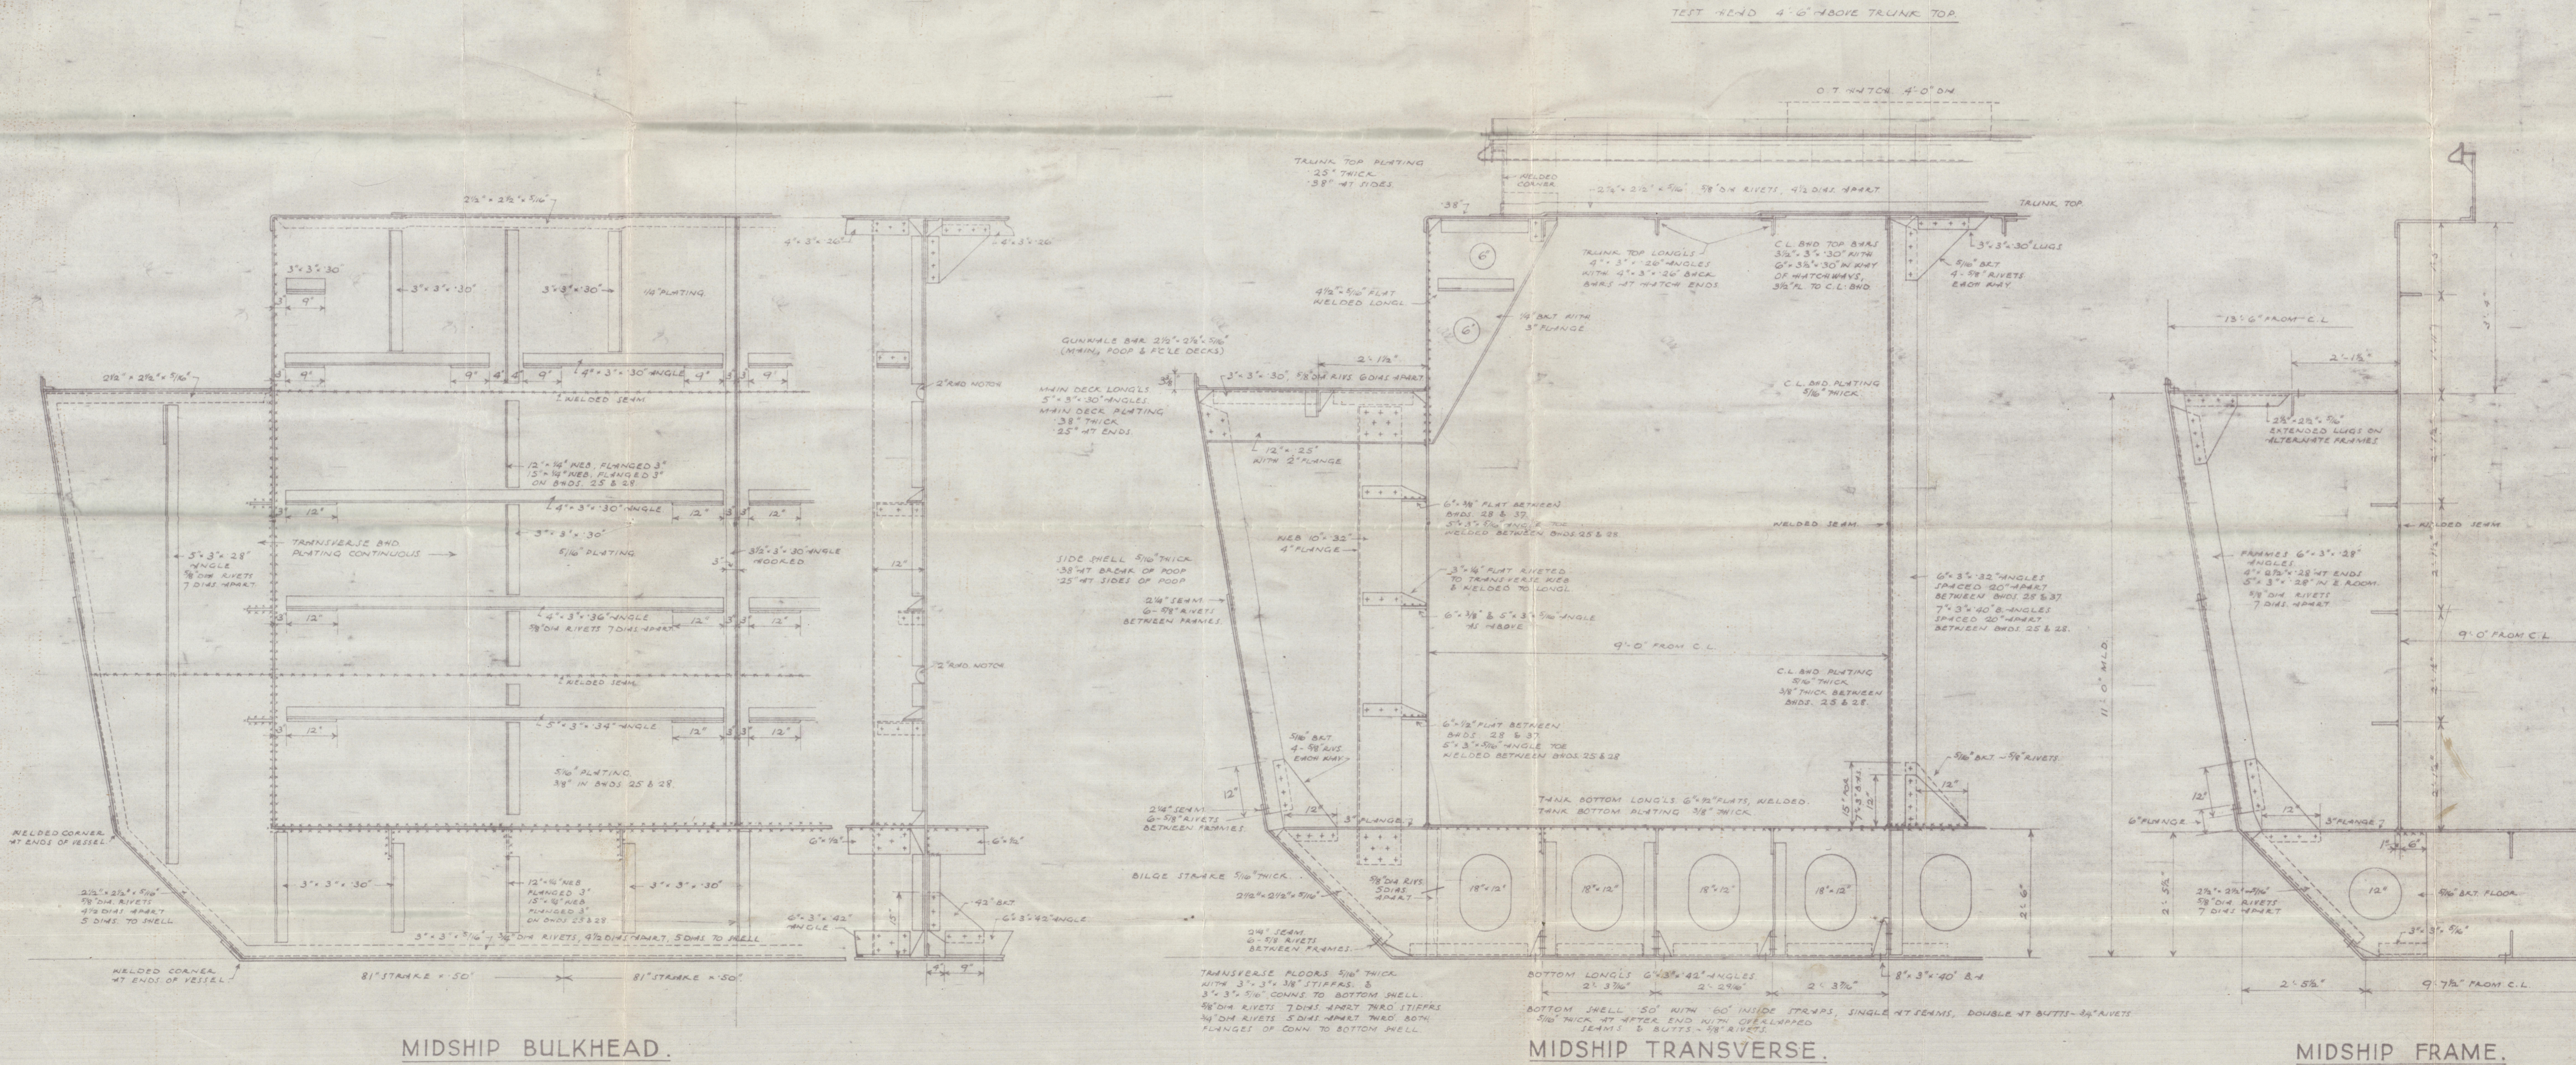

X33421
4-11-43

DRG. NO. T. 6289.

Midship Section

John Headhead & Sons

N^{os} T1 & T2.

3.12.43.


ARZELLA ex CHANT 60

CHANT 61.

Bag

29 NOV 1943

John Headhead & Sons T1 & T2.

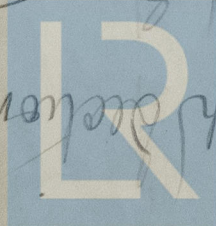

© 2021

Midship Section

Lloyd's Register
Foundation