


"**ATHELDUCHESS**"

Nº 406
PROFILE & DECK PLAN
TWIN SCREW MOTOR TANKER

DIM'S 475'-8" O.B.P. x 63'-0" x 35'-0" MTD TO UPPER DECK
LLOYDS " 473'-8" ON L.W.L. x 63'-0" x 35'-0" "
SCALE 1/8" = 1 FOOT

FLASH POINT OF OIL FUEL TO BE ABOVE 150° FAH°
SECT 35 TO BE COMPLIED WITH

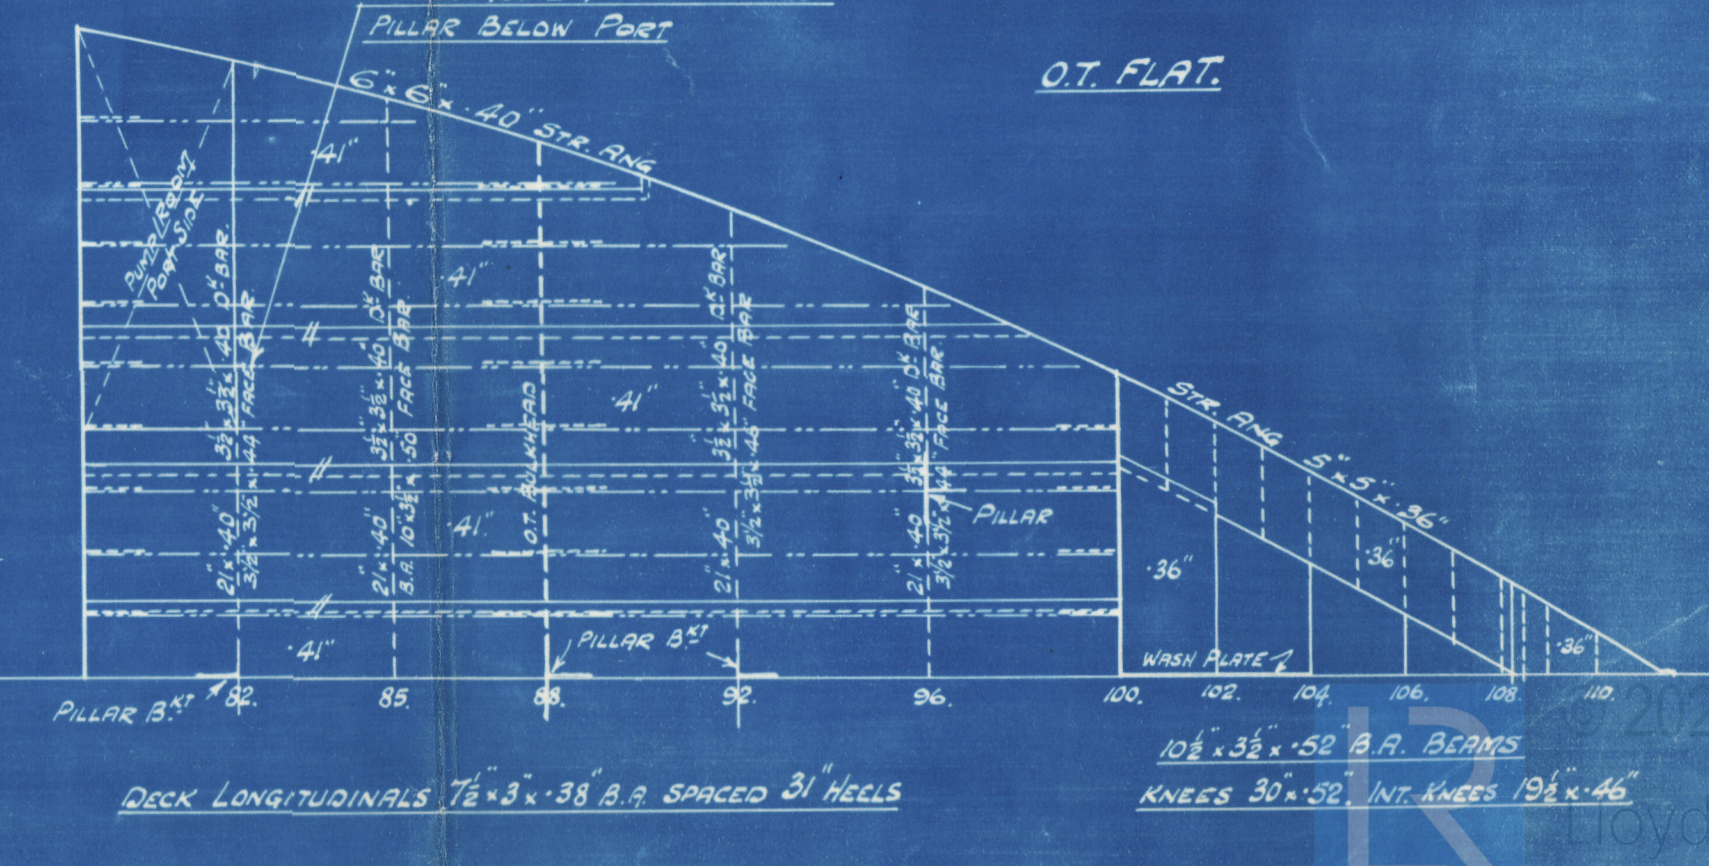

W^M - HAMILTON & Co.,

N^o 406

W.L. 3014

PROFILE & DECKS (As Built)

Mr. Athelstuchess

Greenock First Entry Report N^o 19017.

Mano

DS 606

