

"ATHELDUCHESS"  
MIDSHIP SECTION.

T.S.M.S. No 406.

SCALE 1/2" = 1 FT.

DIMS:- 475'-0" B.P. x 63'-0" x 35'-0" ML<sup>o</sup> TO UPP. DK.

RULE DIMS:- 473'-8" x 63'-0" x 35'-0"

DEPTH ML<sup>o</sup> TO 2ND DECK 27'-0"

TO CLASS 100 A.I. AT LLOYDS. CARRYING PETROLEUM IN BULK.

LLOYDS NUMERALS.

1<sup>st</sup> LONG<sup>o</sup> No. (473.8 x 35.0) = 16583.0  
2<sup>nd</sup> " " (473.8 x 35.0) = 16583.0  
1/2 TO UPPER DECK = 13.53  
1/2 " 2ND DECK = 17.55  
1/2 " BRIDGE DECK = 11.01  
d " 27 - 4.33 = 22.67



STEM 10 1/2" x 2 3/4"  
STERNFRAME 11" x 3 3/8"

EQUIPMENT NUMERAL.

L (B+D) = 46432.24  
POOP 118'-0" x 8' x 75' = 708.00  
BRIDGE 33'-85" x 8' x 75' = 203.10  
FORECASTLE 48'-5" x 8' x 75' = 291.00  
POOP HOUSE 121'-25" x 8' x 50' = 485.00  
SALOON HOUSE 33'-85" x 8' x 50' = 135.40  
EQUIPMENT No 48254.74

EQUIPMENT.


2 BOWER ANCHORS STOCKLESS EACH 8 1/2 CWT.  
1 " ANCHOR " 60 1/2 CWT.  
1 STREAM ANCHOR 23 1/2 CWT.  
300 FATHOMS 2 3/4" STUD CHAIN CABLE.  
120 " 1 3/4" STEEL CHAIN OR 5 1/4" STEEL WIRE.  
130 " 6" STEEL TOWLINE.  
2 @ 100 " 2 3/4" STEEL WIRE OR 8" HEMP HAWNSERS.  
2 @ 100 " 2 3/4" " " 8" " WARPS.

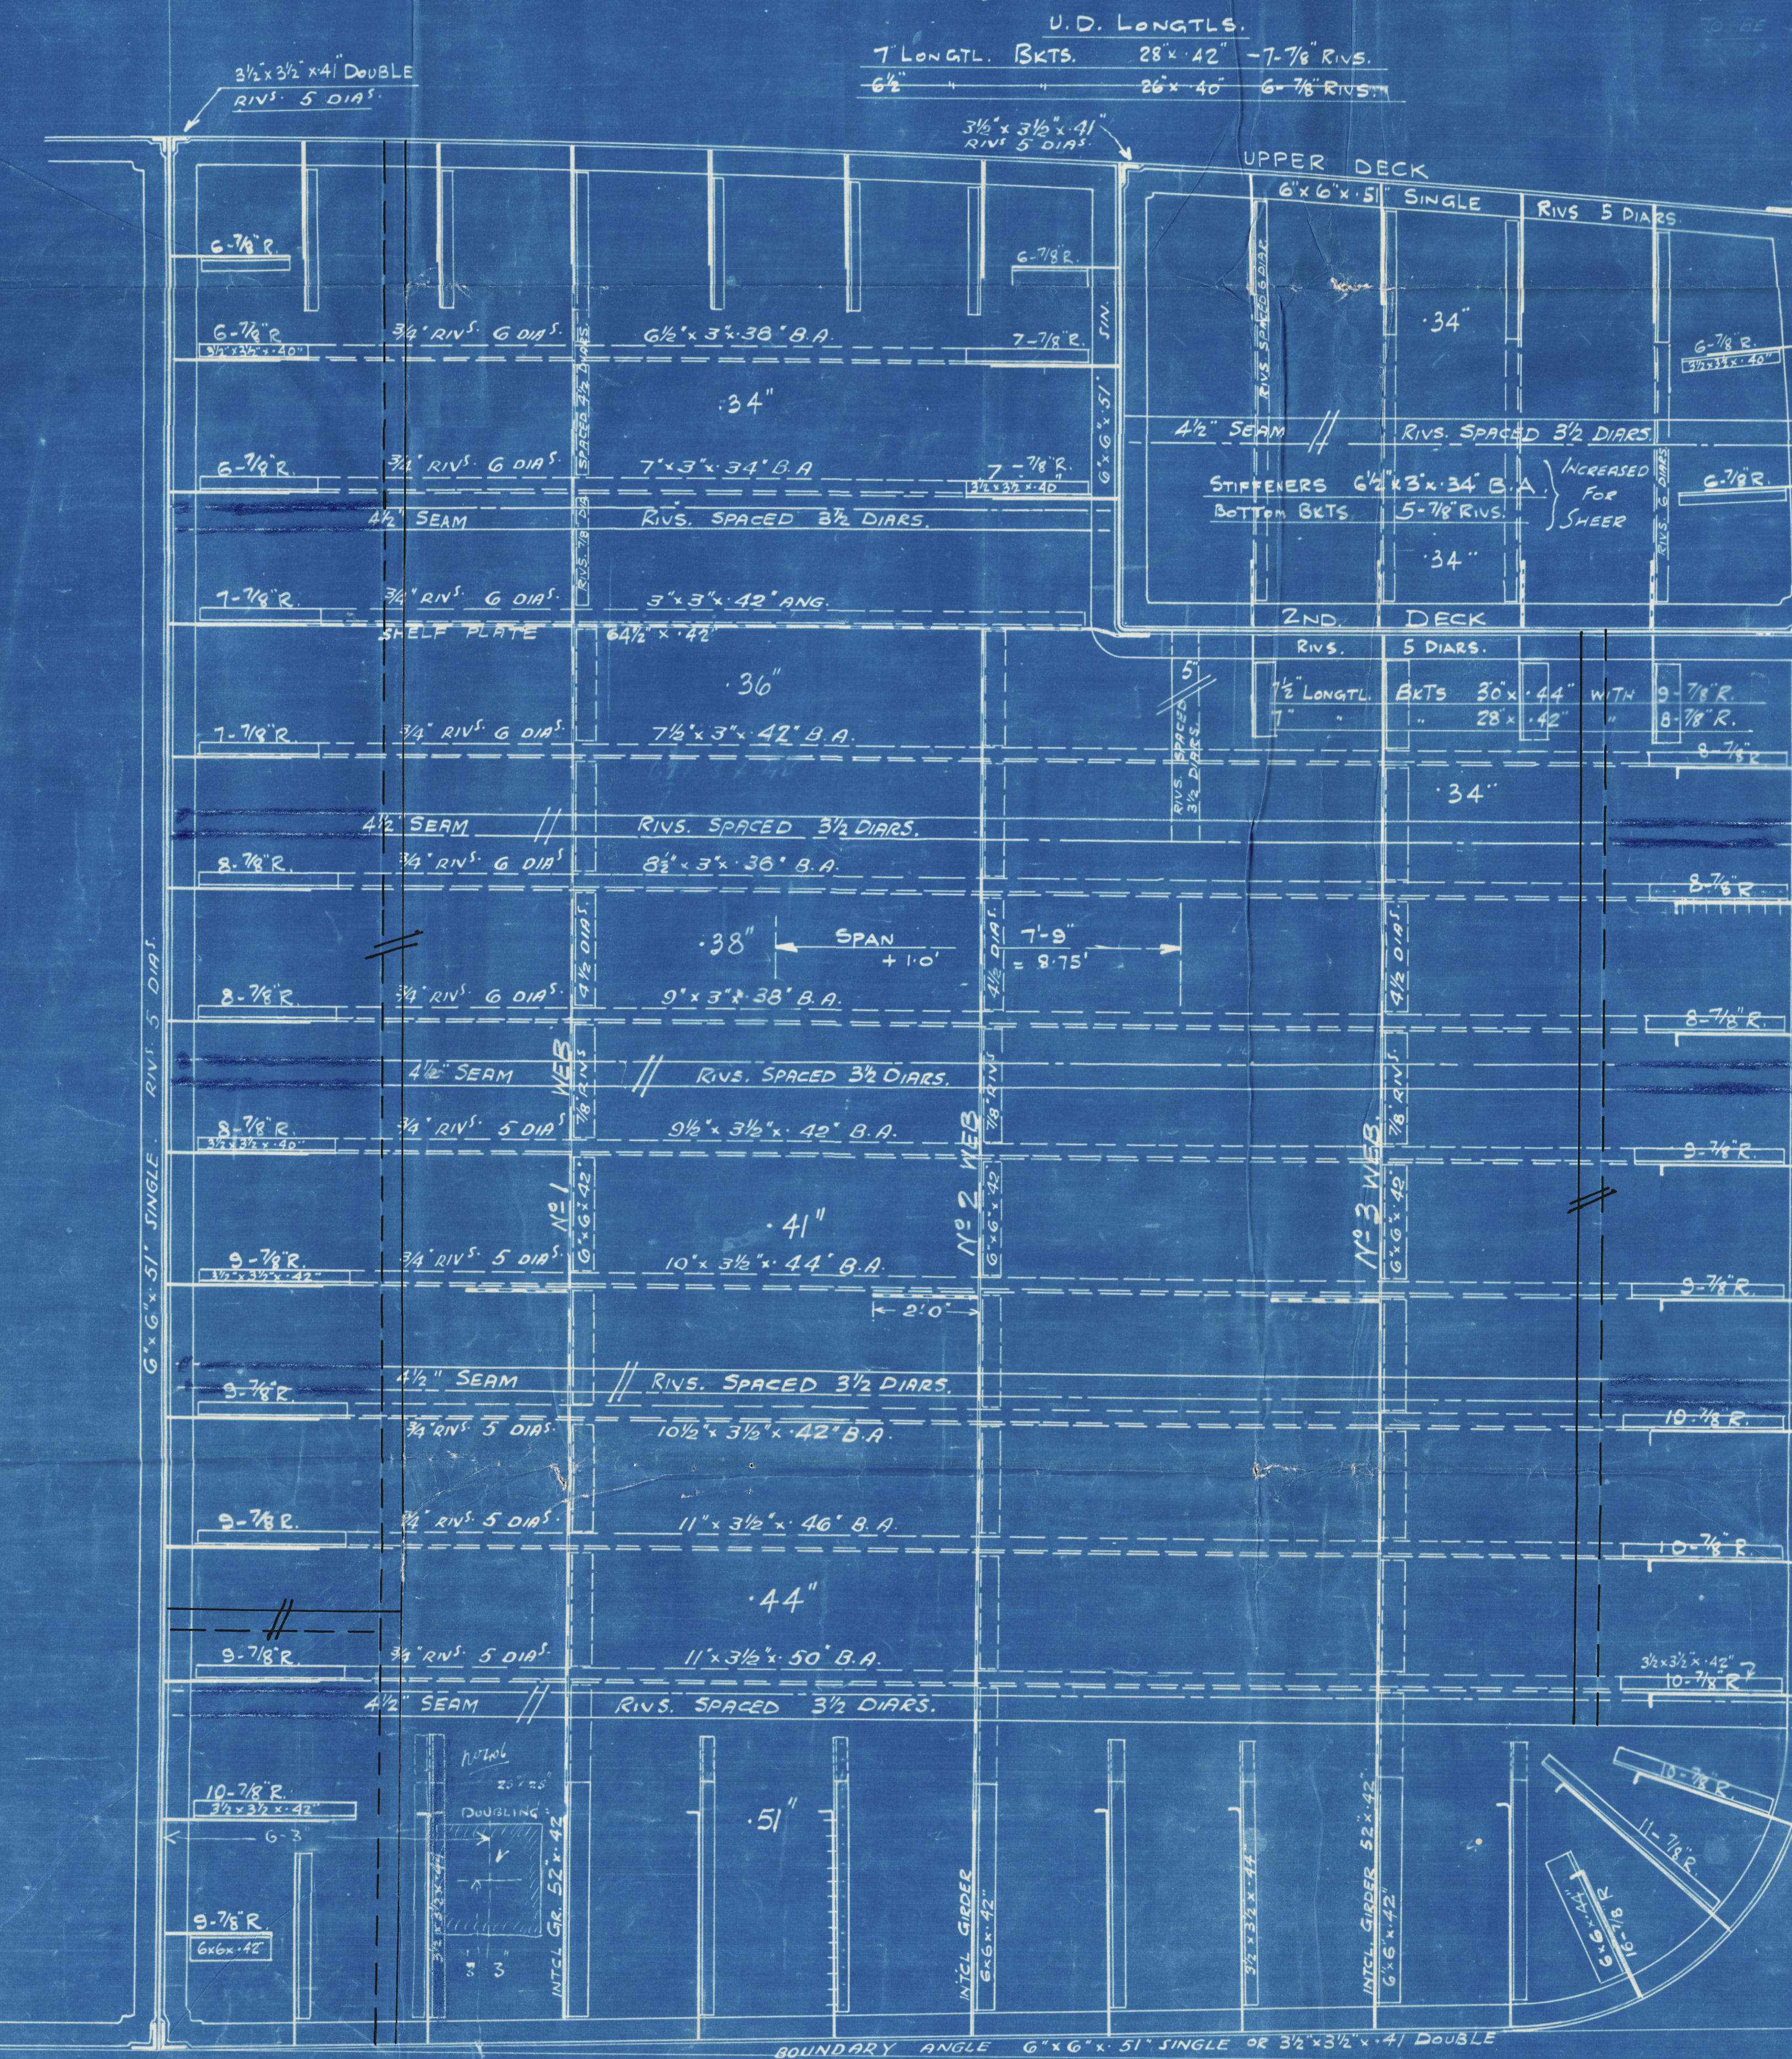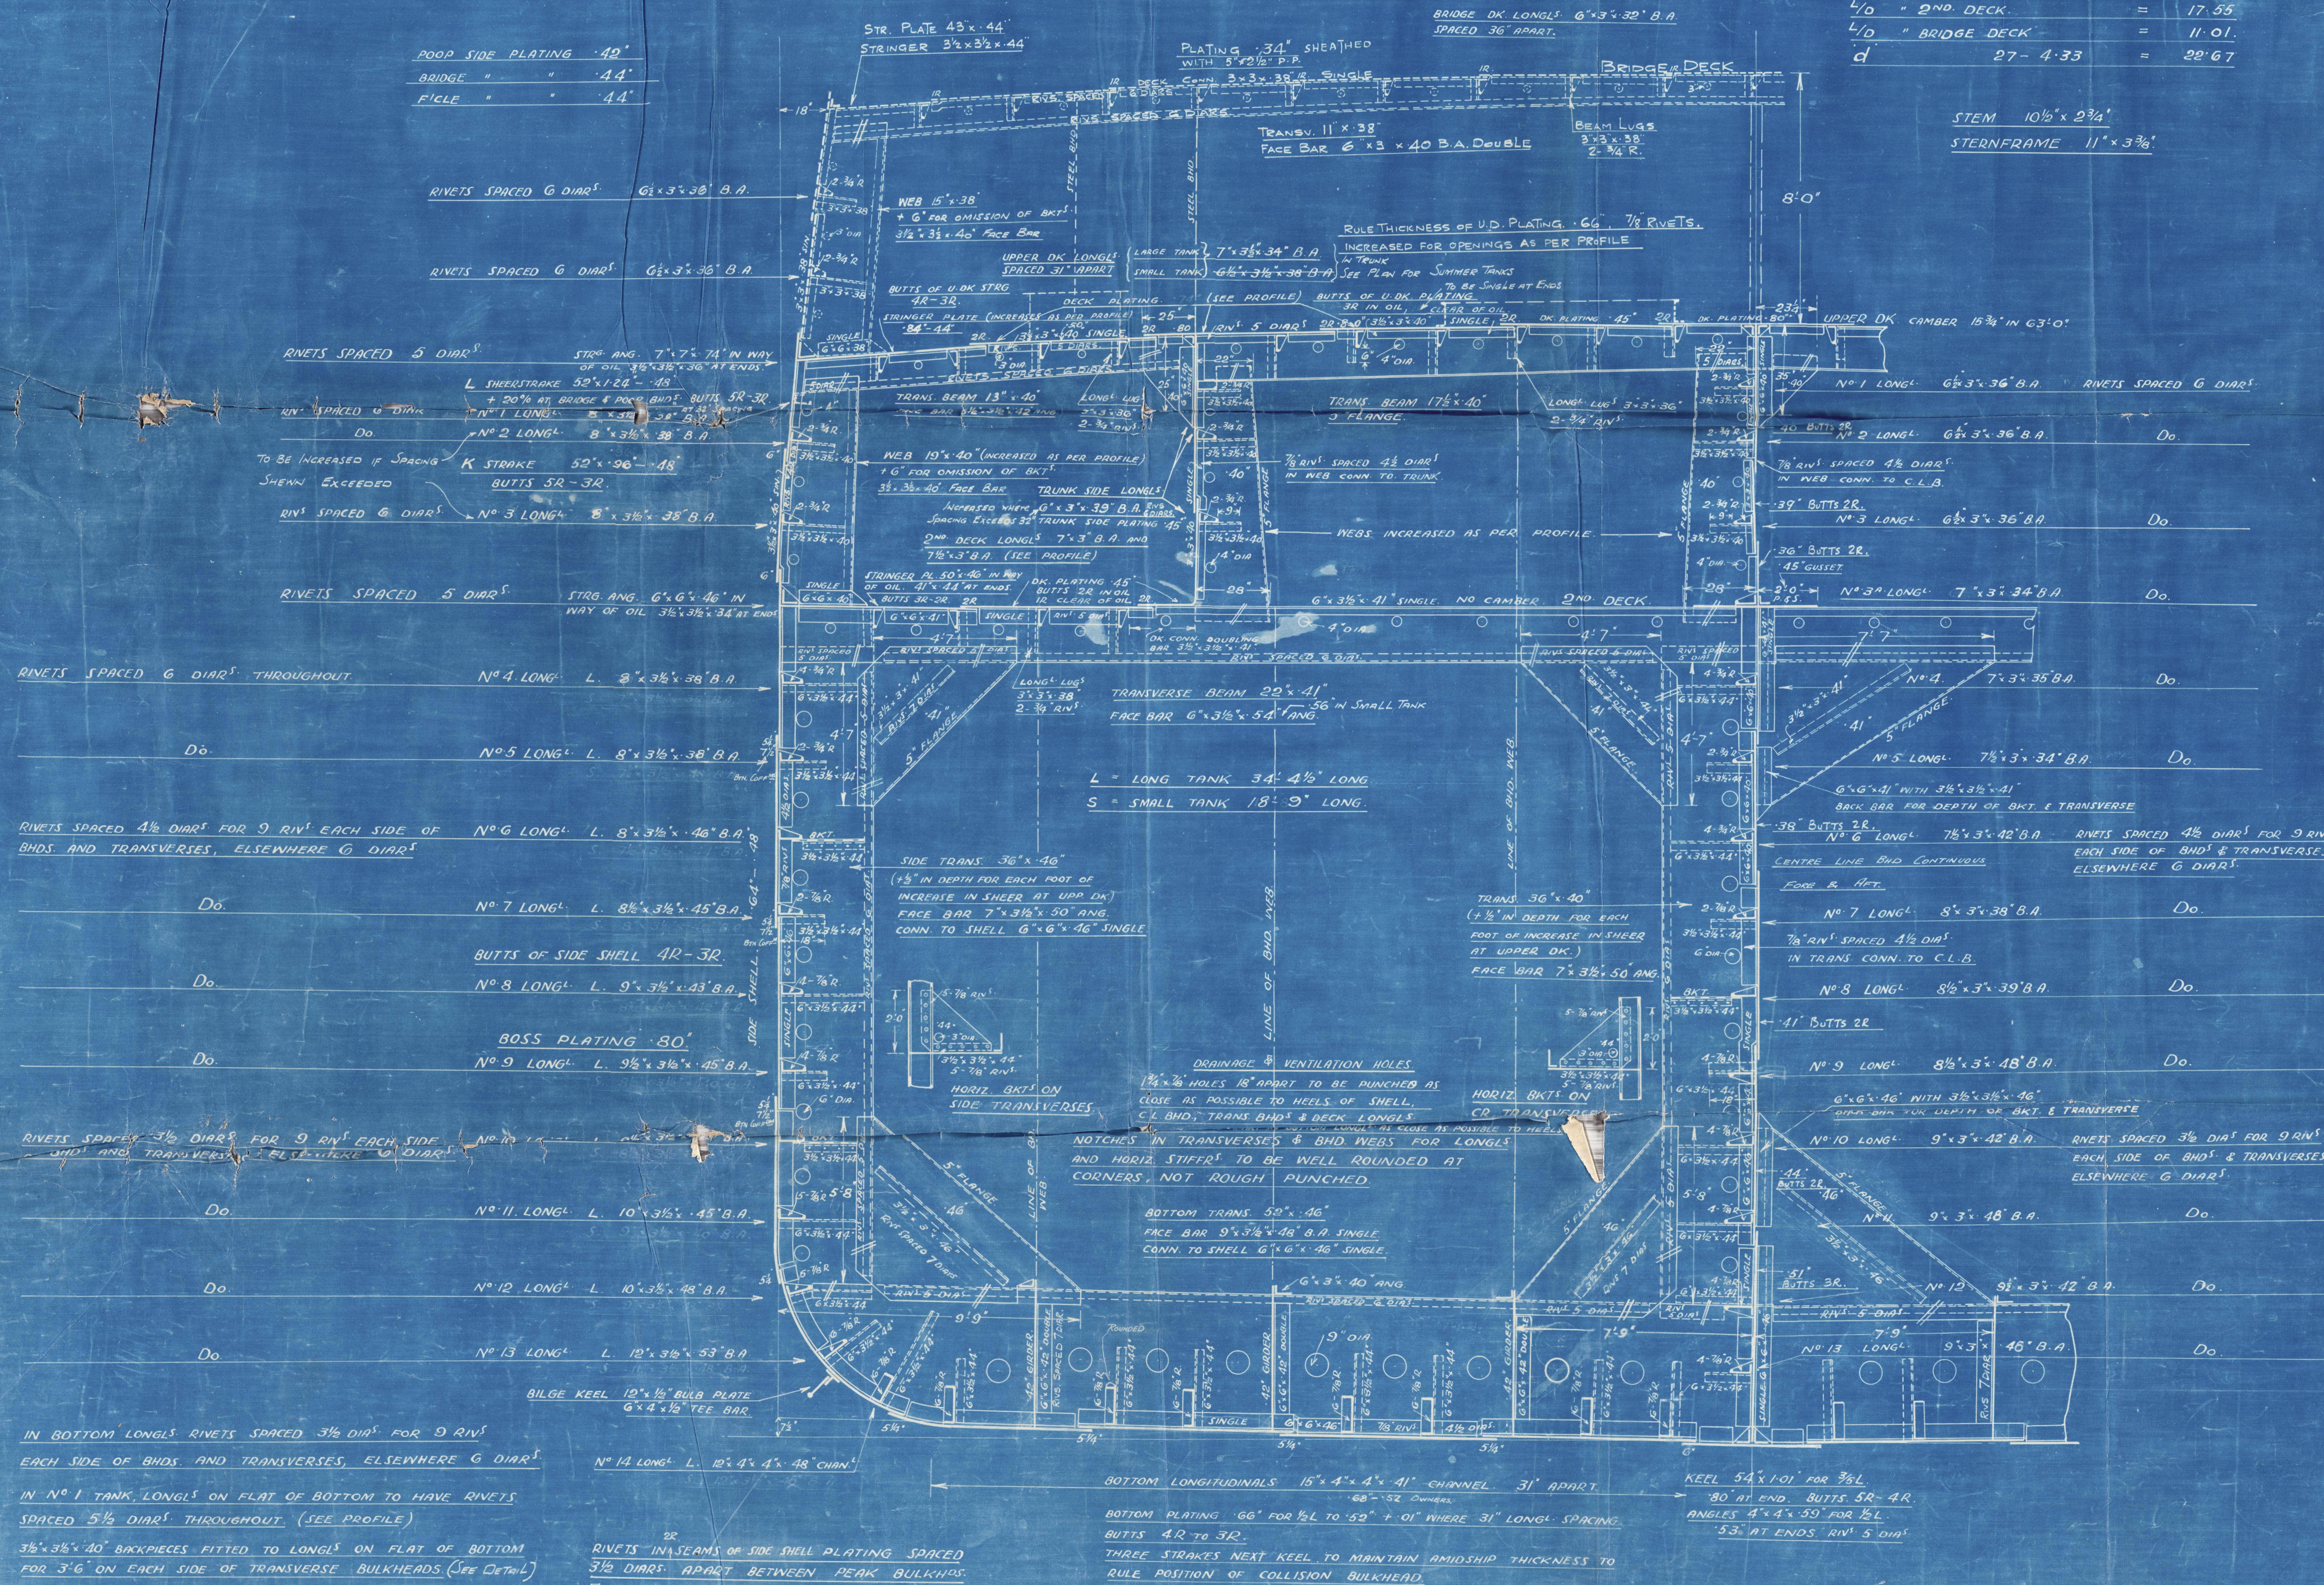


BOTTOM LONGTL. BKTS. 55' x 44", 17 1/2\"/>

O.T. BULKHEAD

ALL BOTTOM AND SIDE SHELL BKTS. IN HOLDS TO BE FLANGED ON FACE.  
BKT. ELSEWHERE WITH 10 RIV. # OVER TO BE FLANGED ON FACE.  
ALL BKT. CONN. TO BE SAME THICKNESS AS BULKHEAD.

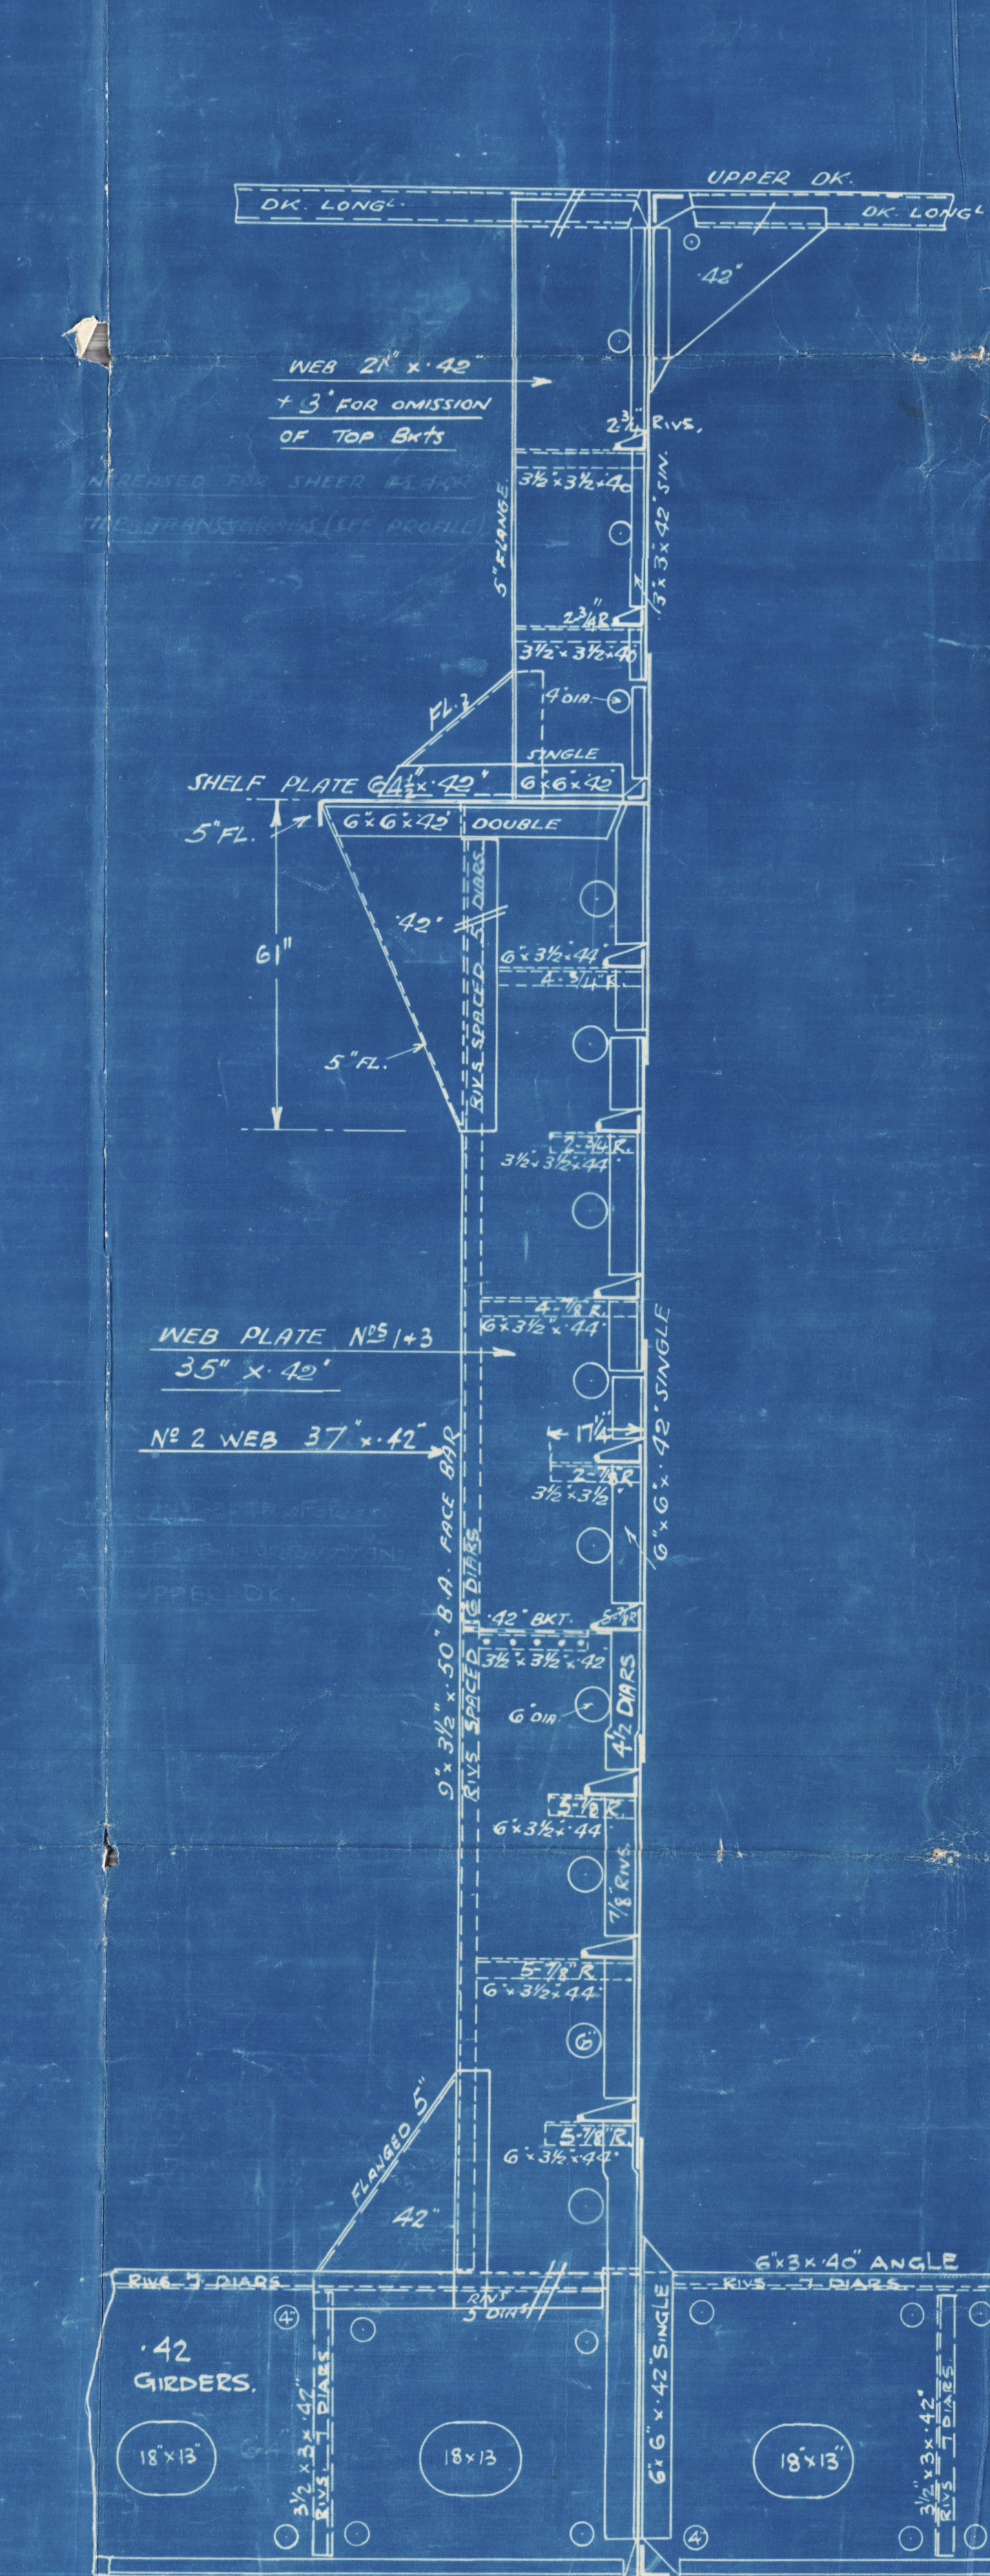

TRANS. BULKHEAD WEBS

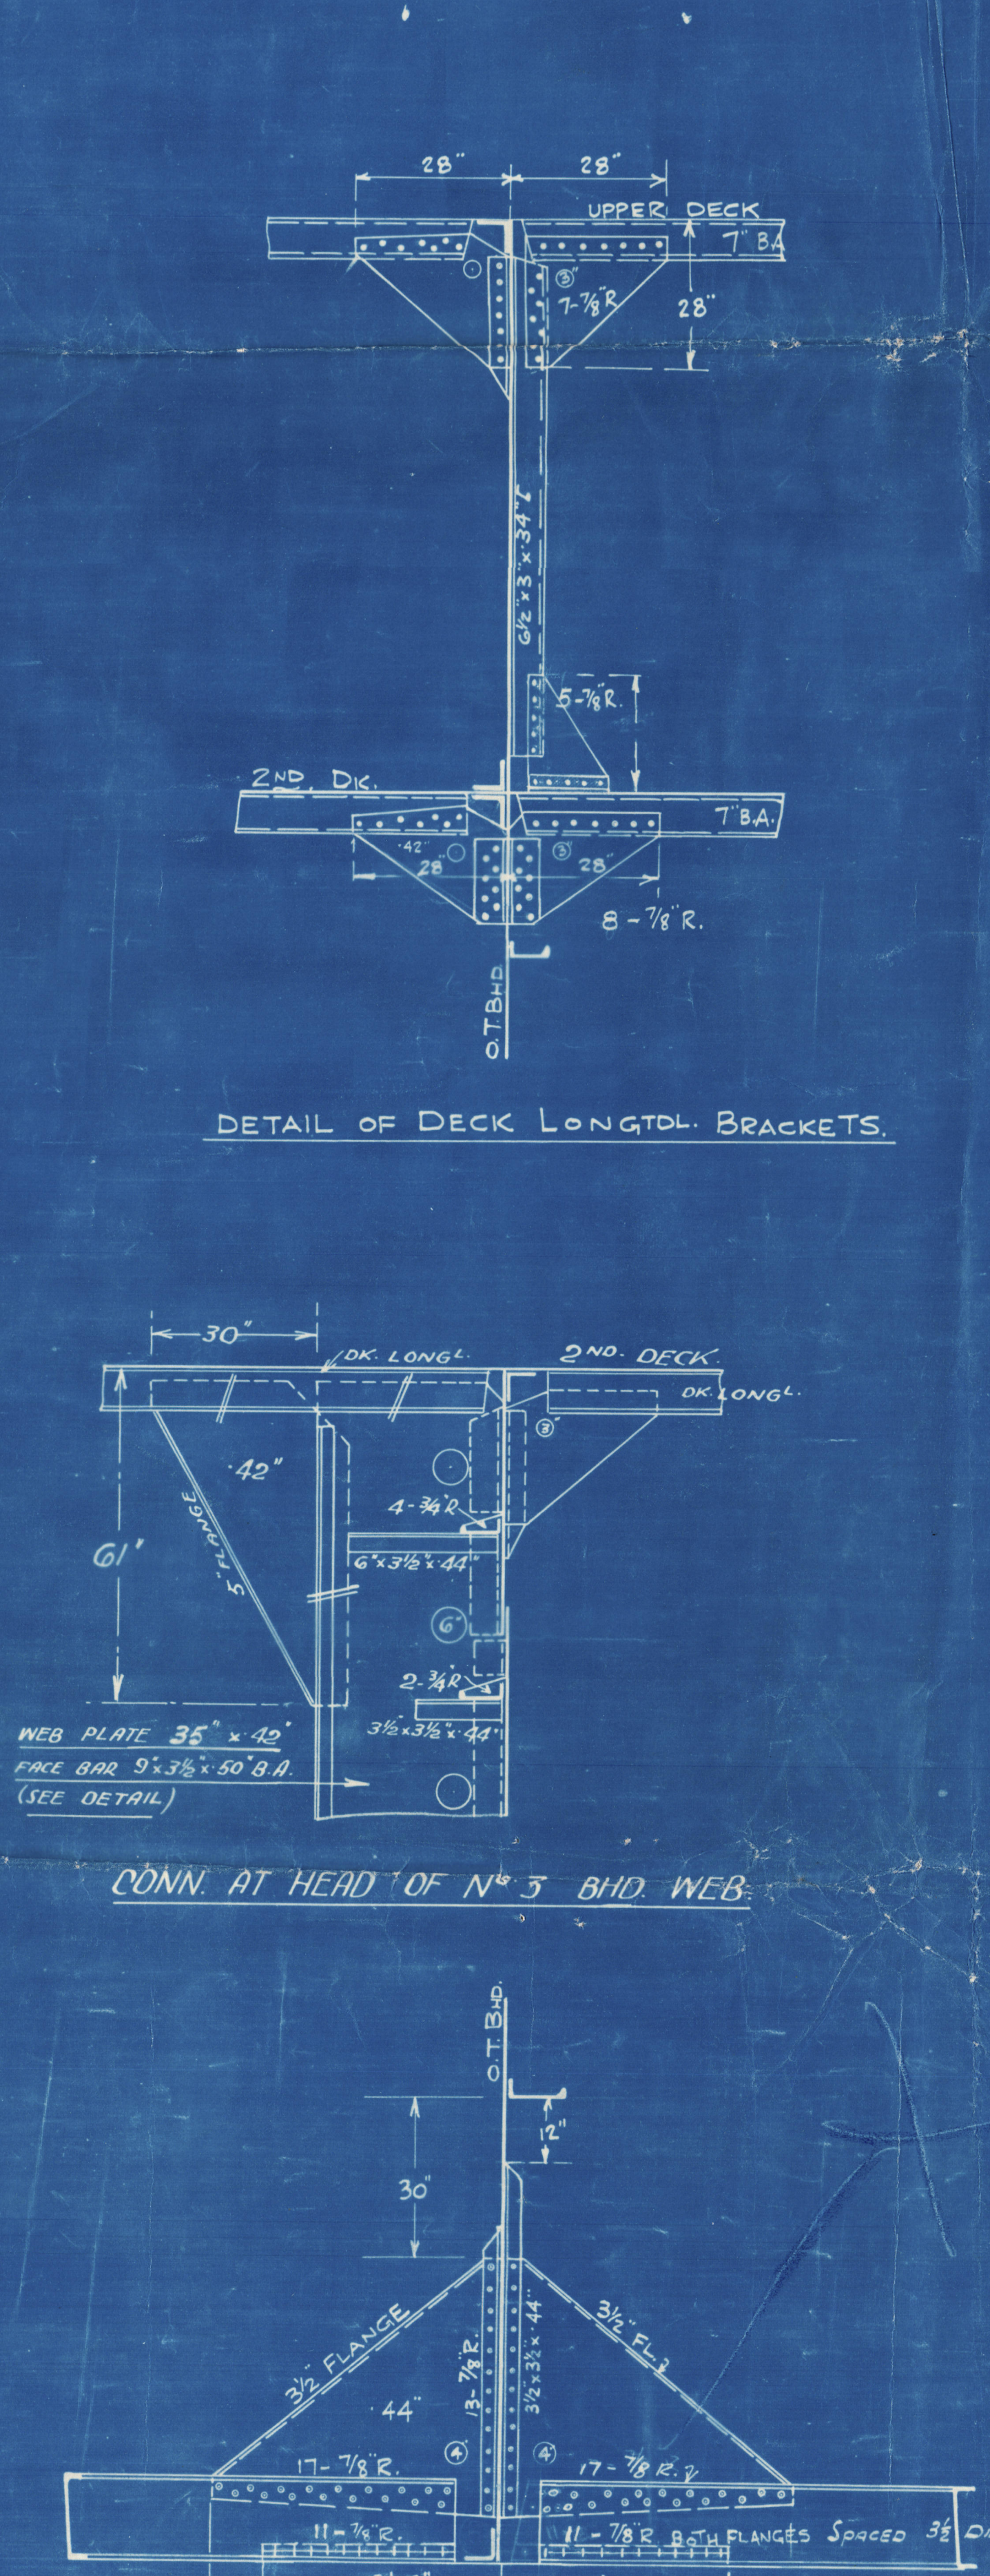

BOTTOM LONGTL. BRACKETS



W<sup>m</sup>. HAMILTON & Co.,

N<sup>o</sup> 406.

MIDSHIP SECTION (AS BUILT).

M/s. "Athelduchess" ————— Mano

Greenock First Entry Report N<sup>o</sup> 19017. DS 606



© 2021

Lloyd's Register  
Foundation

010229-010235-0090