


SCALES —: $1'' \text{ \& } 3'' = 1 \text{ FOOT}$

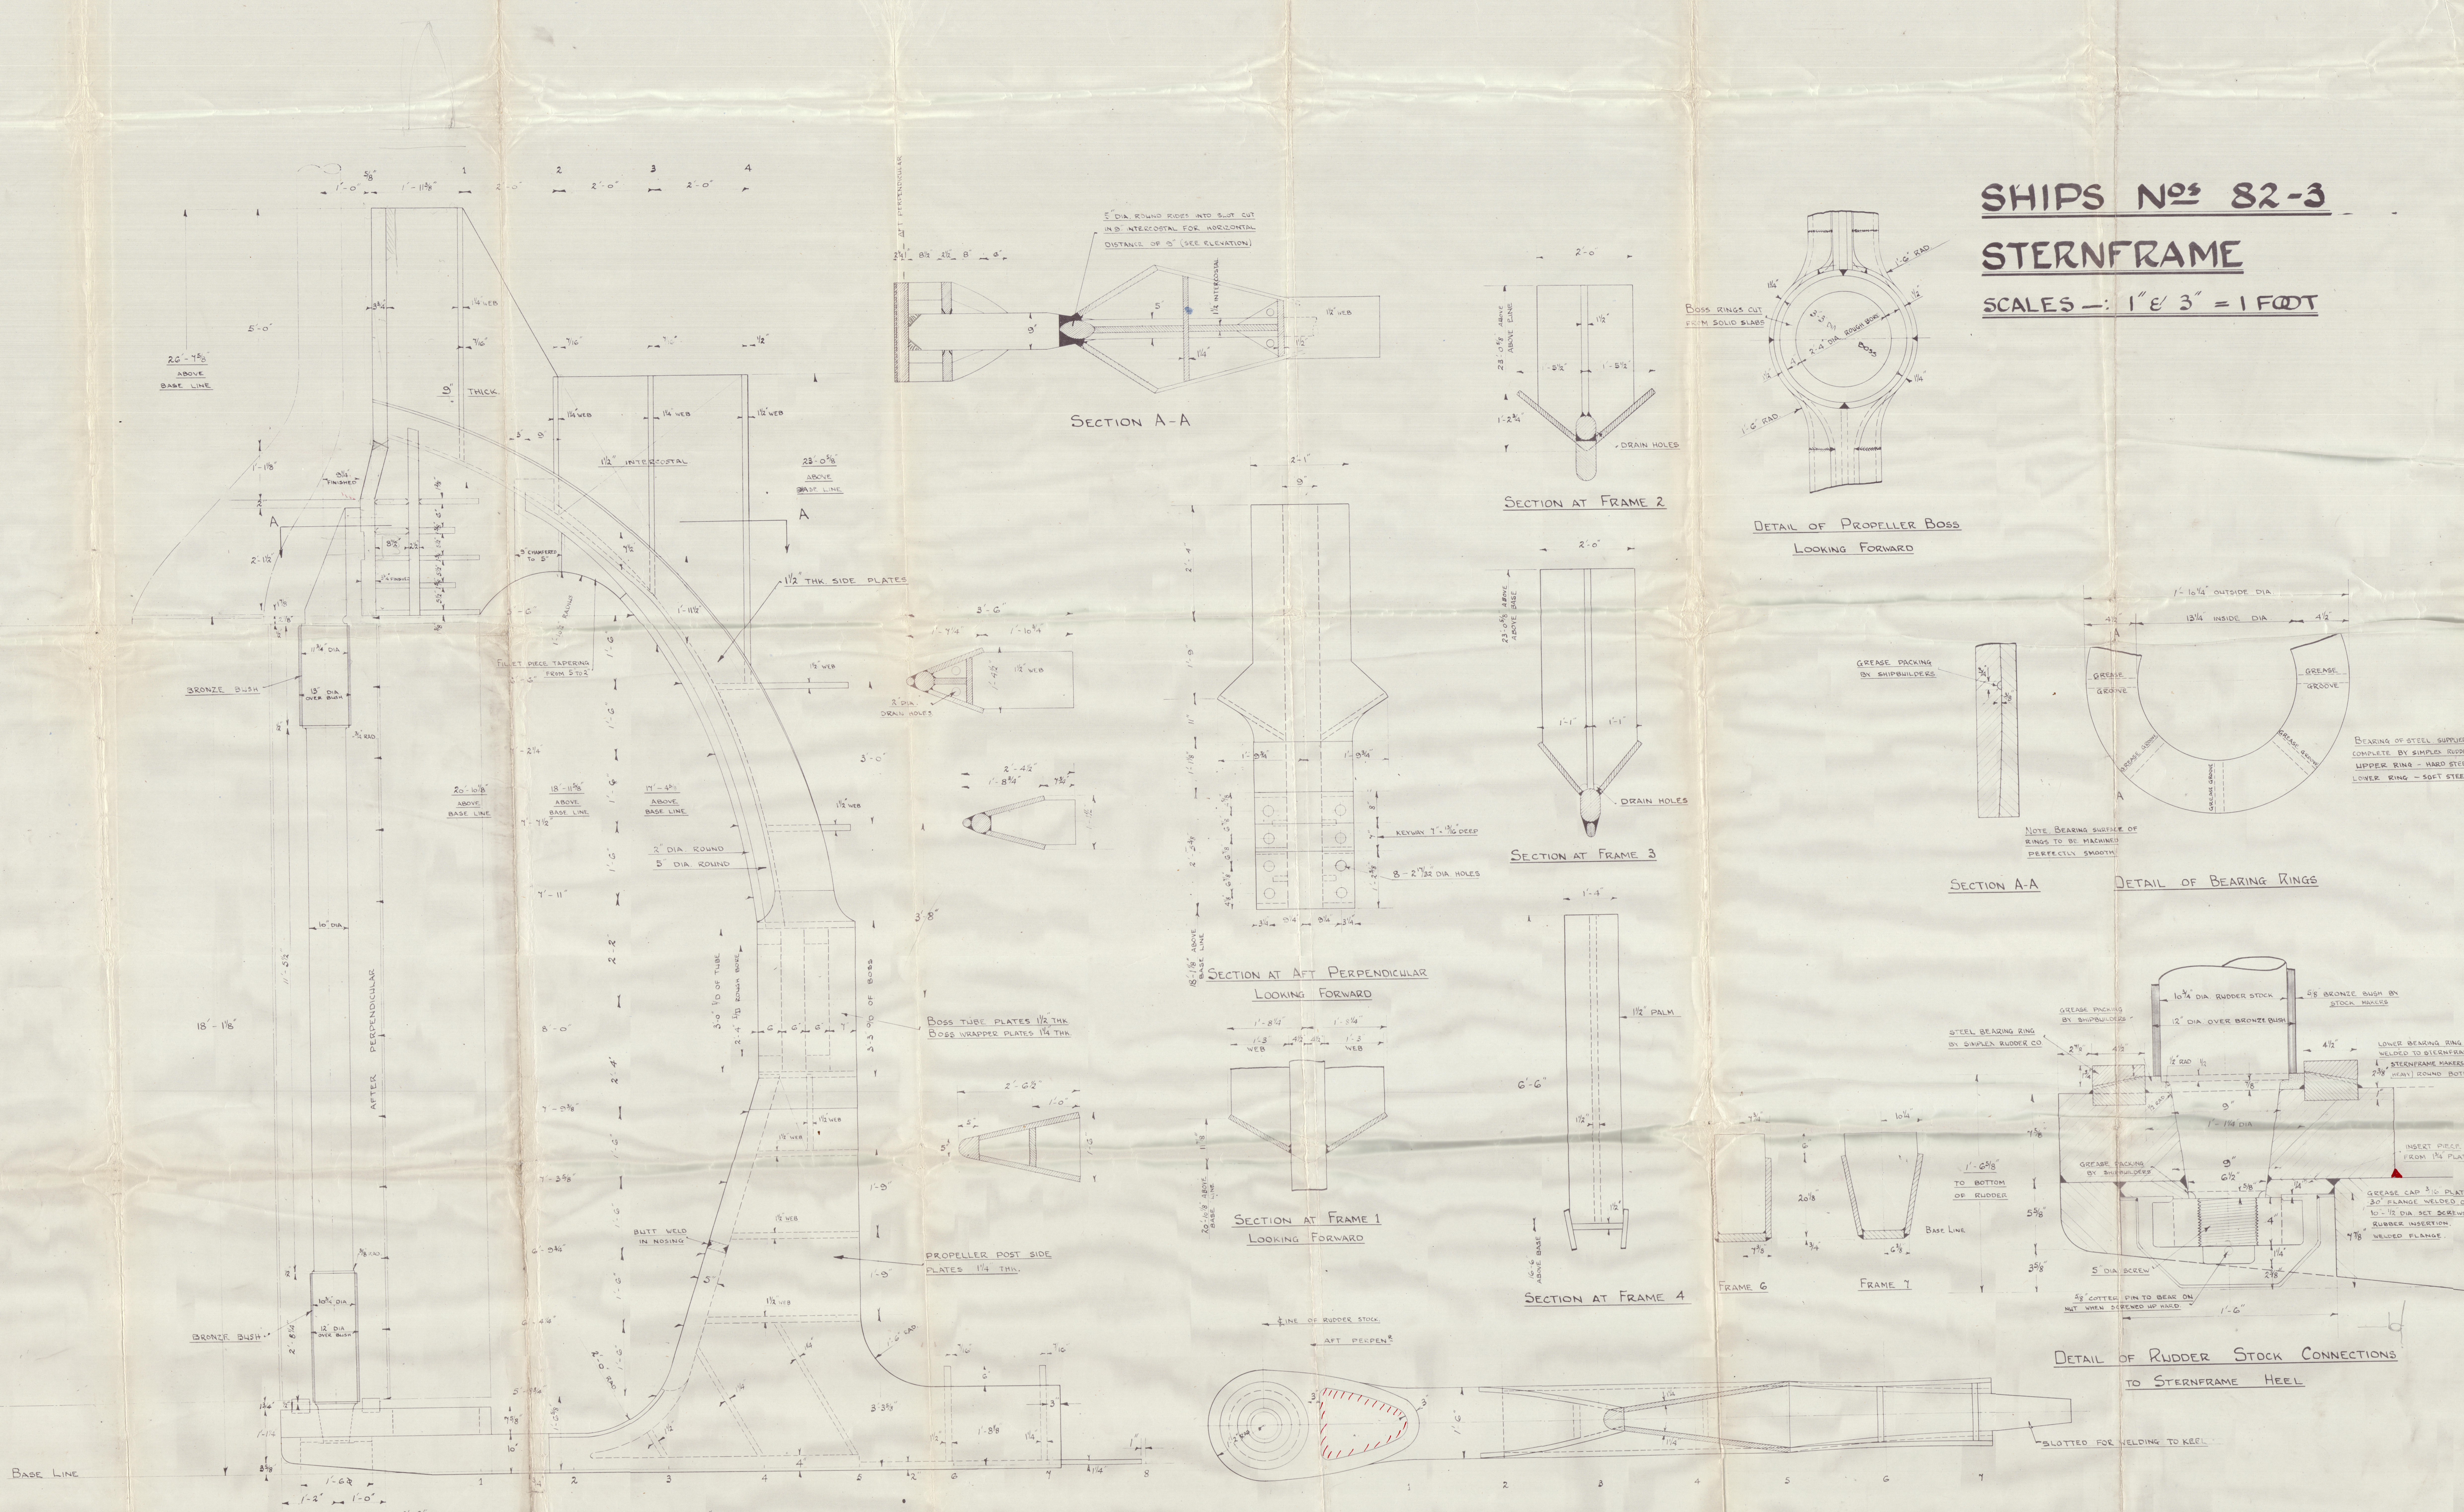

APPROVED
LLOYD'S REGISTER OF SHIPPING
James H. Clark
DATE *19/2/45*
LLOYDS

20/7/45

M/s "NEOTHAUMA" *

32.

M/s "NERITOPSIS".

BLYTHSWOOD S. B. CO LTD

N^{os} 82 + 83

STERN FRAME

82 GLASGOW REPORT No.

70841


GLASGOW REPORT No.

83

71171



010229-010235-0234 © 2021

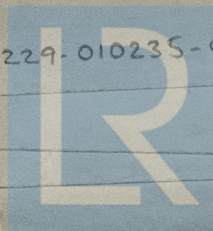

Lloyd's Register
Foundation