


[illegible]

MASTE WINDLASS WINCHES STEERING GEAR & DECKHOUSE  
SUPPORTED TO SURVEYOR'S SATISFACTION  
ALL BULB ANGLE & CHANNEL SECTIONS ARE NBS

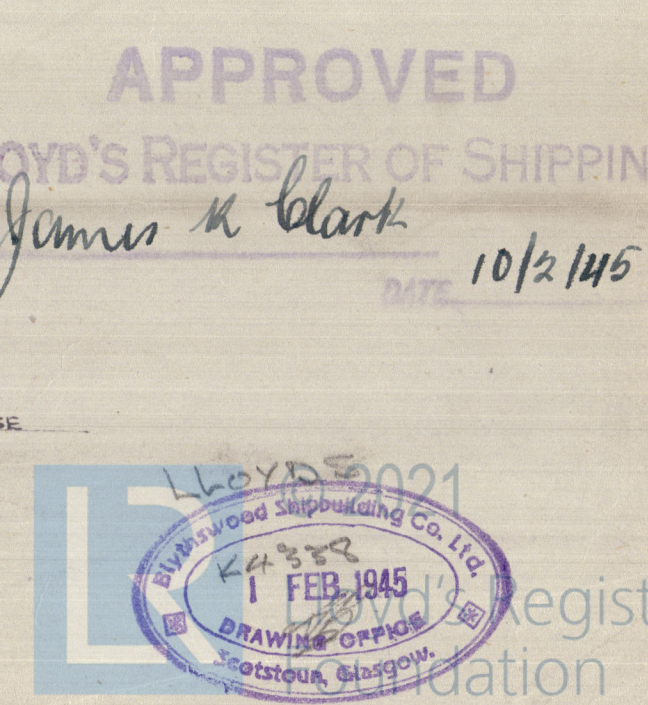



2./

M/s "NEOTHAUMA" \*

M/s "NERITOPSIS"

BLYTHSWOOD S. B. CO LTD

Nos 82 + 83

PROFILE AND DECK PLANS,

82 "Neothauma" GLASGOW REPORT No. 70515

83 "Neritopsis" GLASGOW REPORT No. 70516

KE 82 GLASGOW REPORT No. 70841

82 GLASGOW REPORT No. 71171

83 71171

3



© 2021

Lloyd's Register  
Foundation