


7.3.07.


S. S. N° 404.  
PROFILE AND DECK PLAN.

DIMENSIONS; LEN. 135' 0" B.P. x 22' 6" EX. x 12' 4" DEPTH OF HOLD.


SCALE 1/4" = ONE FOOT.

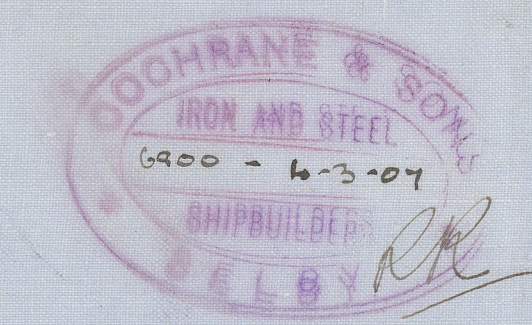

*Pleas to satisfaction  
of surveyors throughout*

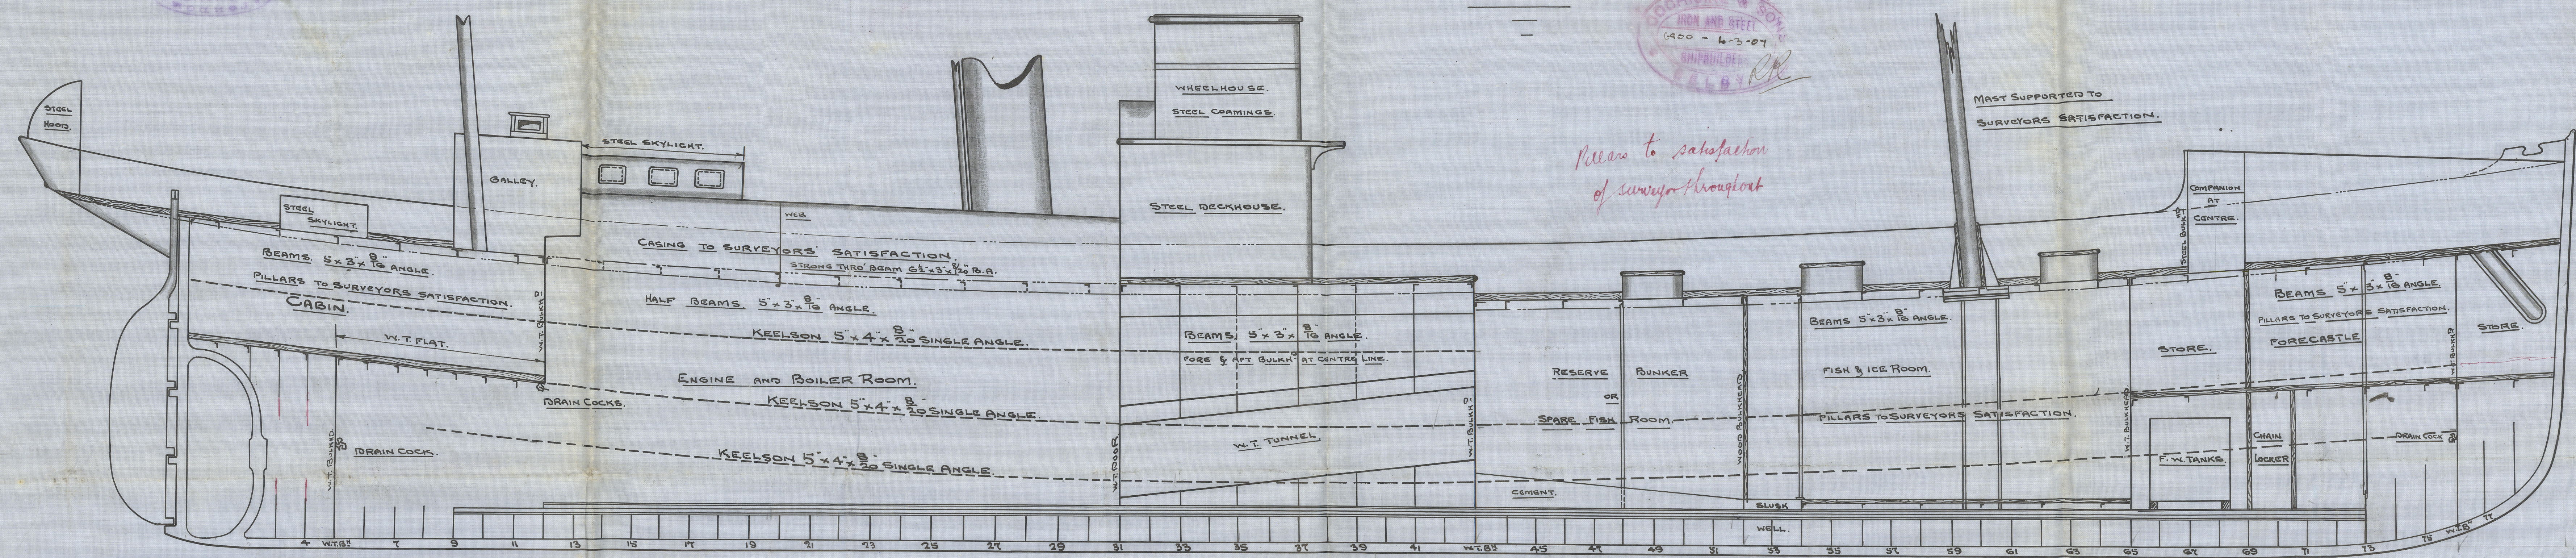

— DECK PLAN. —

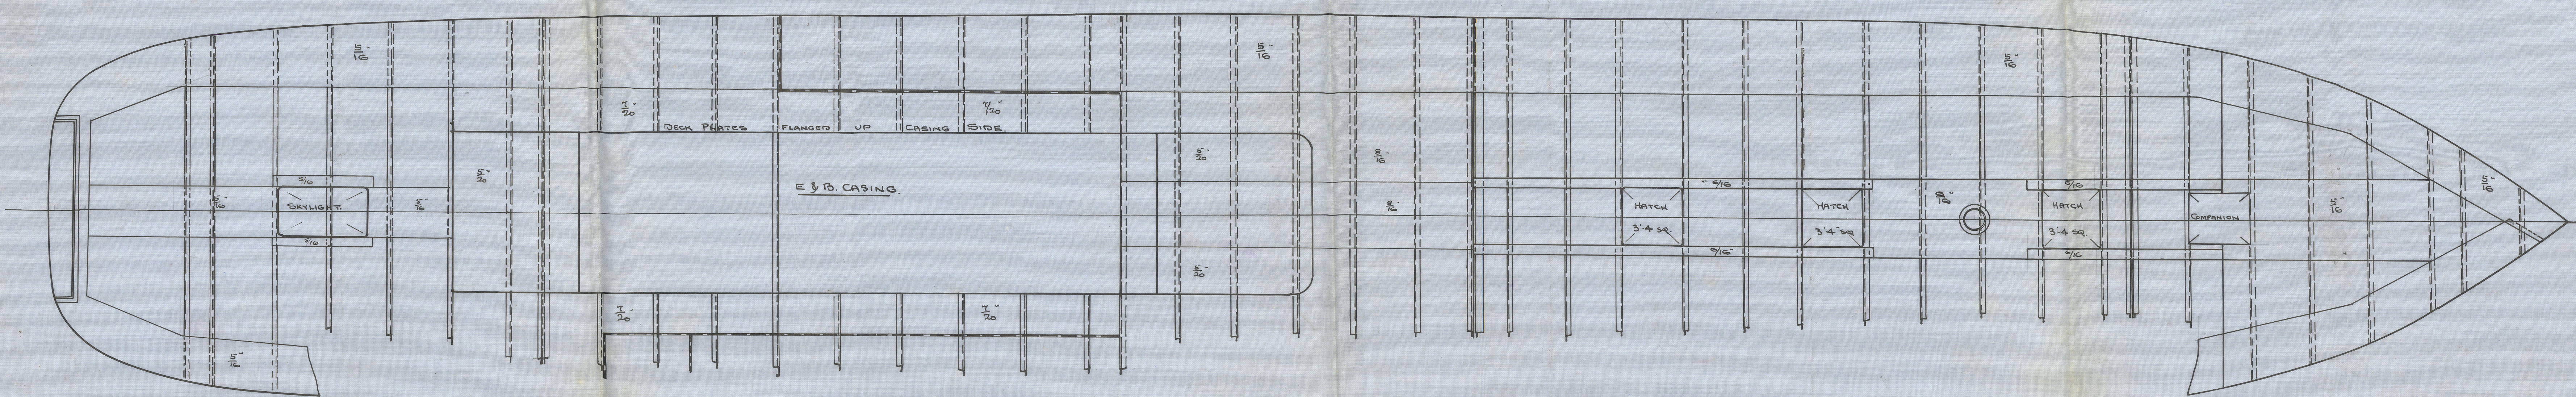

LLOYD'S REGISTER  
OF SHIPPING  
6 MAR 1907  
\* HULL \*




Profile & Deck Plan  
Lochrane & Sons

— s/s No. 404 —

s/s Indian Empire  
Hull R/L No. 19463



10.3.07

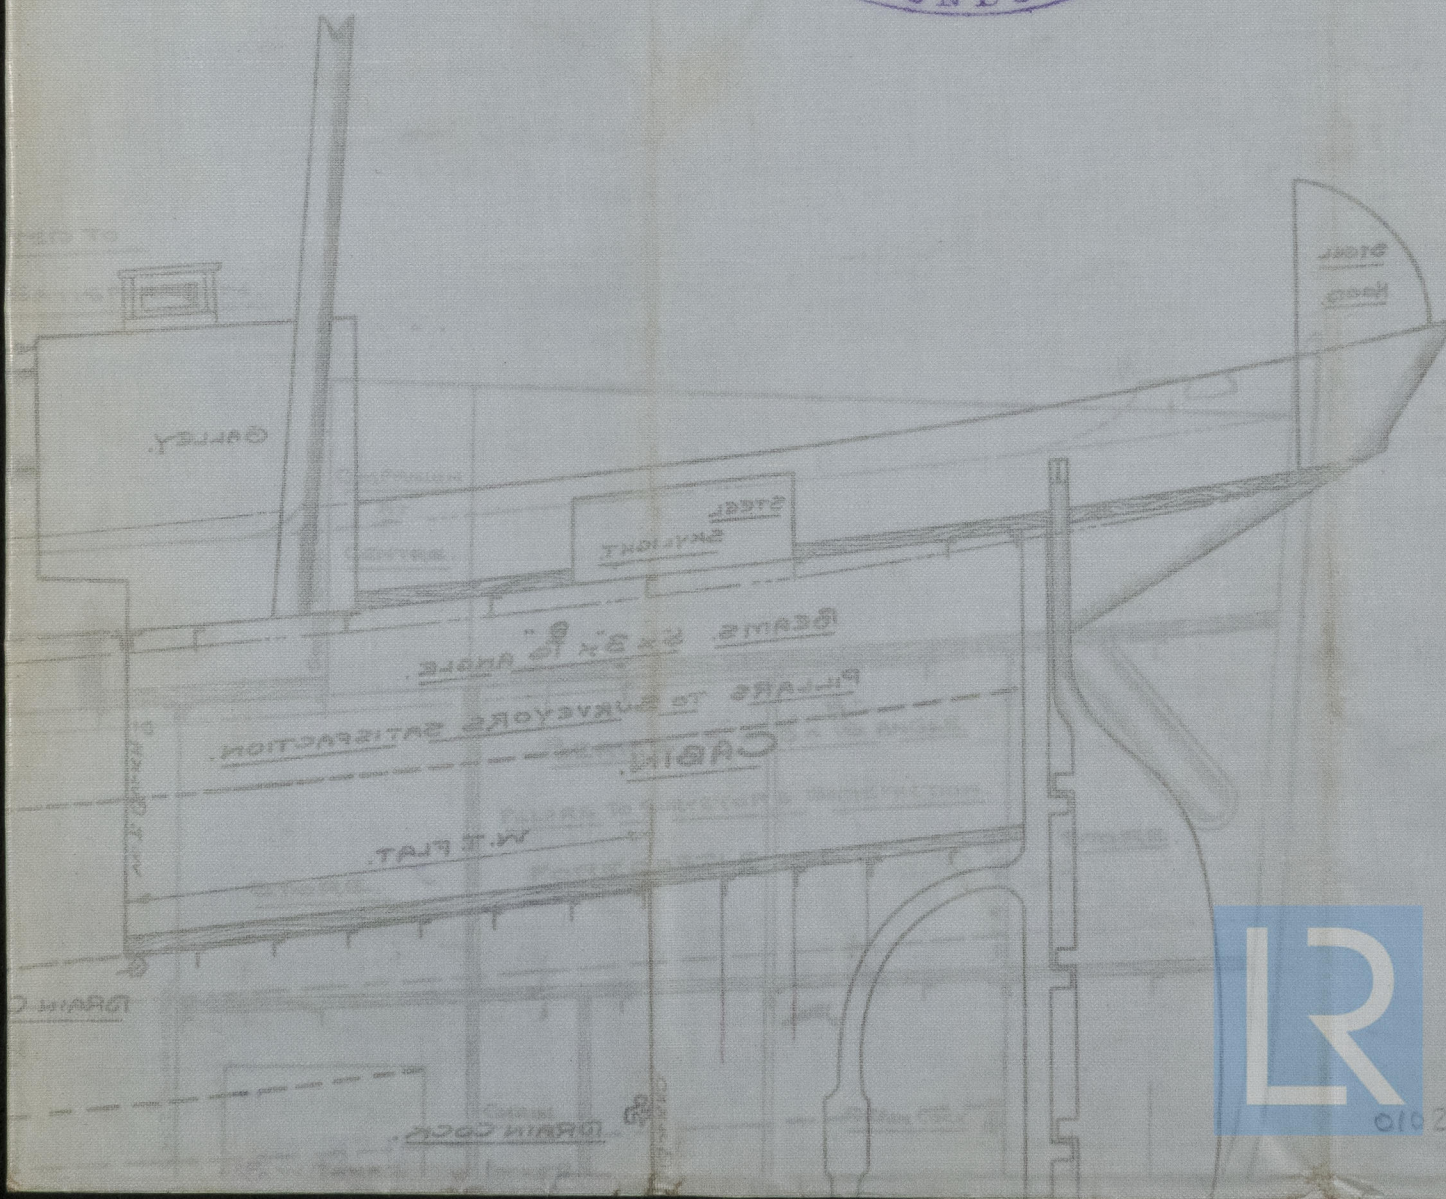

© 2021

Lloyd's Register  
Foundation