
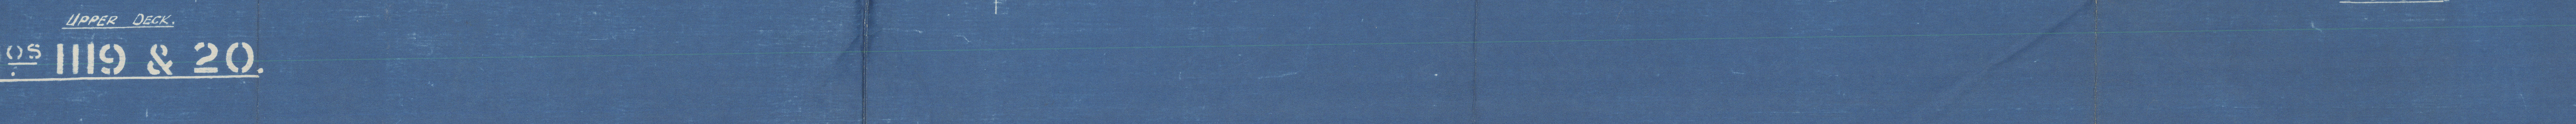
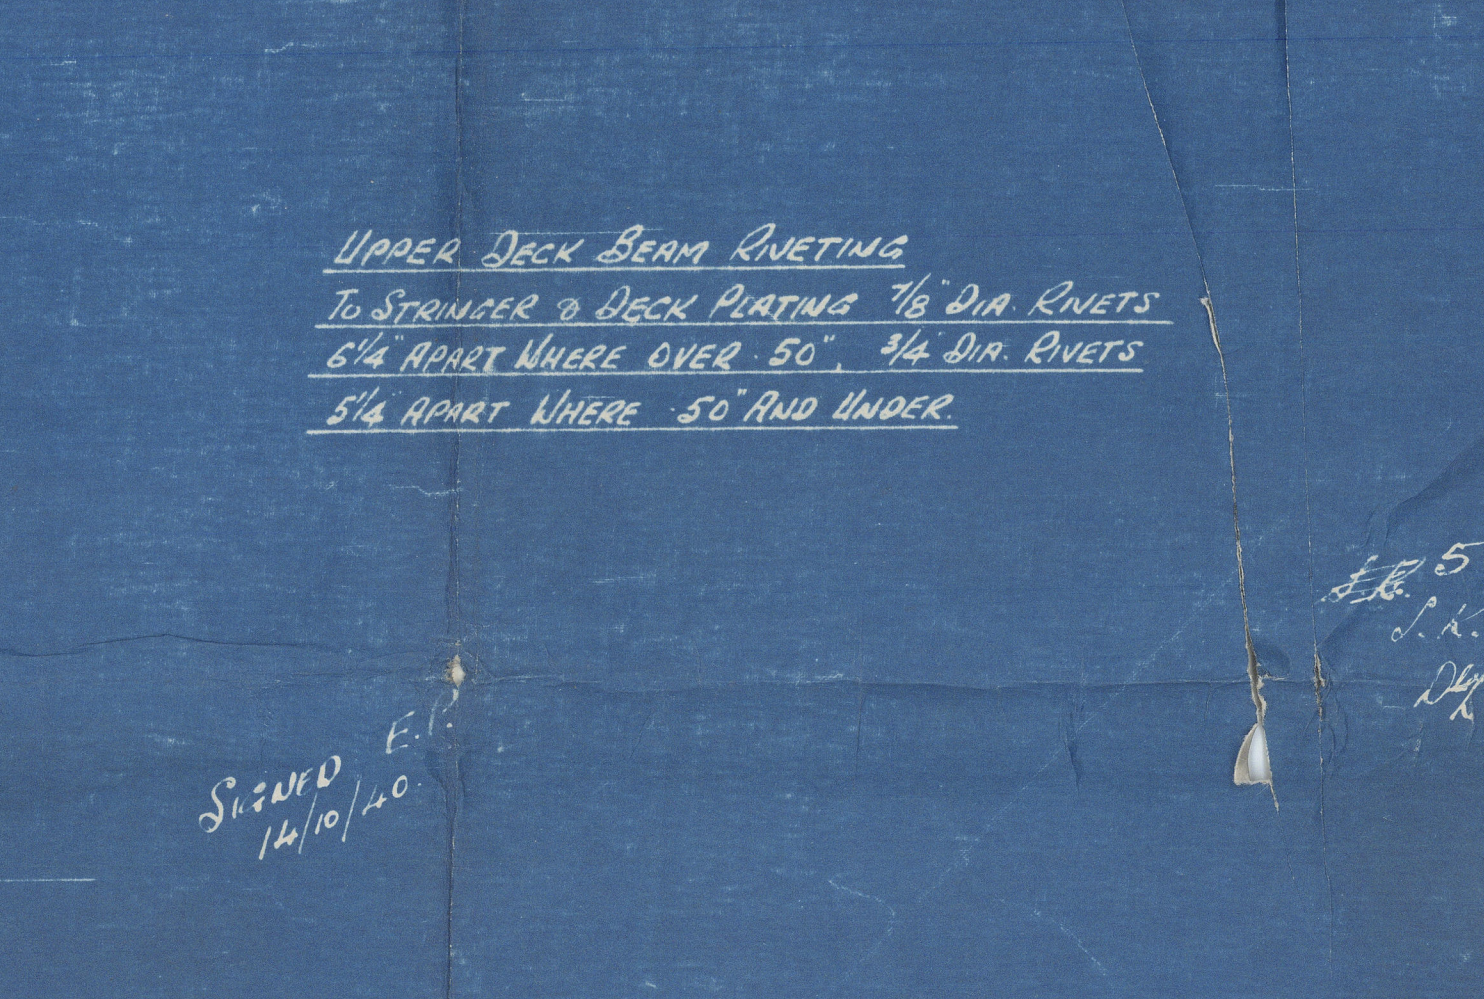
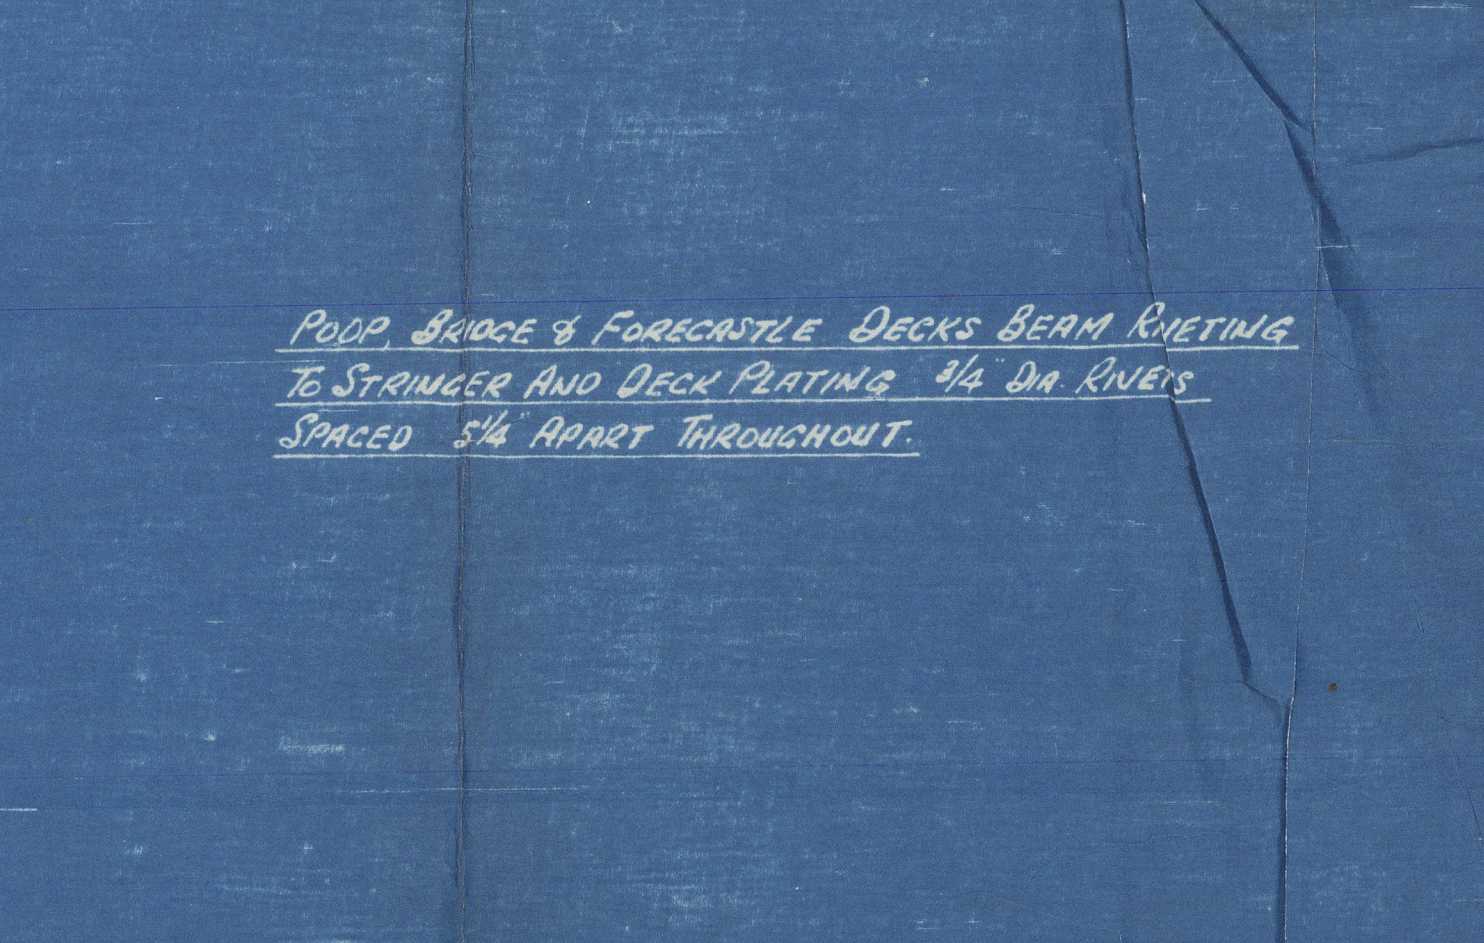
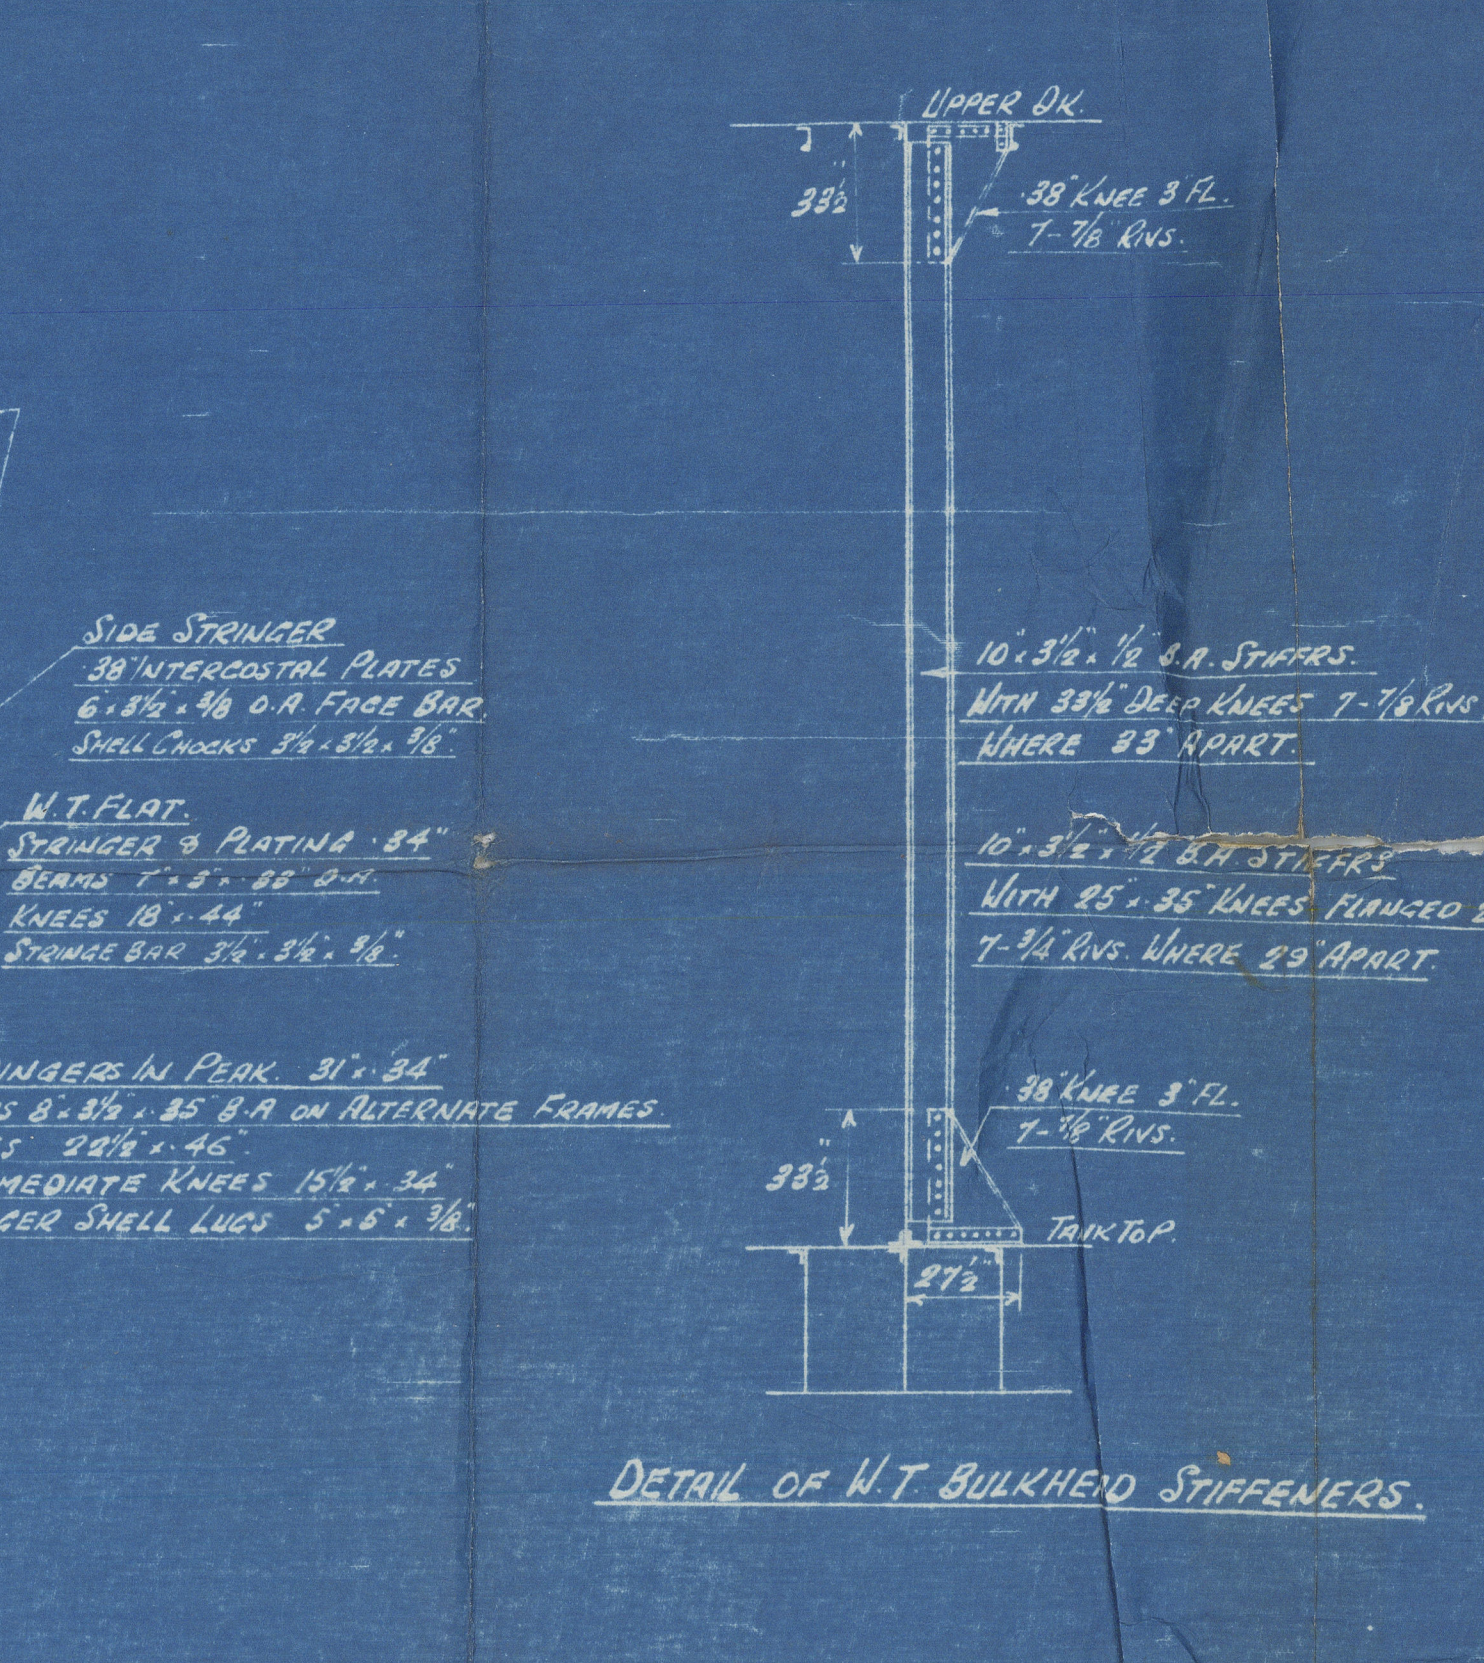
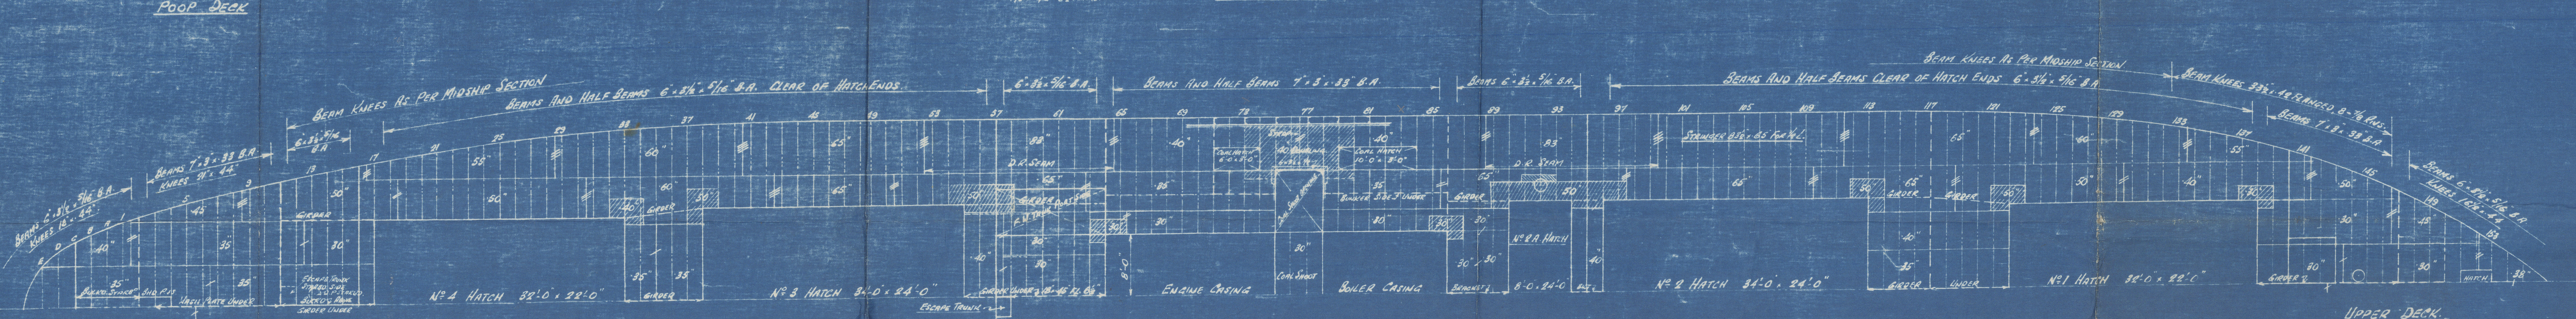
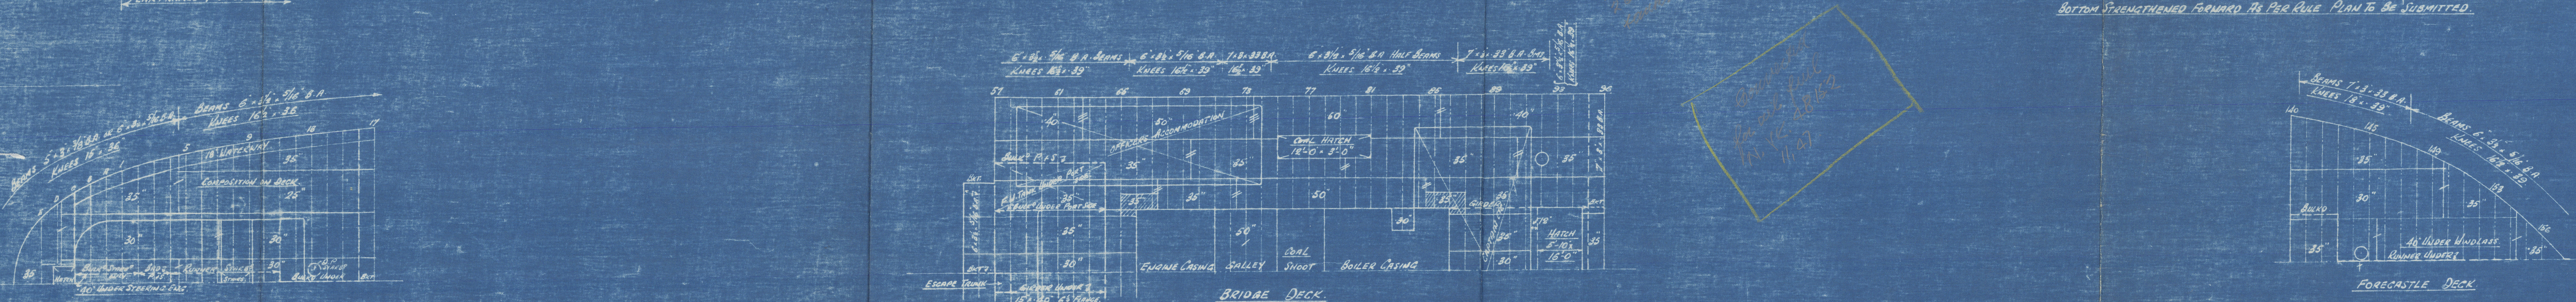
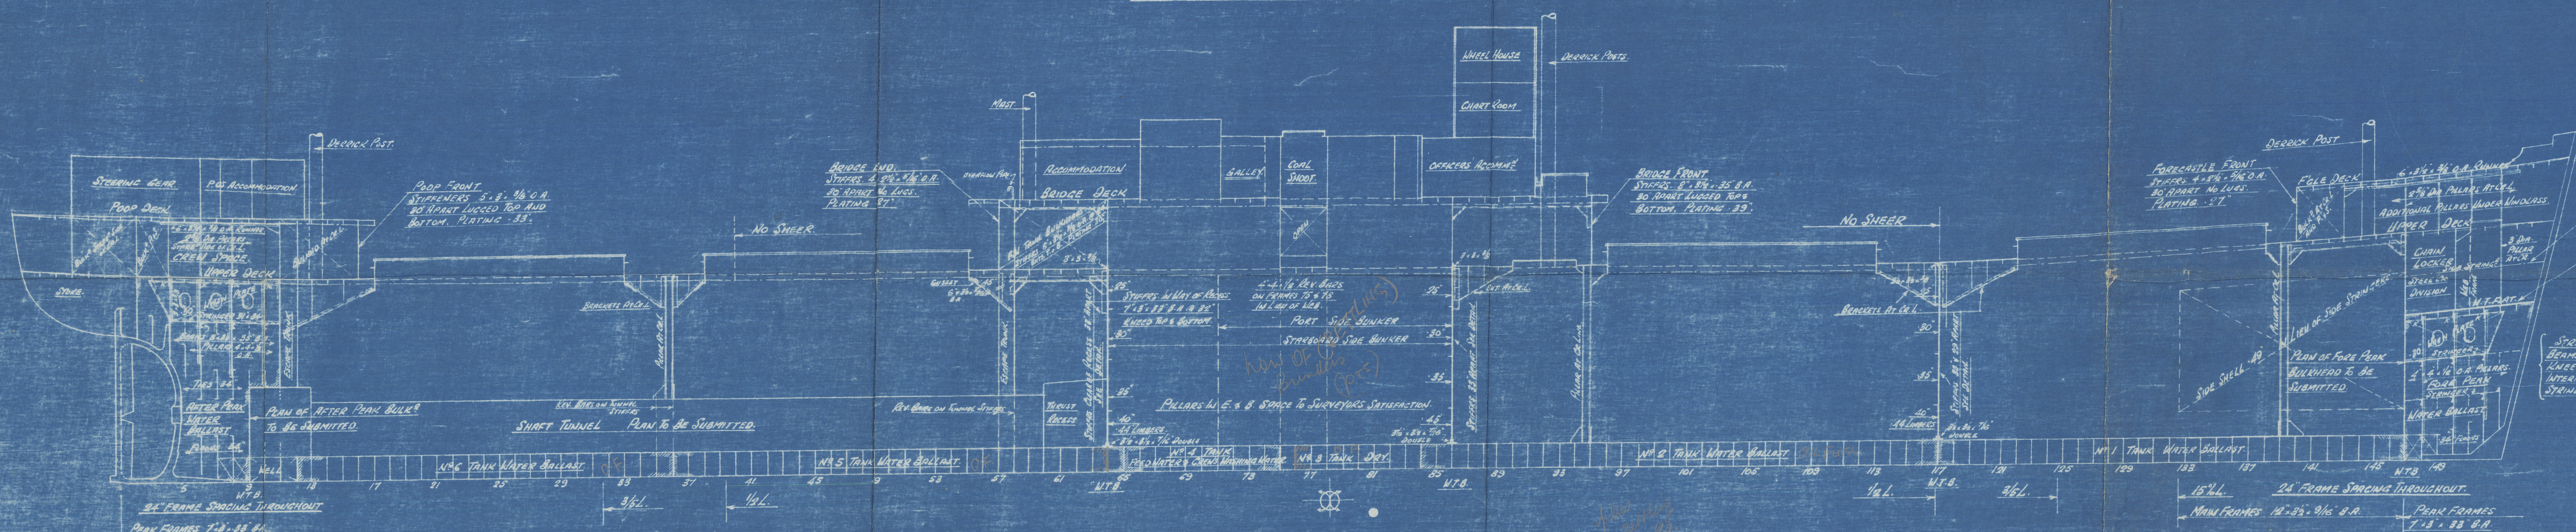


PROFILE & DECK PLANS

SCALE $\frac{1}{8}'' = 1 \text{ FOOT}$

DIMENSIONS: - LENGTH 8 P 810'-0" 46'-4" BREADTH MLD \times 25'-2" FLAT SHEER TO UPPER DECK, 34'-2" FLAT SHEER TO BRIDGE DECK.
24'-6" NORMAL SHEER TO UPPER DECK, 33'-6" NORMAL SHEER TO BRIDGE DECK.

APPROVED BY LLOYDS. 14/10/40.

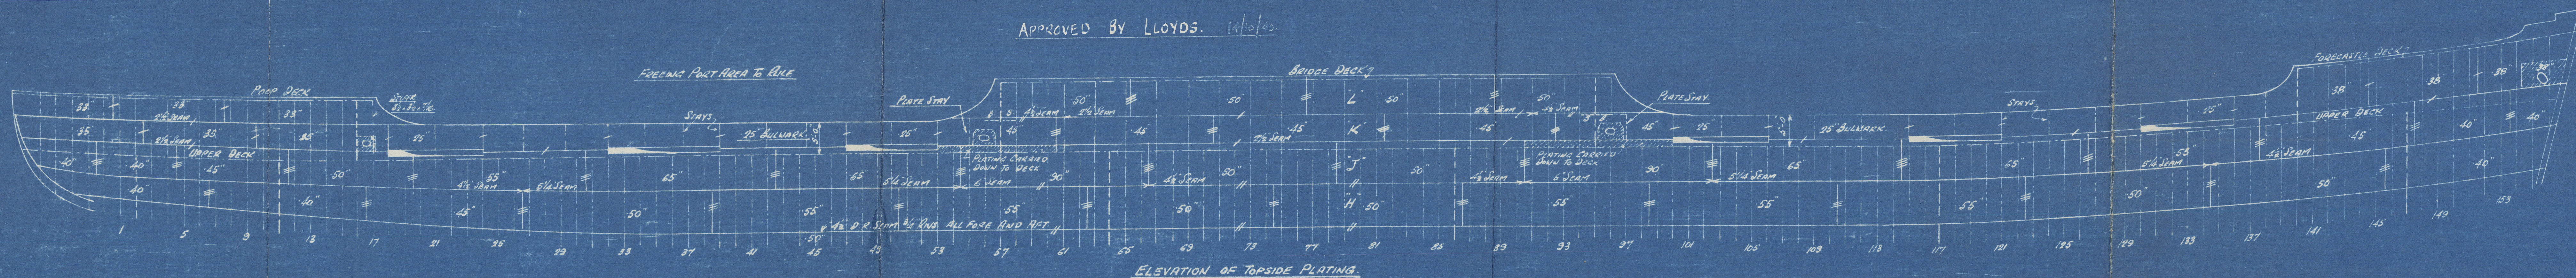

NOS 119 & 20.

NOS 119 & 20.

PROFILE AND DECK PLAN
DRG. NOS 119-20.

HULL NO 14
"LANSDOWNE PARK"
MONTREAL REPORT NO 5893

DS 658

ex Federal Trader

M.N.

"GARDNER BAY"

ex SUNDIAL

RECORDS DEPT.
LONDON.

"CARIBBEAN TRADER"

010236-010245-0187

