


SHIP No 138.


PROFILE & DECKS.

SCALE 1/8" = ONE FOOT.

BULKHEAD SCANTLINGS.									
B.H. NO.	COAMINGS	PLATE	STIFFS	SPAC.	BKTS	BEAM	FRAME	TANK TOP	RIVETS
5	36" x 36"	26" x 30"	1 1/2" x 36"	30"	1 1/2" x 40"	3 x 3 x 36"	3 x 3 x 40"	—	4" x 3/4"
25	42" x 44"	26" x 32"	1 1/2" x 36"	30"	2 1/2" x 36"	3 x 3 x 36"	3 x 3 x 40"	—	4" x 3/4"
55	36" x 36"	26" x 30"	1 1/2" x 36"	30"	1 1/2" x 40"	3 x 3 x 36"	3 x 3 x 40"	—	4" x 3/4"
83	36" x 36"	26" x 30"	1 1/2" x 36"	30"	1 1/2" x 40"	3 x 3 x 36"	3 x 3 x 40"	—	4" x 3/4"

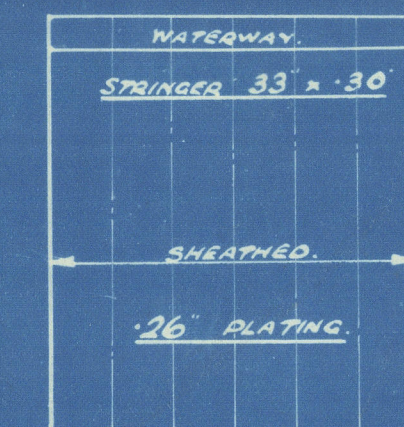


BEAMS 5" x 3" x 25 B.A.
EVERY FRAME. KNEES 15" x 32".
BRIDGE DECK.

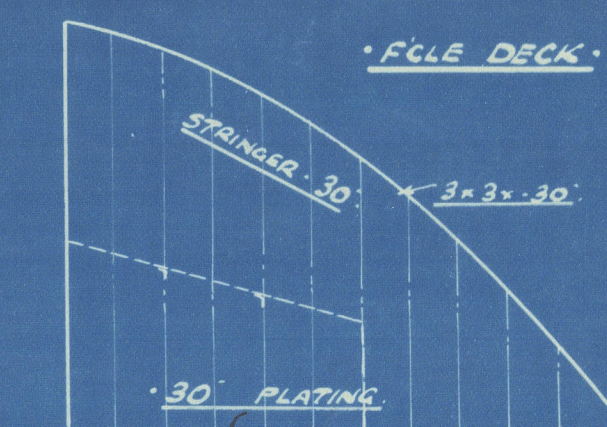

KNEES 12" x 34".

FILE FRAMES 6" x 3" x 34 B.A. ADAPTED.
INTERMEDIATE FRAMES 3" x 3" x 34 O.A.

Supports under windlass winches
during gear to surveyor's direction

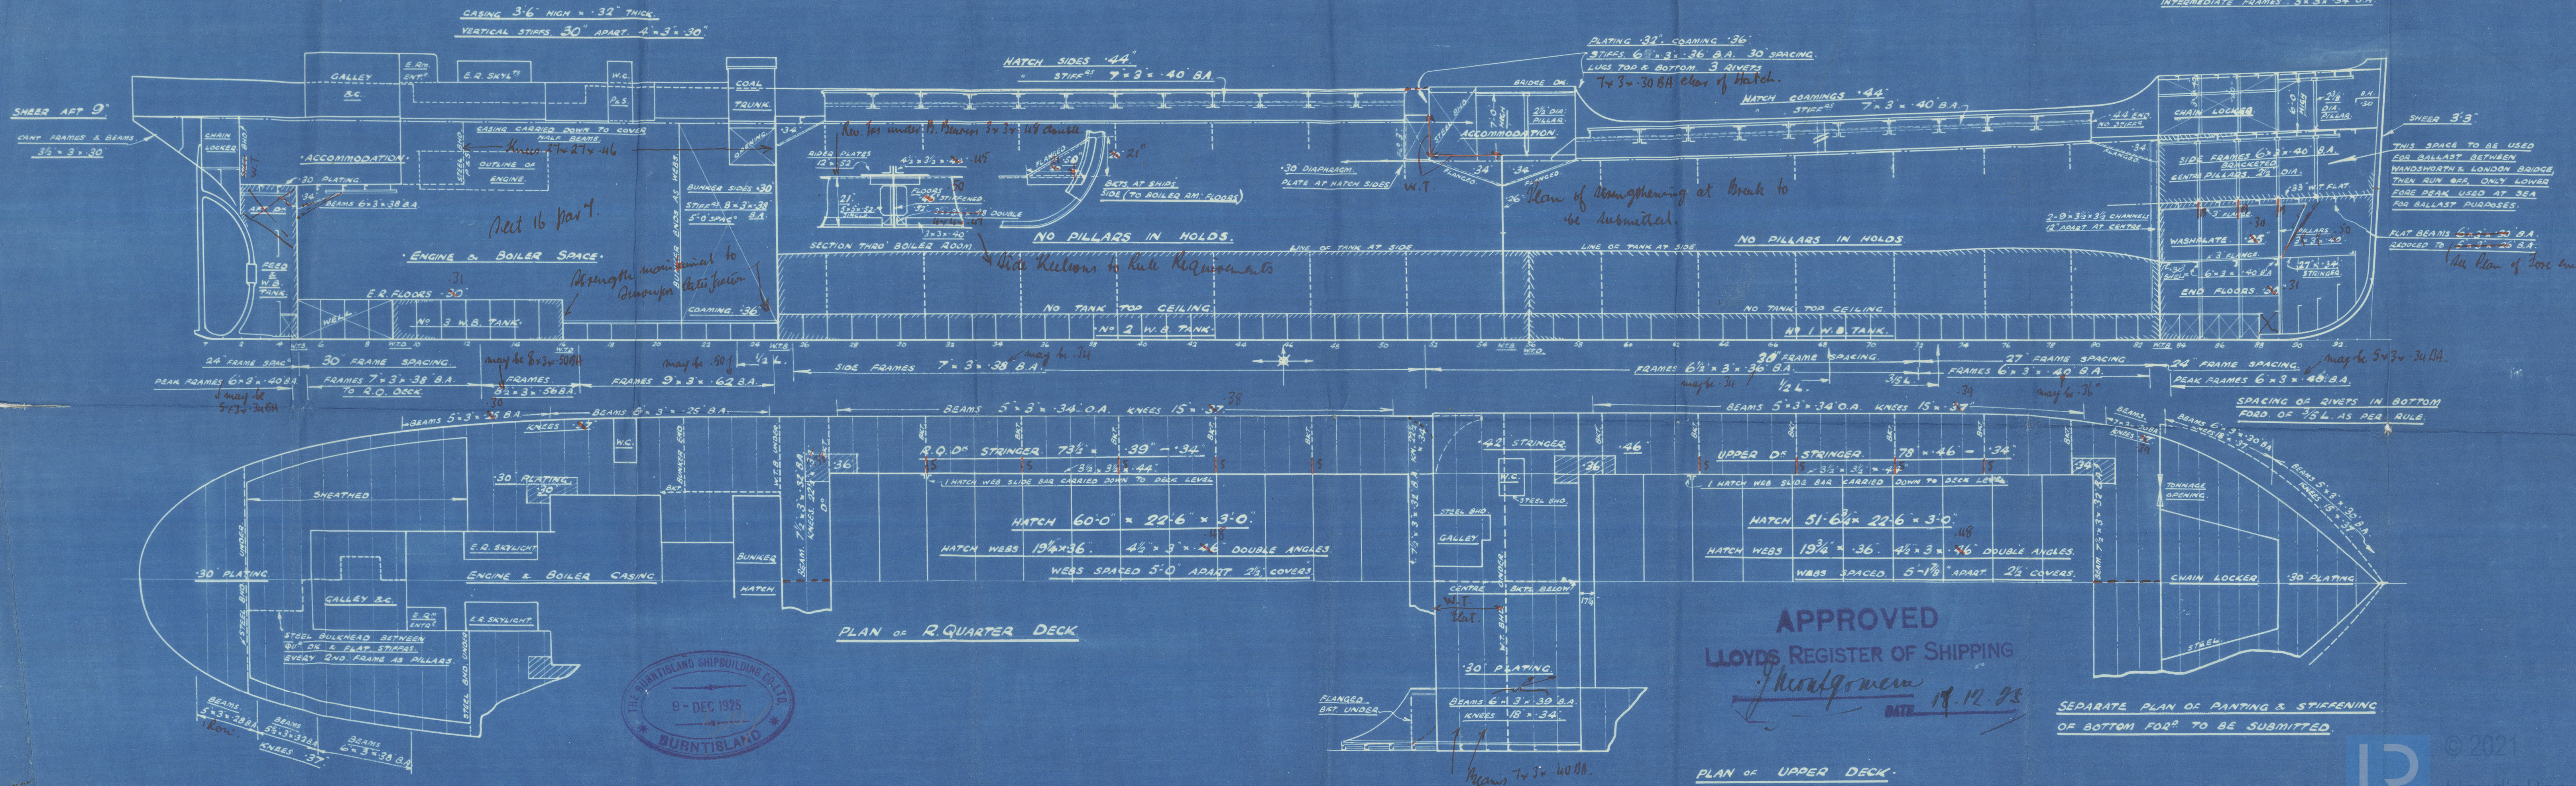

APPROVED
LLOYD'S REGISTER OF SHIPPING

Montgomery
DATE 18.12.25

SEPARATE PLAN OF PAINTING & STIFFENING
OF BOTTOM FOR TO BE SUBMITTED.

PLAN OF UPPER DECK.



Buentsland SFBQ.

No. 138.

Profile & Decks.

^a
8/5 ⁴Ewell



© 2021

Lloyd's Register

010246-010253-0171
Foundation