


SHIP No 853 (AS FITTED)

PROFILE & DECK, HOUSE & W. T. BHDS.


DIMENSIONS :- 85'-0" O.A. x 22'-0" B.M. x 6'-6" D.M.

SCALE 1/4" = 1 FT.

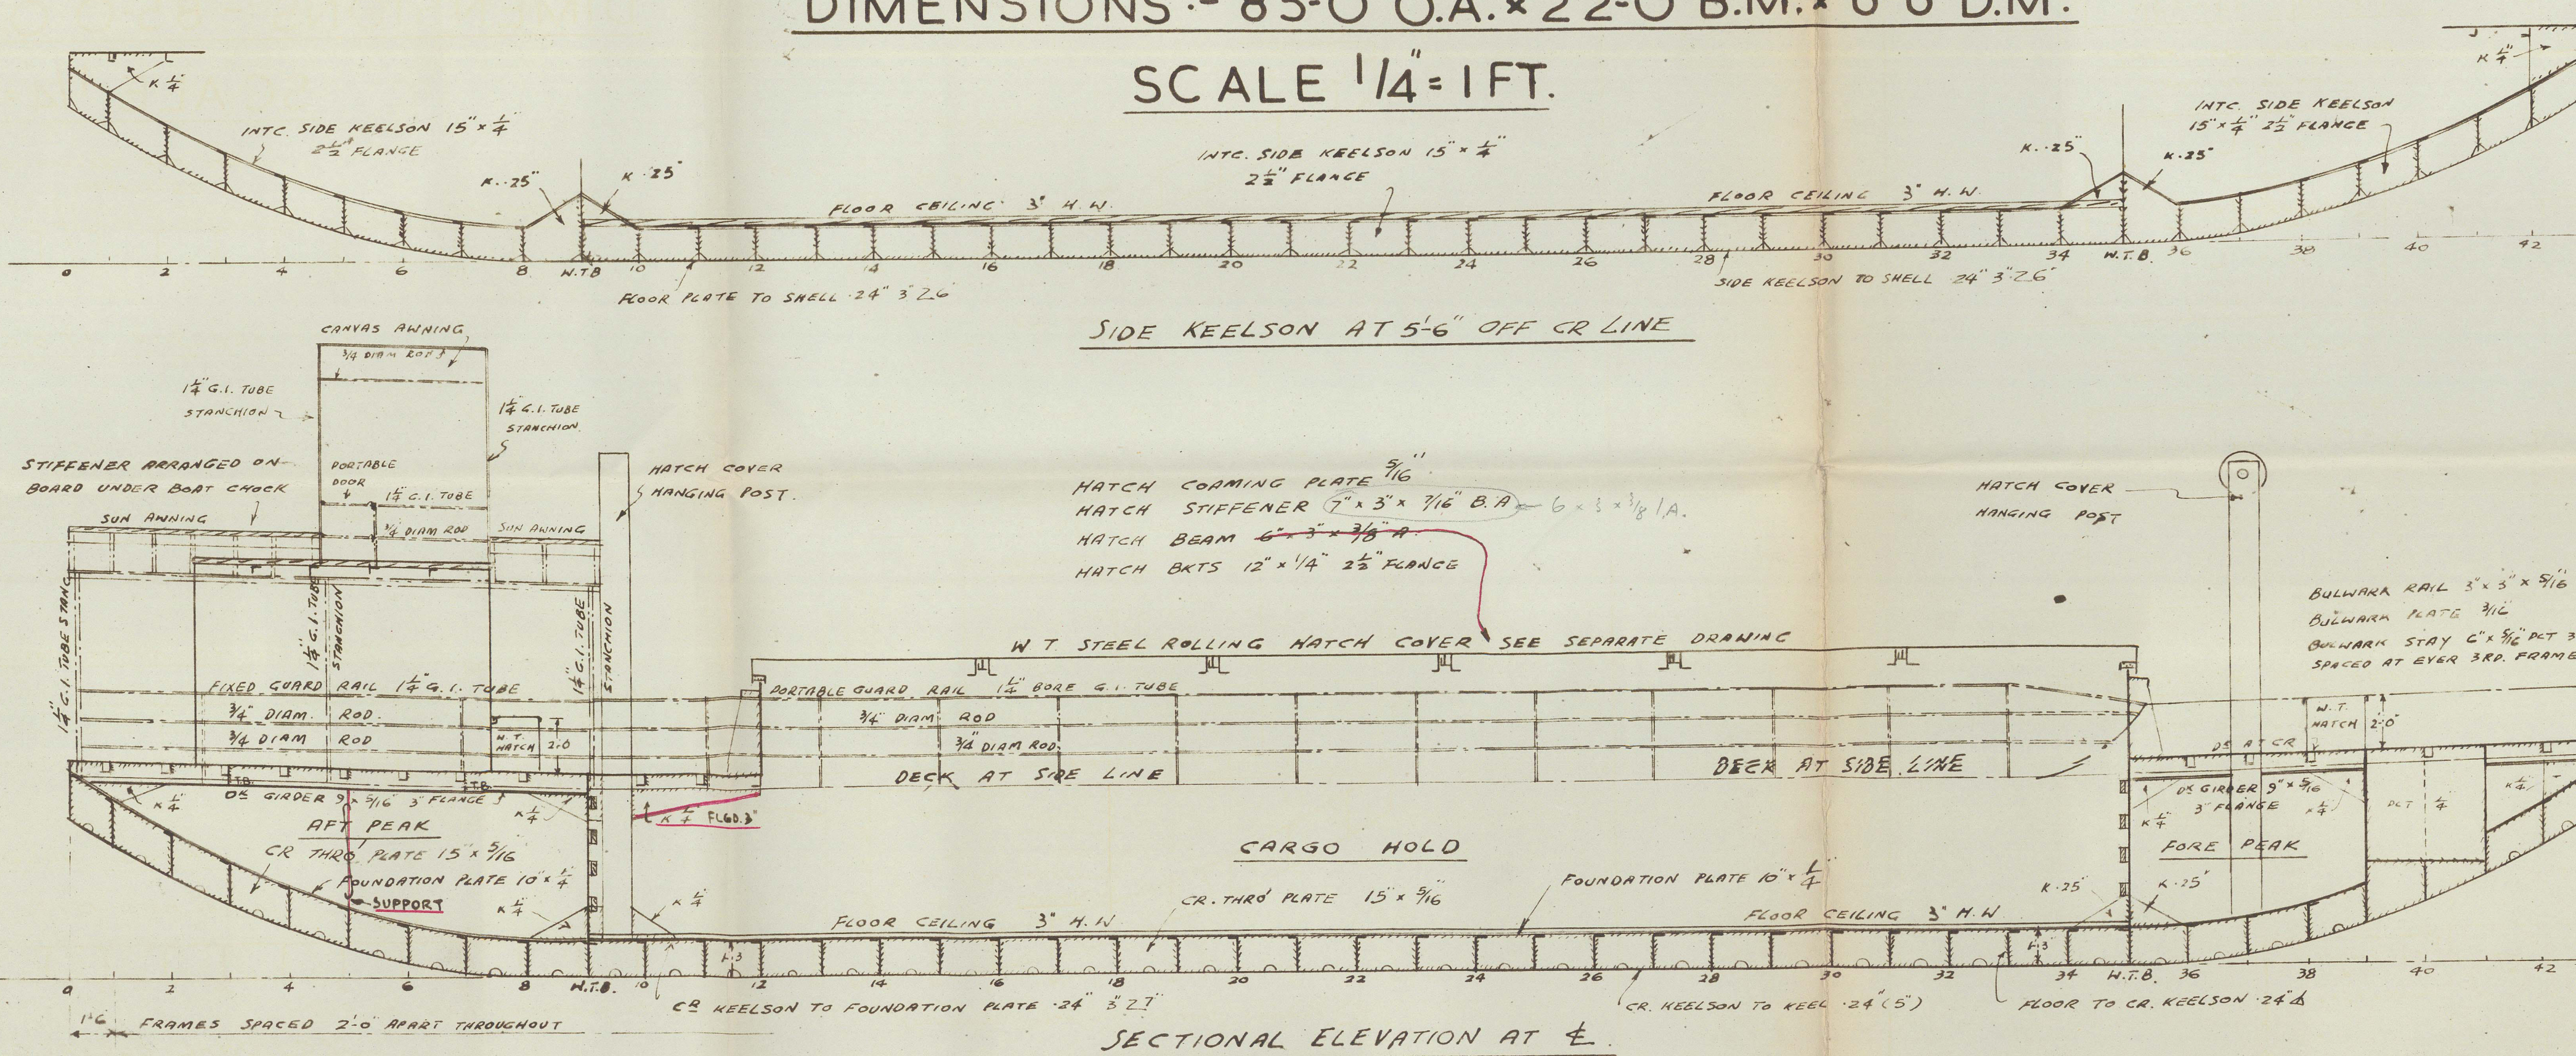


SIDE KEELSON AT 5'-6" OFF CR LINE


SECTIONAL ELEVATION AT 1/4"

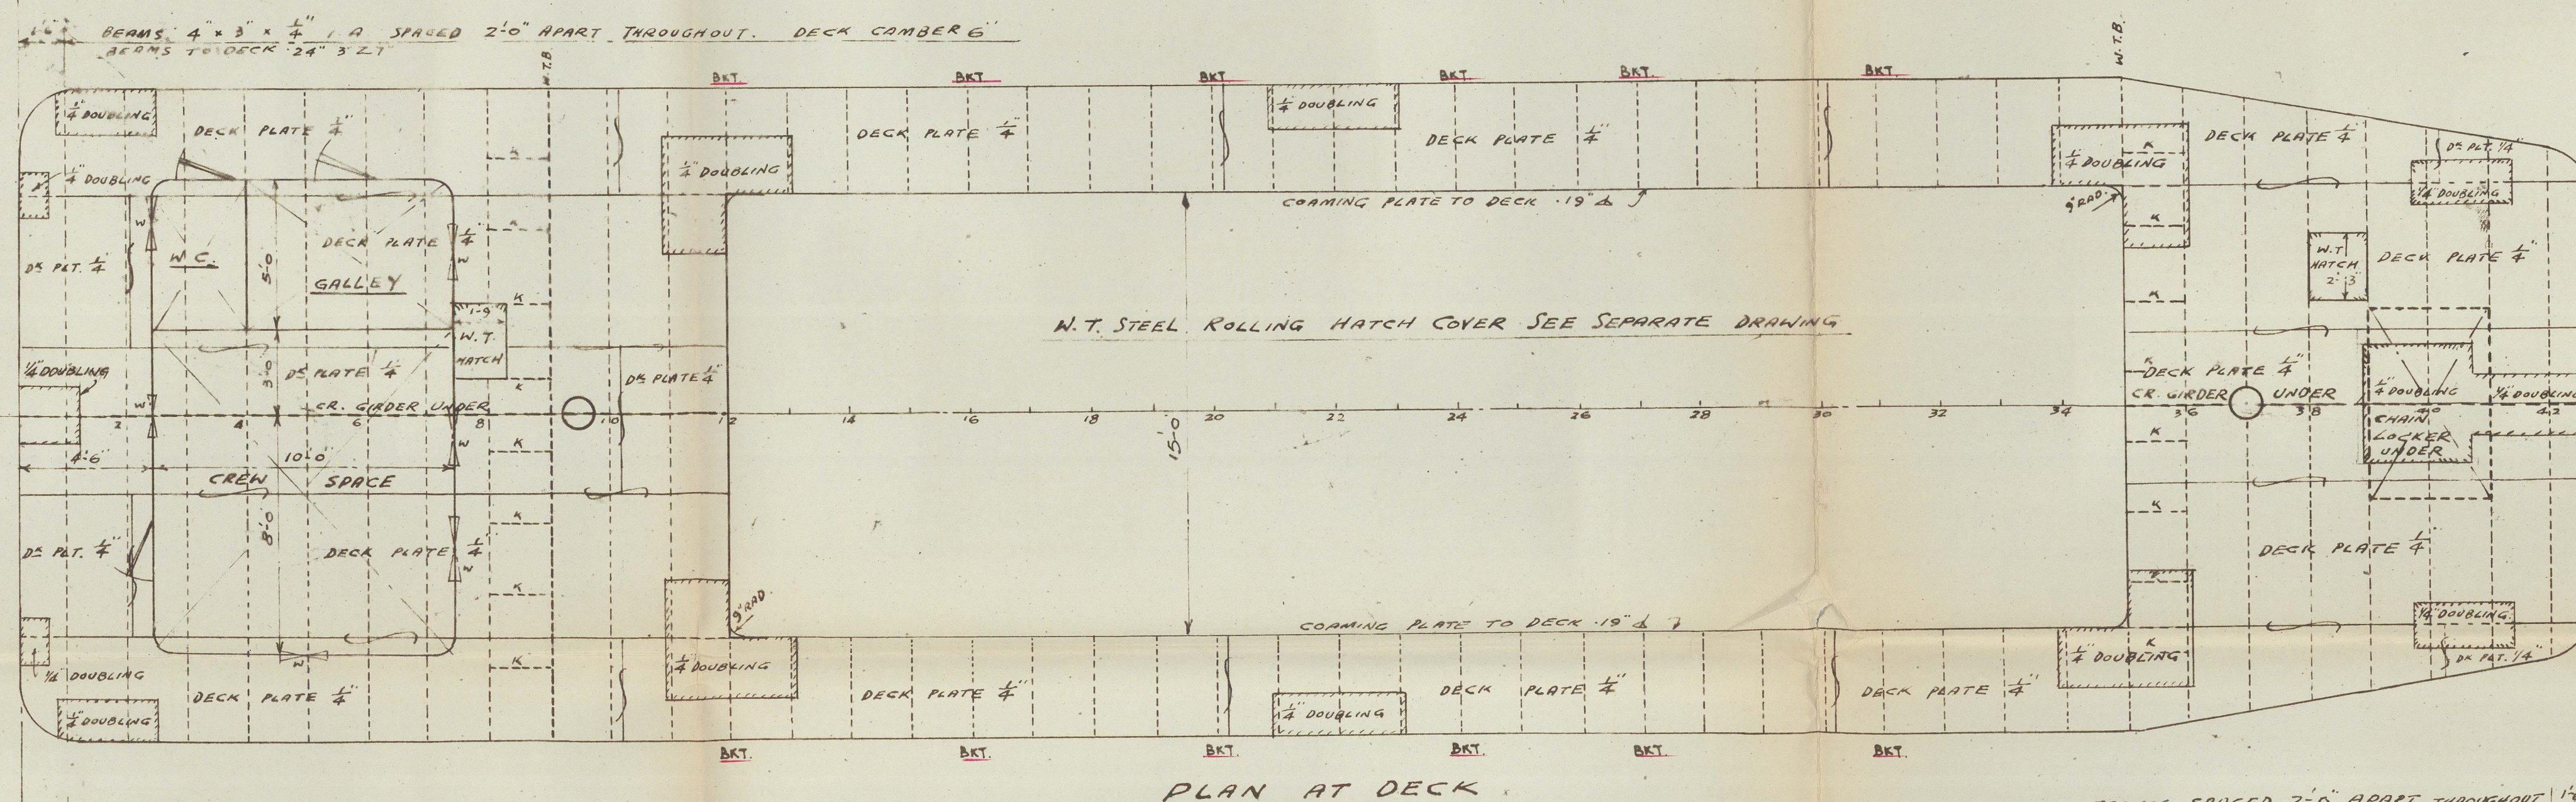

PLAN AT DECK

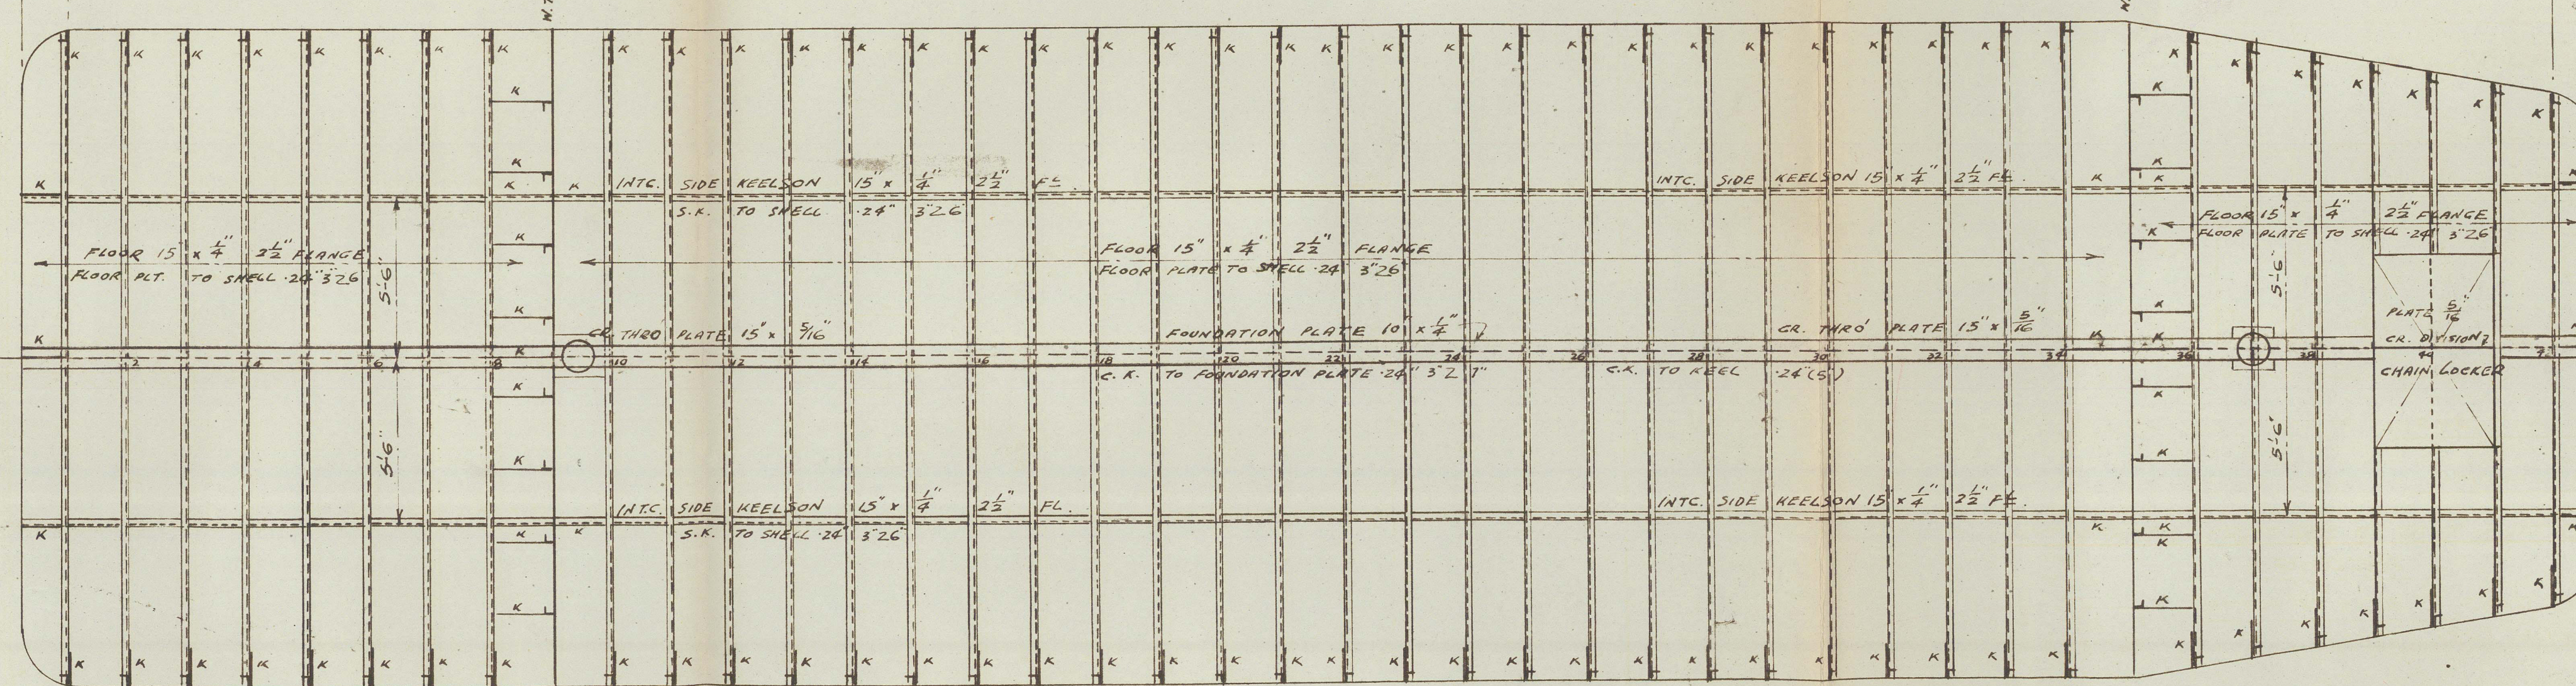

PLAN IN HOLD

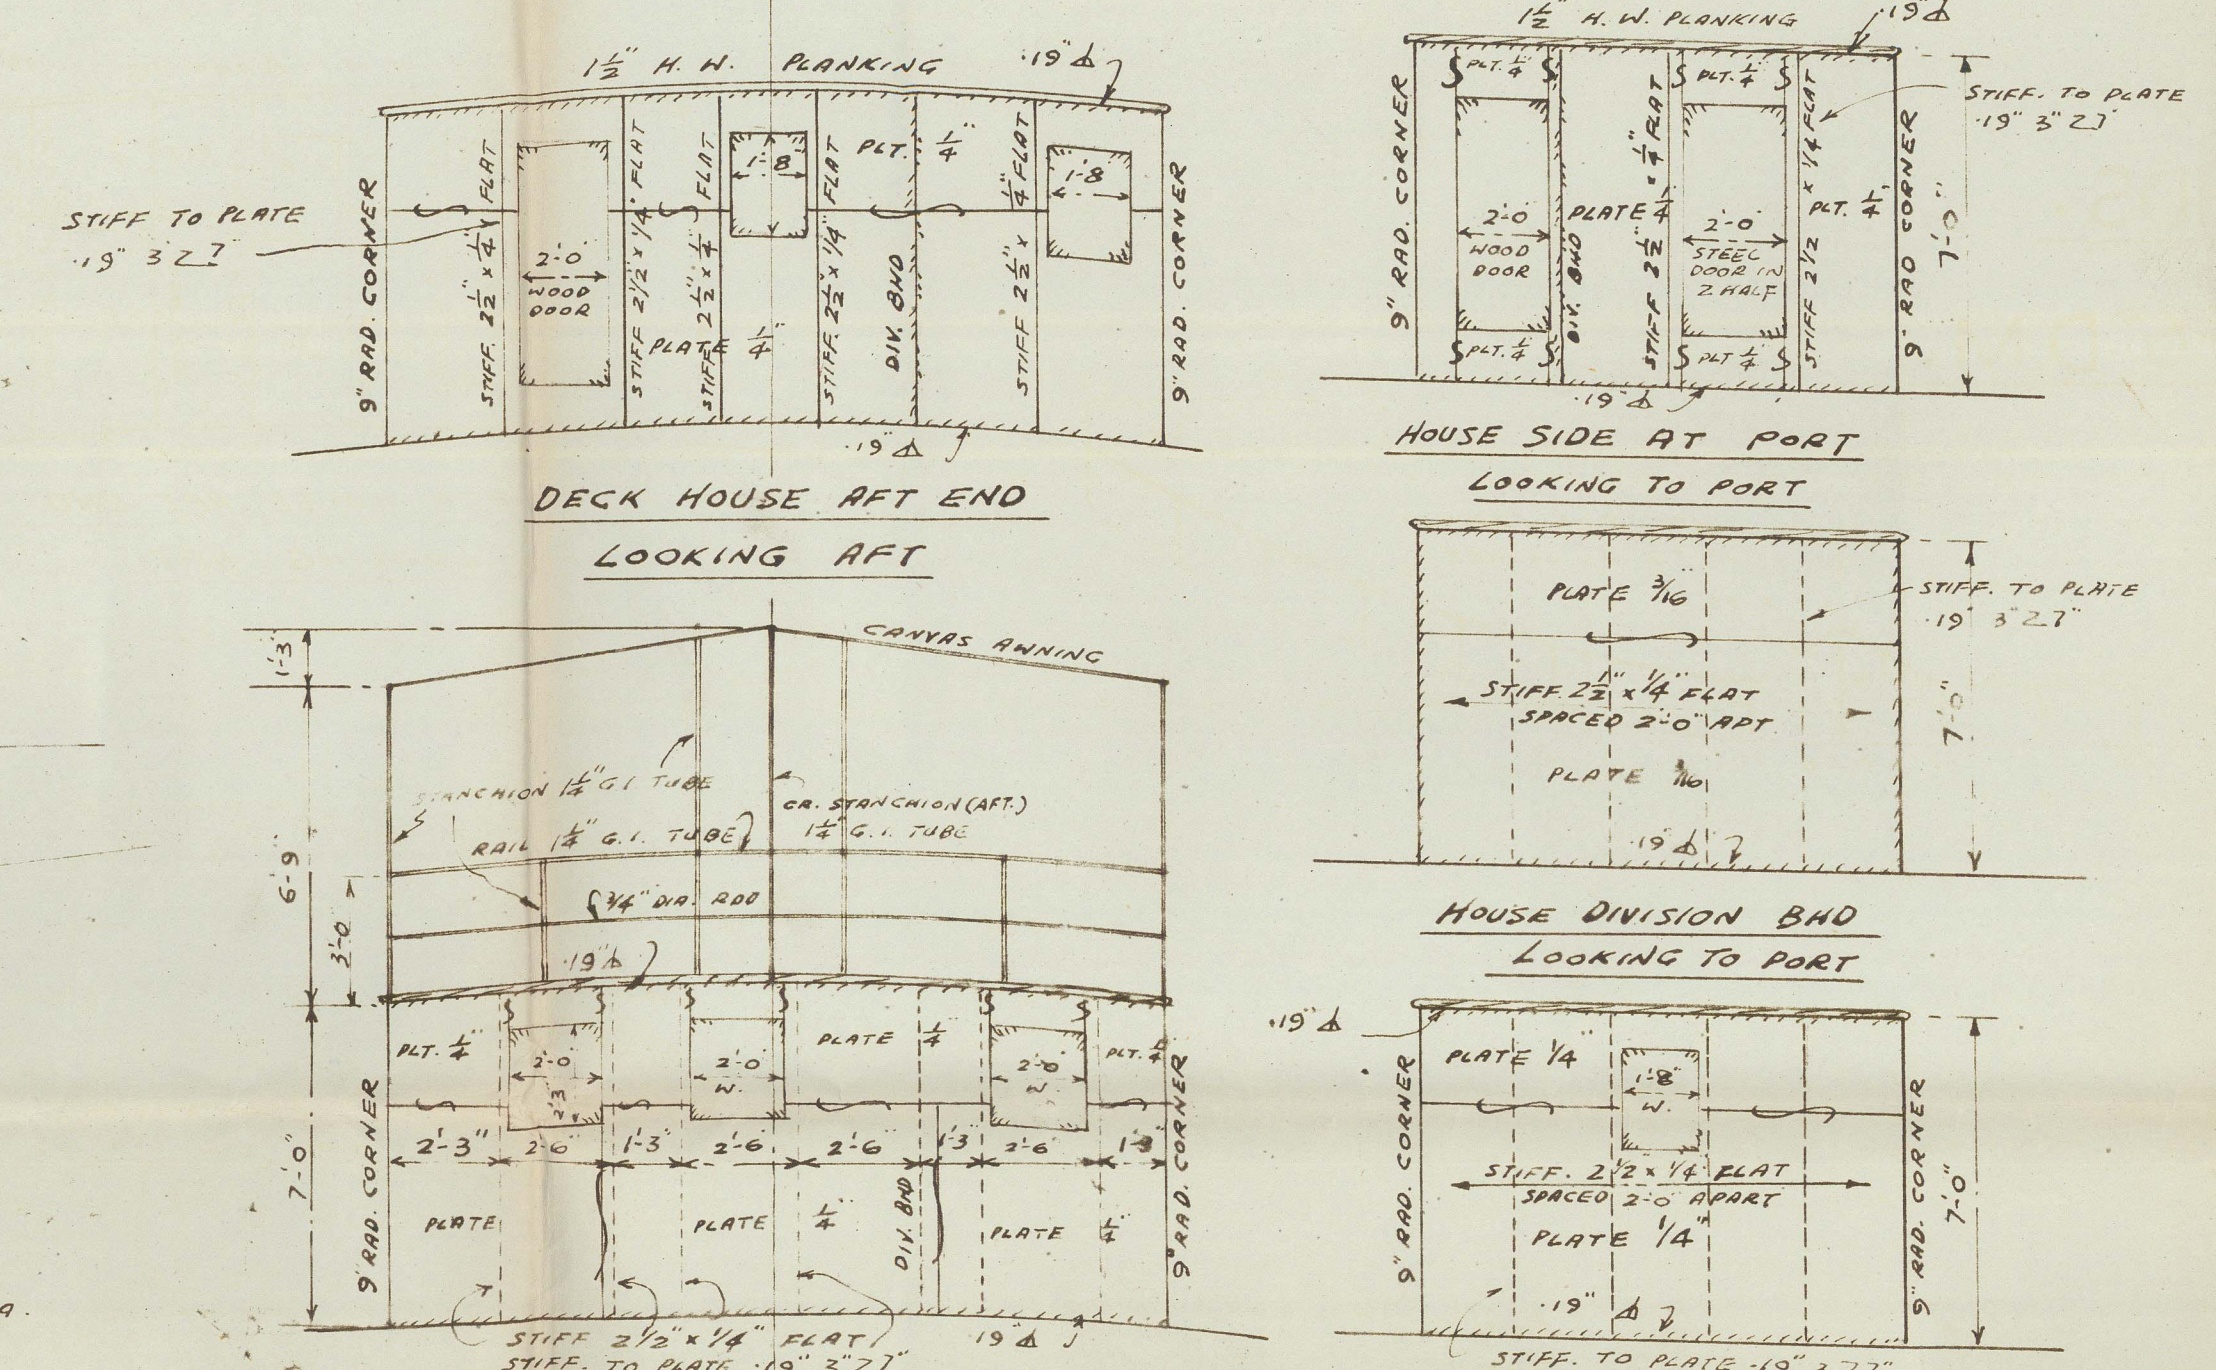

DECK HOUSE AFT END

LOOKING AFT

HOUSE SIDE AT PORT


LOOKING TO PORT

HOUSE DIVISION BND

LOOKING TO PORT

HOUSE SIDE AT STARBOARD

LOOKING TO PORT

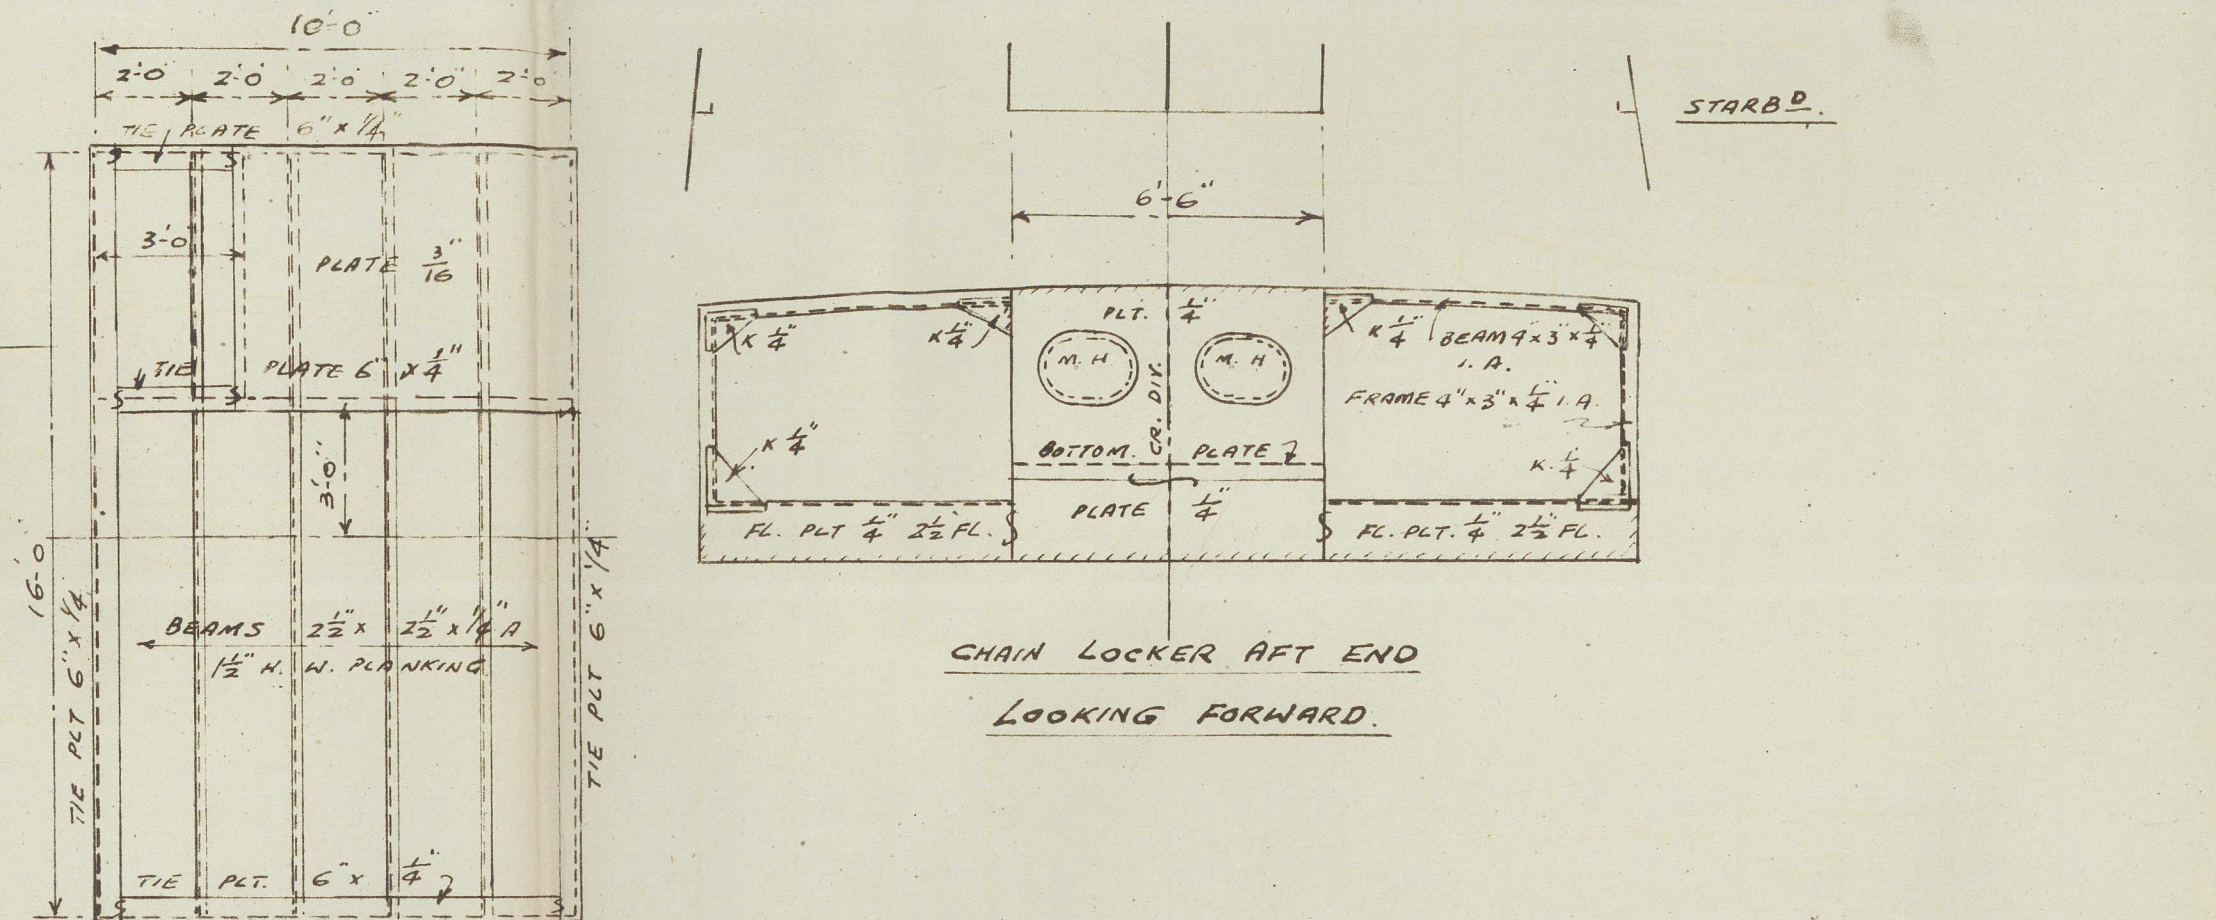


DECK HOUSE FRONT


LOOKING AFT

CHAIN LOCKER AFT END

LOOKING FORWARD

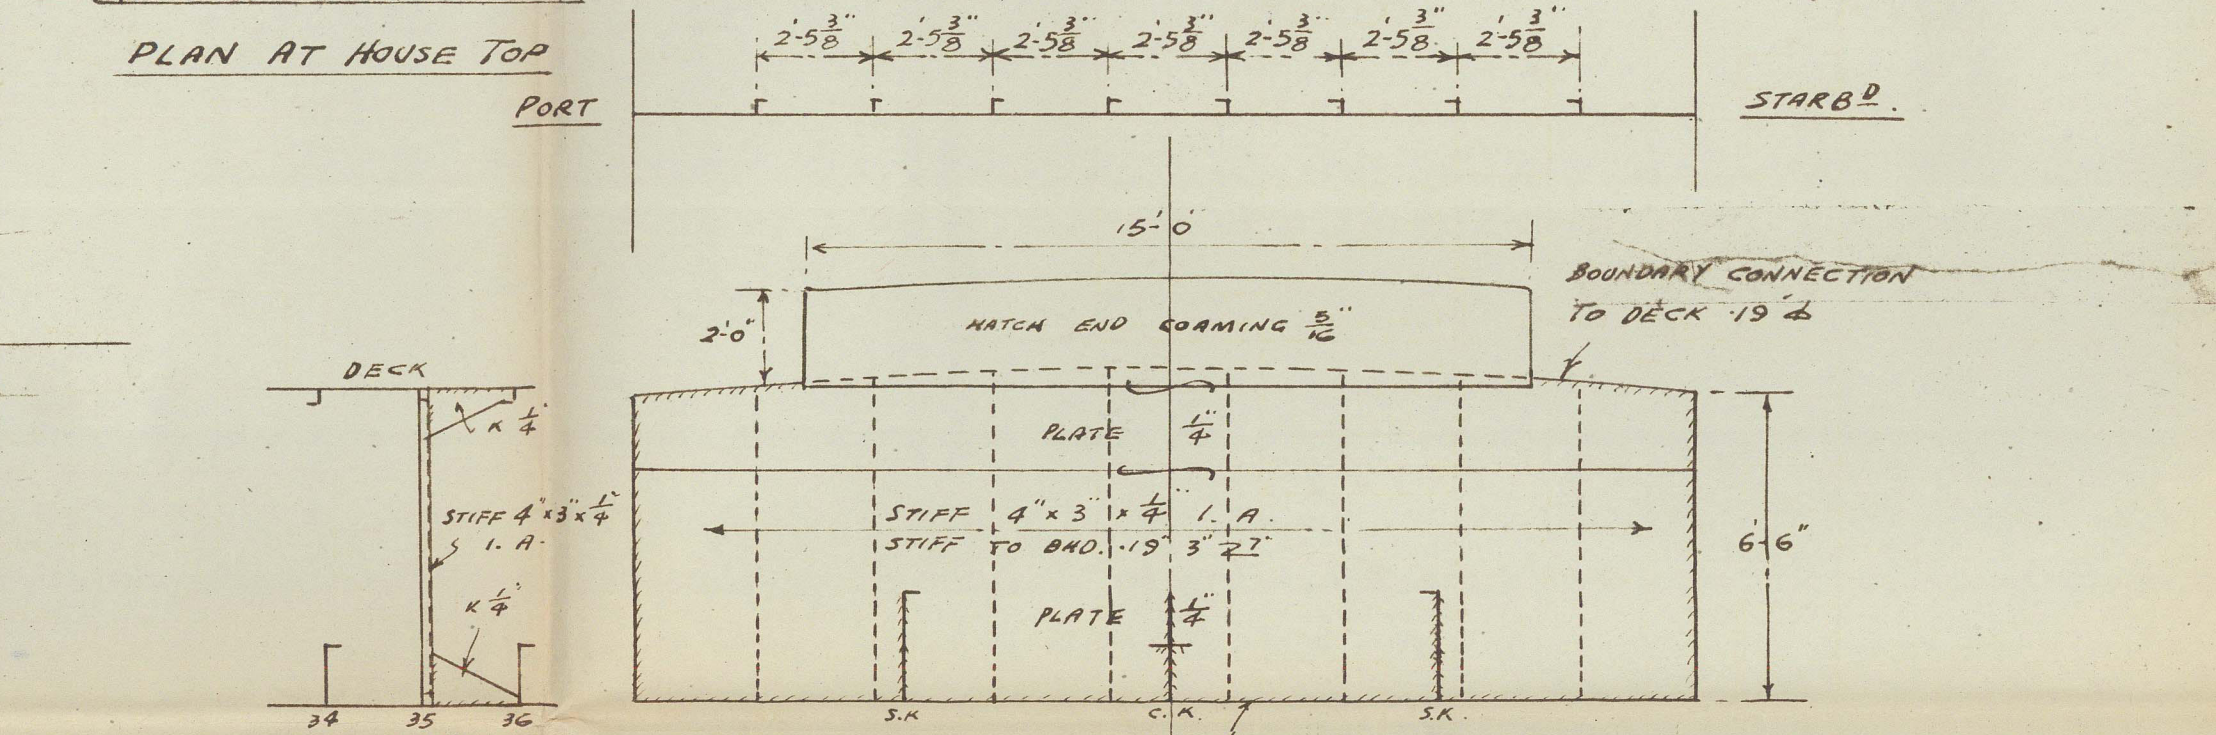

ANY OPENINGS NOT SHOWN ON THIS APPROVED PLAN WHICH MAY BE CUT IN BULK DECK OR SHELL PLG. ARE TO BE PROPERLY FRAMED & ADEQUATE COMPENSATION PROVIDED TO THE SURVEYOR'S SATISFACTION. THE LOSS OF SECTIONAL AREA OF LONGER MATERIAL IS TO BE RESTORED BY DOUBLINGS OR INCREASED THICKNESS OF PLG IN WAY OF AND AROUND SUCH OPENINGS. ADEQUATE COMPENSATION IS ALSO TO BE FITTED FOR THE CUTTING OF OTHER STRENGTH MEMBERS IN THE STRUCTURE AS MAY BE NECESSARY.

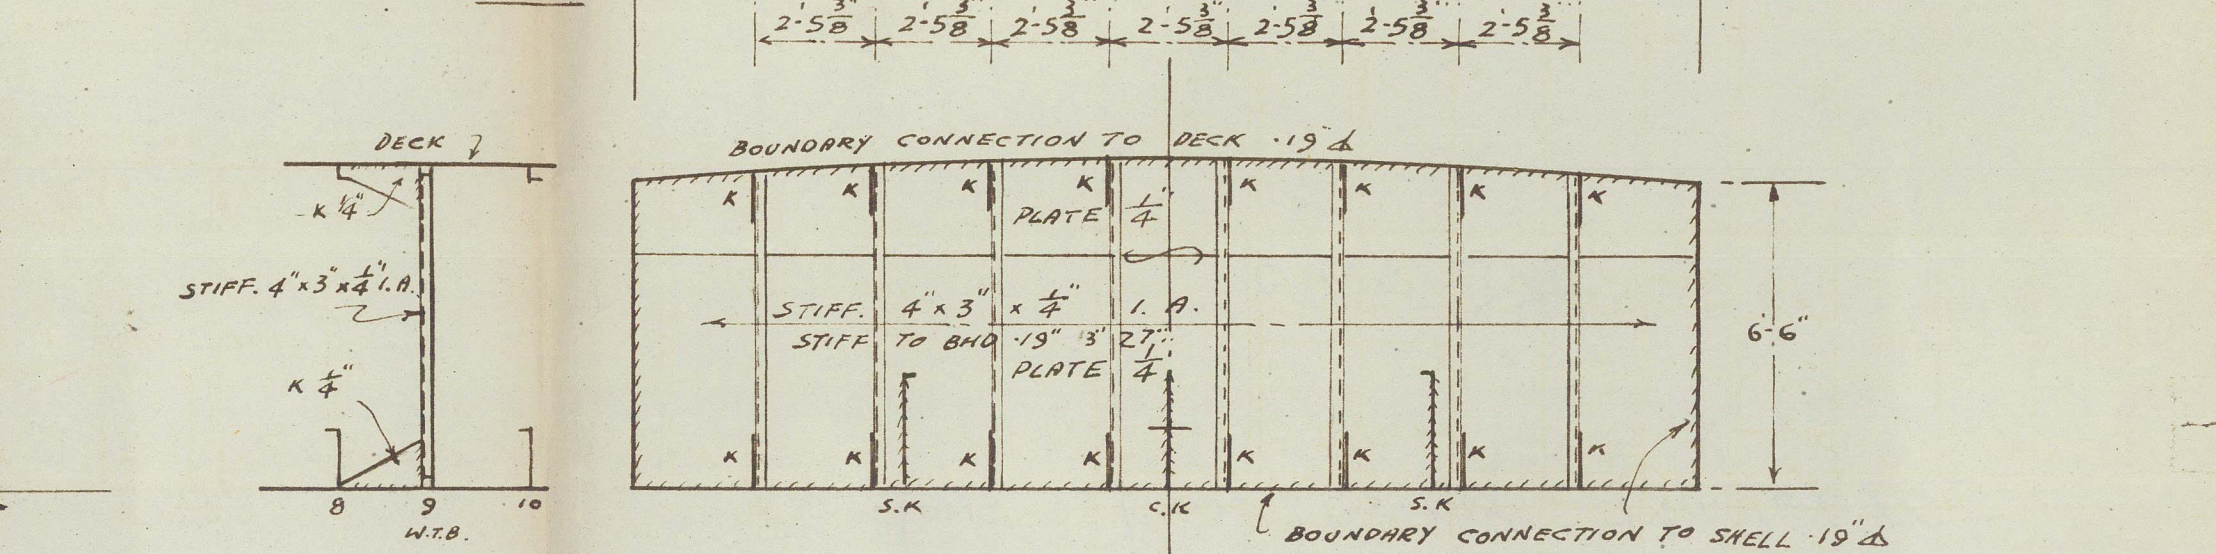

WELDING SYMBOLS

MARKED	DESCRIPTION	SYMBOLS
L &	CONTINUOUS FILLET ONE SIDE	L = LEG LENGTH
L &	CONTINUOUS FILLET BOTH SIDE	L = LEG LENGTH
L &	INTERMITTENT FILLET STAGGERED	L = LEG LENGTH Q = LENGTH OF FILLET
L &	INTERMITTENT FILLET CR. TO CR.	Q = SPACING OF FILLET

WELDING DETAILS TO BE TO SURVEYOR'S SATISFACTION.

APPROVED BY LLOYDS ON 10-11-1960

CHEONG LEE SHIPYARD NGAU CHAI WAN KOWLOON DATE 24-10-60

DR. No 853-858/3

BARGE "CHEOY LEE YARD NO. 853"

RECORDS DEPT.,
LONDON.

2

HONG KONG REPORT No. 16610

"C.M.S.I" ★

TITLE OF PLAN	(AS FITTED)
PROFILE & DECK, HOUSE & W.T. BHDS.	
CHEOY LEE SHIPYARD	
SHIP NO. 853	
NAME OF SHIP	

010263-010275-011

© 2021

Lloyd's Register
Foundation