




SCALE $1/4" = 1 \text{ FT.}$

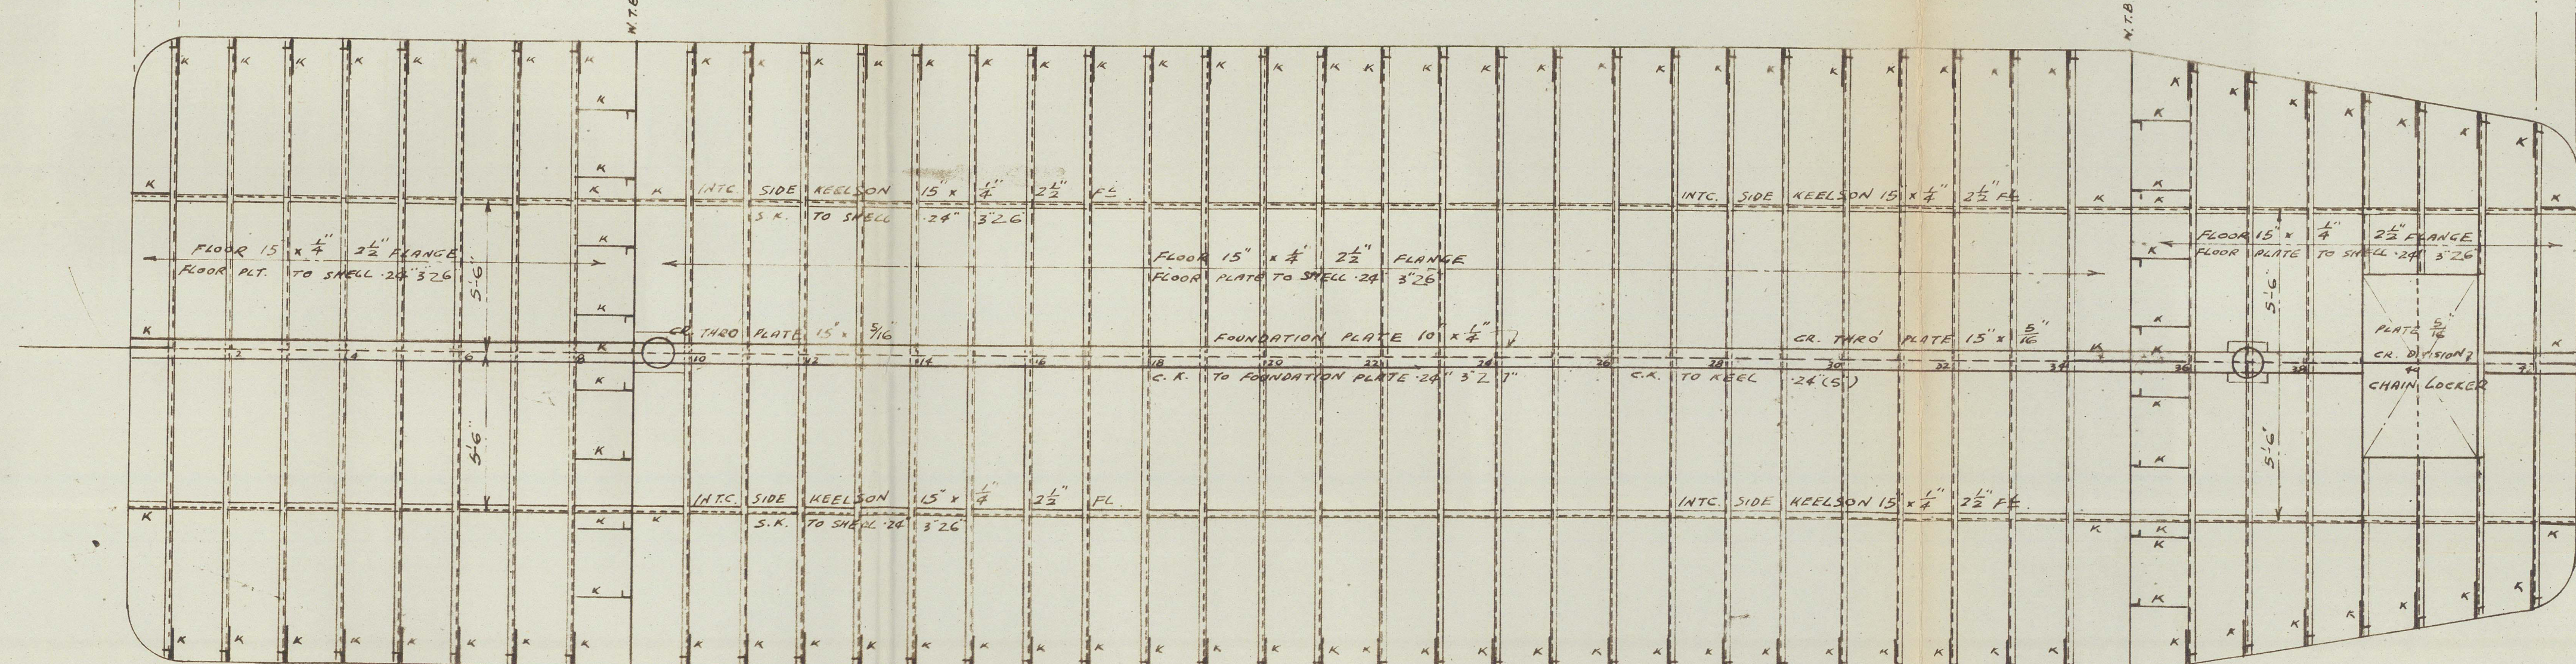

PLAN IN HOLD

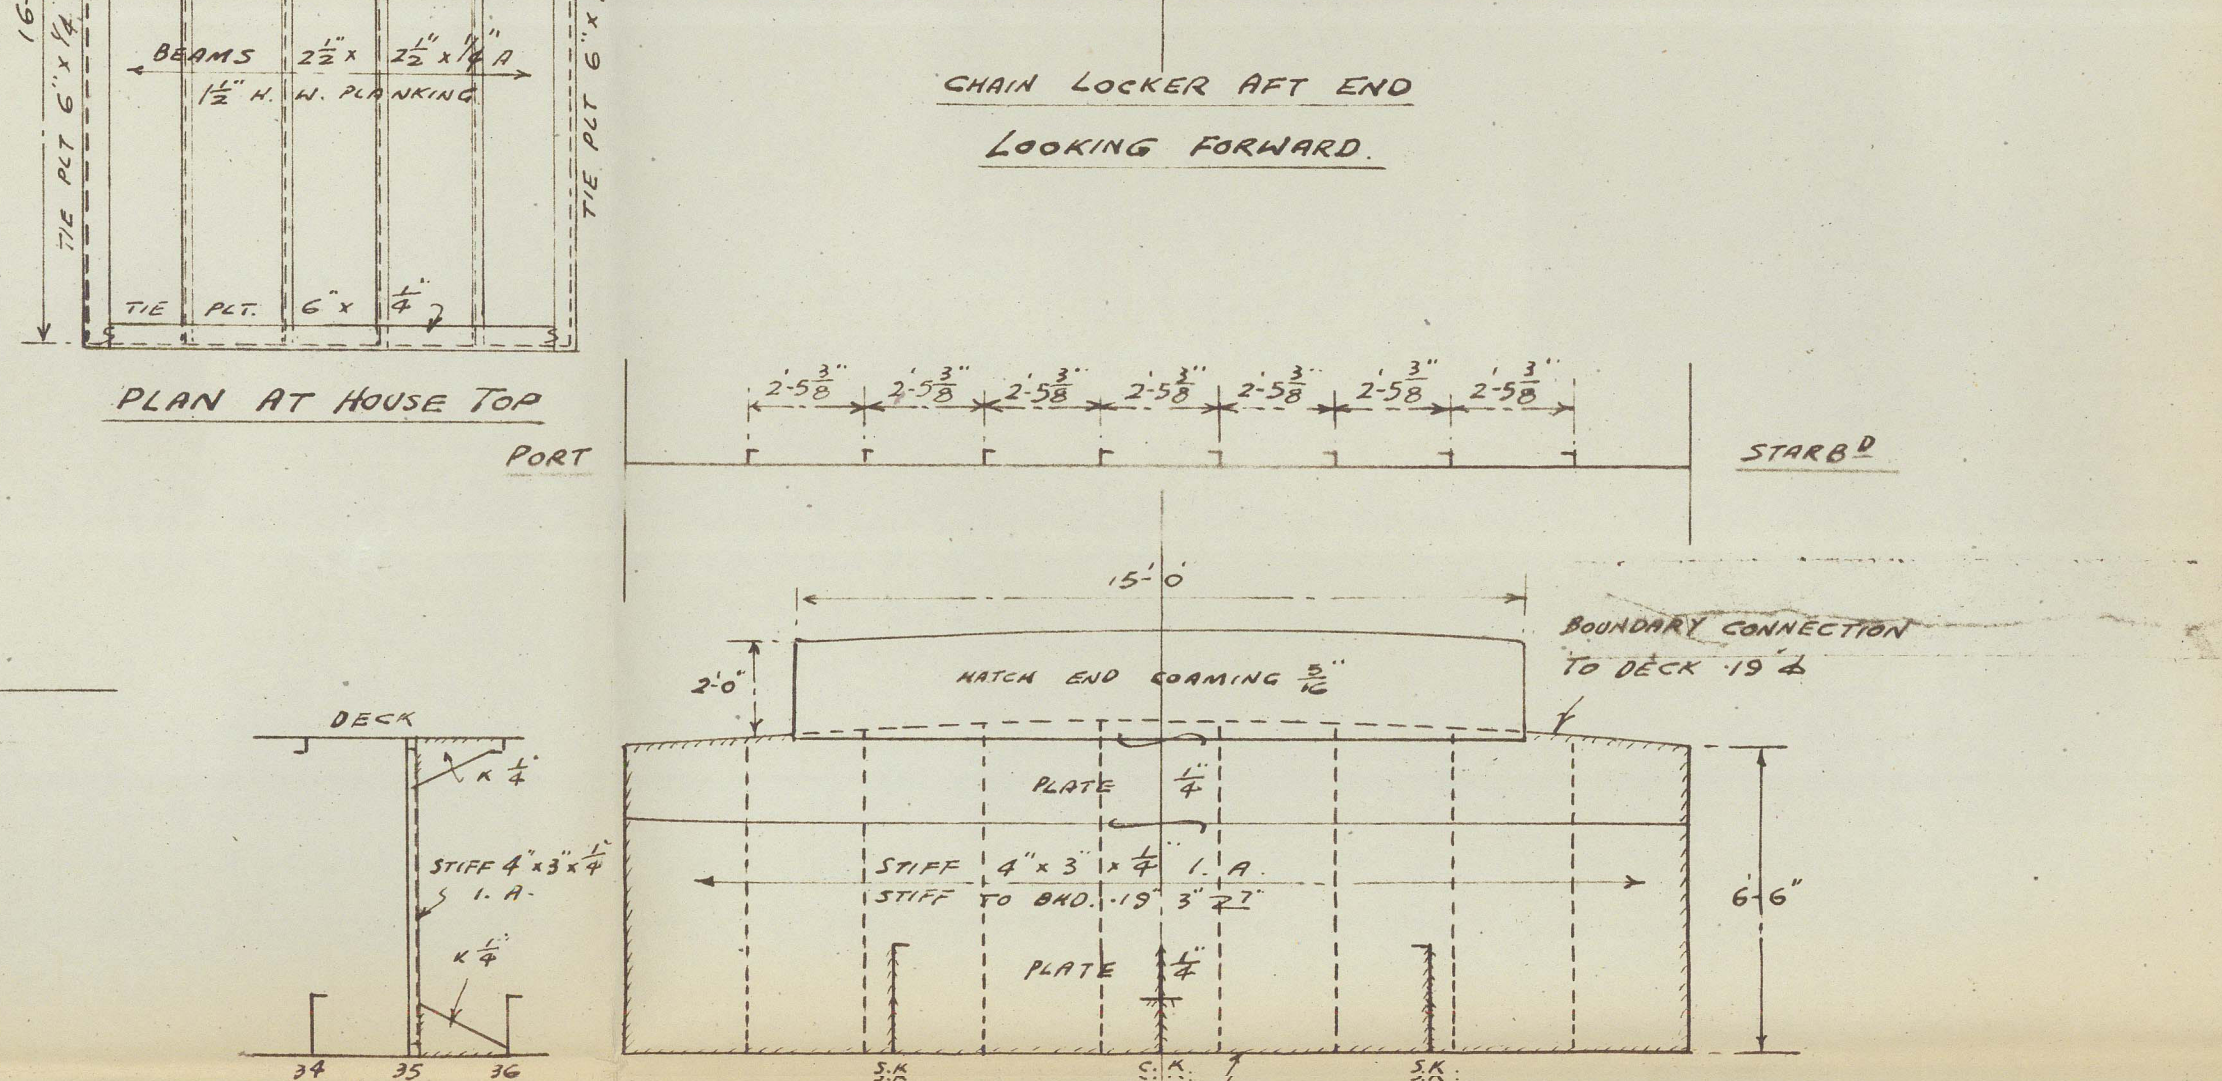

ANY OPENINGS NOT SHOWN ON THIS APPROVED PLAN WHICH MAY BE CUT IN BULK DECK OR SHELL PLG ARE TO BE PROPERLY FRAMED & ADEQUATE COMPENSATION PROVIDED TO THE SURVEYORS SATISFACTION. THE LESS OF SECTIONAL AREA OF LONG. MATERIAL IS TO BE RESTORED TO ORIGINALS OR INCREASED THICKNESS OF PLG IN WAY OF AND AROUND SUCH OPENINGS, ADEQUATE COMPENSATION IS ALSO TO BE FITTED FOR THE CUTTING OF OTHER STRENGTH MEMBERS IN THE STRUCTURE AS MAY BE NECESSARY.

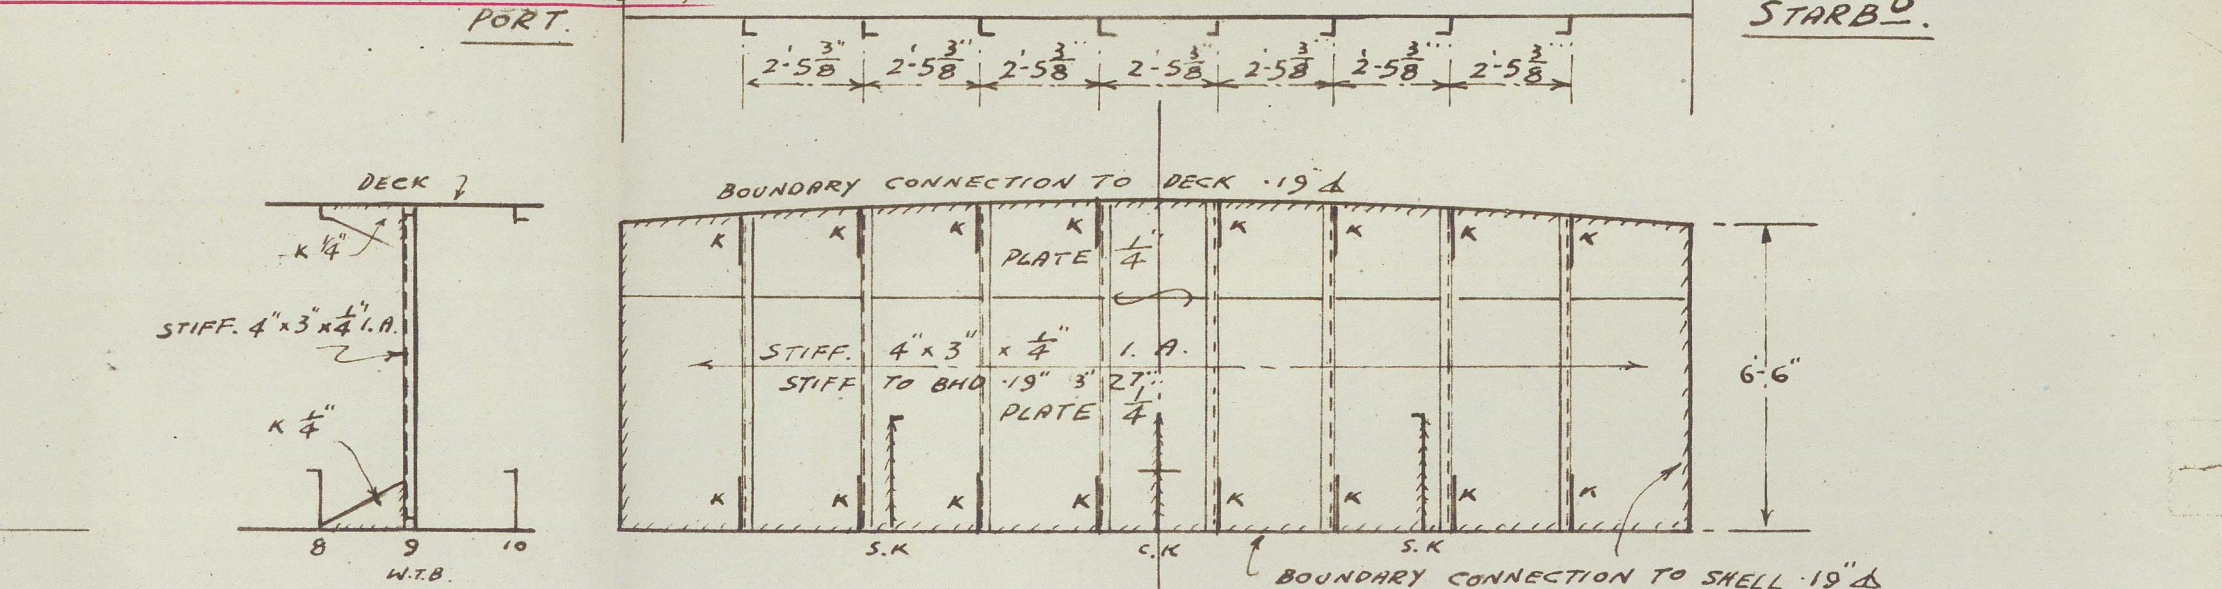

No 9 | W. T. BHD

LOOKING FORWARD.

WELDING DETAILS TO BE TO SURVEYORS SATISFACTION.

WELDING

ALL SEAMS & BUTTS OF PLATING
ABOVE 7 LBS TO BE

ALL SEAMS & BUTTS OF PLATING
A LITTLE DIFFERENCE TO BE

MARKED	DESCRIPTION	SYMBOLS
L b	CONTINUOUS FILLET ONE SIDE	L = LBQ LENGTH
L A	CONTINUOUS FILLET BOTH SIDE	L = LEG LENGTH
L b	INTERMITTENT FILLET	L = LEG LENGTH
q z b	SPACED FILLET	q = SPACING OF FILLET
L A	INTERMITTENT FILLET	b = SPACING OF FILLET
q (b)	CRIP GRAIN	CR. TO CR.

APPROVED
BY LLOYD'S
ON 10-11-1960

CHEOY LEE SHIPYARD
NGAU CHI WAN
KOWLOON -
DATE 24-10-60

DR. N^o 853-858/3


010262-010275-0128 © 2021

BARGE "CHEOY LEE YARD NO. 856"

HONG KONG REPORT NO. 16439

"C.M.S. IV" ★

RECORDS DEPT.,
LONDON.

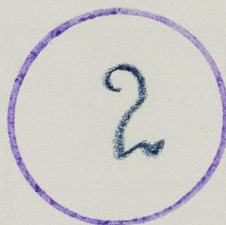

TITLE OF PLAN "AS FITTED"

PROFILE & DECK, HOUSE & W.T. BHDS.

CHEOY LEE SHIPYARD

SHIP NO. 856

NAME OF SHIP