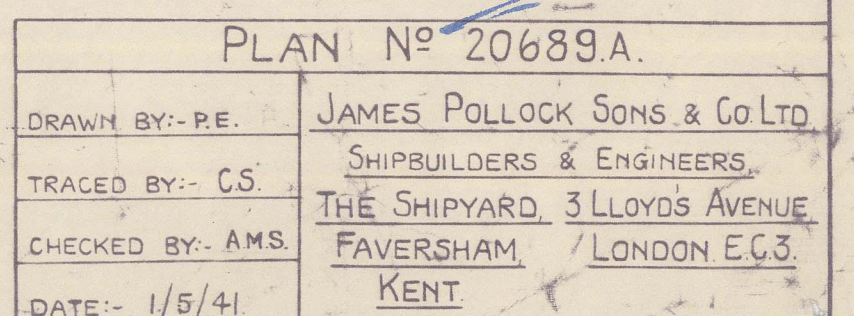


EX. "WALCRAG"
ALTERATIONS IN RED

SCALE: $\frac{1}{4}'' = 1$ FOOT.

M.O.S. № 92.



010263-010275 © 2021