

## Lloyd's Register of Shipping.

## SURVEYS FOR FREEBOARD - STEAM SHIPS.

16 JUL 1927

PARTICULARS RELATING TO A STEAM SHIP, EITHER FRESH DECKED OR WITH TOP GALLANT FORECASTLES, SHORT POOPS, AND BRIDGE HOUSES DISCONNECTED, WITH TOP GALLANT FORECASTLES HAVING LONG POOPS, OR RAISED QUARTER DECKS CONNECTED WITH BRIDGE HOUSES, OR OTHERWISE.

Port of Survey: *Middleburgh*  
 Date of Survey: *During Construction*  
 Name of Surveyor: *J. R. Dwyer*

Ship's Name.	Port of Registry and Nationality.	Official Number.	Gross Tonnage.	Date of Build.	Particulars of Classification.
<i>S. S. OTTERHOUND</i> Ment. Number S.B. N° 121 Number in Register Book	<i>British</i> <i>London</i>	<i>149879</i>	<i>915</i> <i>approx</i>	<i>1927</i>	<i>100 A1 Carrying Petroleum in Bulk</i> <i>Longitudinal Framing, Bottom and Decks</i> <i>Braced System (Contemplated)</i>

Registered dimensions from Ship's Register.	LENGTH.	BREADTH.	DEPTH.	UNDER DECK TONNAGE.
	<i>190.5</i>	<i>32.5</i>	<i>14.6</i>	<i>654.40</i>

CORRECTED DIMENSIONS.	<i>190.0</i>	<i>32.58</i>	<i>15.14</i>	<i>678.40</i>

Moulded Depth as measured..... *15.0*Addition for Keel below base line for draught record..... *1.9* inches.

NOTE - If the depth is measured when vessel is afloat, the details of measurement should be reported.

## CORRECTION FOR LENGTH

Length of Ship on Loadline.....	<i>190.0</i>
Length in Table .....	<i>180.0</i>
Difference .....	<i>10.0</i>
Correction for 10ft., Table A. ....	<i>1.0</i>
× Difference divided by 10 .....	<i>1.0</i> (if required.)
If $\frac{1}{10}$ ths length covered divide by 2 .....	<i>2.0</i> <i>50</i> <i>+ 1/2</i>

## CORRECTION FOR IRON DECK.

Proportion covered, if less than $\frac{1}{10}$ ths length covered .....	<i>2.5</i> <i>75</i>
Thickness of usual wood deck, less stringer .....	<i>-3</i>

## CORRECTION FOR ROUND OF BEAM.

Breadth at Gunwale amidships.....	<i>32.25</i>
Round of Beam .....	<i>7.5</i>
Normal round.....	<i>8.0</i>
Difference .....	<i>-56.25</i> <i>÷ 2</i> = <i>-28.125</i>
Proportion of Deck uncovered (Para. 19) .....	<i>28.5</i>

NOTE - The round of beam should be reported on the full breadth of vessel at the gunwale.

Co-efficient of fineness..... *.703* *698*

Any modification necessary [Para. 4 (a) to (e)]\* .....

Co-efficient as corrected .....

Sheer { Stem..... *54* } *81* ÷ 2 = *40.5* Mean  
at { Sternpost ... *27* }Sheer at  $\frac{1}{2}$  of the length from { Stem *30.5* } *45.5* ÷ 2 = *22.75* Mean  
{ Sternpost *15.25* }Gradual mean Sheer ..... *40.93*Standard mean Sheer [Table, Para. 18] ..... *29.00* CorrectionDifference..... *11.93* ÷ 4 = *2.98*§ If limited as Para. 18 (f) ..... *-3*Rise in Sheer { At front of bridge house..... ✓  
from amidships { At after end of forecastle ..... ✓  
[Para. 18 (e)]

Fall in Sheer {

Para. 18 (d) } ÷ 2 =

Length uncovered ..... Correction

## ALLOWANCE FOR DECK ERECTIONS:—

Freeboard, Table C..... *0.625*

Correction for Length, if required (Para. 12, 13, and 14) .....

Freeboard by Table A, corrected for sheer, and for length, if required (Para. 12, 13, and 14) .....



25 JUL 1927

FREEBOARD recommended amidships from centre of Disc to top of Statutory Deck Line, Wood (Steel) Deck:—  
 Fresh Water Line above centre of Disc ..... *3.34* *3.34*  
 Indian Summer Line " " " ..... *2.0* *2.0*  
 Winter Line below " " " ..... *1.12* *1.12*  
 Winter North Atlantic Line " " " ..... *3.34* *3.34*

† If the frames, skin planking, or ceiling are of unusual thickness the breadth of vessel to inside of ceiling should be reported if possible.

‡ In vessels obtaining an allowance for deck erections under Para. 11 where the sheer drops abaft amidships the height of the R.Q.D. is to be taken from the level of the top of the amidship beam.

§ In flush-decked vessels the total standard mean sheer means the sheer measured at the stem and sternpost. In vessels having poops and forecastles, it means the sheer measured at points distant one-eighth of the vessel's length from stem and sternpost.

2m, 1.28, T.

7 W =  $\frac{1840}{11.9 \times 40} = 3.86$

MARKING FORM

RECEIVED 8 - AUG 1927

010276 - 010282 - 0108

© 2021

Lloyd's Register Foundation


Do all the Frames extend to the top height in the Poop? Yes Raised Quarter Deck? ✓ Bridge House? ✓ Forecastle? ✓  
To what height do the Reverse Frames extend? Bulk. angle frames  
Has the Poop or Raised Quarter Deck an efficient Bulkhead at the fore end? Yes  
Give particulars of the means for closing the openings in Bulkhead One opening each side 5'-4" x 3'-0" with storm boards in hinged channels full height  
Is the Poop or Raised Quarter Deck connected with the Bridge House? No Has the Bridge House an efficient Bulkhead at the fore end?  
Give particulars of the means for closing the openings in Bulkhead ✓  
What is the thickness of the Bridge Front plating? ✓ and Coaming plate? ✓  
Give scantlings and spacing of the Stiffeners ✓  
Are bracket plates fitted at each end of the Stiffeners? ✓ Are hor'l. brackets fitted connecting Bridge Bulk'd. with Bulwarks? ✓  
Has the Bridge House an efficient Iron Bulkhead at the after end? ✓  
How are the openings closed? ✓  
Is the Forecastle at least as high as the main or top-gallant rail? 7'-6" Has the Forecastle an efficient Iron or Wood Bulk'd. at after end? Steel Bulkhead 2 openings 5'-8" x 3'-0" with storm boards full height  
Are the Engine and Boiler openings covered by a Bridge, Poop, Raised Quarter Deck, or enclosed by a Strong Iron or Steel Deckhouse? Poop Deck Coaming  
If the openings are not so protected are the exposed parts of the Casings efficiently constructed? ✓  
Give thickness of plating; scantlings and spacing of Stiffeners ✓  
What is the height of the exposed Casings? 7'-3" Are suitable means provided for closing all openings in them in bad weather? Steel Doors  
Are the Weather Deck Hatchways efficiently constructed and at least equal to the requirements of Section 28 of the Rules for 1904-5? Give particulars below:— Yes

Position and Size.		Bunkers hatchways on poop		all light hatches on top of trunk					
Item.		Ship.	Rule.	Ship.	Rule.	Ship.	Rule.	Ship.	Rule.
COAMING.	Height above top of DECK	2'-6"	2'-6"	2'-6"	2'-6"	6" angle. Coaming			
	Sides	.44	.44	.44	.44	.50 plate. Coaming			
	Ends	.44	.44	.44	.44				
SHIFTING BEAMS OR WEB PLATES.	Number								
	Section and Scantlings	✓							
	Material								
* FORE AND AFTERS.	Number								
	Section and Scantlings	✓							
	Material								
HATCHES Thickness		3" K.W.		3" K.W.					
Remarks									

\* The depth of Fore and Afters should be stated from the underside of the hatches in all cases.  
(If the sill of the lowest side scuttle will be less than 6 inches above the Indian Summer Load Line if assigned under the tables, state vertical distance from top of deck at side amidships to lower edge of lowest side scuttle.)  
The following information is to be given in all Cases of vessels dealt with under Paras. 11, 12 (under 15 feet Moulded depth) and under Shelter Deck Rules.  
What is the thickness of the Bridge Sheerstrake? ✓ Strake between Main and Bridge Sheerstrakes? ✓

Delete the words that do not apply { The Crew are, are not, berthed in the bridge house.  
The arrangements to enable them to get backwards and forwards from their quarters are, are not satisfactory.

Length of Bulwarks in well  
Area of Freeing Ports required by Para. 11 (e) each side of vessel = open Rails Sq. ft.  
Ft. Tenth. Ft. Tenth. No. } Freeing Ports = open Rails Sq. ft.  
(each side of vessel)  
Total deficiency or excess = open Rails Sq. ft.

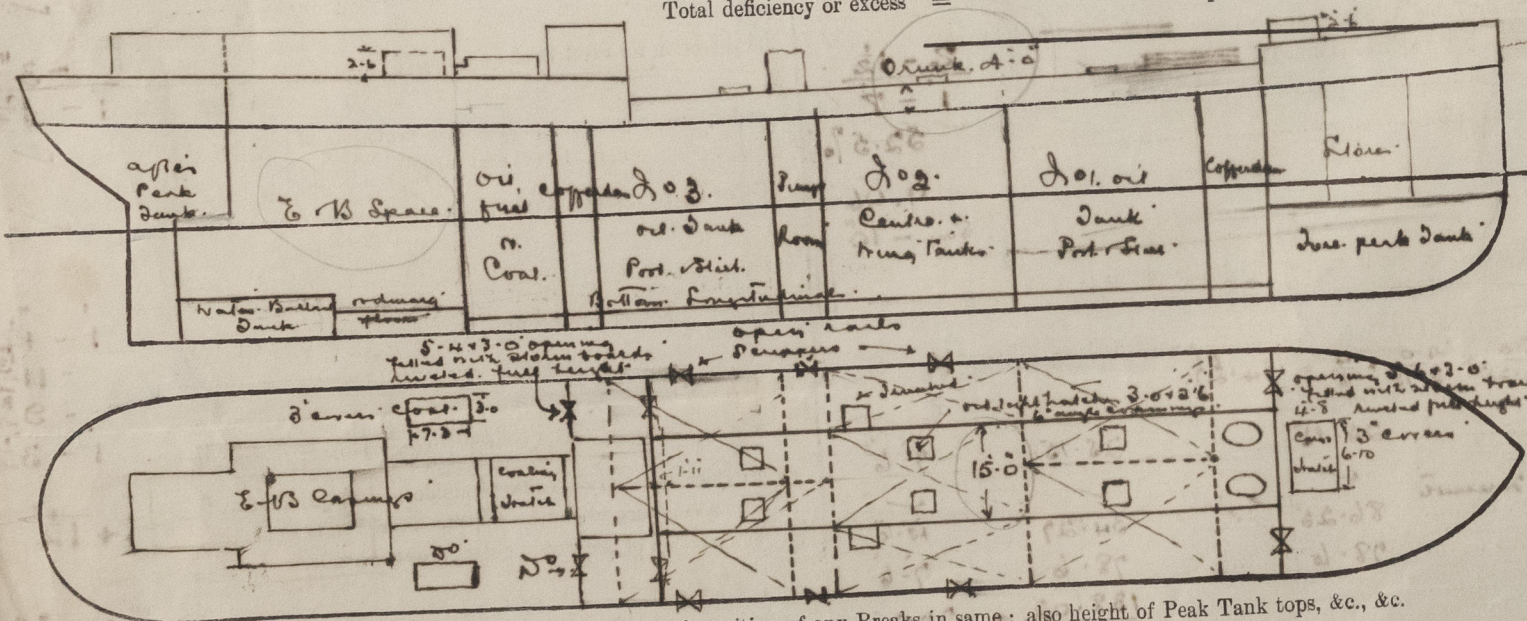

State any special features in the construction of the Vessel This vessel has been built in accordance with the approved  
Builder's name and yard number plan. copies of which are retained in Random Office; 100 Al Carving  
Names of sister vessels Petroleum in bulk Longitudinal framing at Bottom and Decks; Brackets System;  
Bulk. angle frames on side.  
Owners Furness S.W. 67 N° 121

Address  
Fee £ 4 : 0 : 0 aprove Received by me