

# DETAIL OF RUDDER AND STERNPOST № 31

SCALE 1" = 1'8"





1 - 10.

VERSCHURE & CO'S SCHEEPSWERF  
EN MACHINEFABRIEK - AMSTERDAM

A = 53' 43"  
D = 1'3" 2  
A.D = 68'9" 86

STEERING CHAINS 5/8"  
RODS 1 1/4"  
SPEED PER HOUR 9 KNOTS.

*Steel forged. wrought-iron  
in cast-steel.*

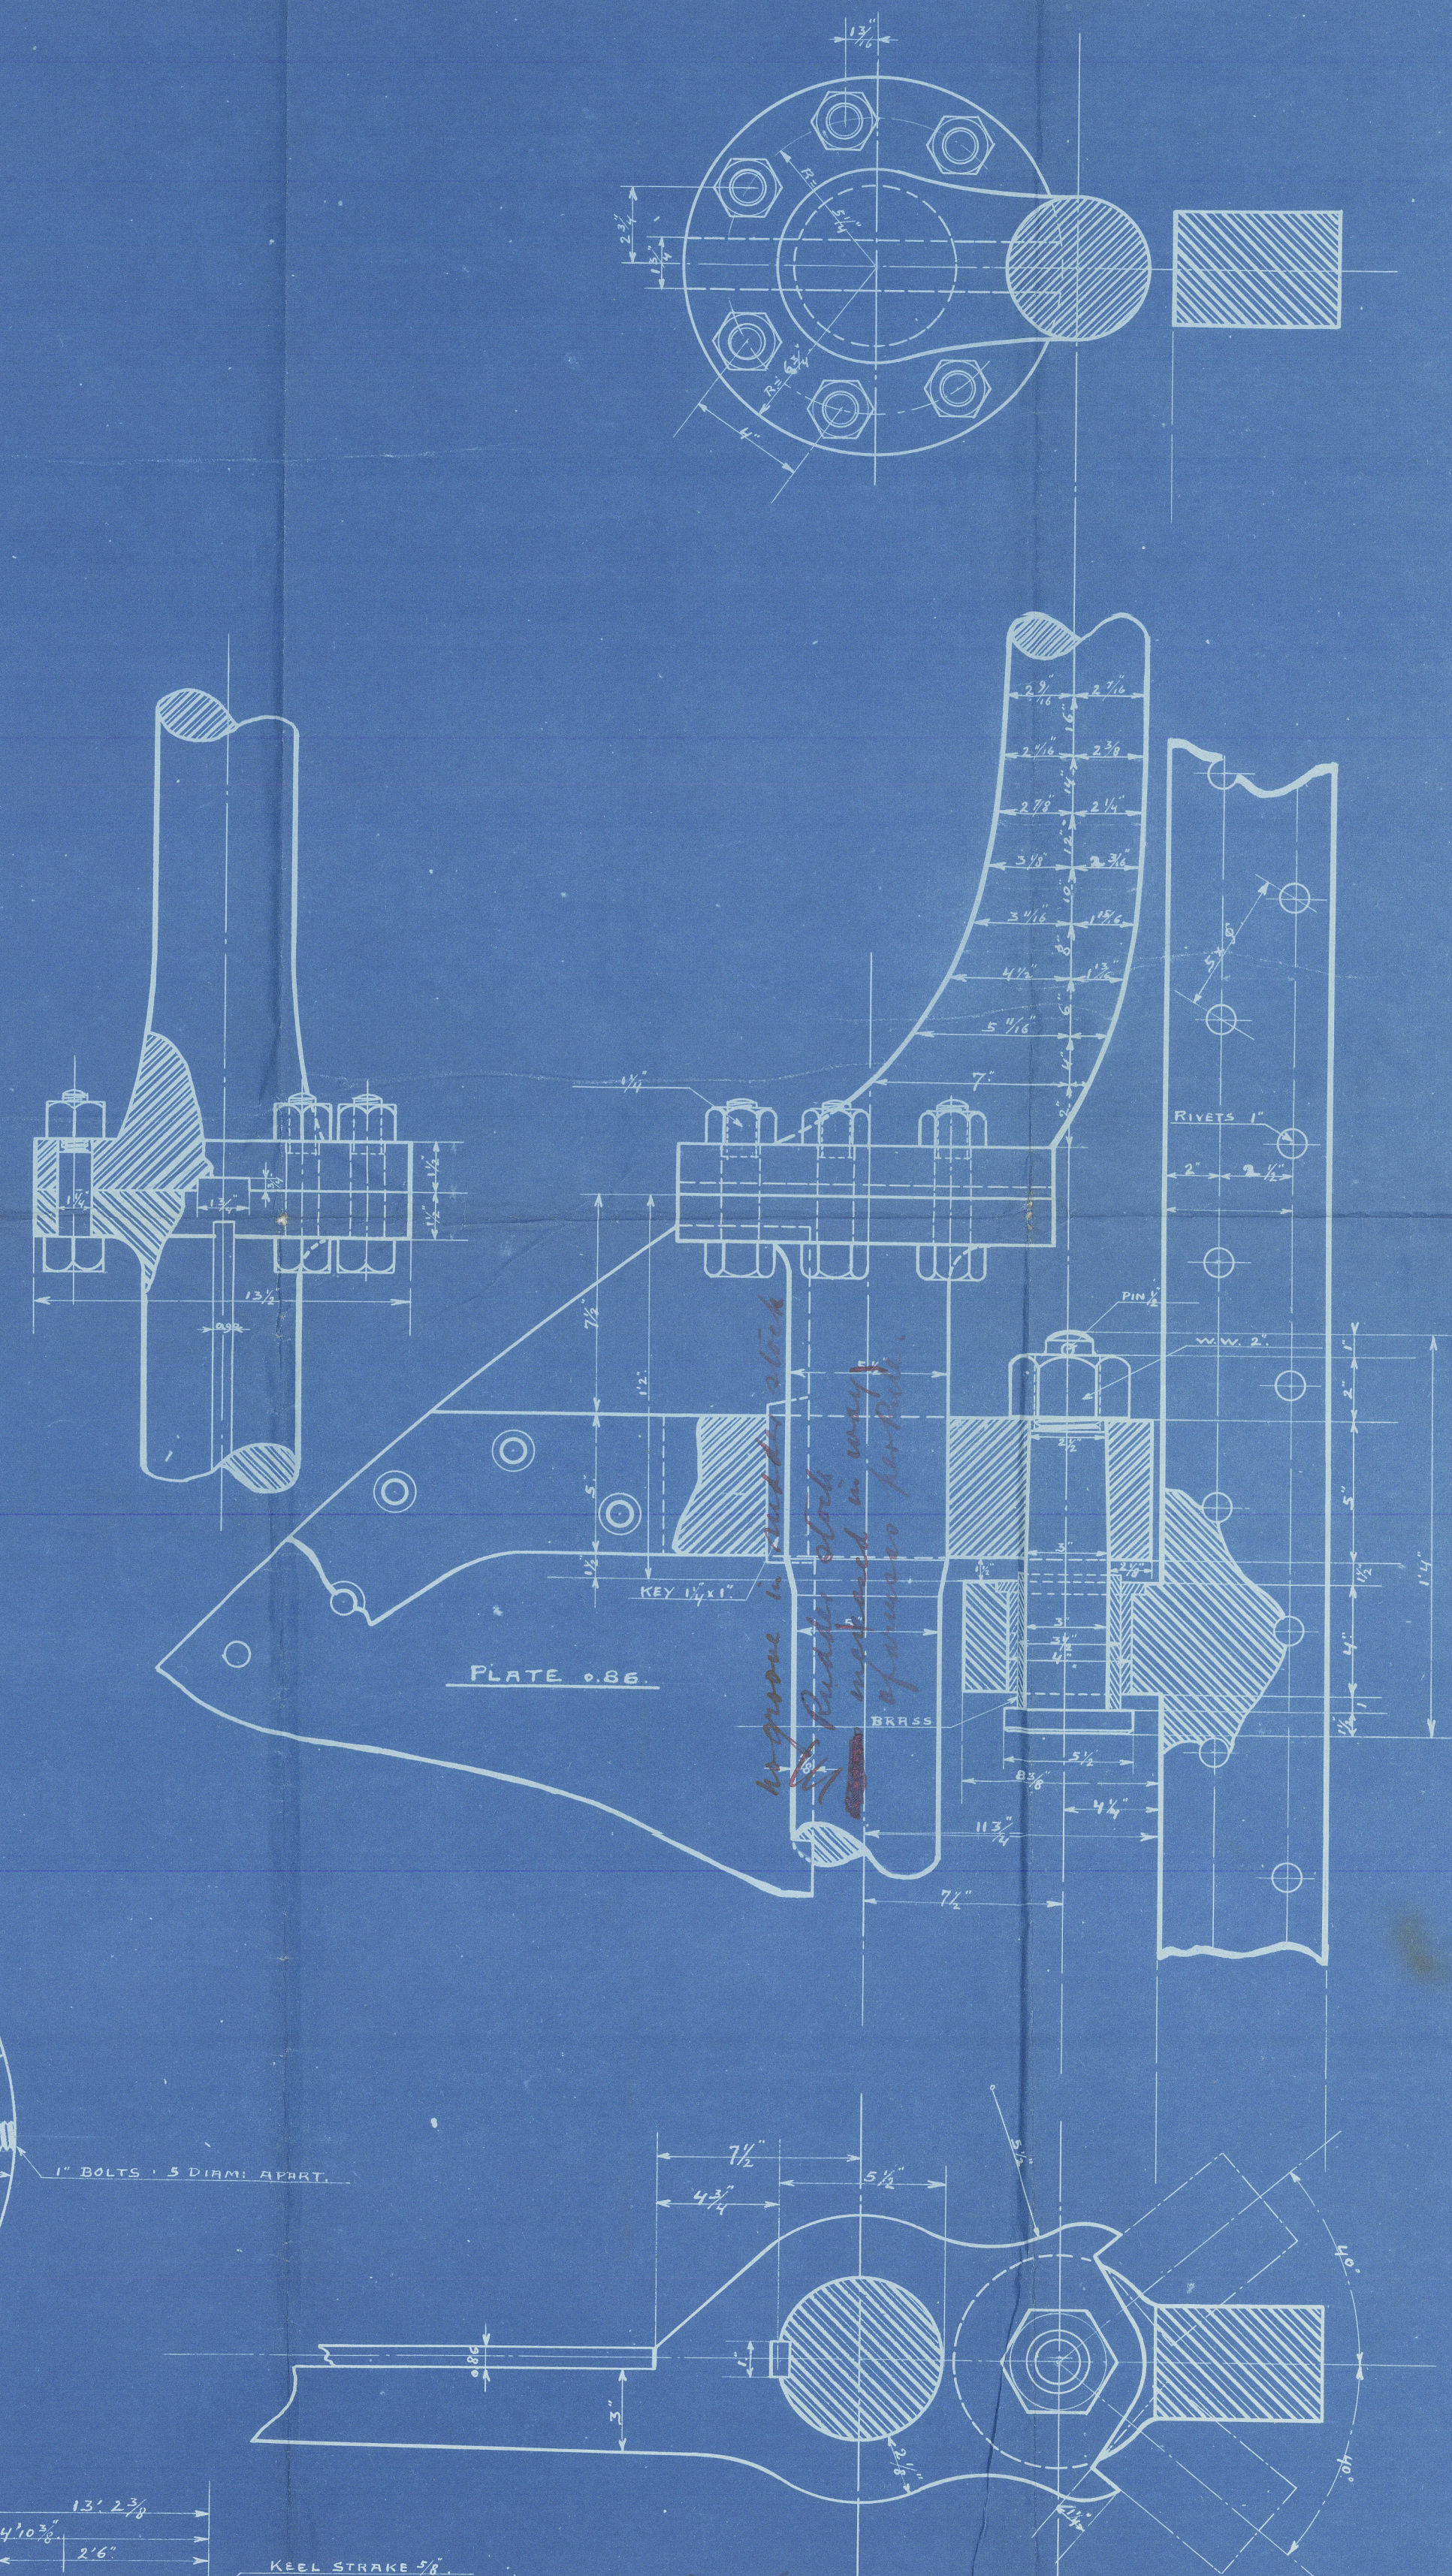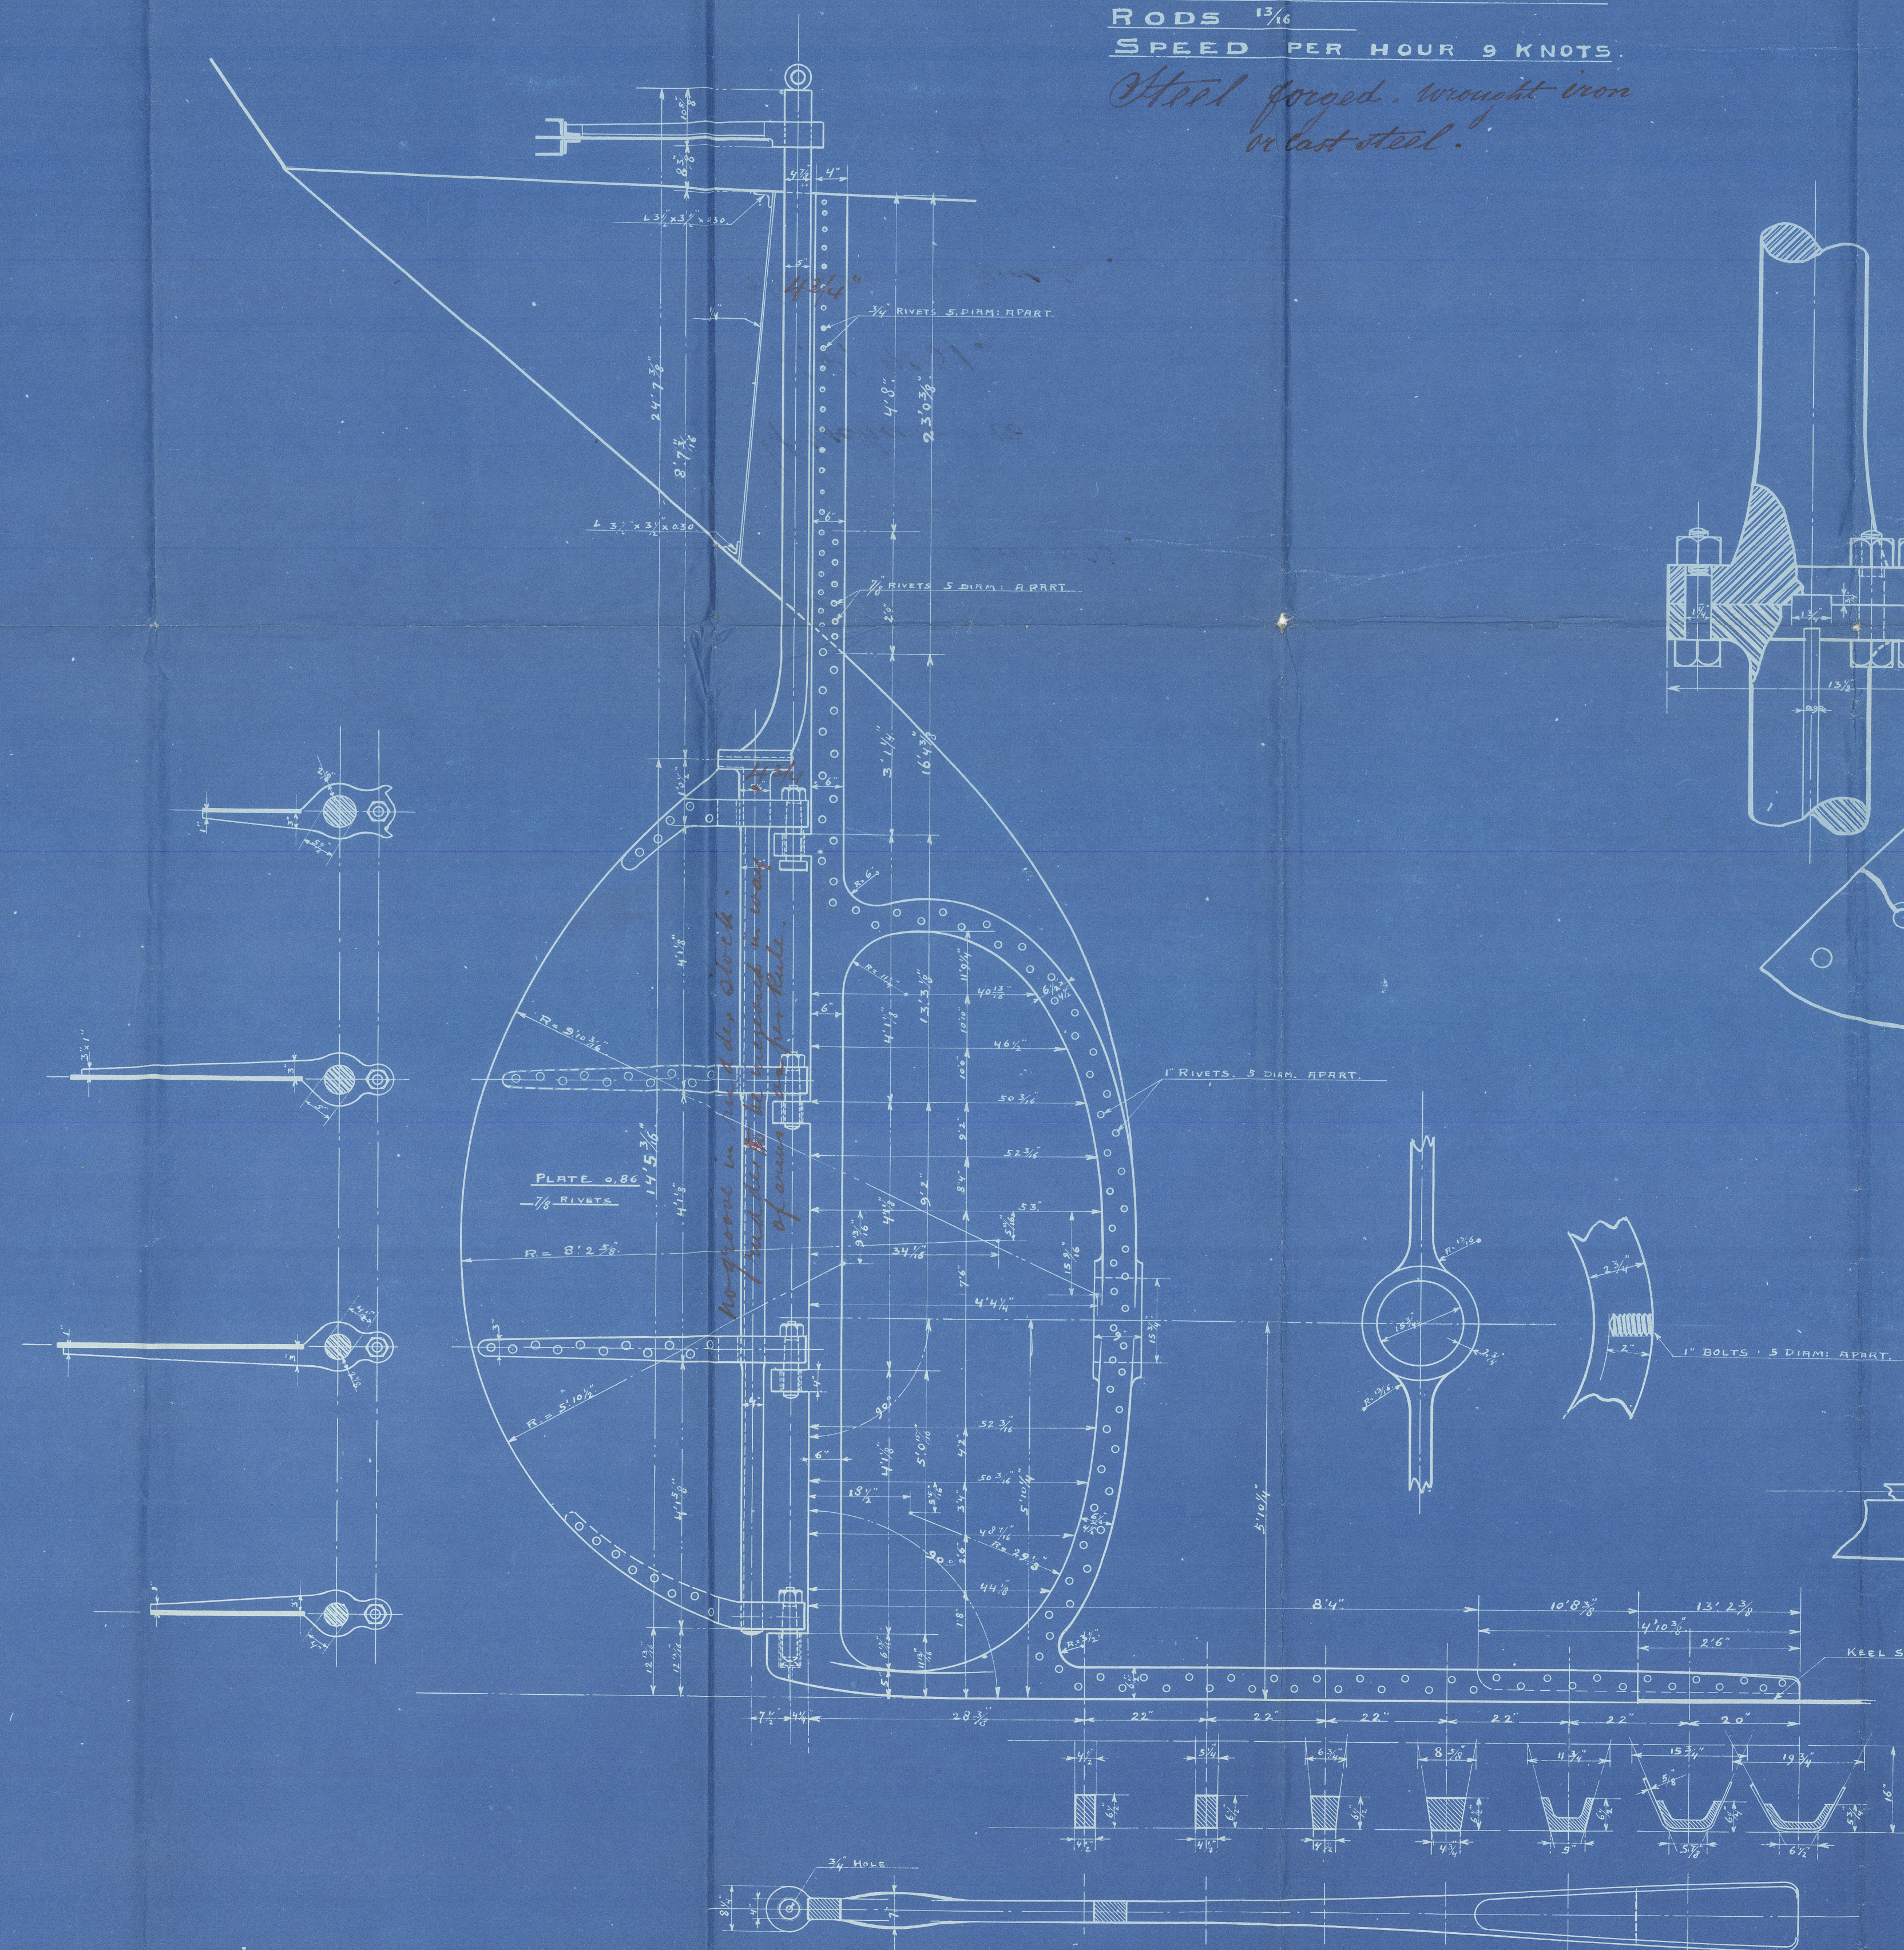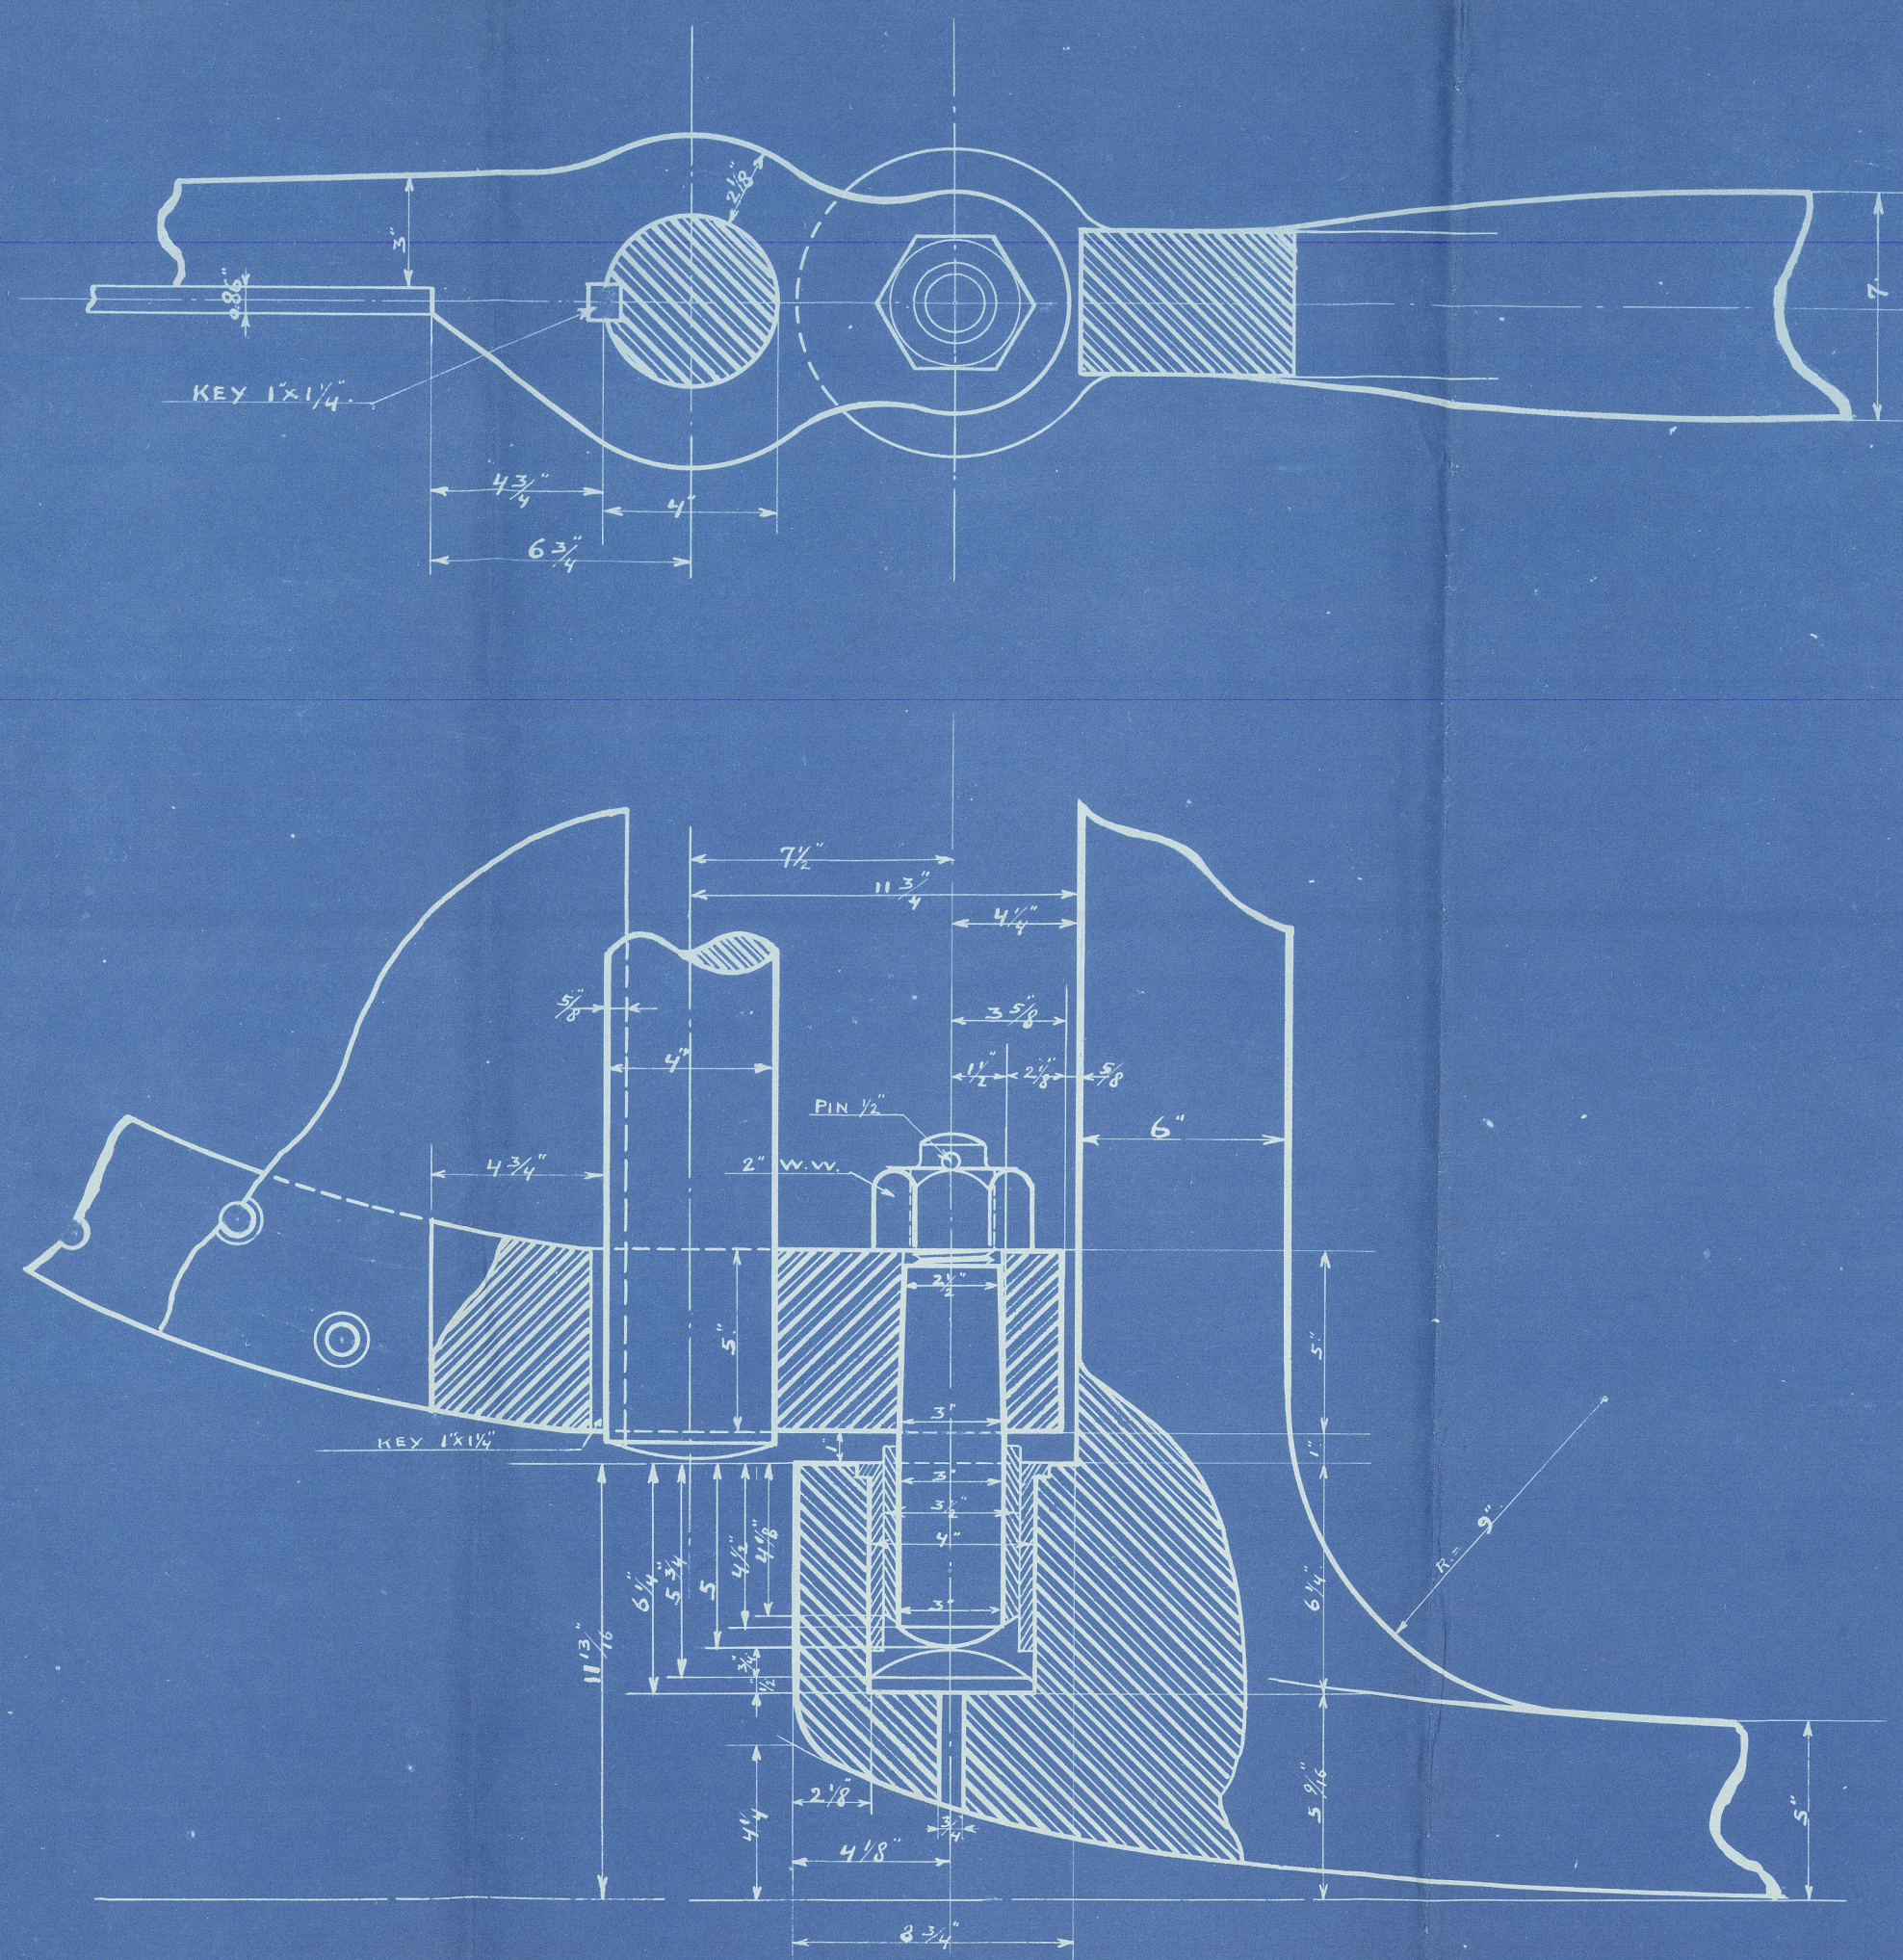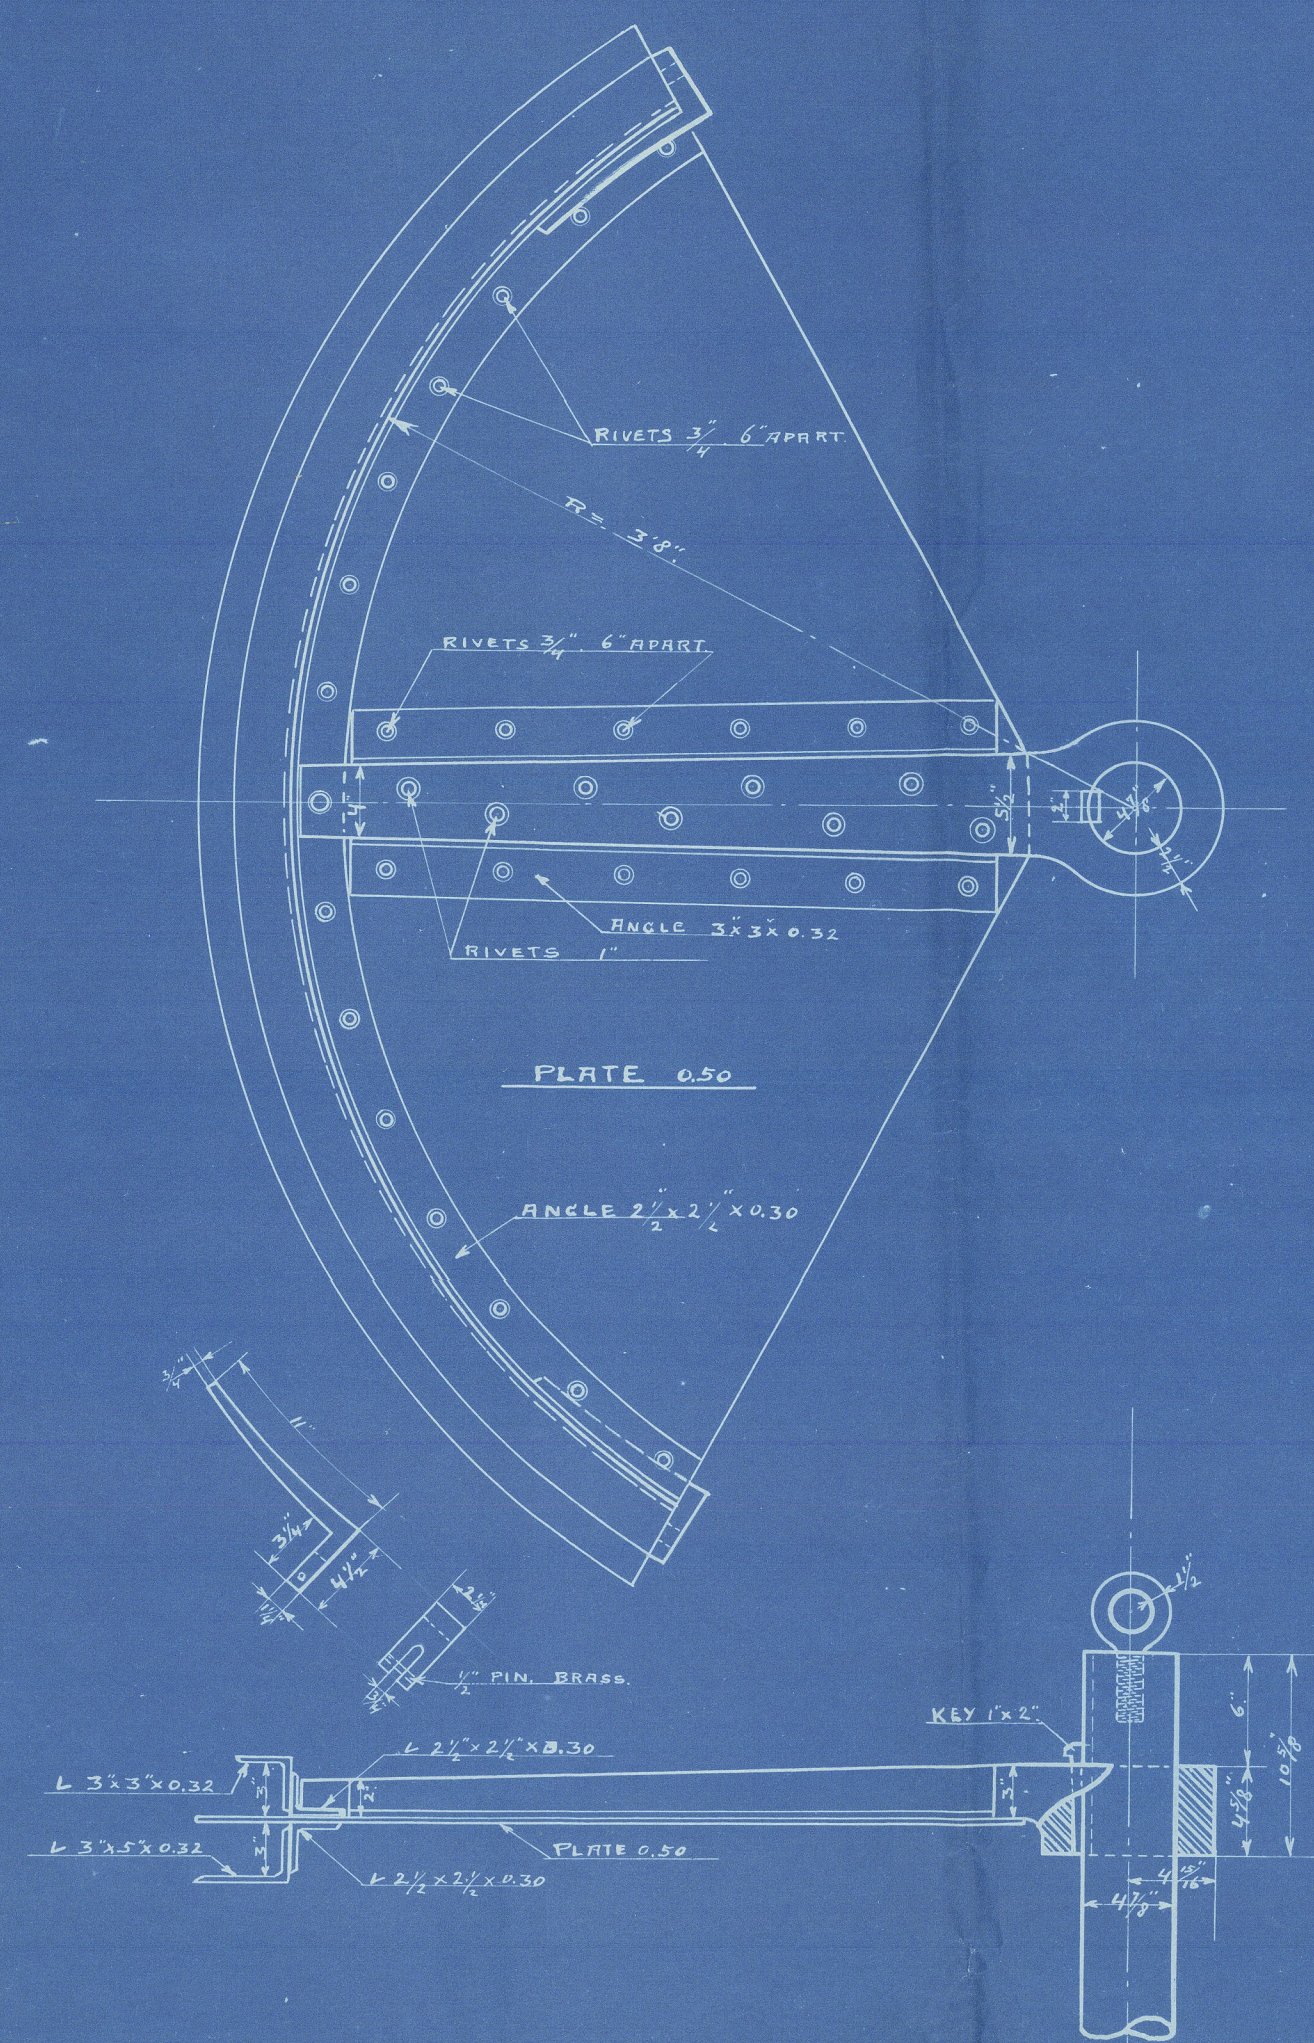

*68/*  
*27.10.15.*



plan N<sup>o</sup> 3.

Verschure & Co

S. G. N<sup>o</sup> 31.

Steenframed Rudder.

S.S. "Herminea".

Amsterdam 7280.



© 2021

Lloyd's Register  
Foundation

010283-010288-0003