
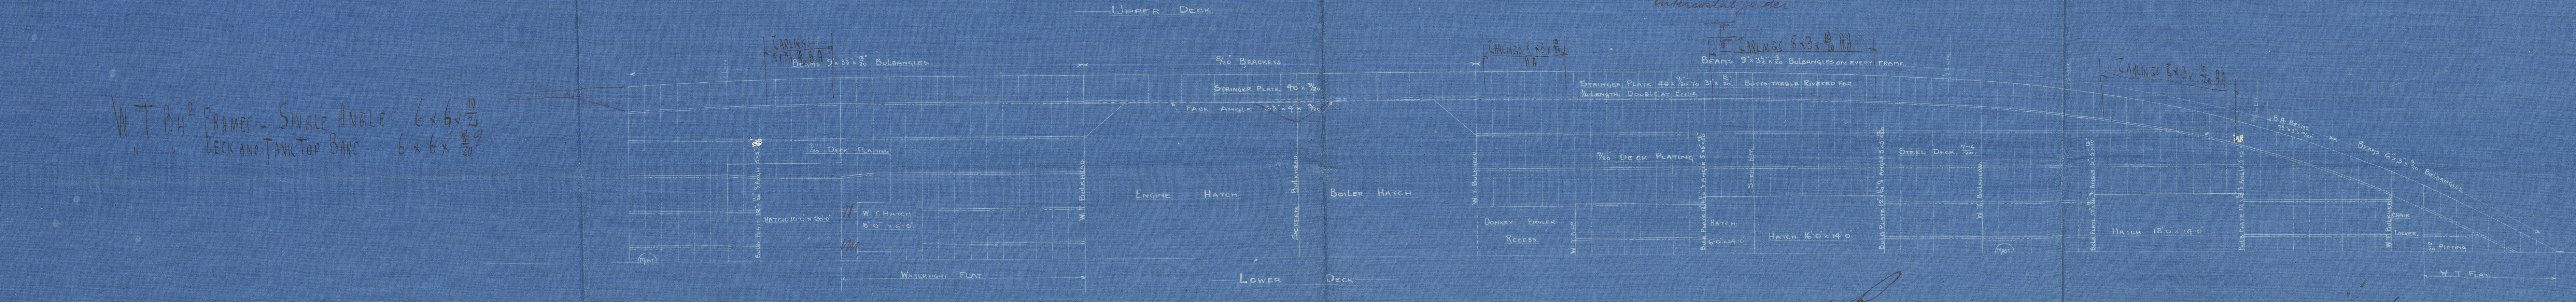
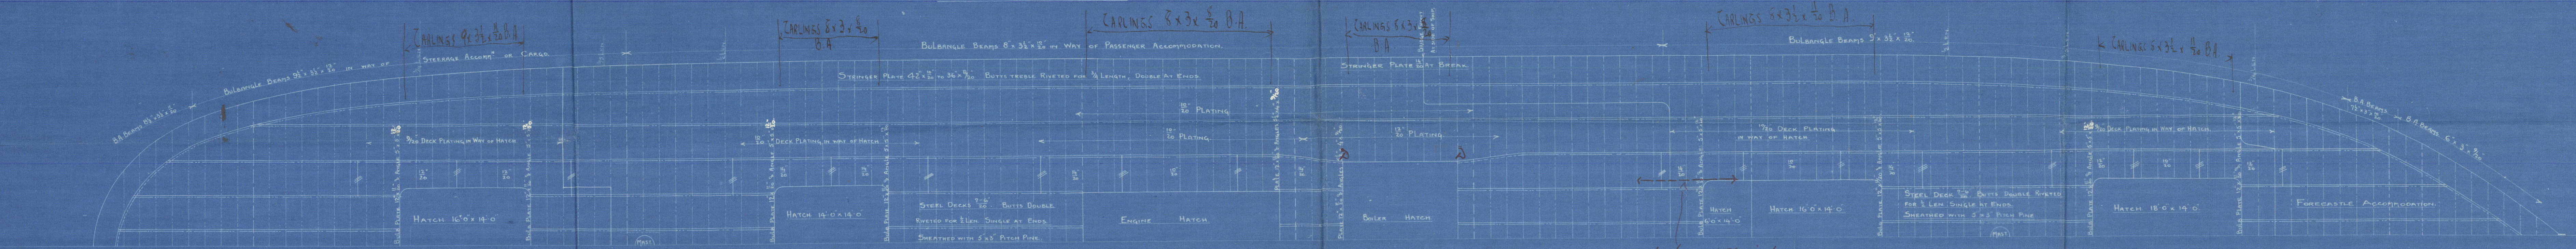
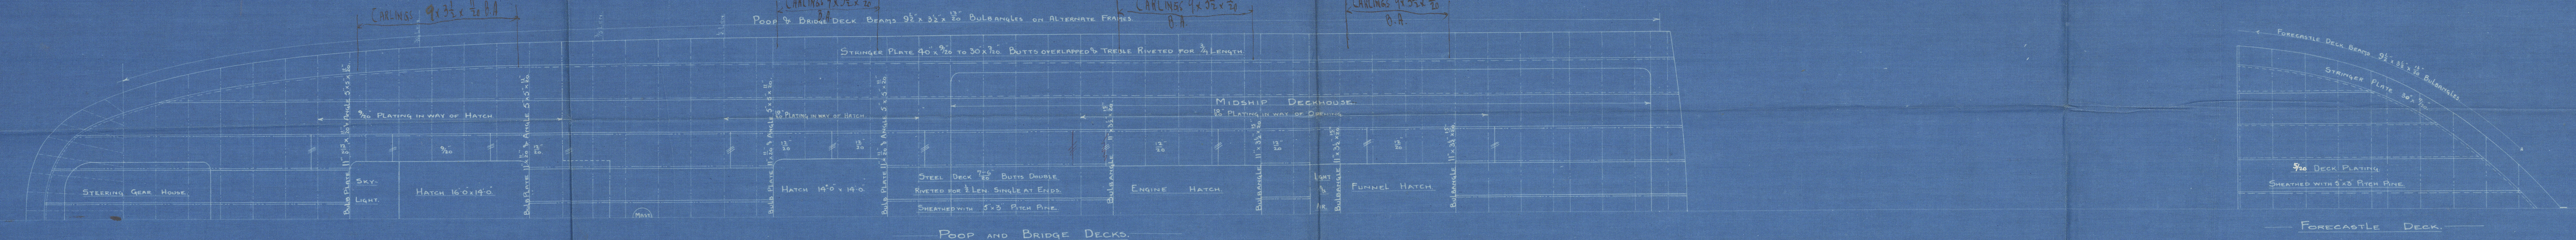
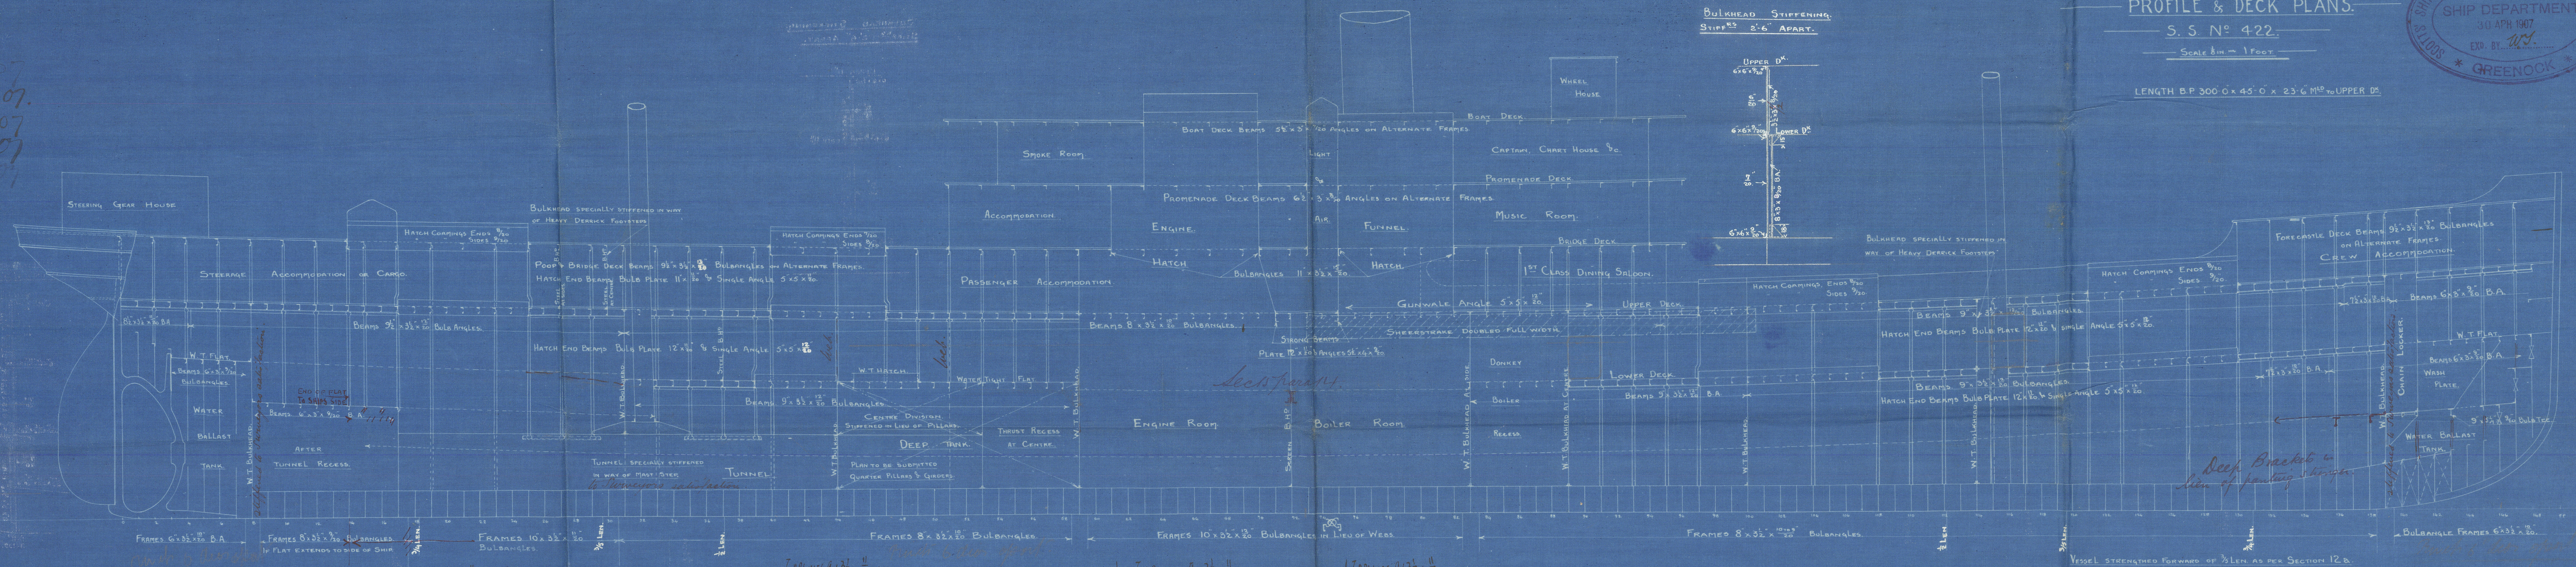
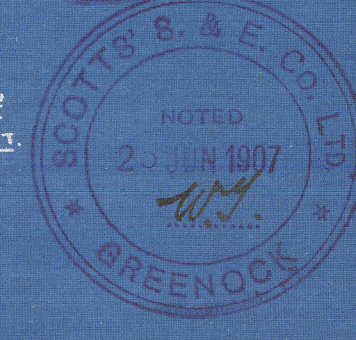
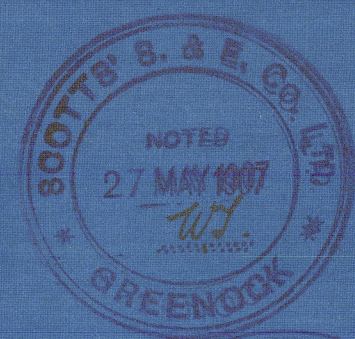


4.5.07
28.5.07
13.6.07
23.7.07
13.8.07

PROFILE & DECK PLANS.
S.S. No. 422

Scale 1/16" = 1 Foot
LENGTH B.P. 300' 0" x 45' 0" x 23' 6" M¹⁰ UPPER DECK

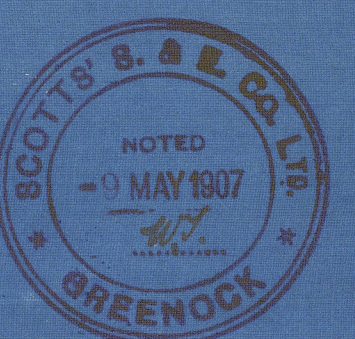

W.T. BH¹⁰ FRAME - SINGLE ANGLE 6x6x¹⁰/₁₆
DECK AND TANK TOP BARS 6x6x⁸/₁₆

C.B.
4.5.07

Profile & S&K Plan
Scott SB & Eng Co
No 422

S.S. Marco
Grk report No 15313

S.S. Tusima Maru.
Grk. 16761.



© 2021

Lloyd's Register
Foundation

010283-010288-0065