


MATERIAL

ALL MATERIAL ON THIS SHEET FABRICATED BY AMER. BRIDGE CO. EXCEPT CHOCK FOUNDATION & CASTINGS.

DIVISION
9TH DIVISION.

MARK	ALTERATIONS	DATE	BY
A	VENT AIR OF 92 CHD	10/18/17	WJS
B	STATIONING AT BULKHEADS MOVED OUT	10/18/17	WJS
C	DETAILS AND DIMENSIONS ADDED BY AMER. BRIDGE CO. FOR FIRST 200' OF BRIDGE	10/18/17	WJS
D	WHICH FOUND ADDED TOW IN BULKHEADS	10/18/17	WJS
E	LOCATION & SIZE OF DOOR 7' FROM BULKHEAD IN BULKHEAD	10/18/17	WJS
F	CANCEL LINE 17-12-13 CODE LINE MARK 104-110 ADD NOTE FOR CHOK FOUND.	10/18/17	WJS
G	MARKS BY AMER. BRIDGE CO.	10/18/17	WJS
	PORT LIGHT TO BE MARKED BY AMER. BRIDGE CO. FOR FIRST 200' OF BRIDGE	10/18/17	WJS
	CHOCK MOVED & NOTE ADDED	10/18/17	WJS

NOTE: THIS DRAWING IS AN EXACT REPRODUCTION OF 11-0-9 ISSUED 10/17/17

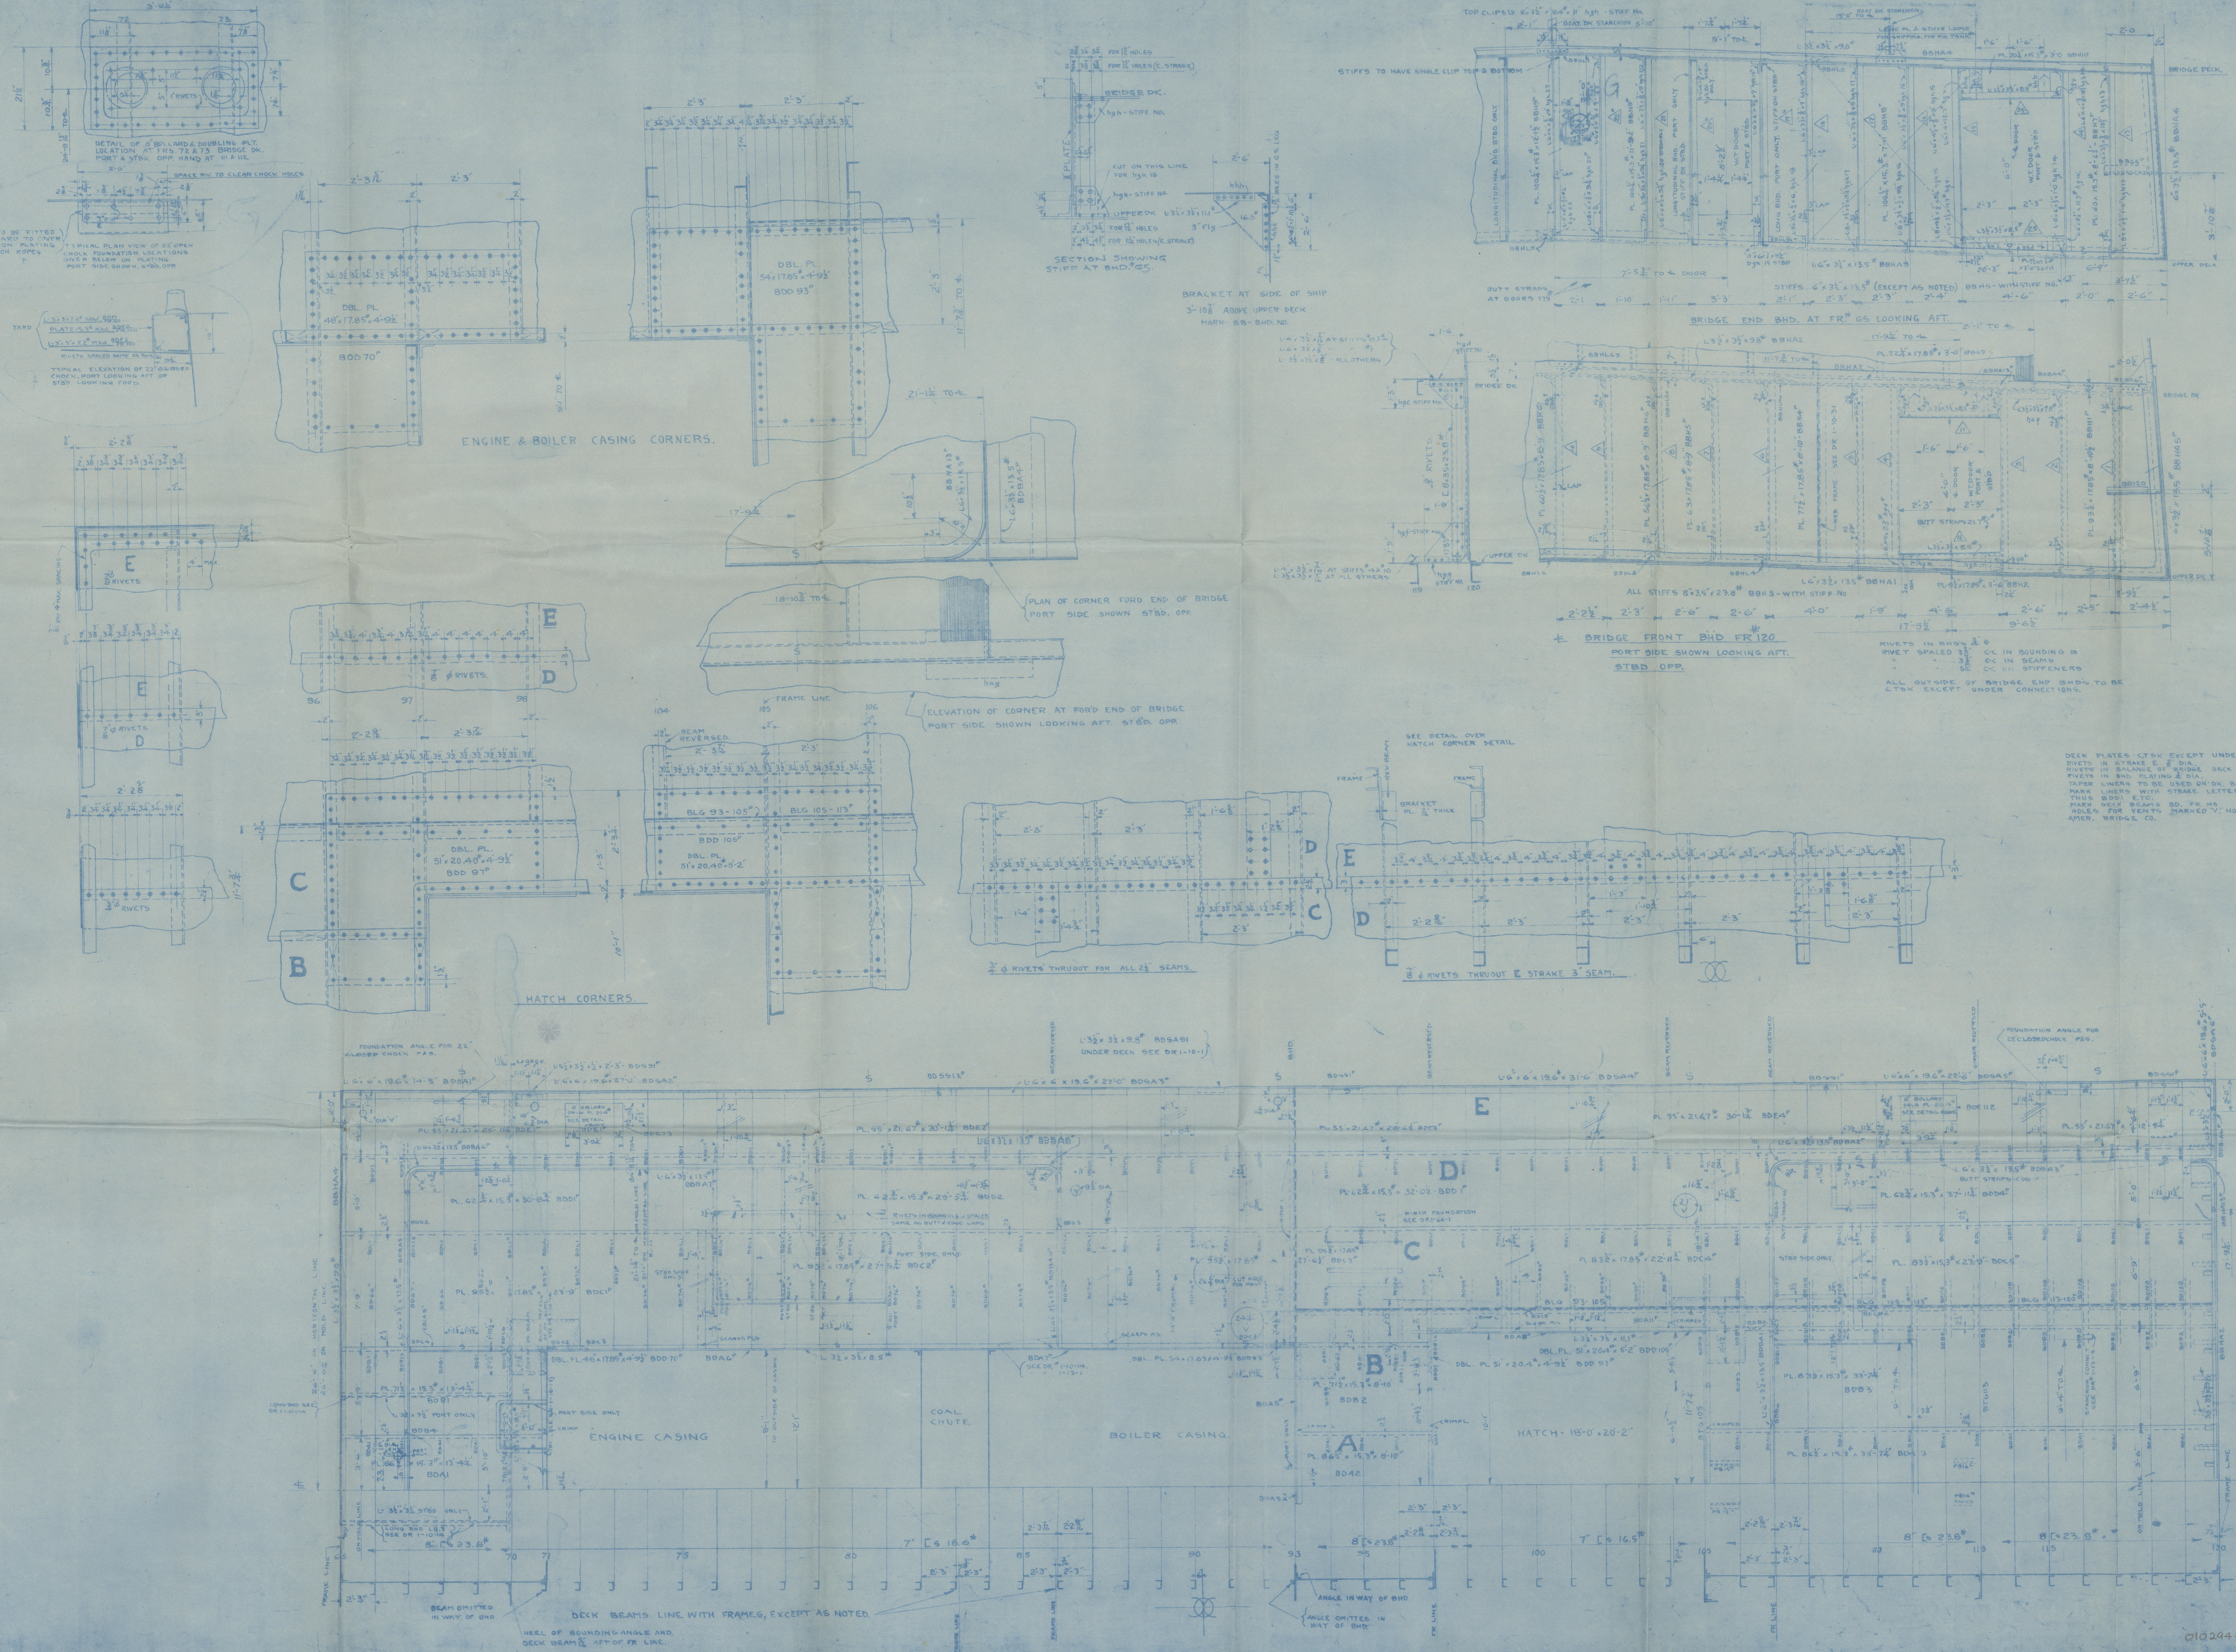

APPROVED
25-1-1921

FOR CONTRACTS

UNITED STATES SHIPPING BOARD
EMERGENCY PLANING BOARD

BRIDGE DECK AND
BRIDGE END BULKHEADS

SCALE 1/2" = 1'-0"

DATE JAN. 15, 1921

WJS RVT

DR NO. 10-0-9

Monfalcone N^o 111-116

Plan of Bridge Deck and Bridge End Bulkheads

N^o 111. - S.S. Lucia^{*}; Tri. Rep 5362
N^o 116. - S.S. "Laura"; Tri. Rep 5963



© 2021

Lloyd's Register
Foundation

010294-010299-0199