


# VNOS 129 PROFILE & DECK PLAN

Scale 4 1/2 inch = 1 foot  
DIMS 92'0" B.P. x 25'0" x 13'6" M.P.

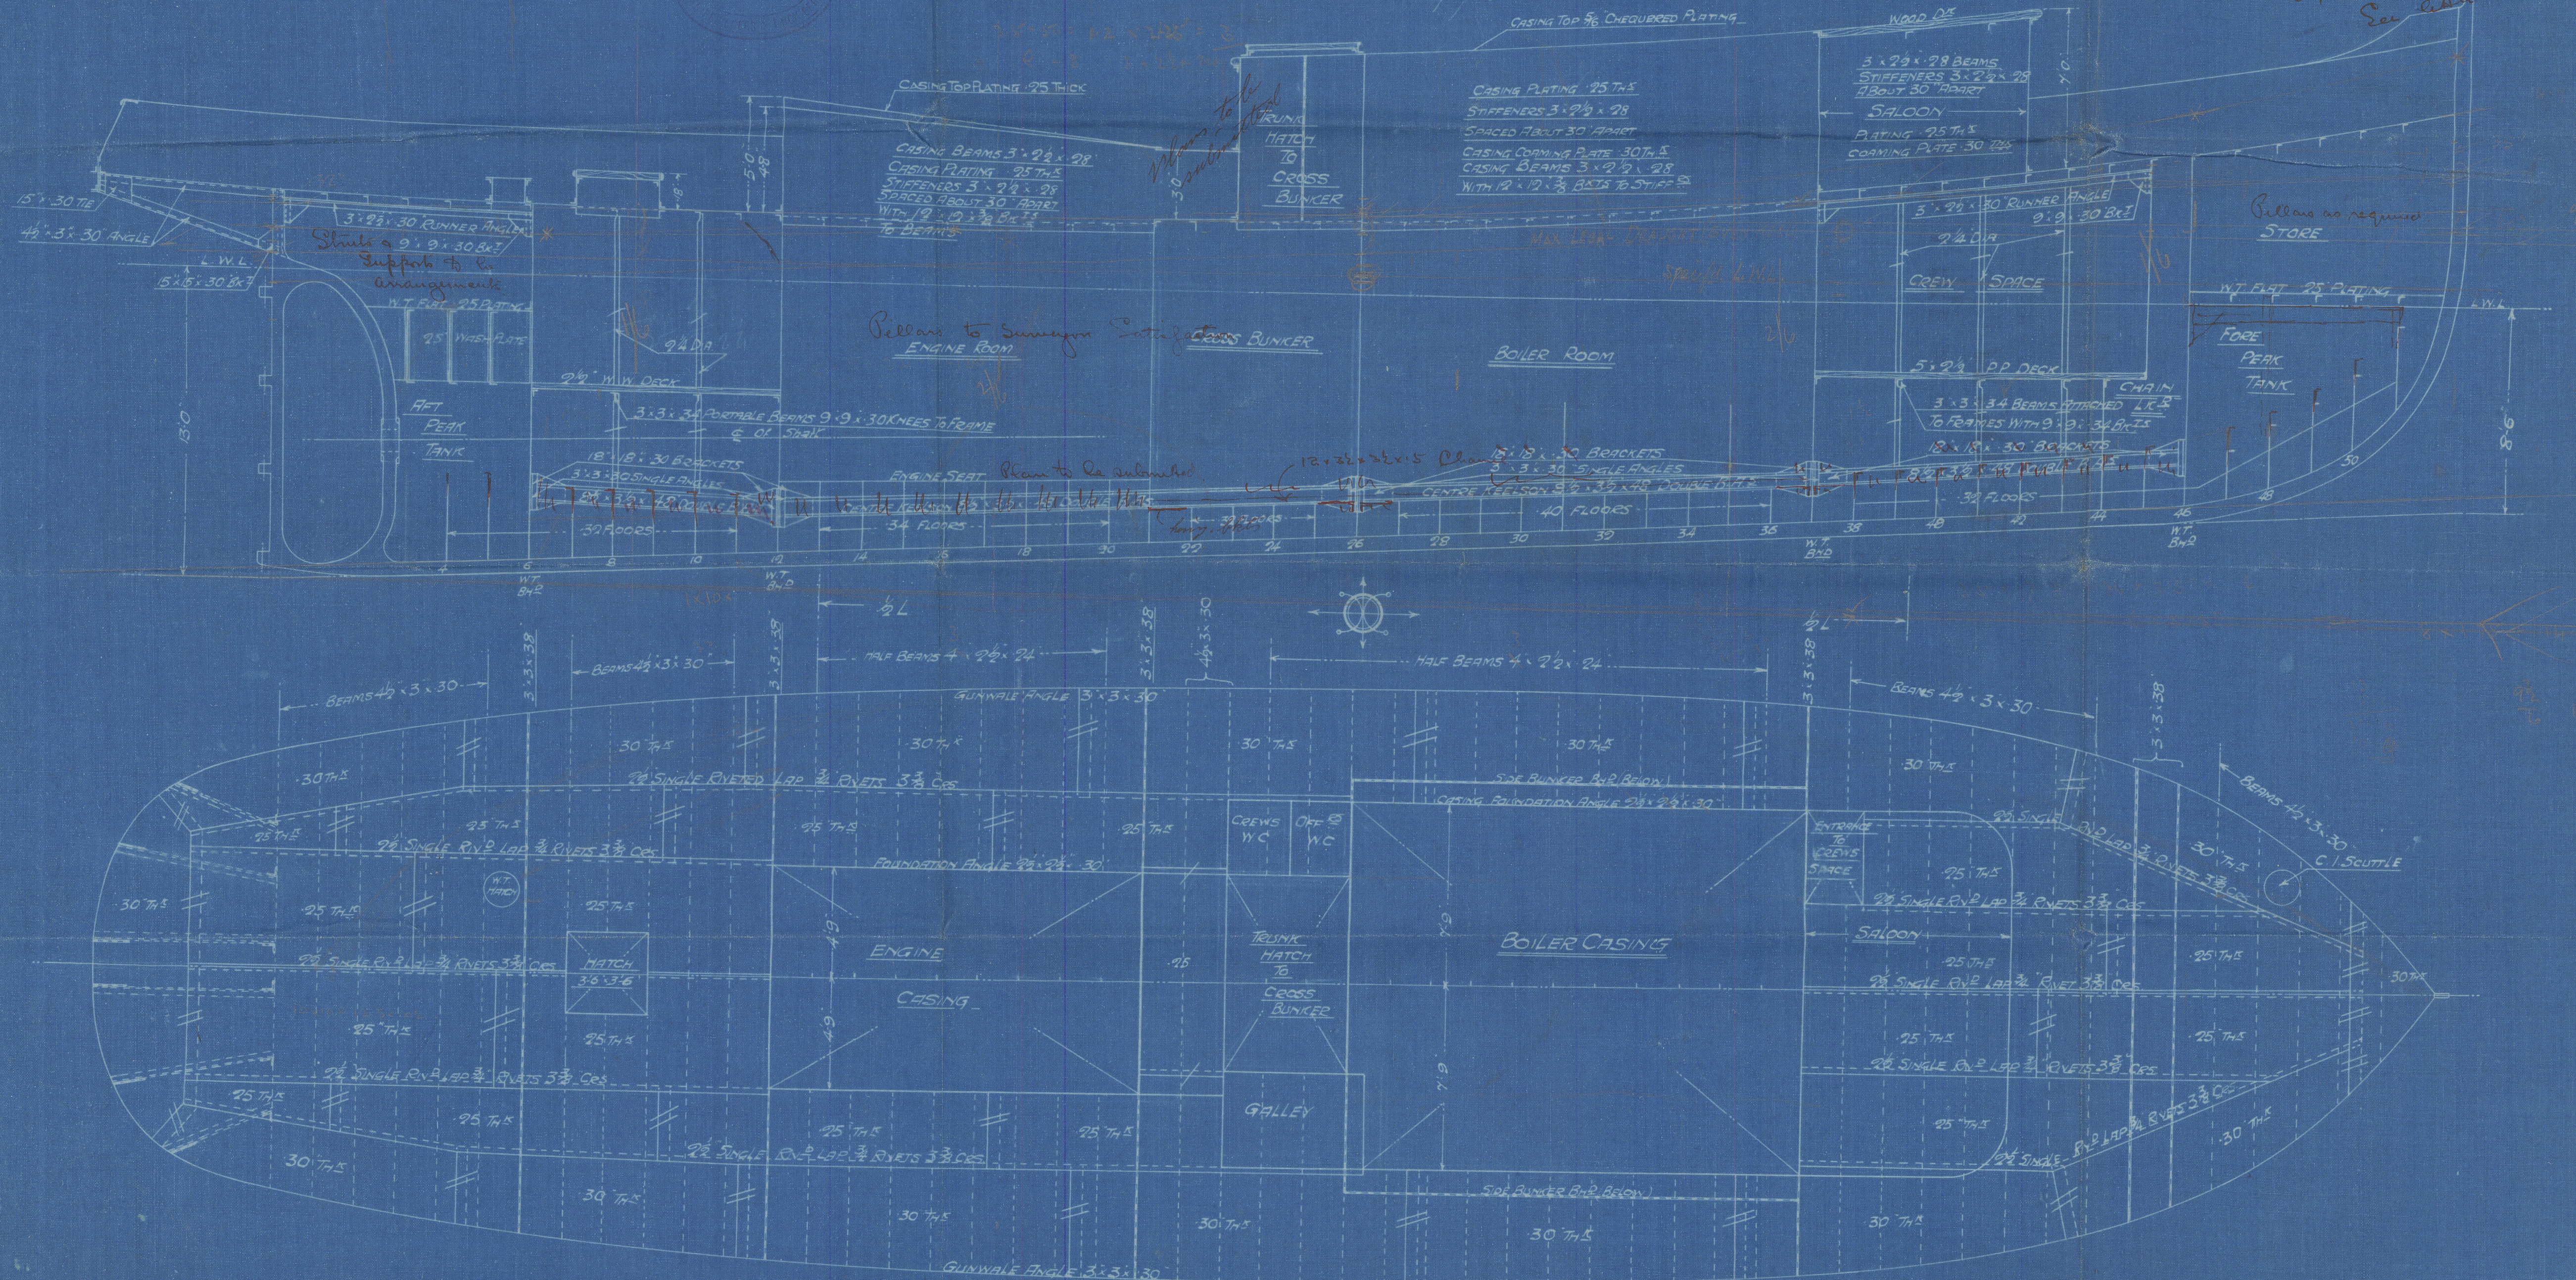

24 OCT 1921





Cran + Somerville

129.

Profile + decks

Bag

010300-010308-0085

TC 23-11-71

Cran + Somerville L<sup>o</sup>

129

Profile + Decks

92 x 25 x 13'6

27-10-71.

SS  
BRAMLEY  
2  
MOORE  
2021  
Library Register  
Foundation