

PRINCIPAL DIMENSIONS.

LENGTH BETWEEN P.P. 128'000 (419.94')

BREADTH MOULDED 17'300 (52.72')

DEPTH 9'800 (32.15')

DRAFT 7'818 (23.85')

TWEEN DECK HEIGHT 3'500 (AT C)

2ND D^m & UPPER DECK 3'300 (AT SIDE)

UPPER DECK & BRIDGE DECK 2'450

BRIDGE DECK & BOAT DECK 2'400

BOAT DECK & NAVIGATION BRIDGE DECK 2'400

NAVI. BRIDGE DECK & COMPASS BRIDGE DECK 2'300

CLASS

LLOYD 100A1 LMC

NIPPON KAIJI KYOKAI NS * MNS*

MIDSHIP FRAME SPACE 8'50" (33.33")

EQUIPMENT NUMERAL

	BY L.R.	BY N.K.
TONNAGE UNDER FREE BOARD DK	37366.3	3471.4
POOP	151.4	14.1
BRIDGE	992.1	92.1
FORECASTLE	176.3	17.4
DECK HOUSE ON BRIDGE DECK	274.3	25.5
" ON BOAT DECK	120.8	25.1
EQUIPMENT TONNAGE	39081.2	3445.6

EQUIPMENT


ITEMS	BY L.R.	BY N.K.	ACTUAL
BOWER ANCHORS (STOCKLESS)	2 68 (3454.4 ^{kg})	2 3455 ^{kg}	2 3460 ^{kg}
SPARE BOWER ANCHOR (")	1 58.5 (2921.8 ^{kg})	1 2970 ^{kg}	1 3100 ^{kg}
STREAM ANCHOR (EX-STOCK)	1 19 (952.2 ^{kg})	1 965 ^{kg}	1 966 ^{kg}
ANCHOR CABLE STUDBAIN	2 7/8 270 (499.1 ^M)	58 ^{kg} 500 ^M	(CAST STEEL) 50 ^{kg} 500 ^M
STEEL WIRE (6 x 12)	5" 90 ^{kg} (164.7 ^M)	40 ^{kg} 175 ^M	40 ^{kg} 175 ^M
TOWLINE (STEELWIRE) (6 x 24)	4 3/4 170 (219.6 ^M)	38 ^{kg} 220 ^M	38 ^{kg} 220 ^M
HAWSER (MANILA)	2 8" 90 ^{kg} (164.7 ^M)	2 15 ^{kg} 165 ^M	2 15 ^{kg} 165 ^M
WARDS (")	2 7" 90 ^{kg} (164.7 ^M)	2 16 ^{kg} 165 ^M	2 16 ^{kg} 165 ^M

NOTES

ENGINE 1 SET OF DOUBLE REDUCTION GEARED TURBIN 4500 SHP.

BOILER 2 SET OF WATER TUBE BOILER.

DECKS & SHELL PLATING BUTTS WELDED.

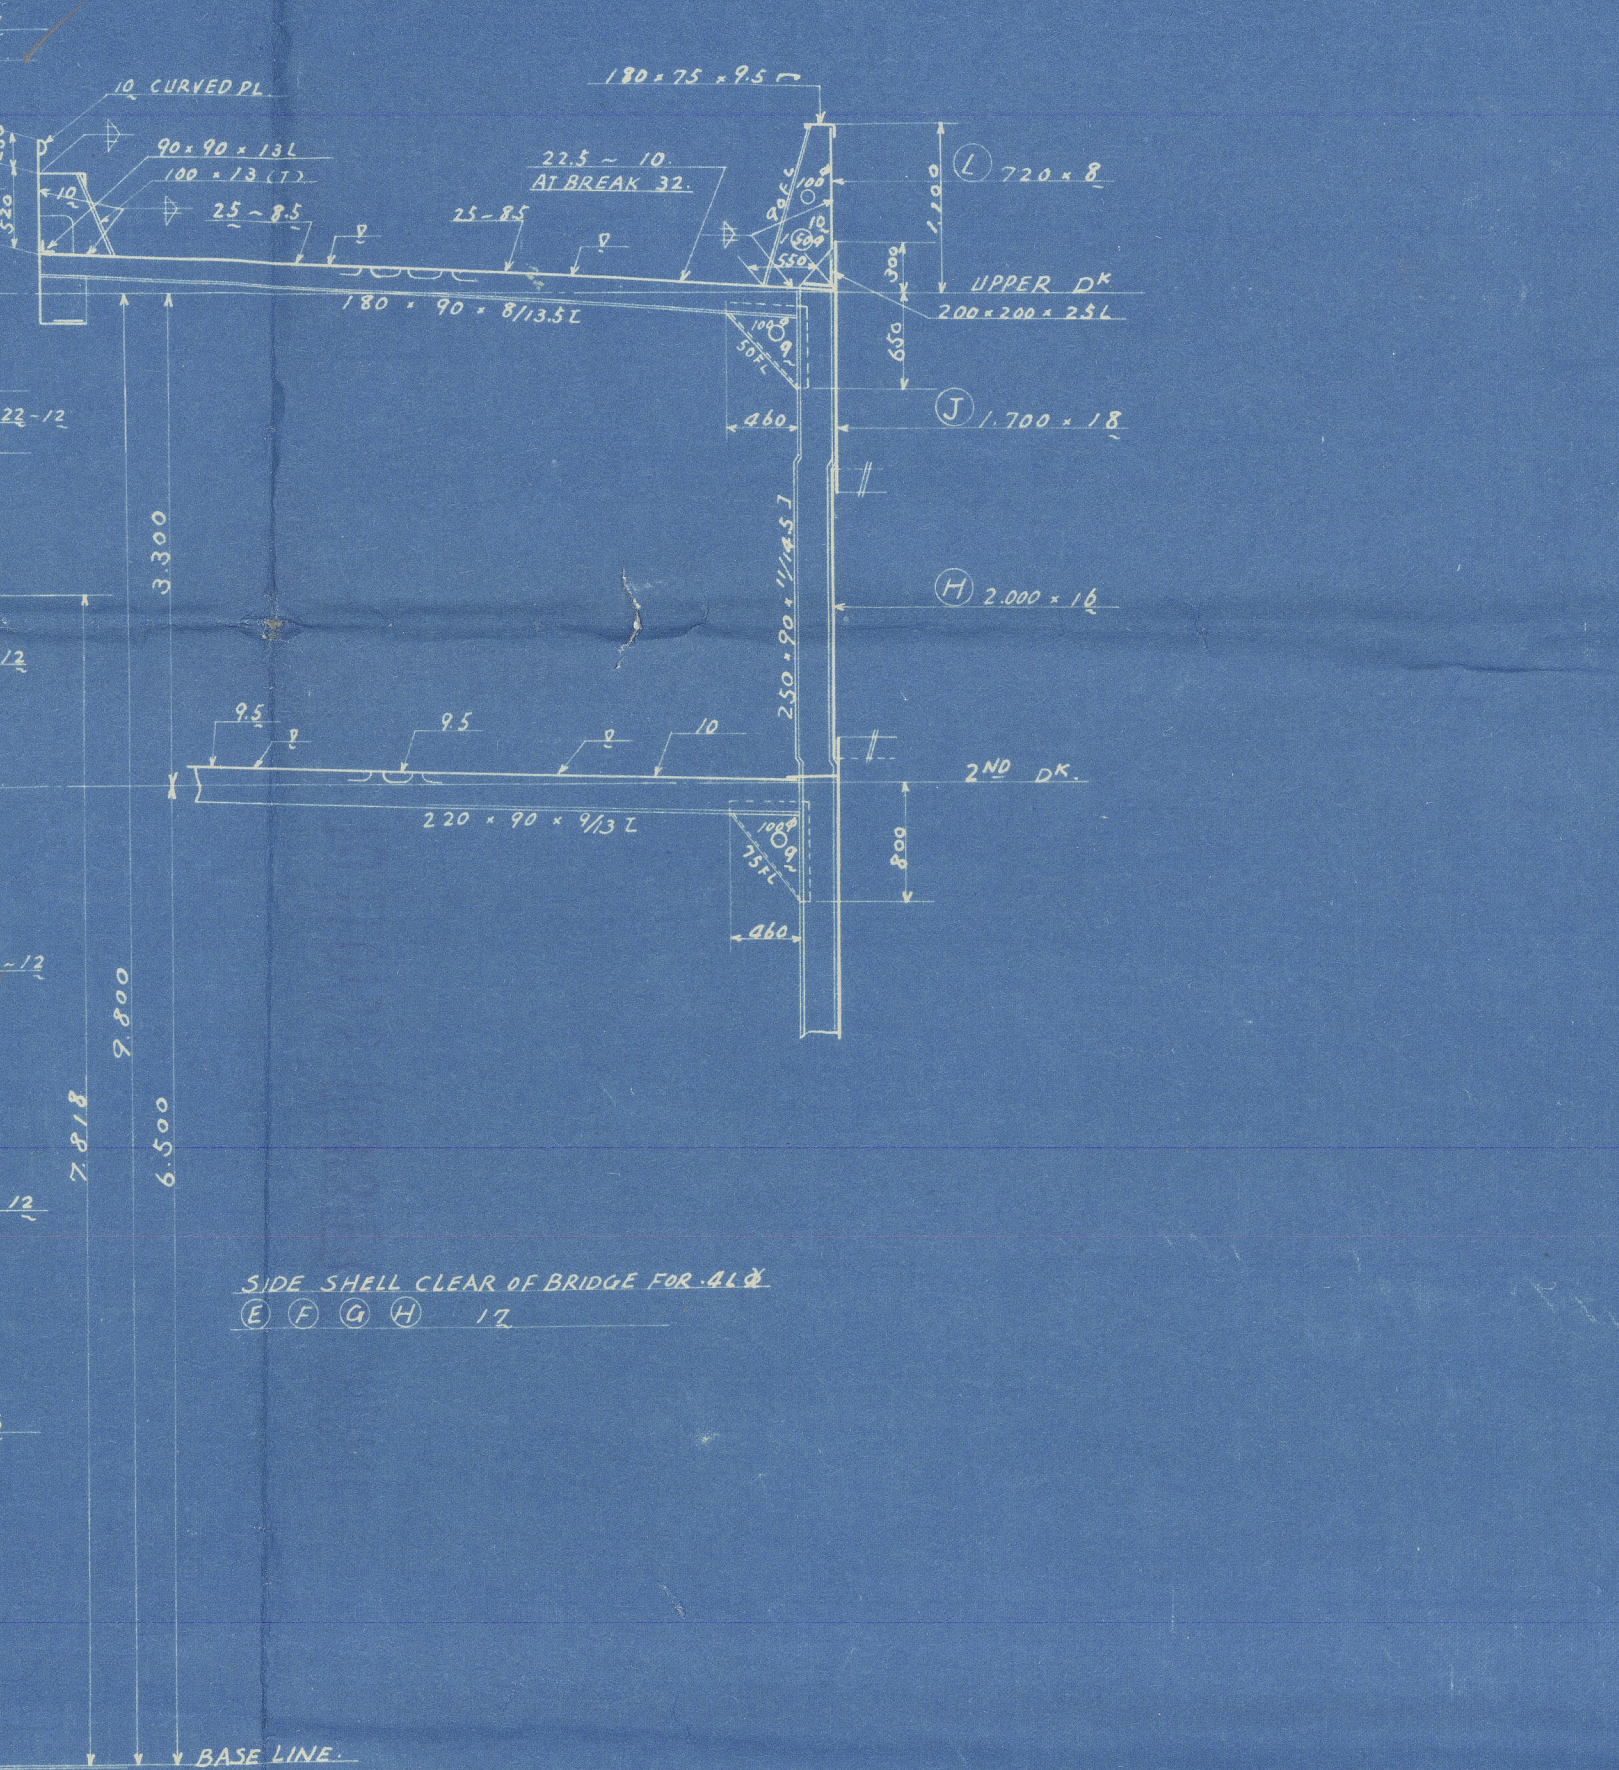

SHELL PLATING

ITEMS	4100	4100	AFT	FOR P	REMARKS
FLAT PLATE KEEL (R)	21	21	21	21	
BOTTOM PLATE (A) (B) (C)	16	17	15-12	18	BOTTOM FORG WHERE F.S. = 850 19 ^{kg}
BIDGE PL.	17	17	16-12	16-12	
SIDE PL. (E) (F) (G) (H)	16	17	15-12	15-12	
SHEER STRAKE (UP D ^m)	22		18-12	18-12	IN WAY OF BRIDGE 16 AT BREAKS 32
" (BRIDGE D ^m)	17				20.5
BRIDGE SIDE PL.	16				20.5
POOP SIDE PL. (I) (J)			9.5		
FOLE SIDE PL. (L) (M)				10.5	
BASS & HEEL PL. (N) (O) (P)			17		

BUTTS OF SHELL PLATE TO BE WELDED.

日豊丸

中央切斷

尺度 1/50

27-2-20

A-9

FINISHED PLAN

SHIP NO. NIPPON MARU

TITLE MIDSHIP SECTION

SCALE 1/50

DESIGNED BY M. Yoshizawa

SHIPDESIGNING DEPARTMENT

DEPARTMENT OF DEPARTMENT

SECTION

DESIGNED BY M. Yoshizawa

DESIGNED BY S. Shimada

DRAWN BY

DATE

DRAWING NO. A-9

TO LLOYDS REGISTER OF SHIPPING

RECORDS DEPT.
LONDON

3

NIPPON MARU★

MIDSHIP SECTION
As filed

6/3/82

010300-010300-003000



Register
Foundation