


14 NOV 1944

FOR GENERAL DETAILS SEE GENERAL ARRANGEMENT
OF 5435 DR. NO 4321

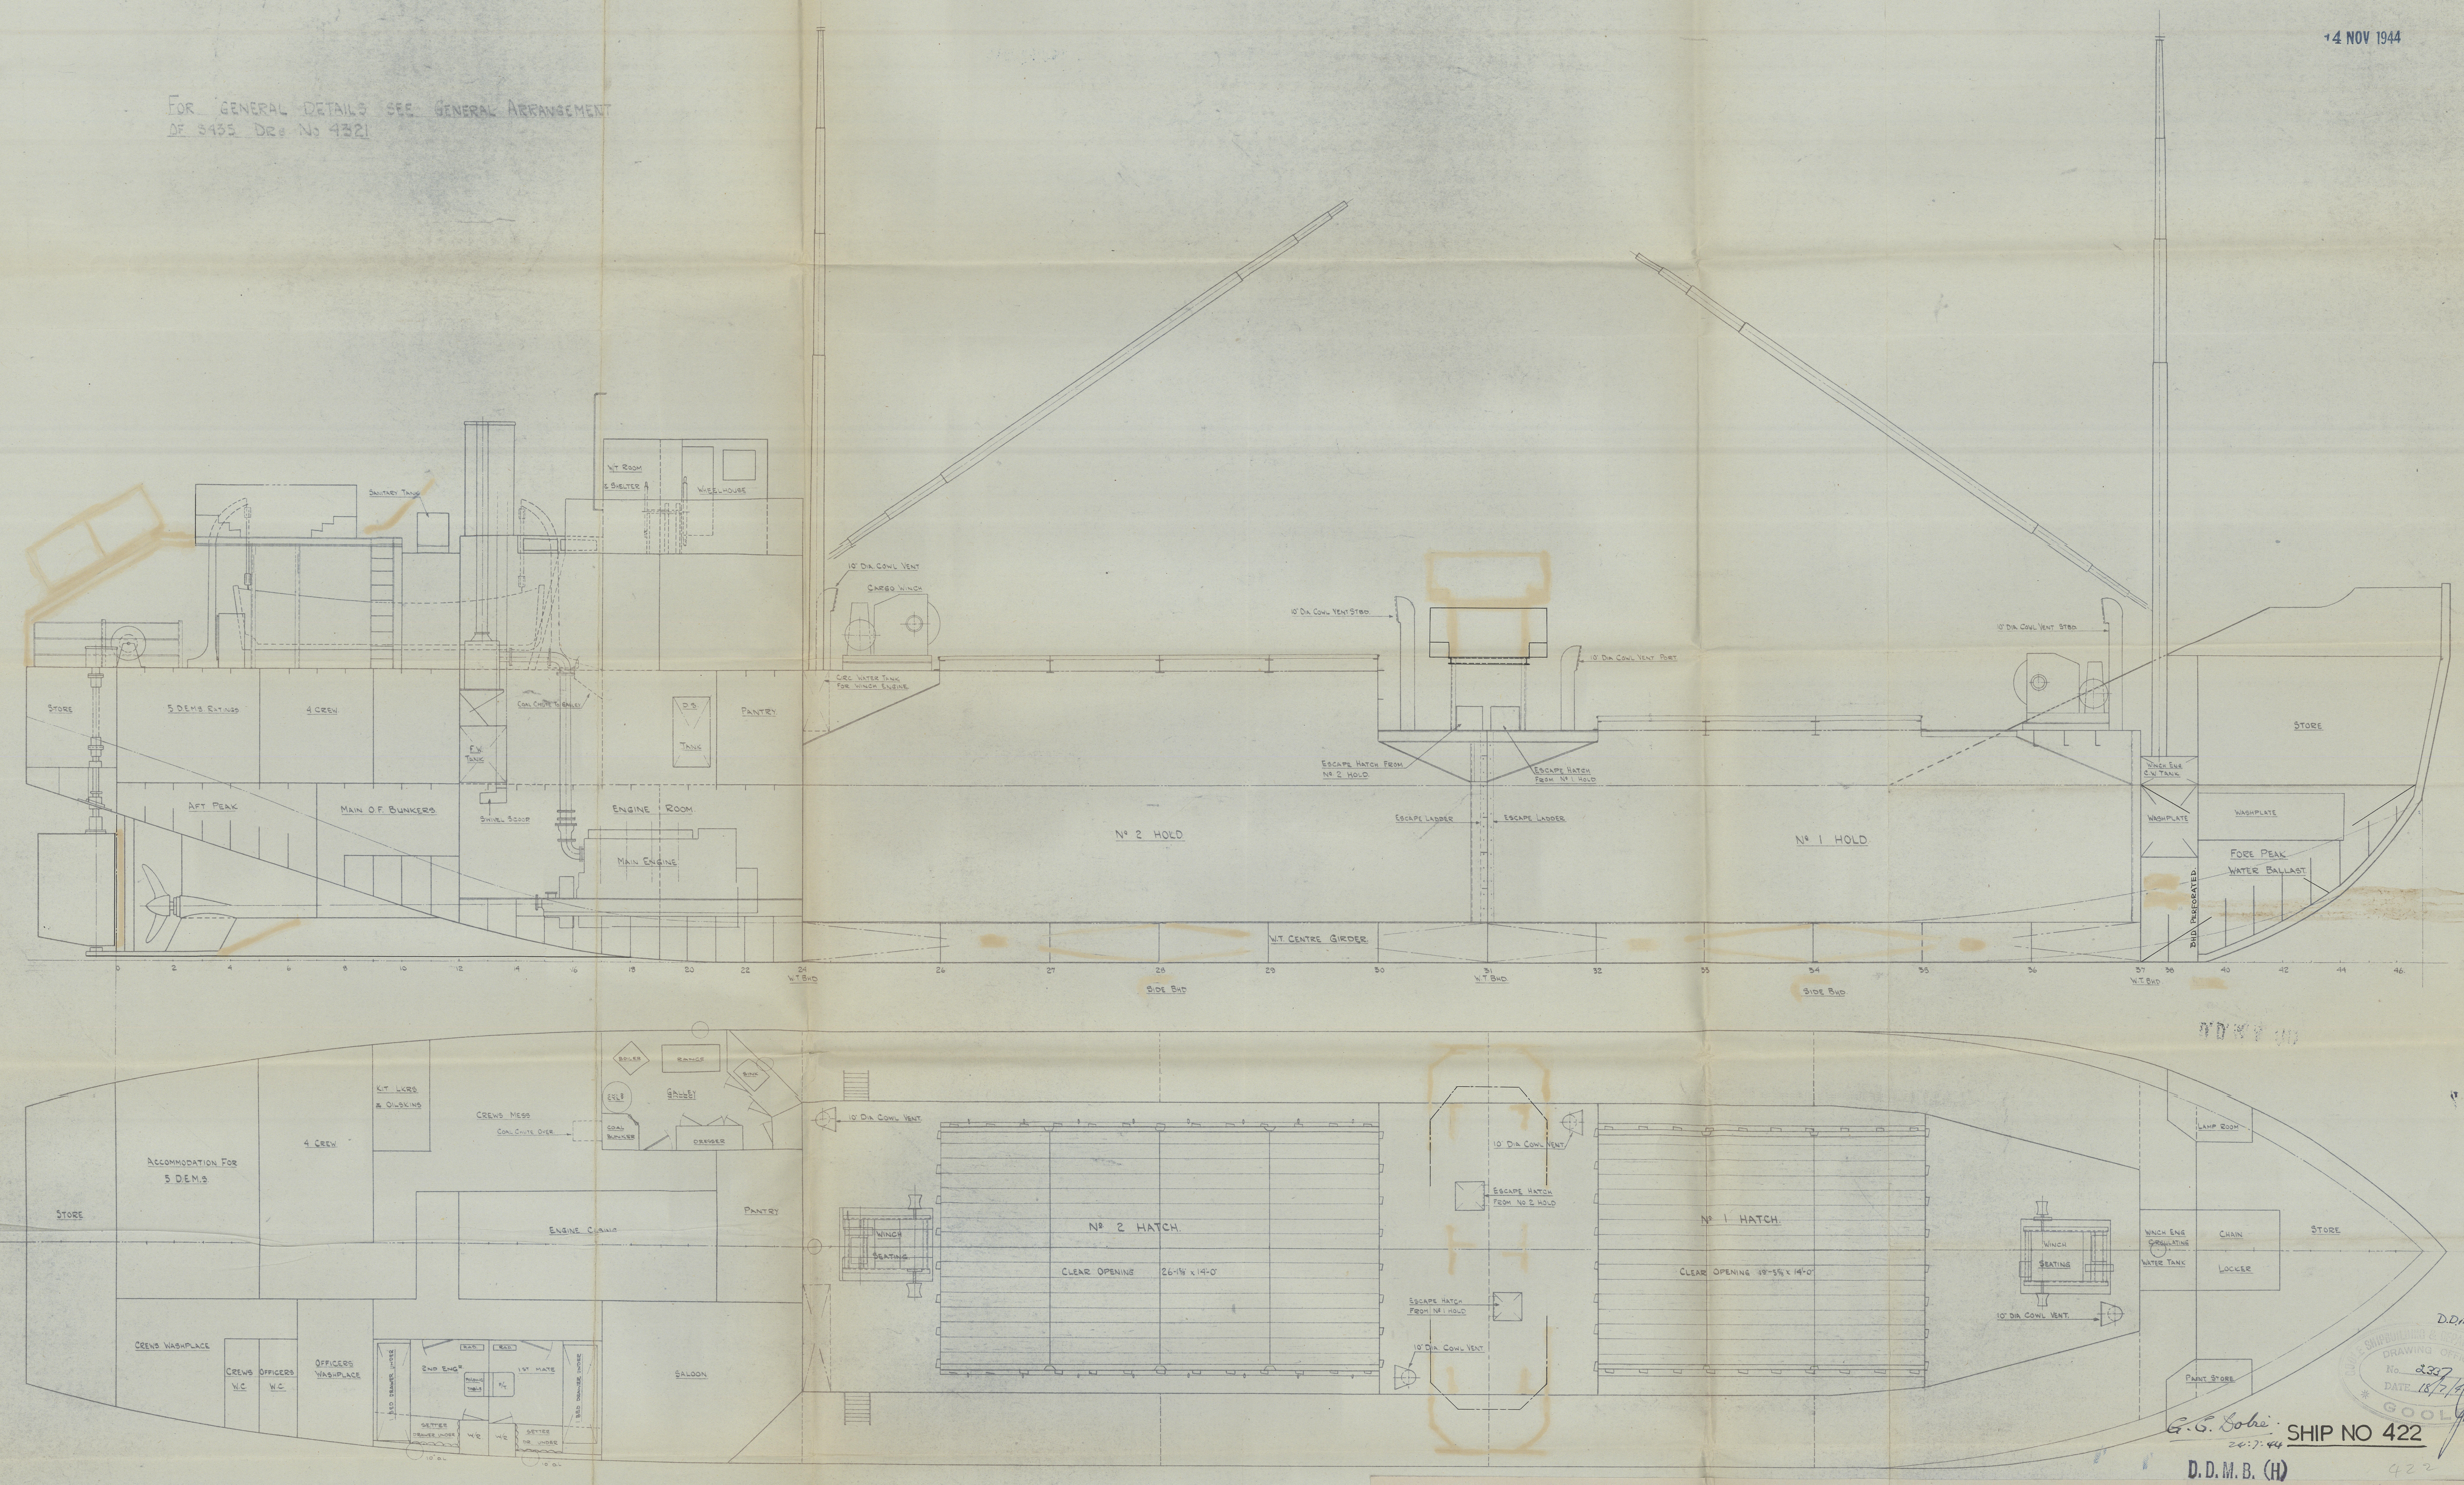

GOOLE SHIPBUILDING & REPAIRING CO. LTD.

GOOLE. YORKSHIRE.

DRY CARGO CARRIERS.
YARD Nos. 417/424 & 430/434.

GENERAL ARRANGEMENT.

SCALE: 1/4" = TO ONE FOOT

D.D.M.B.
DRAWING OFFICE
No. 2327
DATE 15/7/44
GOOLE

G.C. Sobri: SHIP NO 422
24.7.44
D.D.M.B. (H)

Comptrolle

1

General Dirg
Goole So R po

Nº 422

✓

EMPIRE FANE ^{now} FLUIDITY.

14 NOV 1944



© 2021

Lloyd's Register
Foundation

010309-010316-0179