
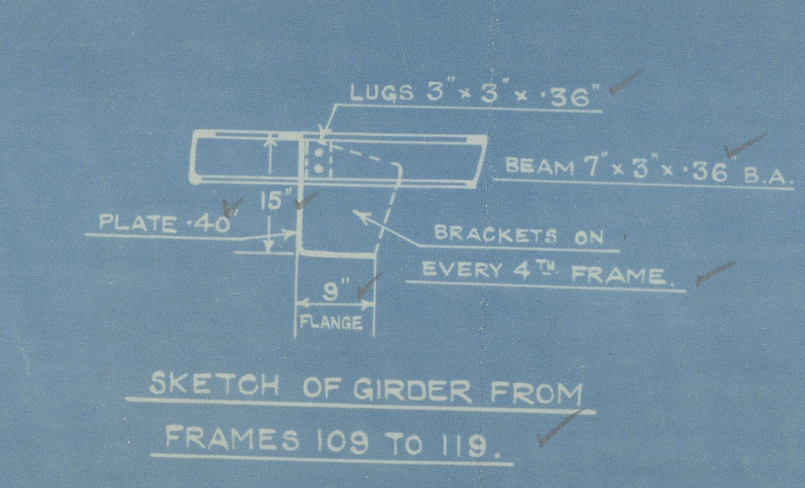
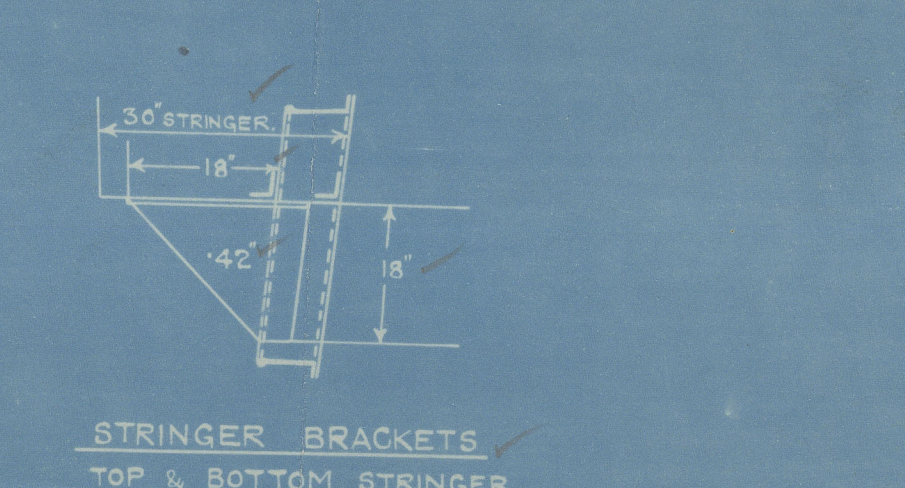
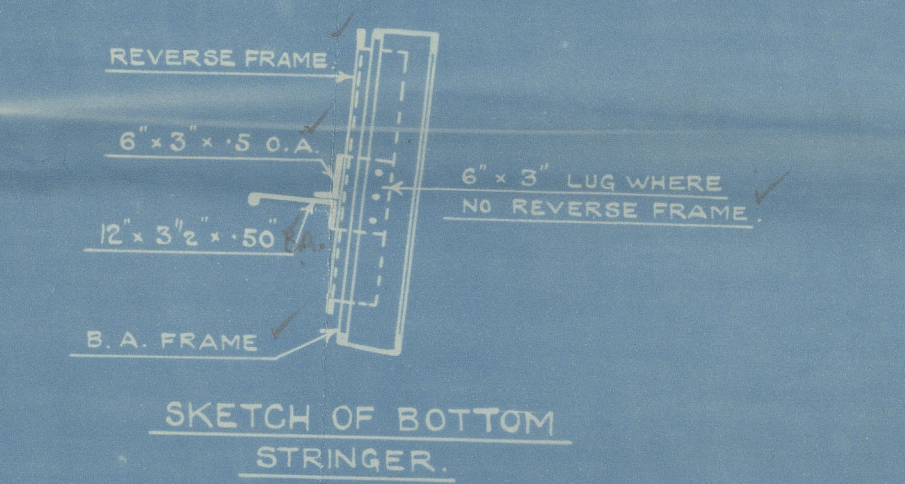
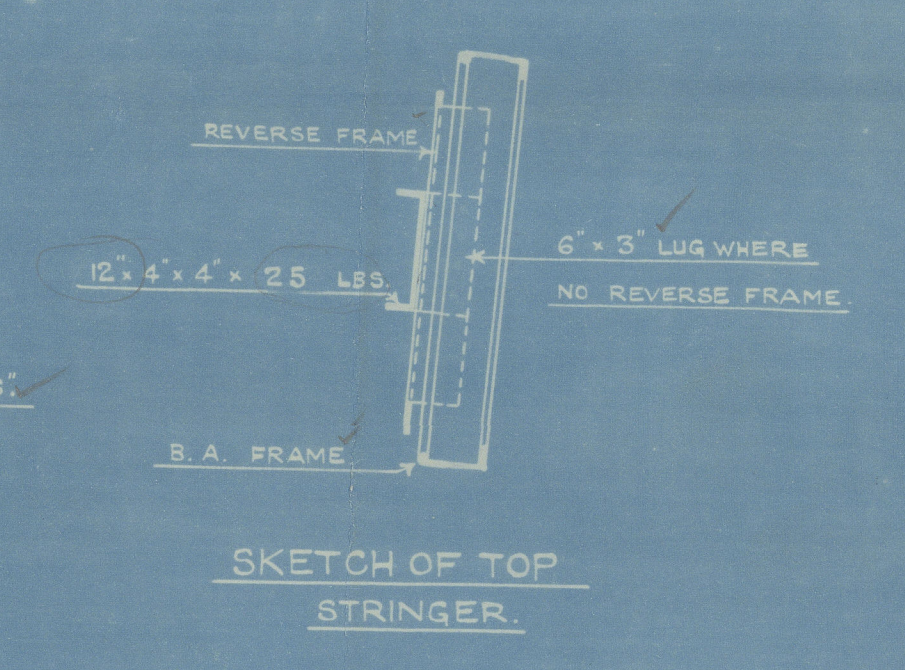
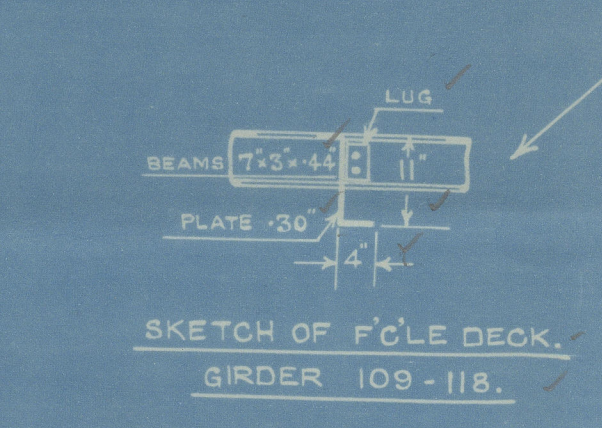
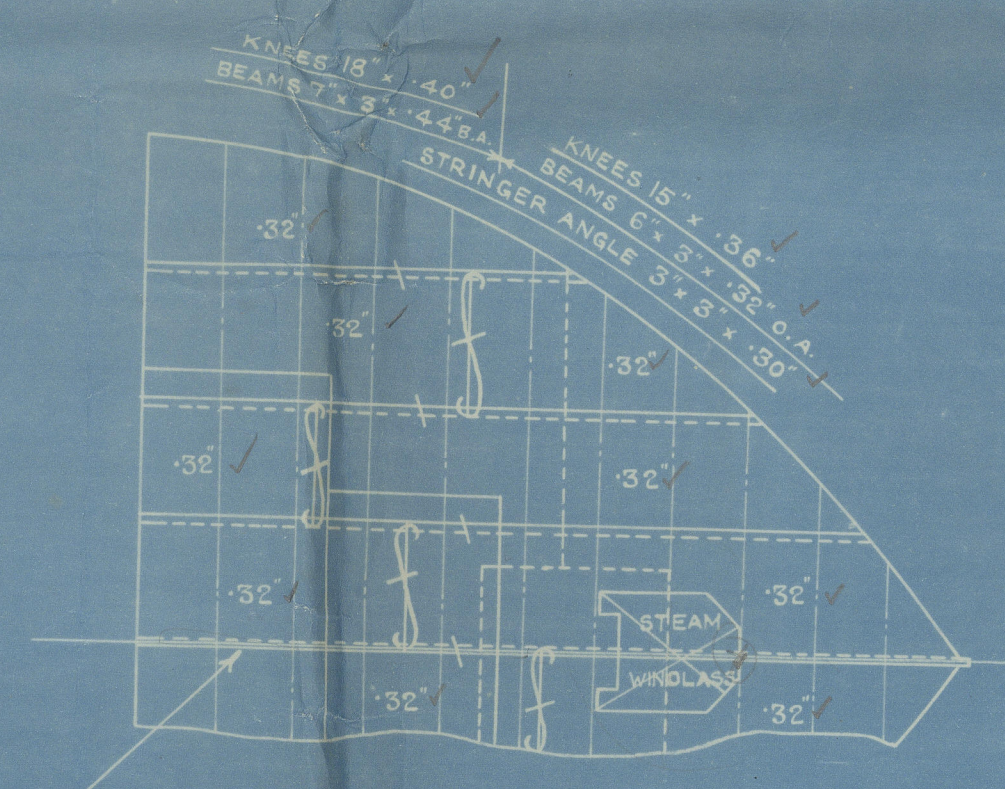
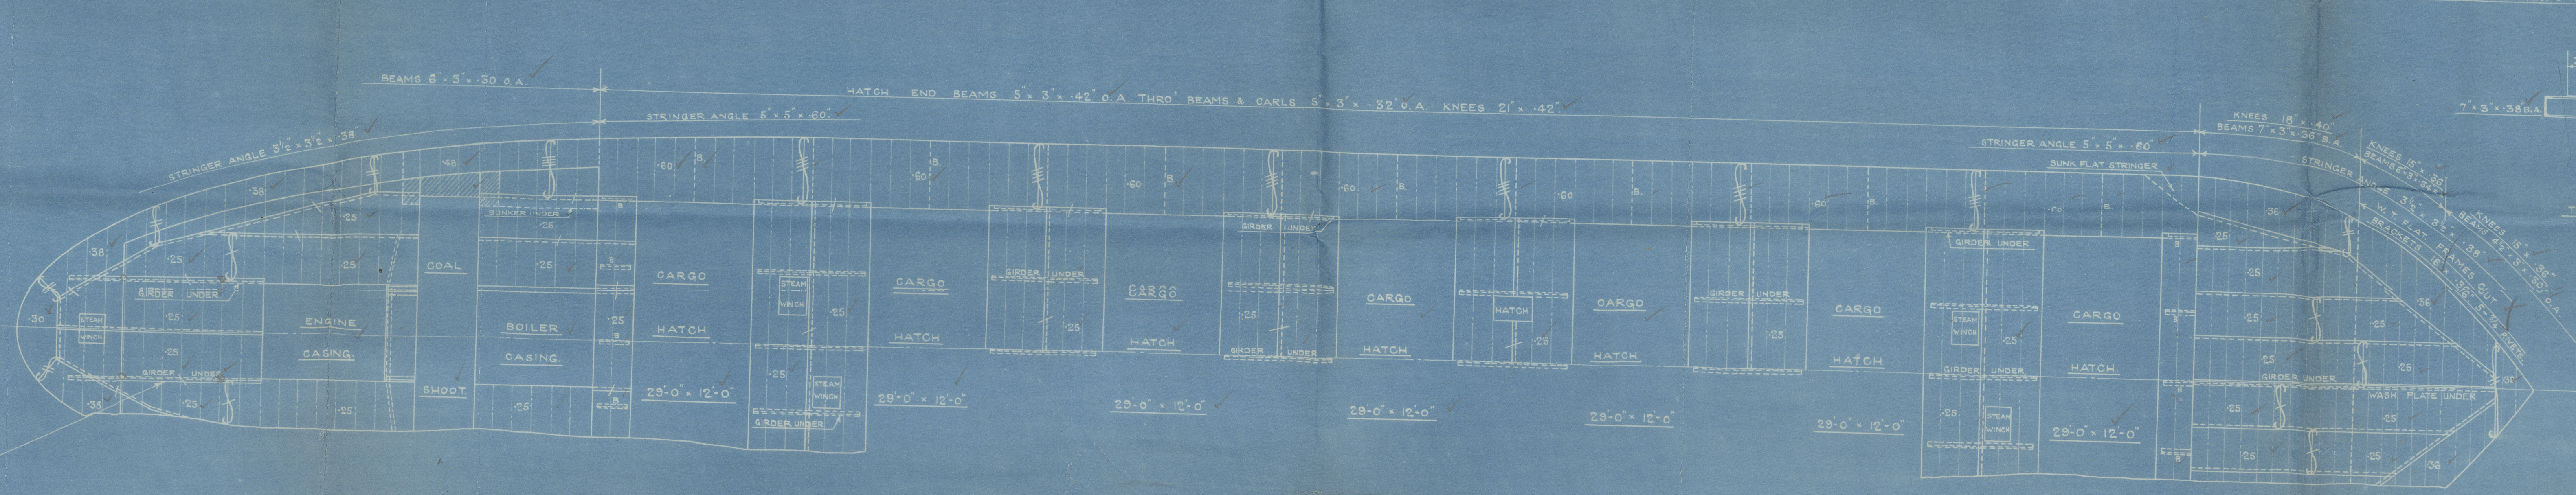
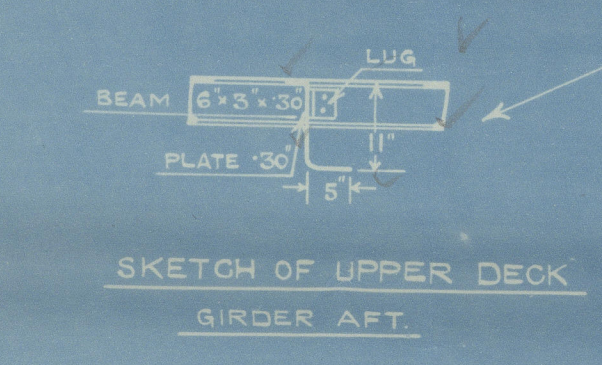
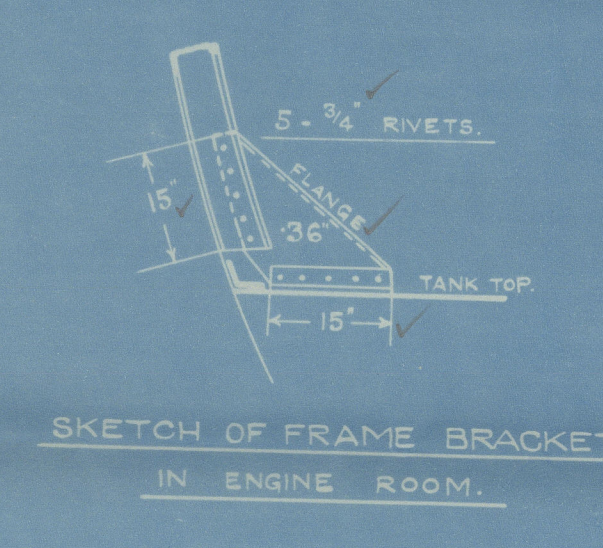
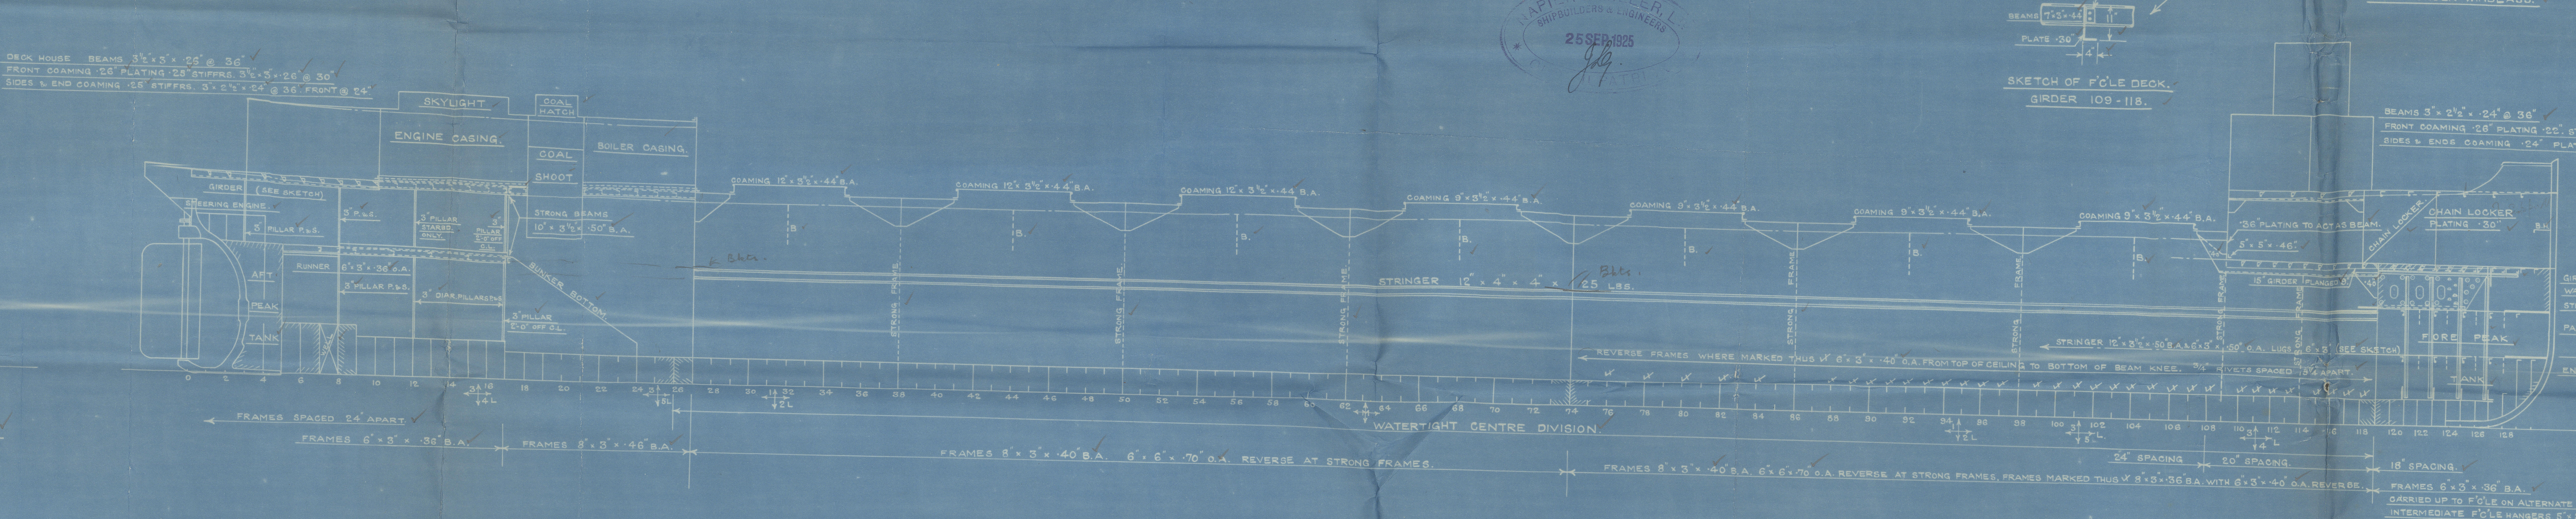
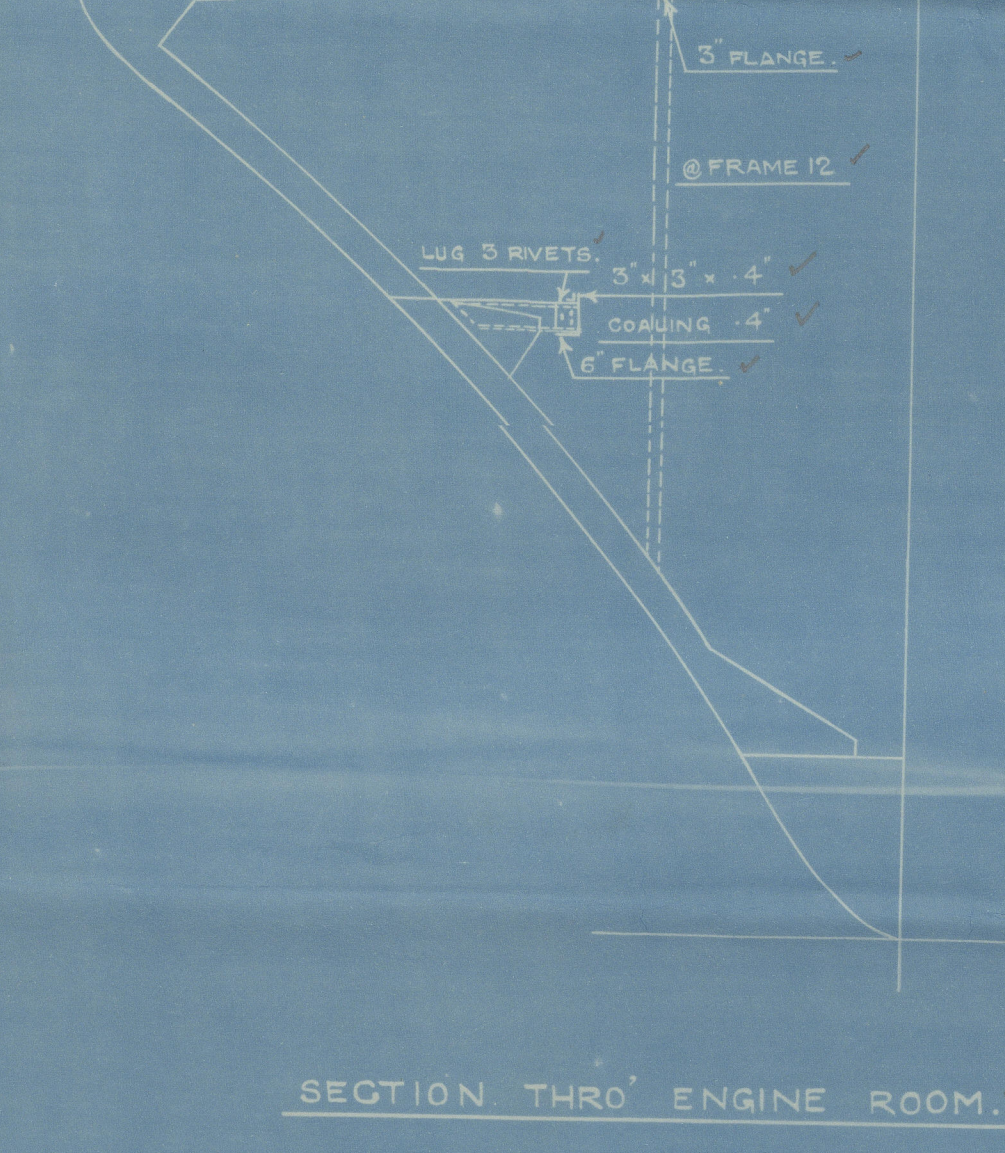


S.S. Nos. 255-G. PROFILE & DECKS. SCALE 1/8"=1 FOOT.

DIMENSIONS: 253'-0" B.P. x 43'-0 3/4" B.M.P. x 20'-0" D.M.P. DRAFT 14'-0"
TO CLASS B.S.* (GREAT LAKES & RIVER ST. LAWRENCE).

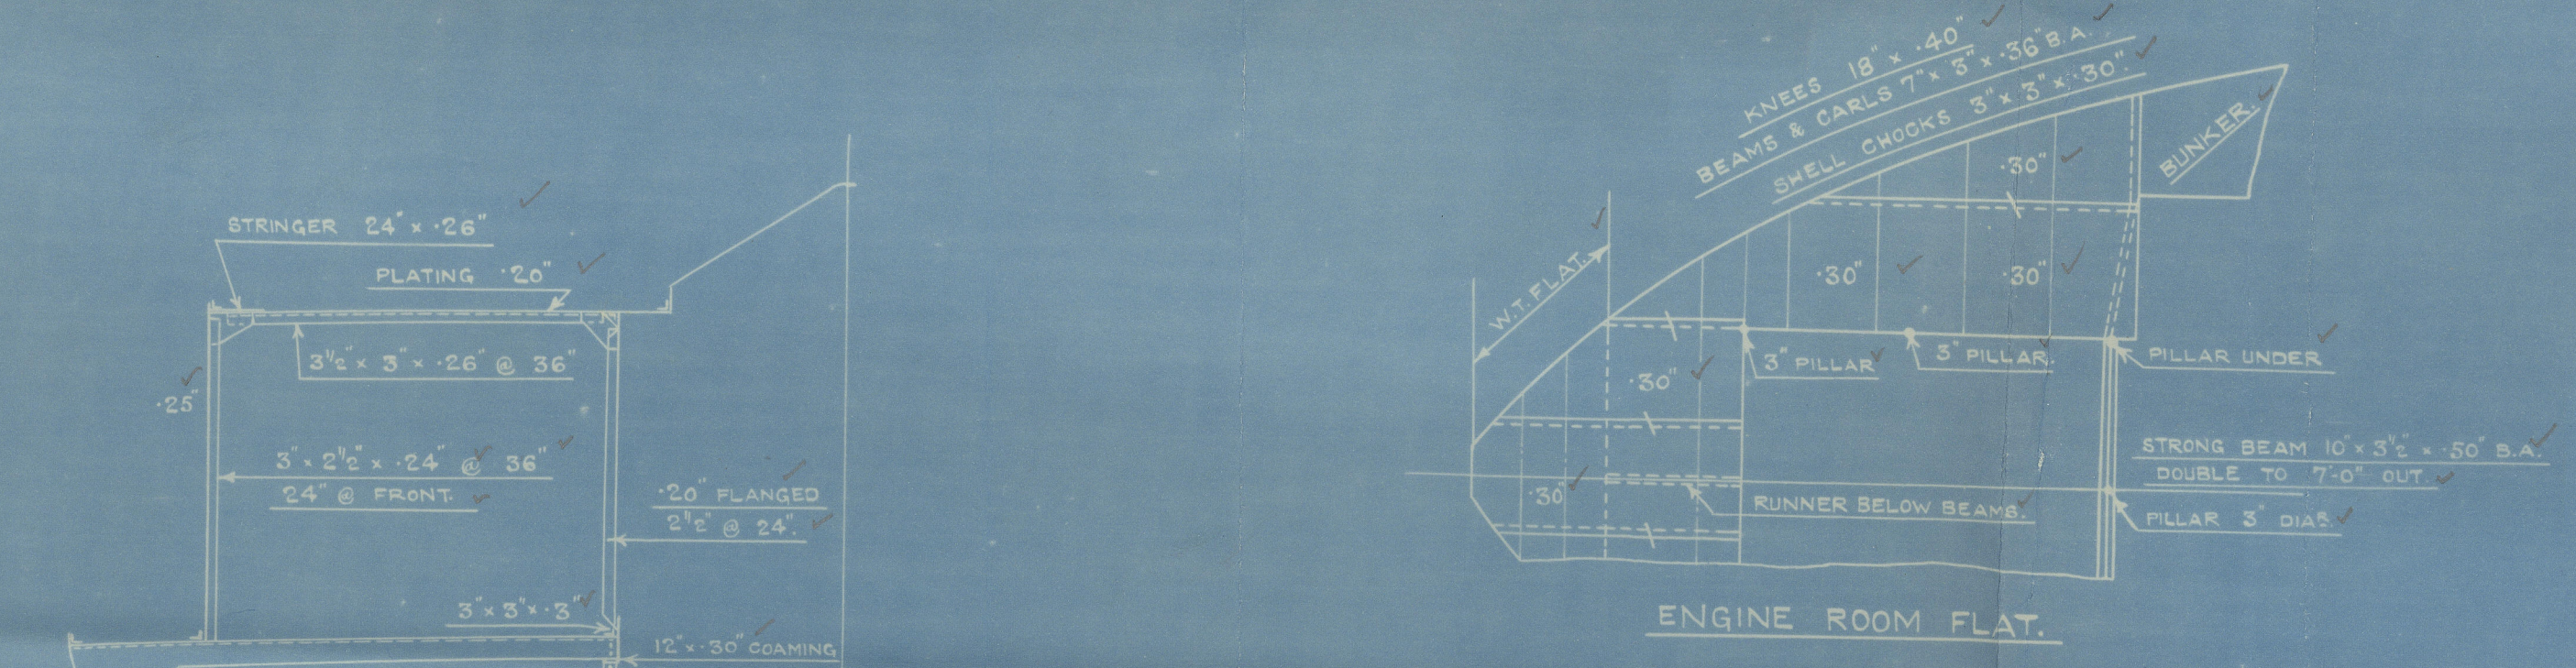

Napier Miller

255.6

Profile & Decks


Cancelled

NAPIER & MILLER

255/6

PROFILE & DECKS

26.9.25.

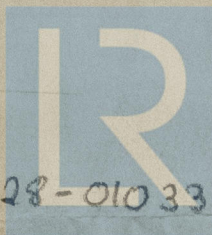

© 2021

Lloyd's Register
Foundation

010 328-010 337 F0148