


KOTOHIRA MARU  
琴平丸



R6911-501

Repair to Main Engine MP cylinder slide valve casing.  
主機中压滑弁蓋富金之区(縮尺10)

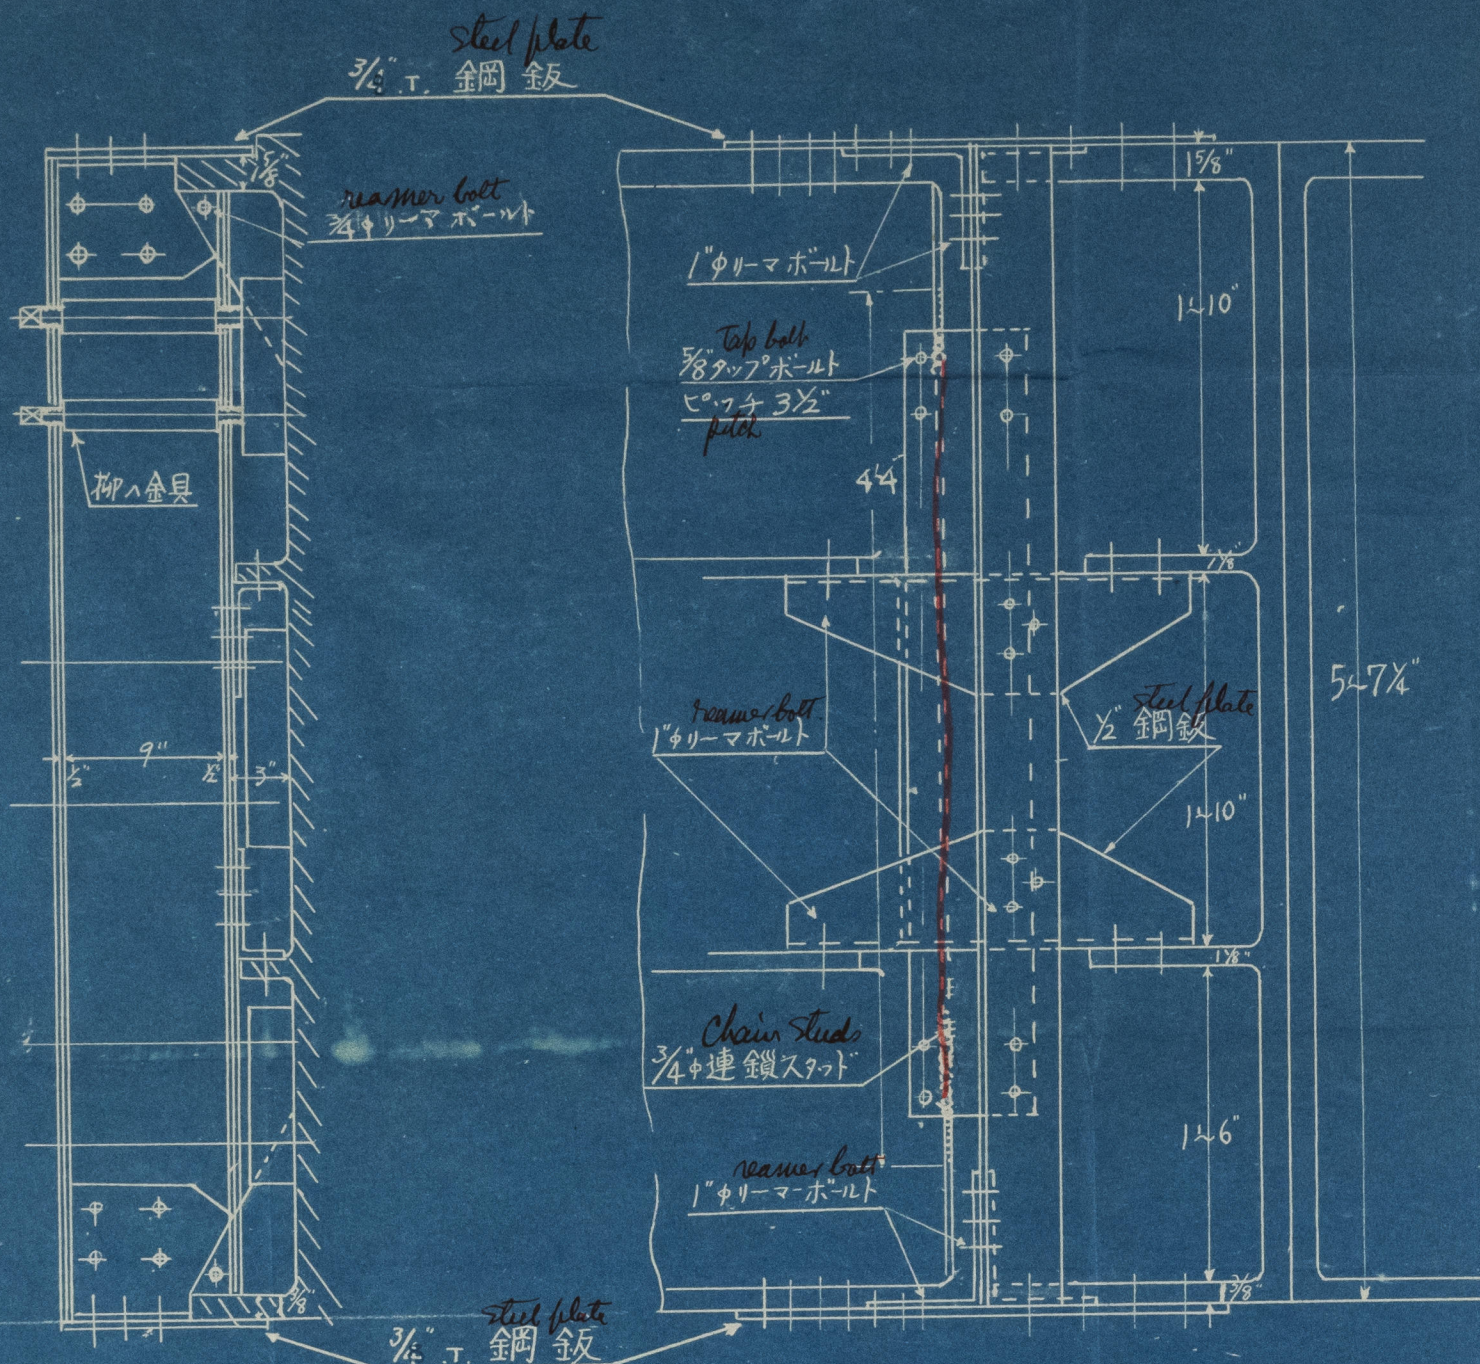

①部詳細(縮尺1/2)

Mangan putty  
マンガンパテ及1/16\"/>

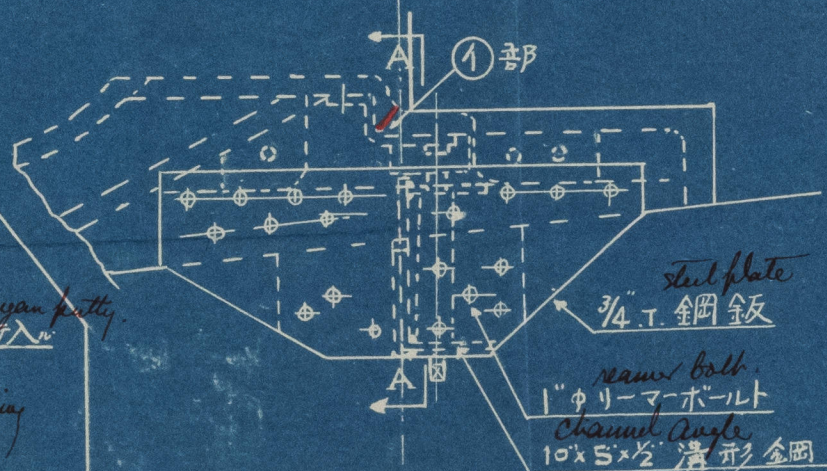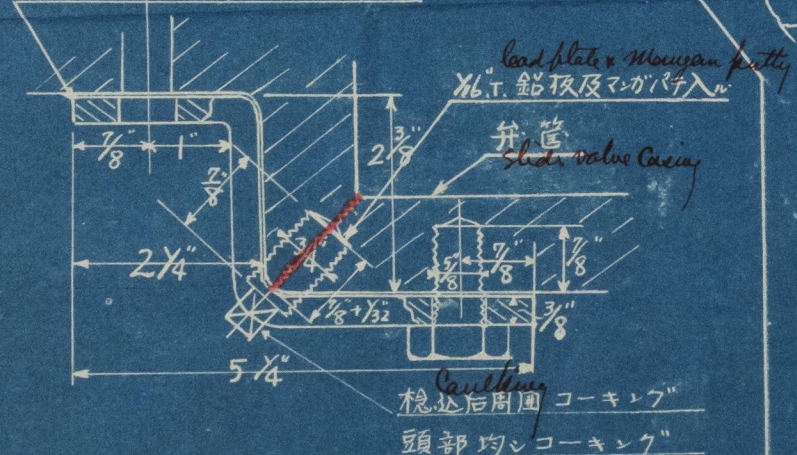


010369-010377-0153



"Kotokura Maru"

YKa. 7083.

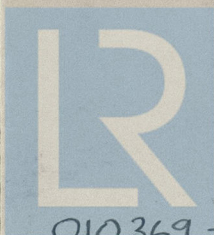

© 2021

Lloyd's Register  
Foundation

010369 - 010377 - 0153