


APPROVED
OCT 6 1950
K. K. K.

Supd: 26 Oct 1951

664

8/5 Koryu Maeda

Aug. 18 08

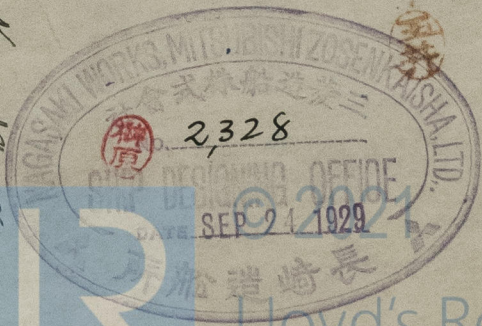

010369-010377-0177

Lloyd's Register
Foundation