

N^o 53-4

STERN FRAME & RUDDER & QUADRANT.

SCALE:-

1/2 IN. TO ONE FT. FOR GENERAL PLAN
1 IN. TO ONE FT. FOR DETAILS
2 IN. TO ONE FT.


MATERIALS.

RUDDER STOCK FORGED STEEL
RUDDER AND STERN FRAME CAST STEEL
PINTLES FORGED STEEL
TILLER

NUMERALS AND SPEED.


A 116 32 1/2
D 3.31 FT.
A x D 385.02
SPEED UNDER 12 KNOTS.
DIA OF RUDDER HEAD 9'

COUPLING * ARM "A"
SCALE 1" TO 1'-0"

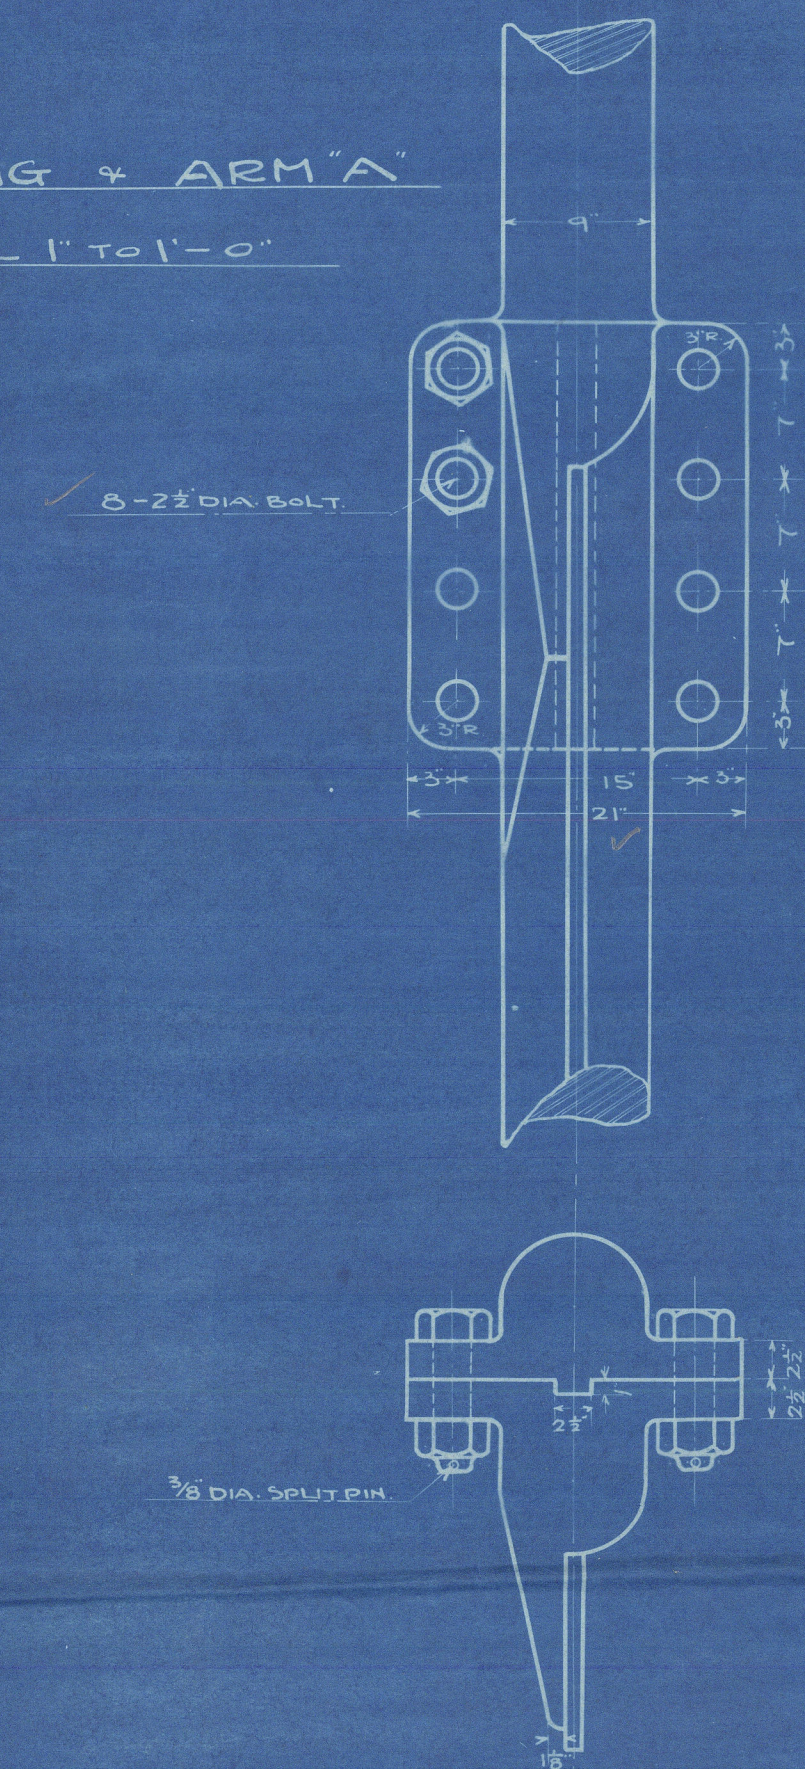

ARM "B"

SCALE 1" TO 1'-0"

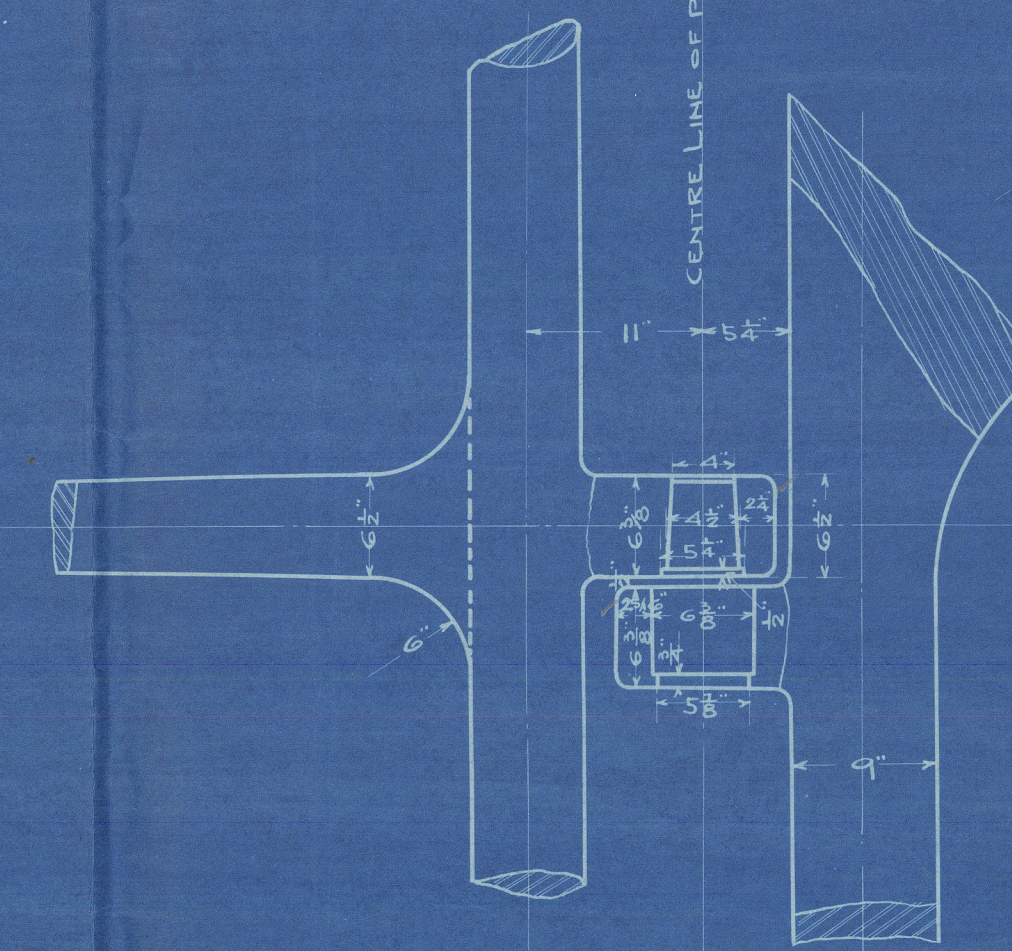


QUADRANT


SCALE 1" TO 1'-0"

DIA OF STEERING CHAIN 1 1/2"


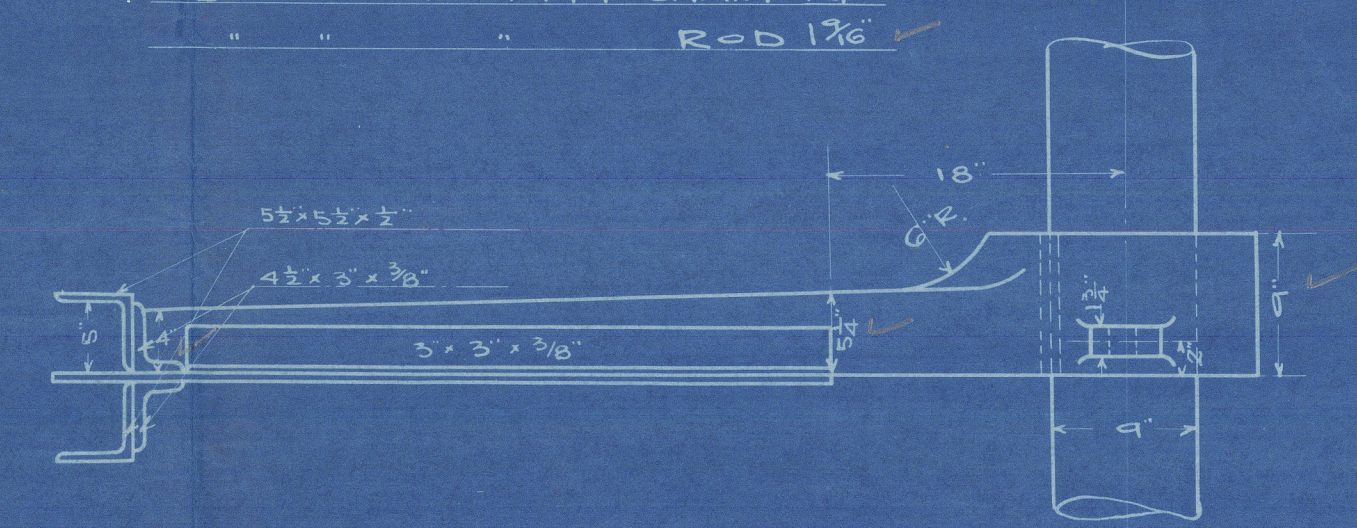


ARMS "A" TO "D"
SCALE 1" TO 1'-0"

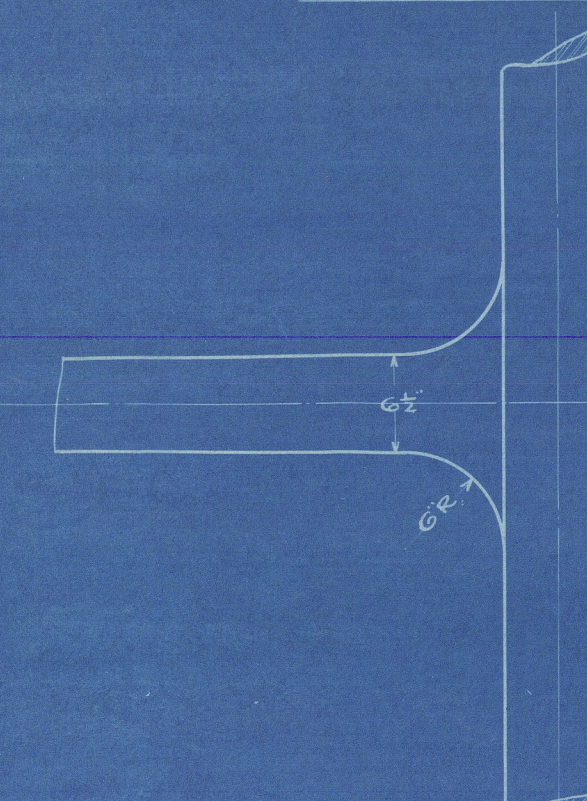


ARM "E"

SCALE 1" TO 1'-0"

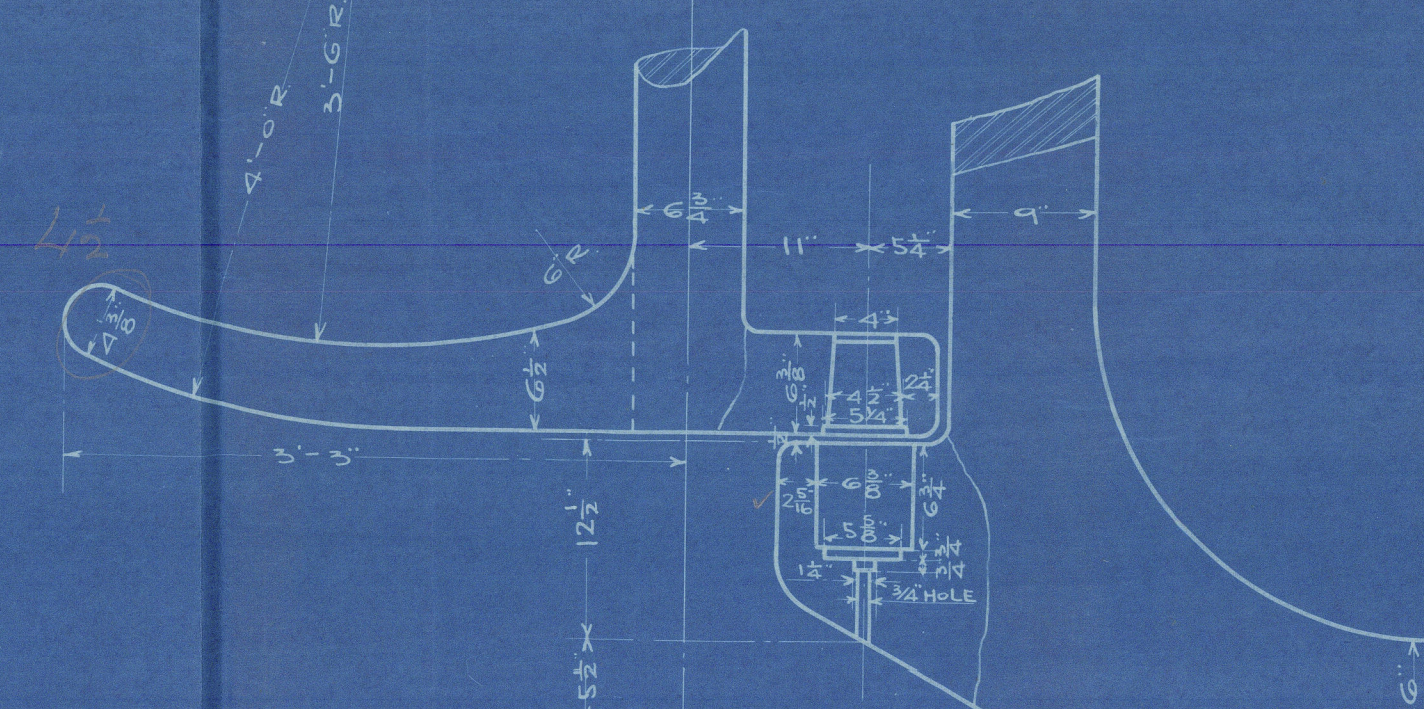


ARMS "C" & "D"
SCALE 1" TO 1'-0"

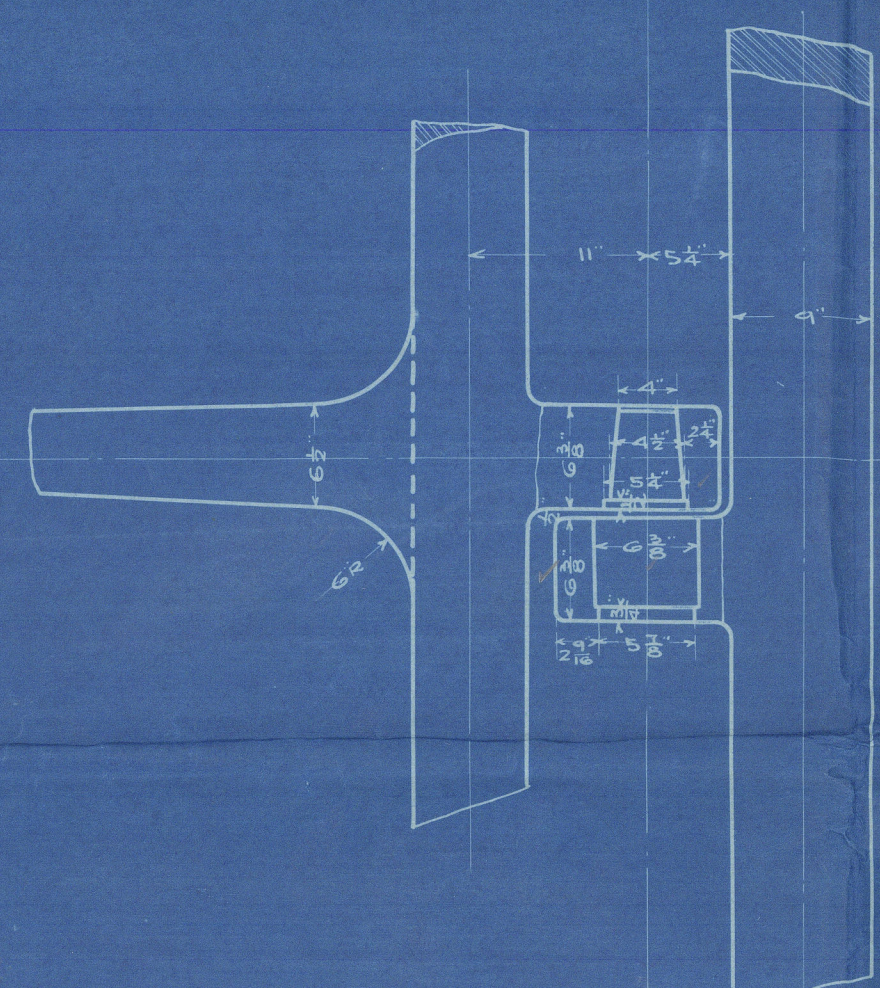


DETAIL OF PINTLES
SCALE 2" TO 1'-0"


IN ARM "A"

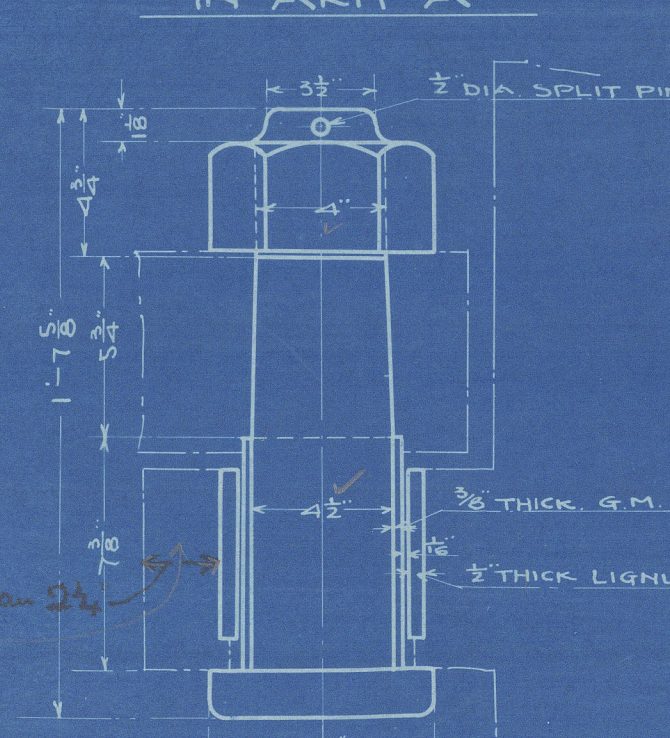

IN ARMS "B, C & D"

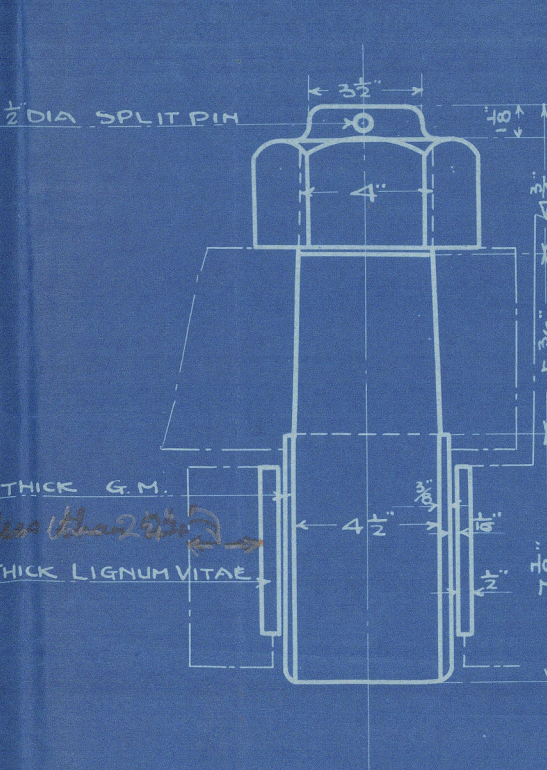

IN ARM "E"

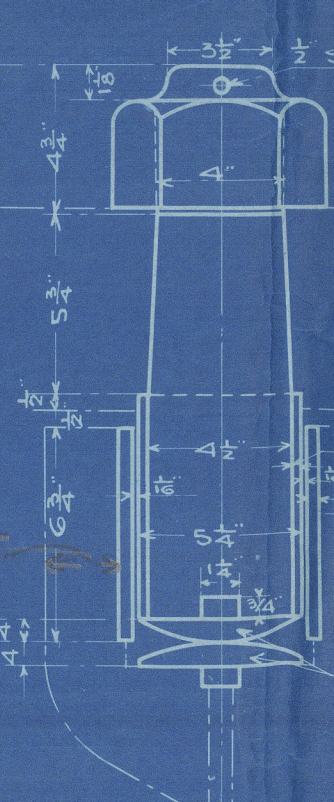




010364-010377-021821


M. B. R.

Mrs Shap W.

No 53-4 Wm's

Stem from trusted

Rob letter 9/8/19

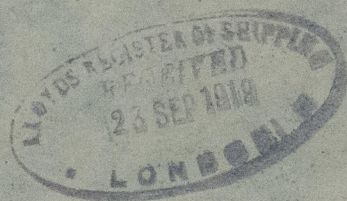

Gen. Box 2835.

ⁿ
Luso ⁴ Maru.



© 2021

Lloyd's Register
Foundation

010369-010377-0218