

The vessel
 is for the
 shipping interest
 of the
 27-11-08
 21-12-08
 N. 77. 12-1-09


S. S. N° 73. 77
LONGITUDINAL SECTION.

SCALE $\frac{1}{8}'' = 1 \text{ FOOT}$

DIMS: 165'-0" BP. x 28'-0" x 12'-2" MLD.

TO CLASS 100 A1. LLOYDS.

VAN YLIET & C^o
 HARDINXVELD — HOLLAND.

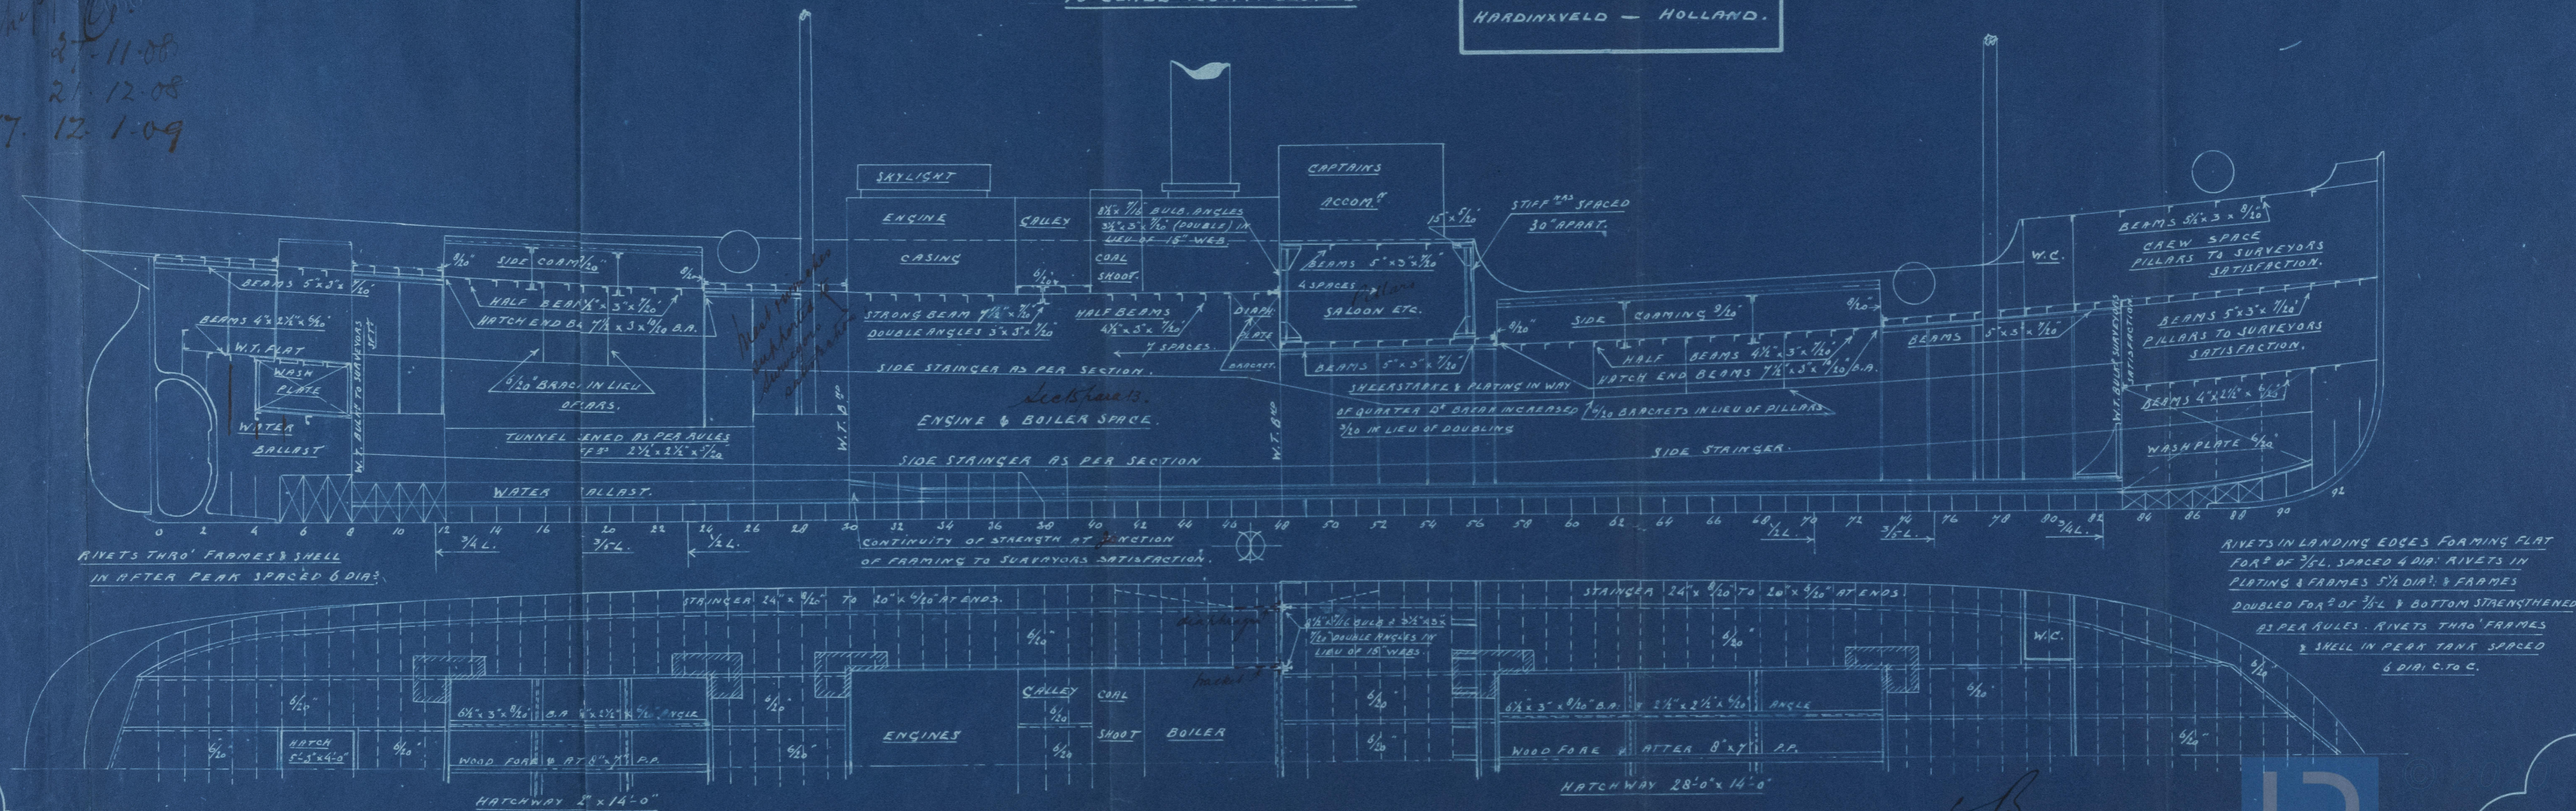

C.B.
 27.11.08

Profile and Sh. Plan.

S.P. no. 73 - Aud. 77.

Part. of. R. Tolam.

S. 73. report no. 6170



S. 77. r. n. 6596

Sh. Breeze V.D. 581

Rot. 670.

as Marrowah

Rot. 6596.

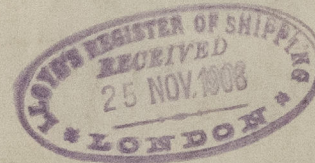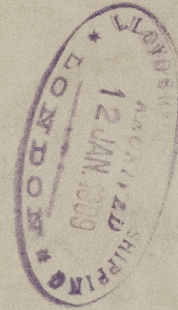

© 2020

Lloyd's Register
Foundation

010391-010404-0111