

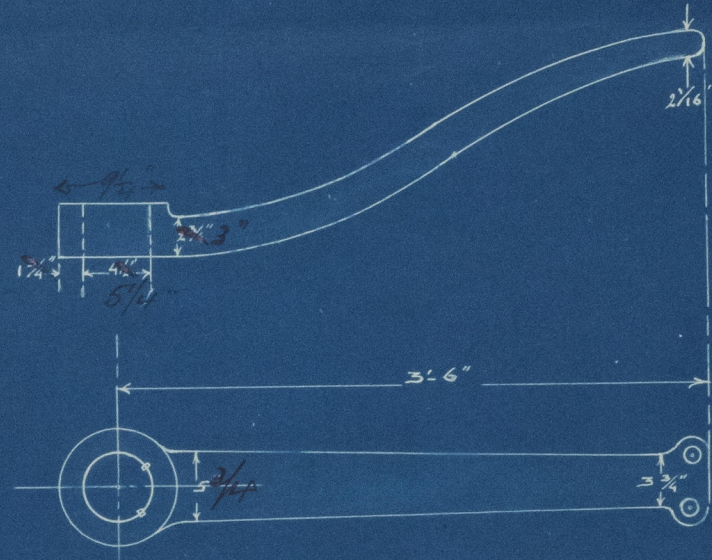


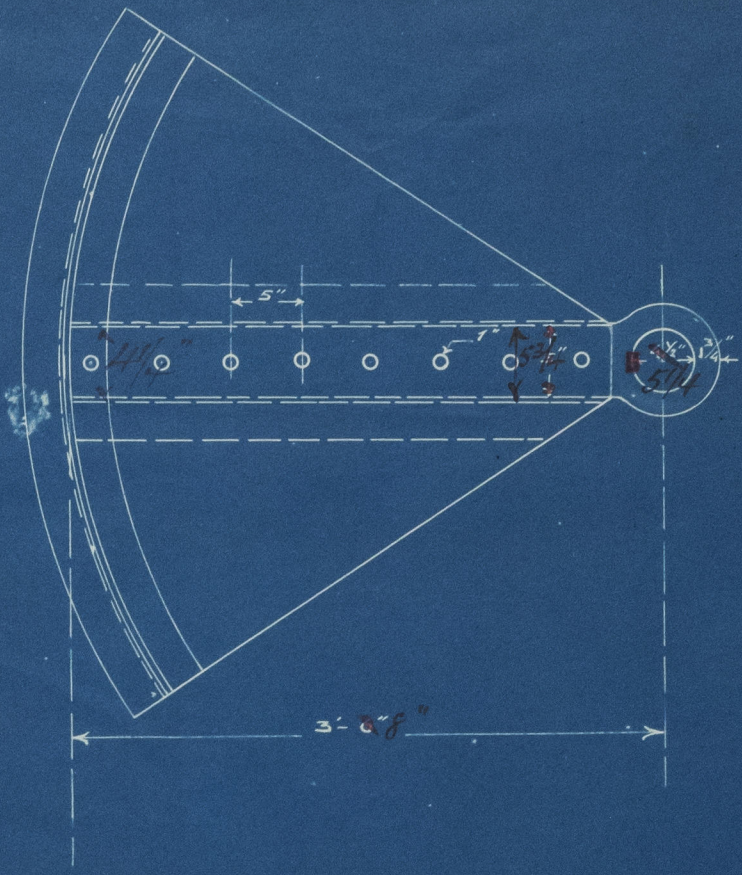

30.12.08.

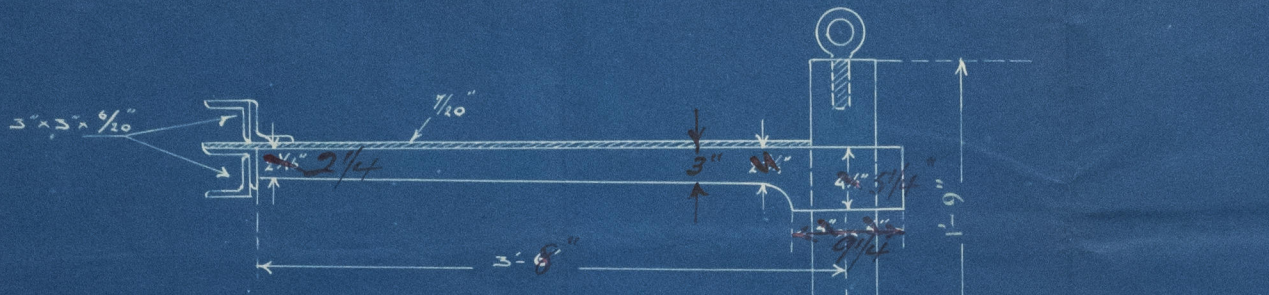


S. S. N° 73.

RUDDER GEAR.

TO CLASS 100 A1. LLOYDS.

SCALE 1" = 1 FT.

VAN VLIET & CO.
HARDINKVELD - HOLLAND.

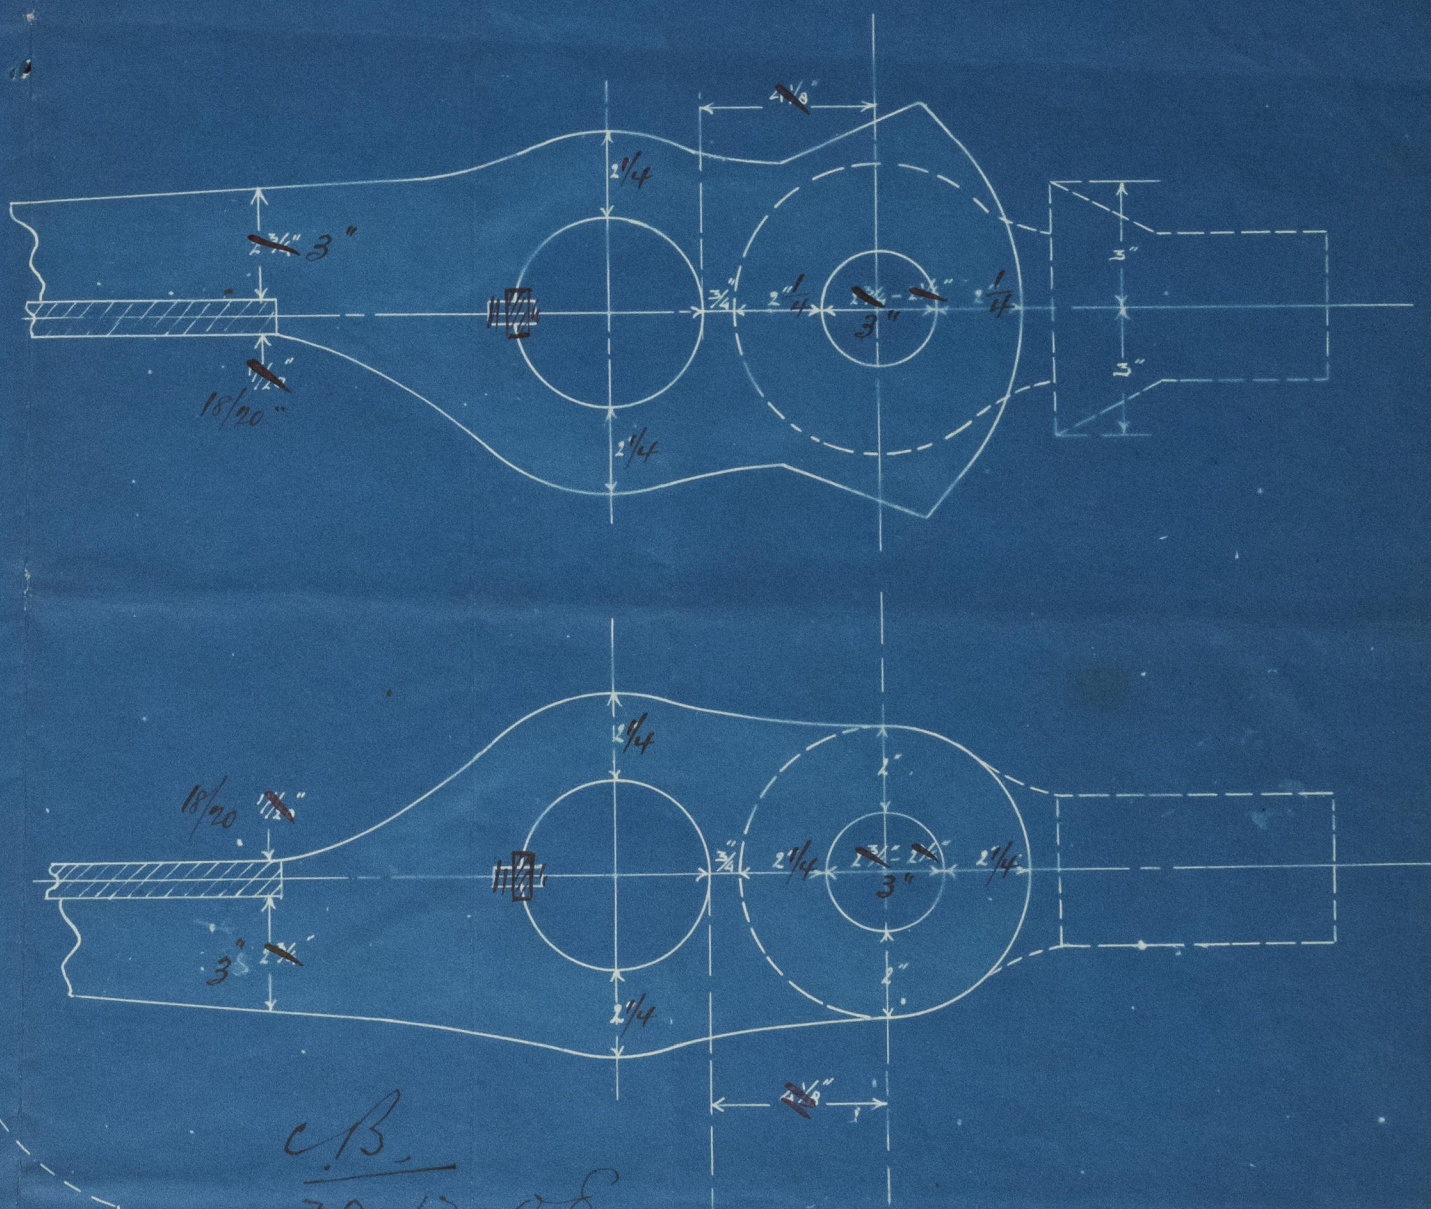

C.B.
30.12.08.



Lloyd's Register
of Shipping



Buider. Plan ss 43 and 44
Port of Rotterdam.
No. 43. report no-6170
77 - n 6596
St. Breege
Rot. 6170.



R. Harrawah
Rot. 6596

73
Buider

610341-010404-0112