

 Lloyd's Register Foundation

Van Vleit & Co's

No 23477

~~Advised~~

Plan of midship Section
Ss. 73. and 77.


Port of Rotterdam.

No. 73. report. no. 6170

No. 77 & no. 6596

St. Breeze - Dist 58T

Rot 6170.

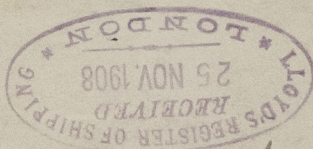

Rs. Marrawah

Rot 6596



© 2020

Lloyd's Register

Foundation 010341-010400-0113