

21.12.08

S. S. N° 73.

STERN FRAME.


TO CLASS 100 A1. LLOYDS.

SCALE 1" = 1 FT.


Approved for Stern frame

— VAN VLIET & CO. —  
— HARDINXVELD — HOLLAND.



DETAIL OF STOPPER. AT 42°.

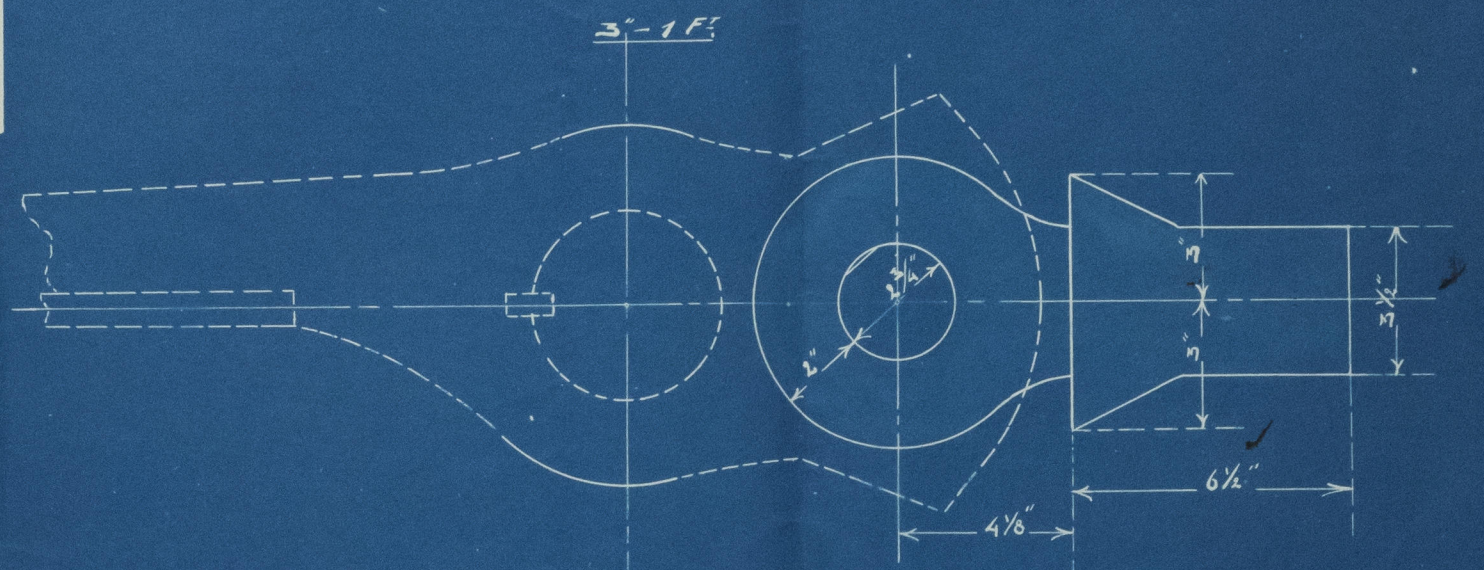

DETAIL OF GUDGEON.

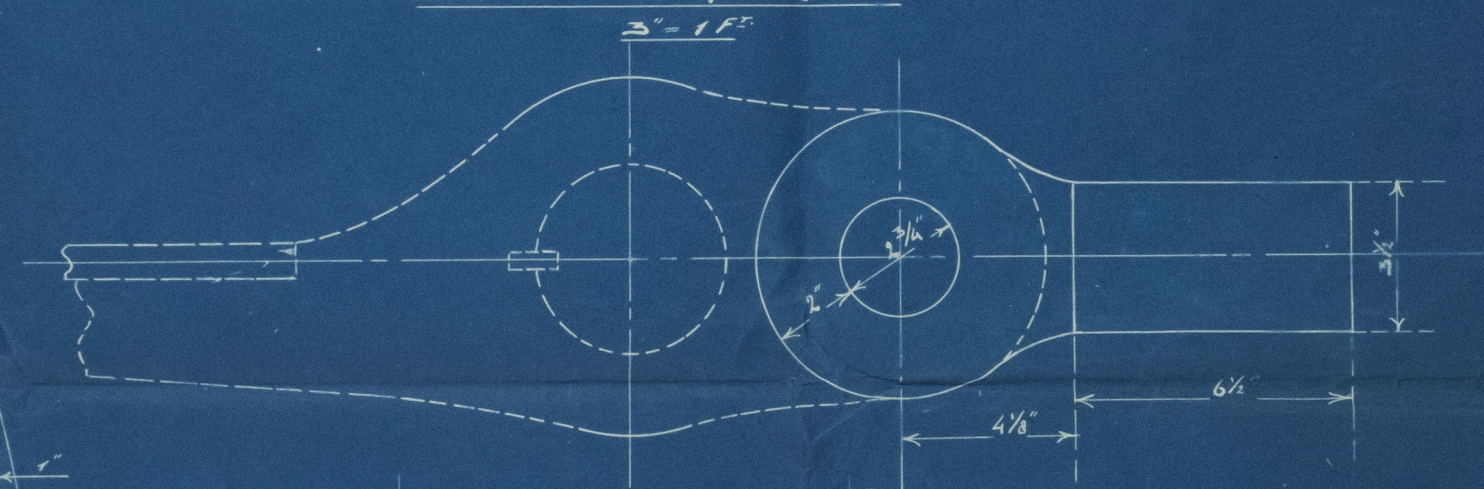

BOSS AT FORE PART BOSS AT AFTER PART.

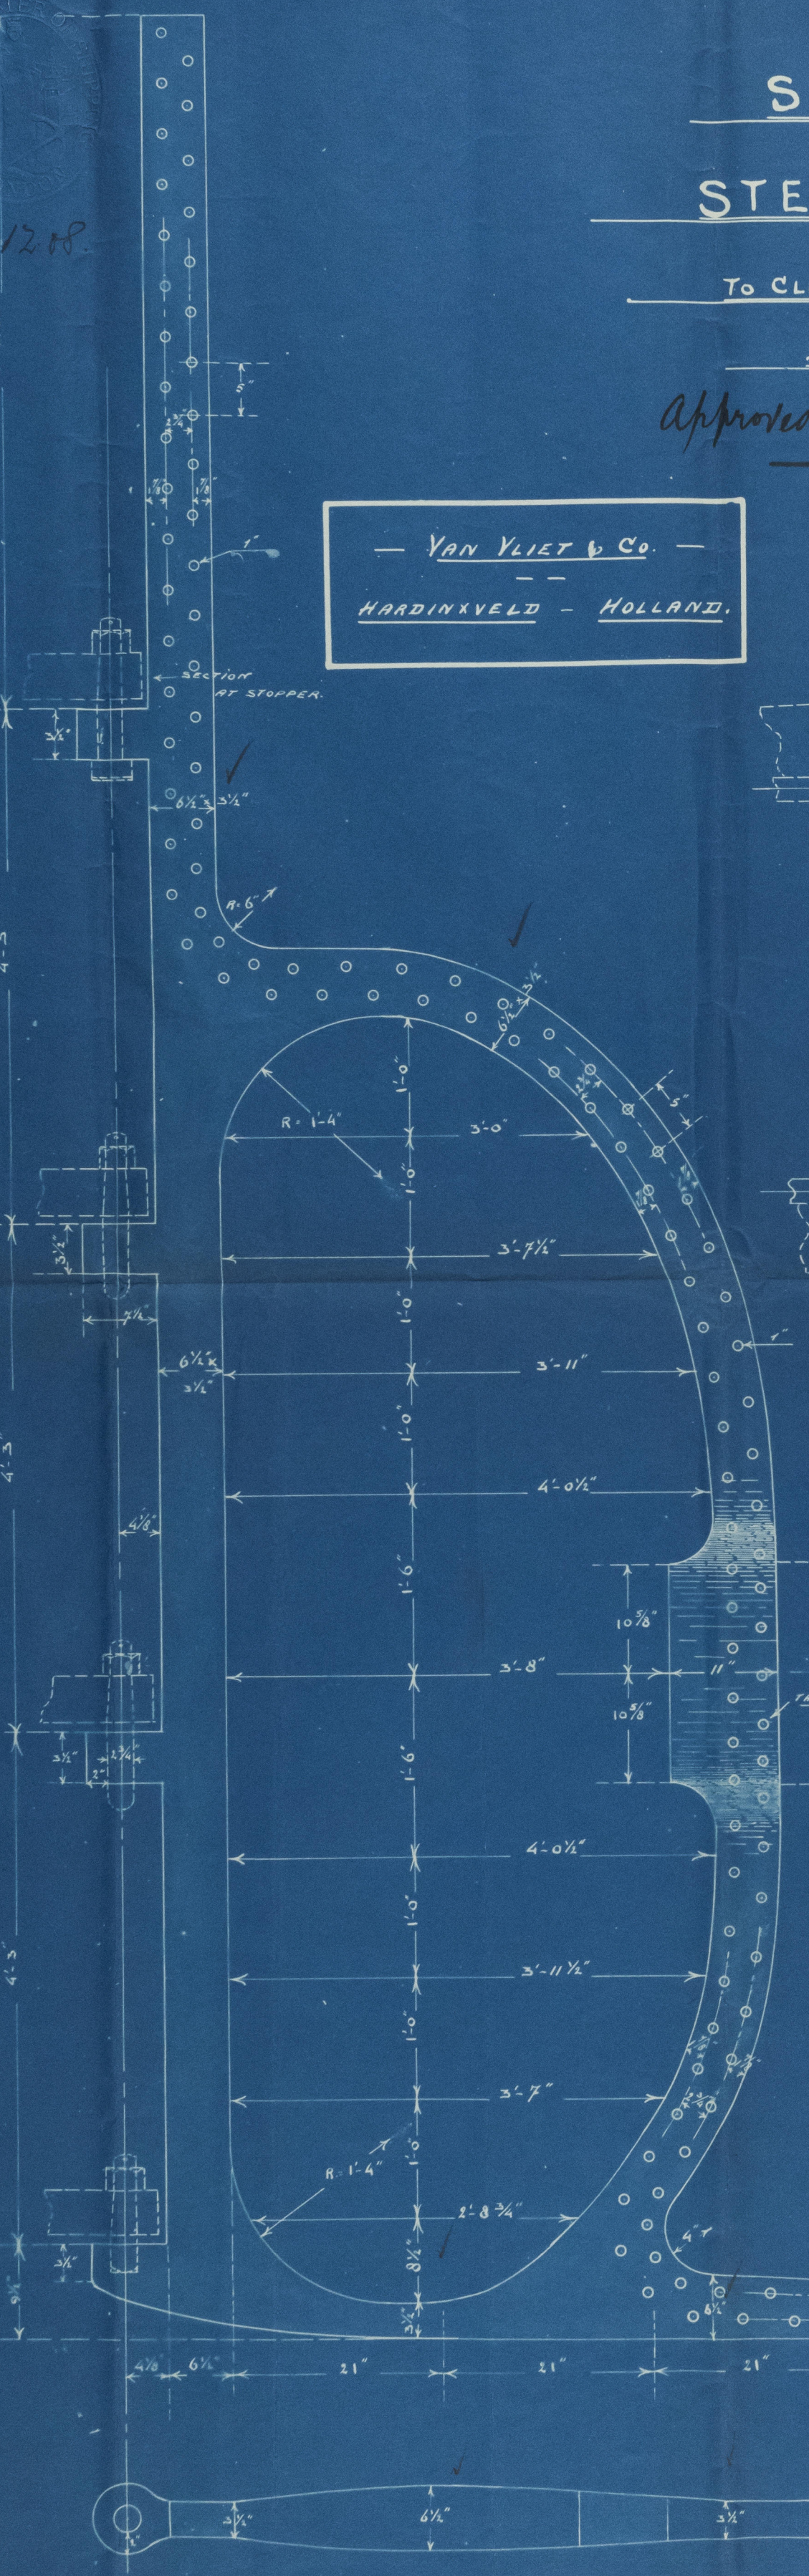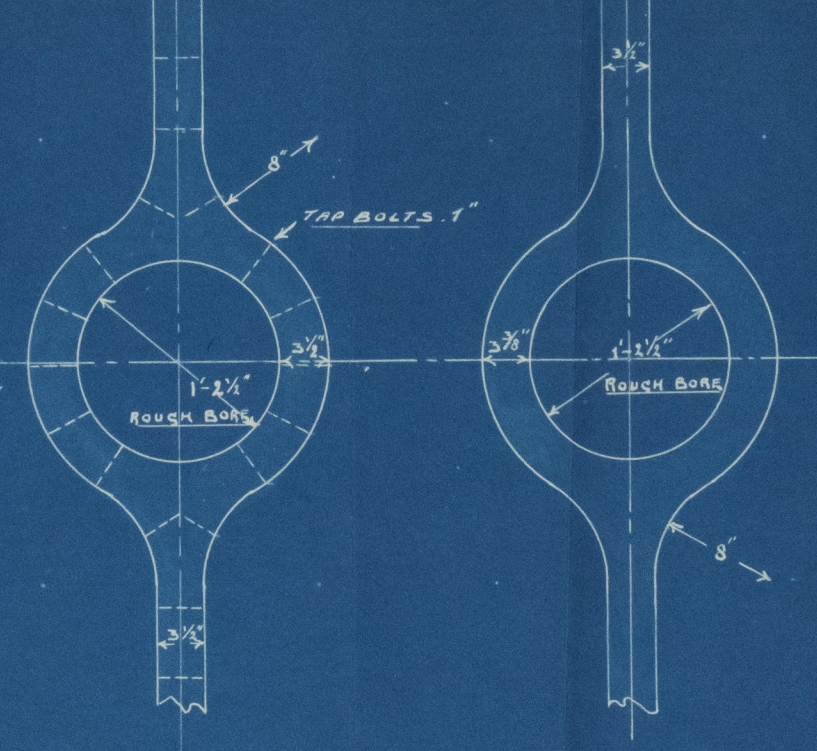

C.B.  
21.12.08.



Lloyd's Register of Shipping



73

New frame

Plan of Stern frame & saw

Port of Rotterdam.

No. 13. report No. 6170


n 17 s n 6596

St. Breeze.

Rot. 470.

St. Marawah

Rot. 6596

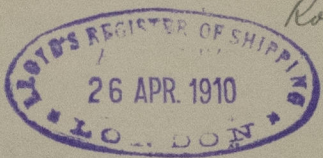

010391-00404-014



© 2020

Lloyd's Register  
Foundation