

DIMENSIONS 148.4 B.P. x 22-10 1/2 M^{LD} 11-9 1/2 M^{LD}

CLASS 100 A. 1.

STEEL (FOR FISHING PURPOSES.





LLOYD'S REGISTER
OF SHIPPING.
6 - MAY. 1905
* HULL. *

Carls S. & C.

No 503.4.5, & 6.

Profile & Deck Plan.

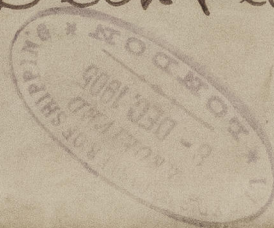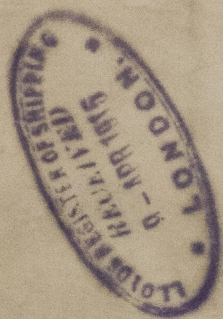

1/2 "Neopachia"
Hull Report No 19566
Shankel
Obua Rpt 19567

010341-010404-0253



© 2020

Lloyd's Register
Foundation