

18.9.14

MIDSHIP SECTION

STEEL SCREW TRAWLERS

N^{OS} 627-'8.

135.0 B.P. * 23.6 EX. * 13.1 MOULDED.

1/2" SCALE

TO CLASS 100. A. 1. STEAM TRAWLER

DECK PLATED OVER IN WAY OF MACHINERY
E. AND B. CASING AS PREVIOUSLY APPROVED

PLAN No. 4719.

FOR ENCLOSURE TO


MESSRS. LLOYDS SURVEYOR

HULL FROM

COCHRANE & SONS, LTD.

SHIPBUILDERS, SELBY.

DATE 15/9/14

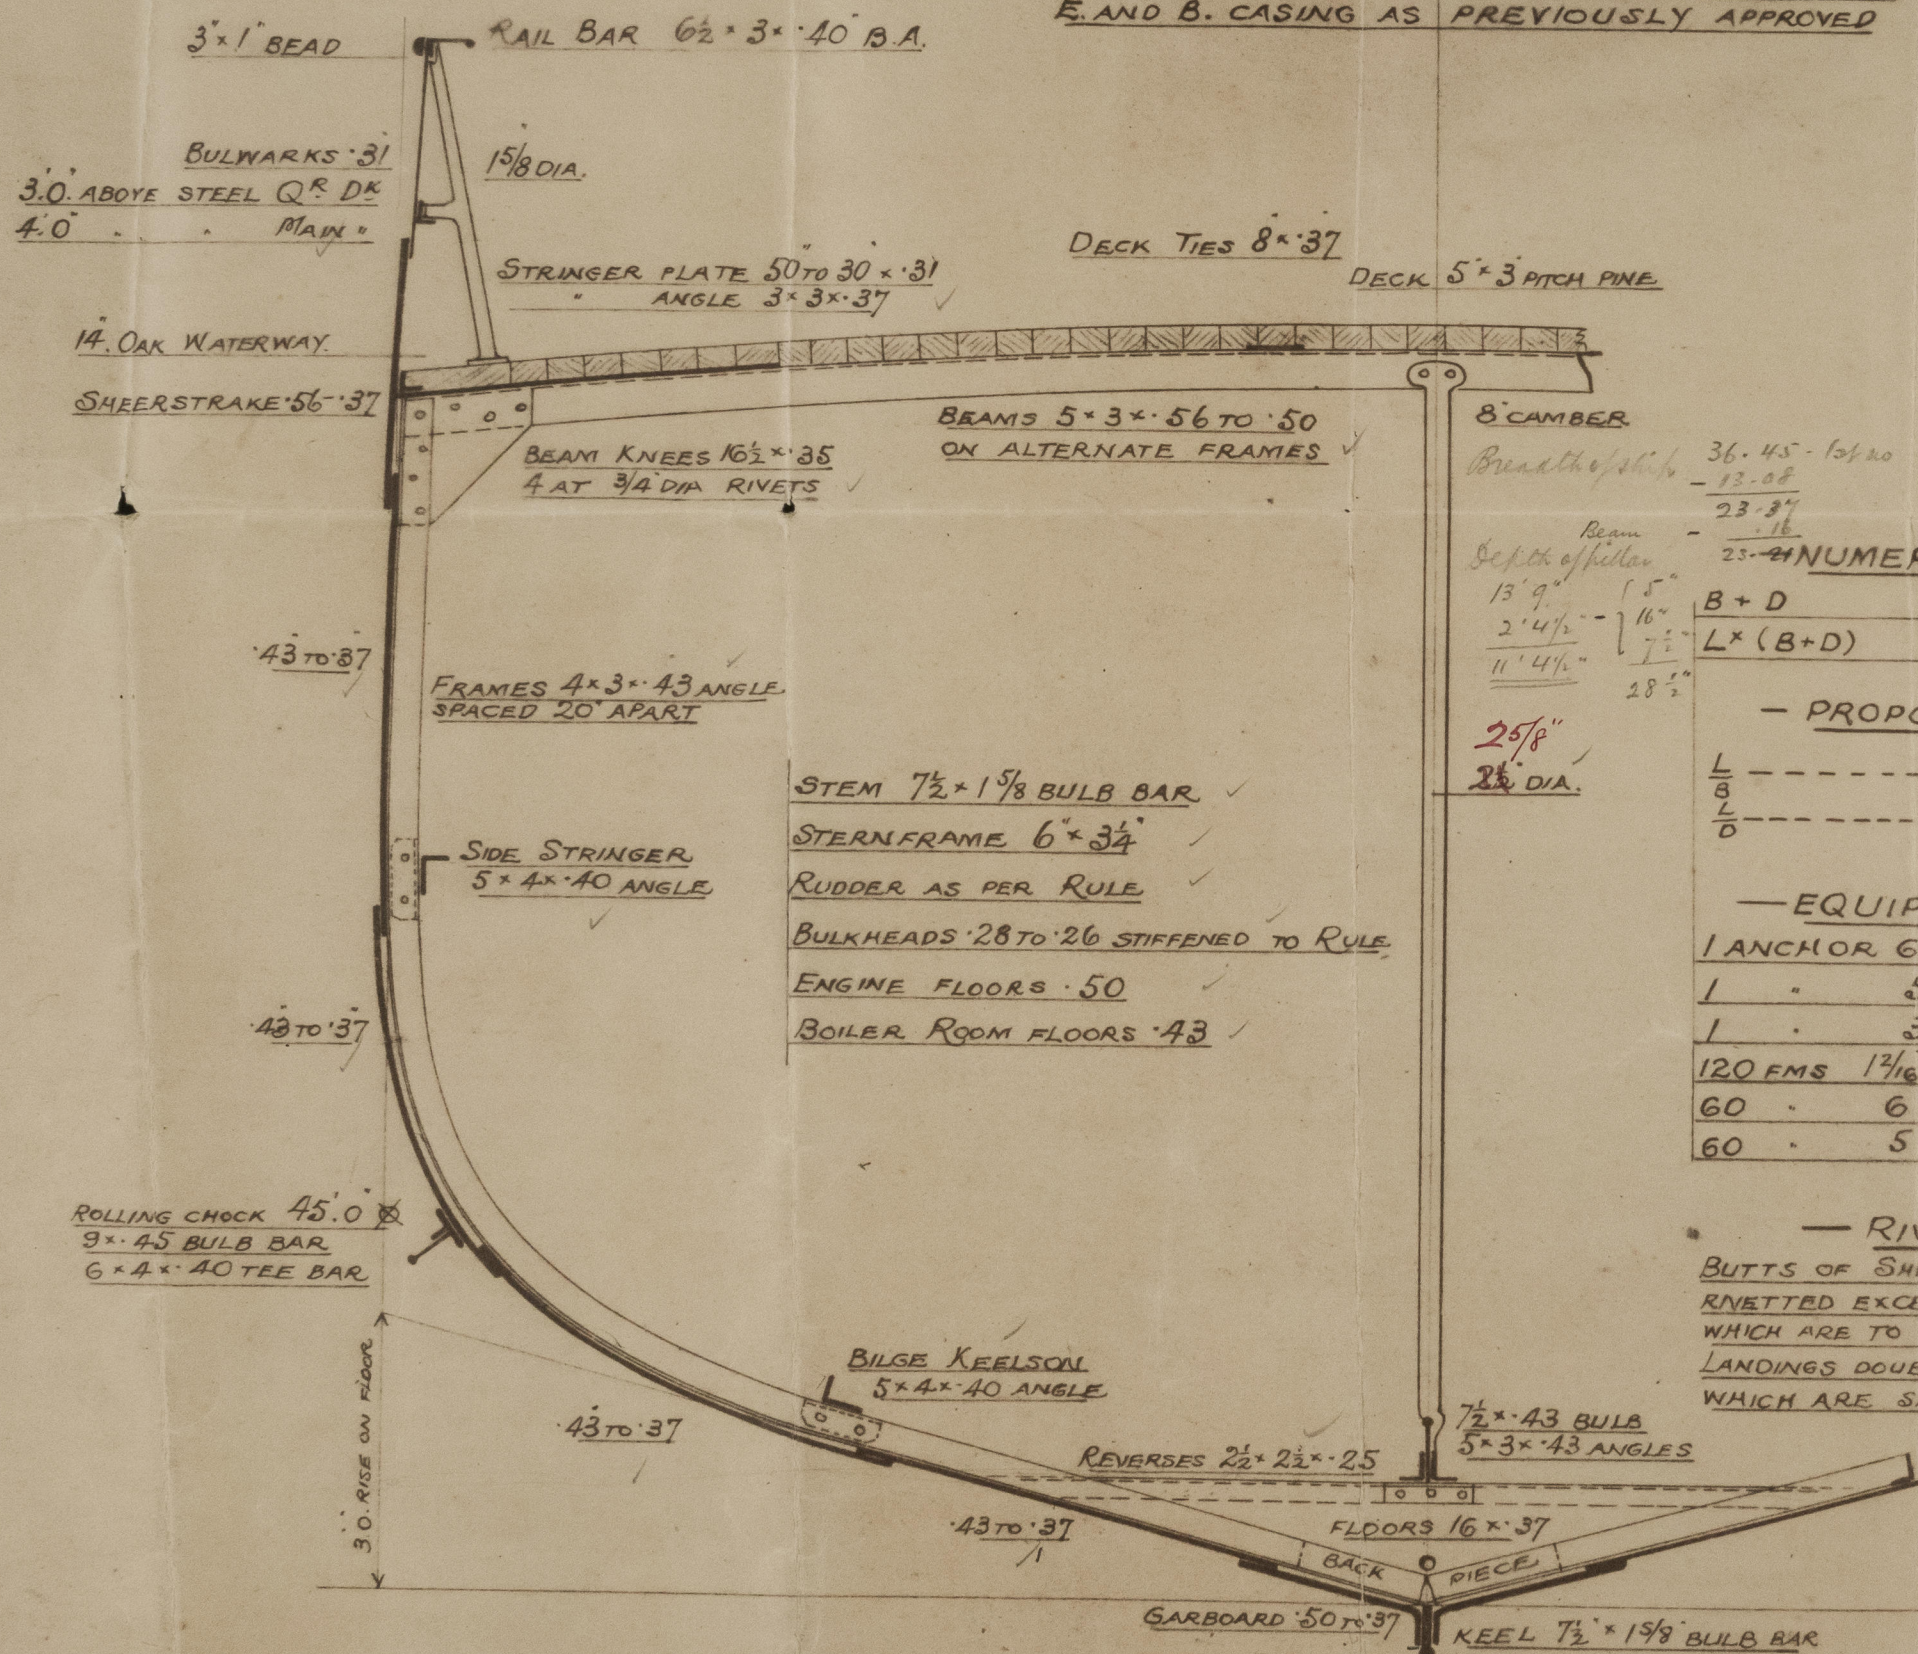

18.9.14




© 2021

Lloyd's Register Foundation

010416-010427-0135


Cochrane's nos 627/8.

Mid Ship Section

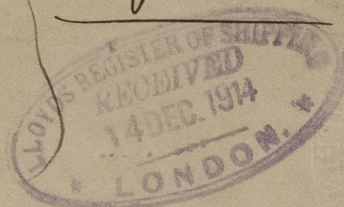

s/s "Welbeck"

Hull Rpt. no. 28425

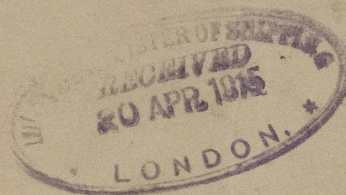

© 2021

Lloyd's Register
Foundation

010416-010427-0135