

PROFILE & DECK PLAN.

STEEL STEAM TRAWLERS

DIM^{NS}. : 137'-0" B.P. x 26'-6" M.L.D. x 13'-9" M.L.D.

TO CLASS 100 A1 STEAM TRAWLER

SCALE - $\frac{1}{4}" = 1 \text{ FOOT}$

SHIP Nos. ~~1377 & 78~~ & 79.

PILLARING THROUGHOUT TO SURVEYORS' SATISFACTION

WHALEBACK SCANTLINGS
FRAMES & BEAMS 4" x 3" x .38" O.A.
SPACED ABOUT 30" APART
STRINGER PLATES .31"
REMAINDER OF PLATES .26"

STEEL TUBE MAST SUPPORTED
TO SURVEYORS SATISFACTION.

WINCH SUPPORTED
TO SURVEYOR'S
SATISFACTION.

NET STORE

WINDLASS SUPPORTED TO

CREW SPACE

- PLAN TO BE SUBMITTED:


1/2 LENGTH

$\frac{1}{2}$ LENGTH.

© 2021
Lloyd's Register
Foundation

Cafe Sambre ★
Profile + Deck (as fitted)


RECORDS DEPT.
LONDON

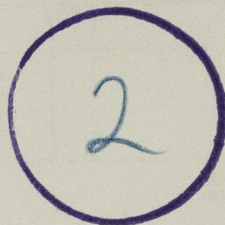

© 2021

Lloyd's Register
Foundation

010428-010439-0100

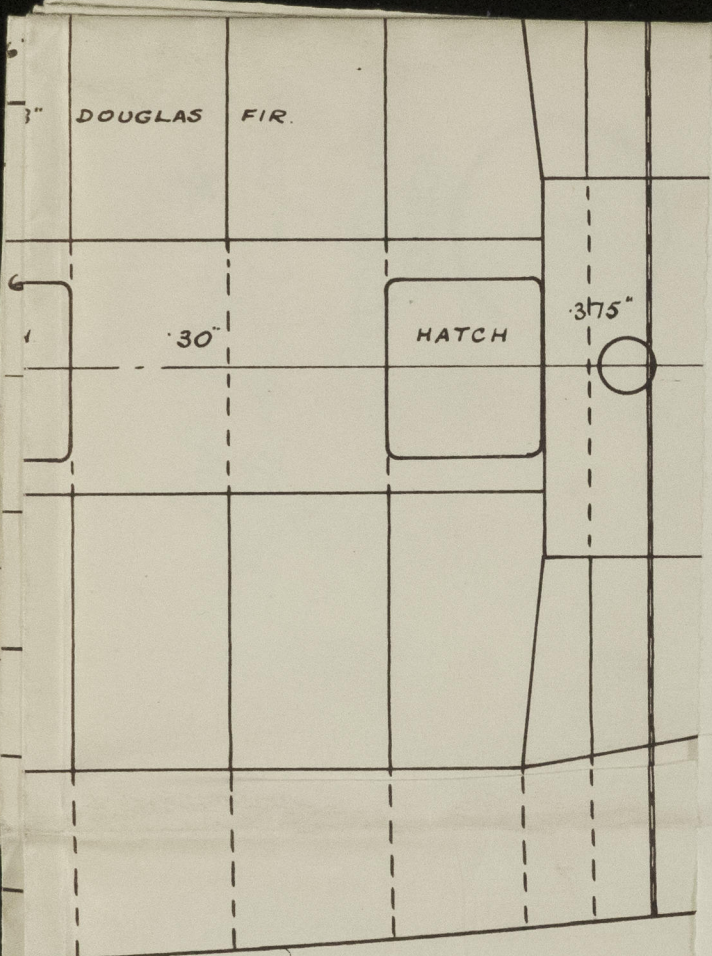

© 2021

Lloyd's Register
Foundation