

S.S. 170.


OIL TANKER FOR THE GREAT LAKES.

PROFILE AND DECK PLANS.

DIMENSIONS :- LENGTH B.P. 250'-0", BREADTH MLD 43'-0", DEPTH 18'-0".

SCALE 1/8" = 1 FOOT.

'ISHERWOOD COMBINATION SYSTEM'.

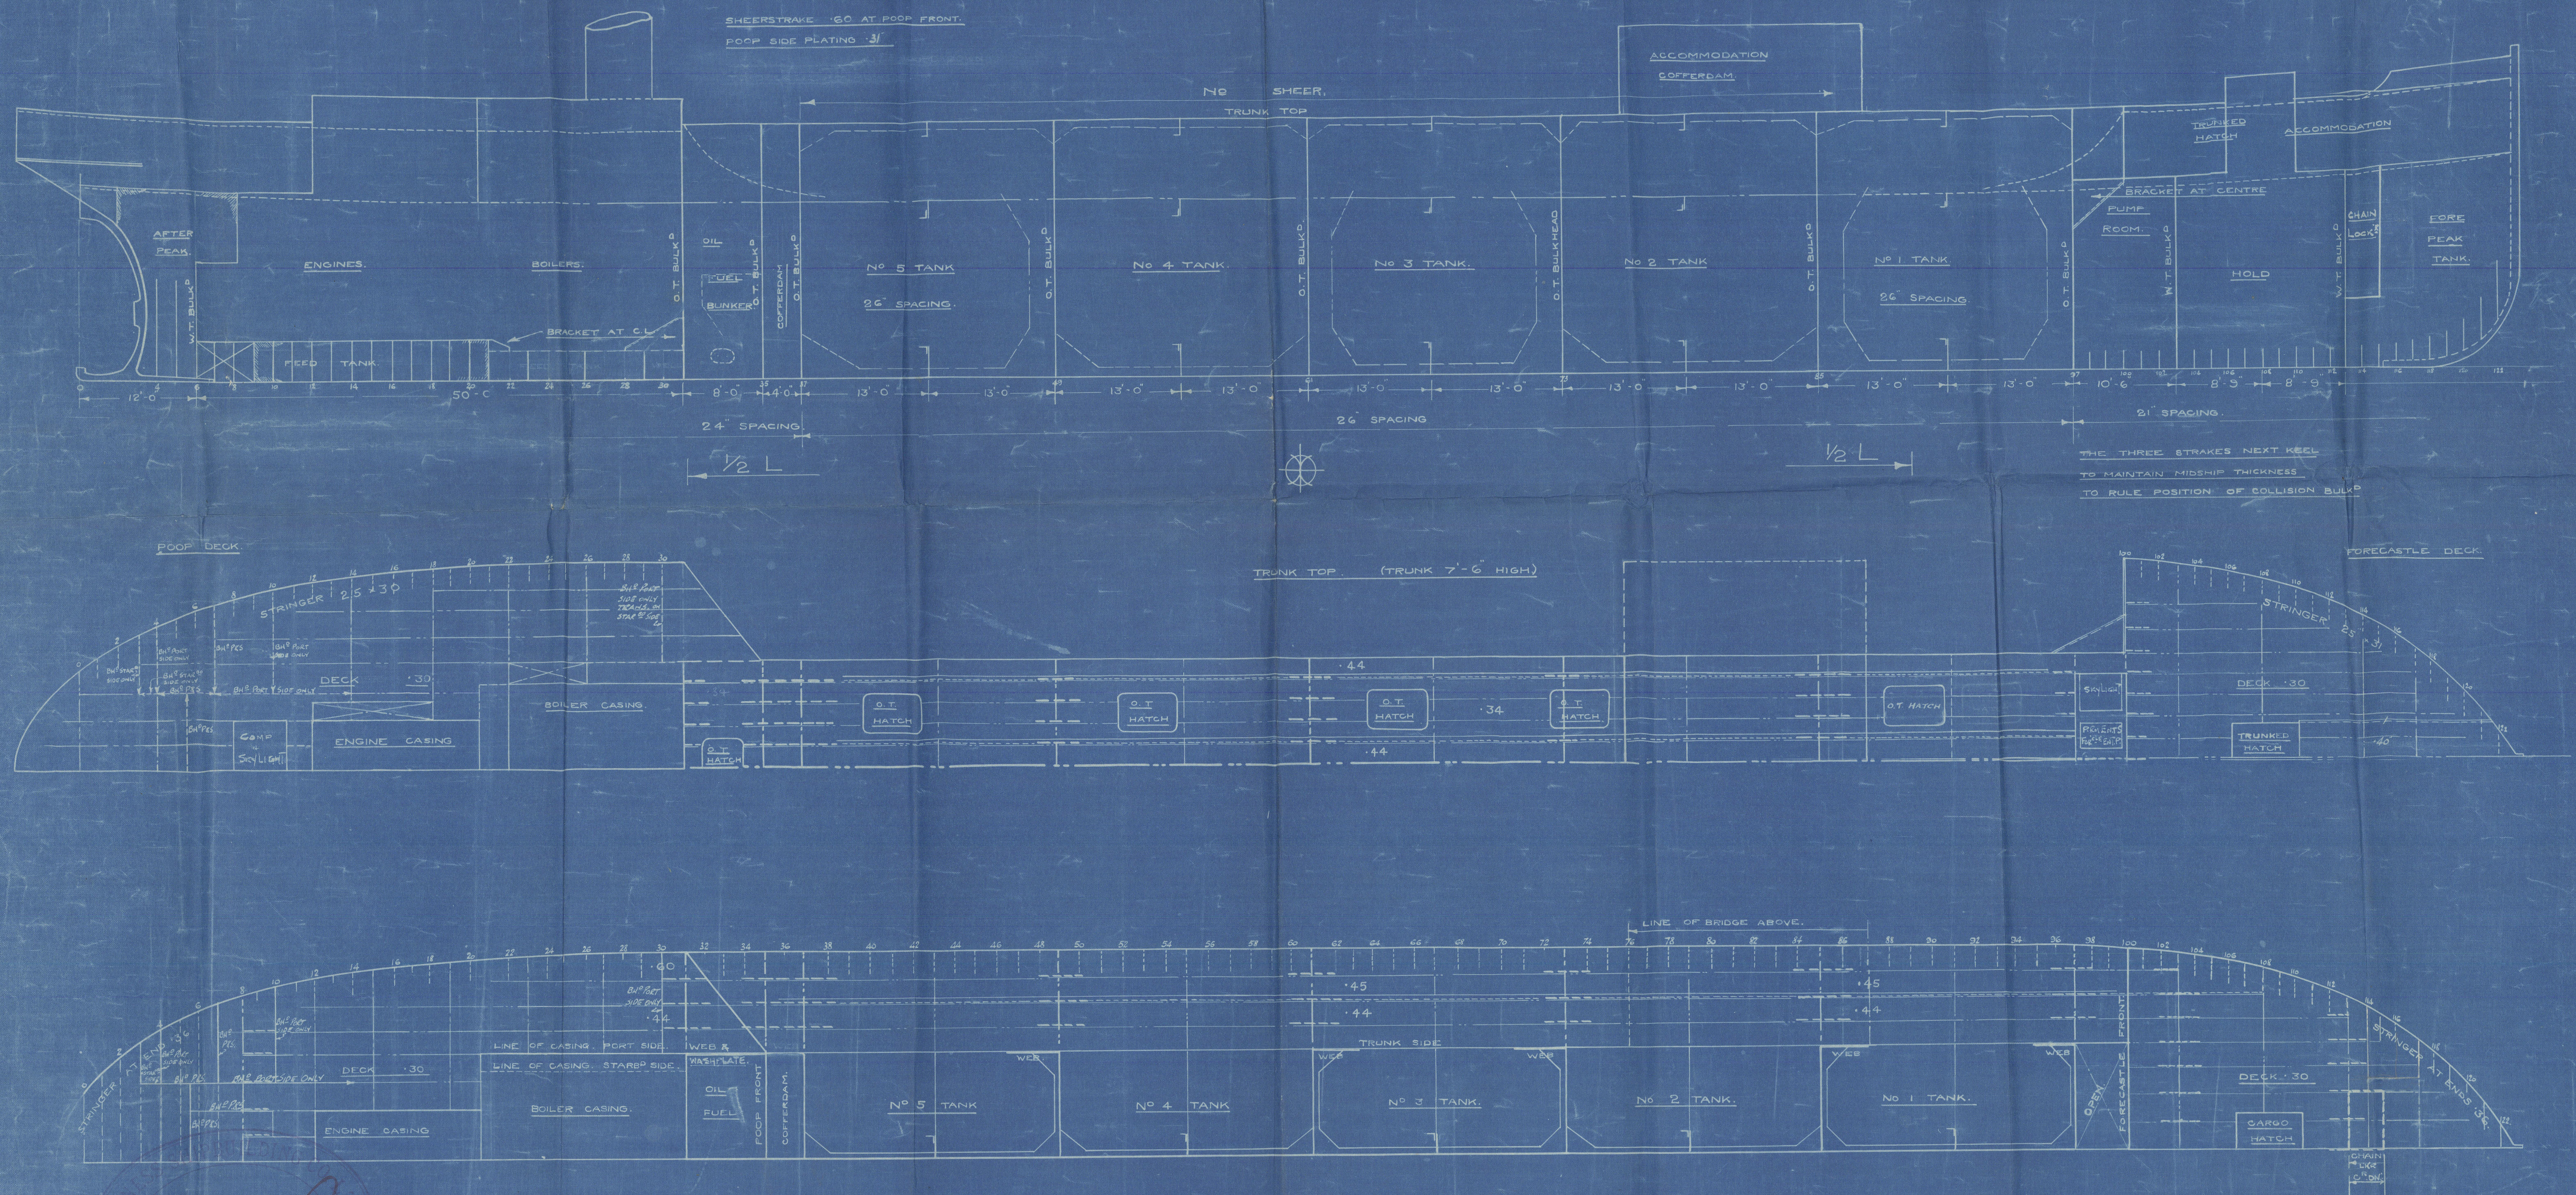


SHIP DRAWING OFFICE
ISSUE NO. 15402
DATE 10-3-33
WILKINSON BROS. & CO. LTD.

0103440 010450 0137

MESS^{rs} FURNESS S.B. Co
No 170 S/S "ACADIALITE"
PROFILE & DK. PLANS AS BUILT.

S.S. Acadialite
MDB. RPT. No. 14028.

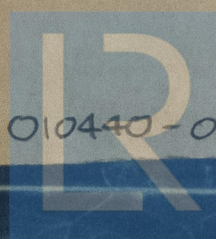

© 2021

010440 - 010450 - 0199

Lloyd's Register
Foundation